

STA 108+00 - 108+20 SOLID LT & DASHED RT  
 STA 108+20 - 108+78 SOLID LT & RT  
 TEMPORARY 4in YELLOW LINE (PAINT)  
 DURABLE 4in YELLOW LINE (THERMOPLASTIC)

78 STA 108+00 TO 115+59.64 DASHED LT & SOLID RT  
 64 STA 115+59 TO 151+50-152+35 SOLID LT&RT  
 STA 125+40 152+35 DOUBLE SOLID RT  
 STA 151+50 TO 154+00 SOLID LT & DASHED RT  
 STA 151+98 DOUBLE SOLID RT  
 (WITH CENTERLINE BREAKS FOR TOWN HIGHWAYS)

REMOVAL AND DISPOSAL OF GUARD RAIL

STA 108+00 TO 108+80 LT 72  
 STA 117+40 TO 118+90 LT  
 STA 119+65 TO 119+90 LT  
 STA 119+88 TO 120+25 RT  
 STA 149+55 TO 151+30 RT  
 62 39

MANUFACTURED TERMINAL SECTION, FLARED

~~STA 108+43 TO 108+80 LT~~  
 STA 117+40 TO 117+77 LT  
 STA 119+65 TO 120+02 LT  
 STA 119+88 TO 120+25 RT 120+25.5 - 120+63 RT  
 STA 150+93 TO 151+30 RT 151+01.5 - 151+39 RT  
 STA 149+01.5 - 149+39 RT  
 STEEL BEAM GUARD RAIL, GALVANIZED

STA 108+00 TO 108+43 LT 72  
 STA 117+77 TO 118+90 LT 40  
 STA 149+55 TO 150+93 RT  
 39 89  
 STA 119+88 - 120+25.5 RT

CURVE #21  
 PC = 113+70  
 PT = 118+00  
 R = 1,500ft - RT  
 SEE SHEET 24 FOR SUPERELEVATION DIAGRAM

TEMPORARY 4in WHITE LINE (PAINT)  
 DURABLE 4in WHITE LINE (THERMOPLASTIC)

STA 108+00 TO 154+00 SOLID LT&RT  
 (WITH EDGELINE BREAKS FOR TOWN HIGHWAYS)

ANCHOR FOR STEEL BEAM RAIL

~~STA 149+55 RT - 2~~  
 STA 108+59.5 LT - 1

DITCHING LOCATIONS (REFER TO SHEET 8 FOR DETAILS)

~~STA 111+50 TO 118+90 RT~~  
~~STA 111+90 TO 117+00 LT~~  
~~STA 134+50 TO 148+90 LT~~  
~~STA 134+50 TO 149+20 RT~~

STEEL BEAM GUARDRAIL, GALVANIZED W/8' POSTS

STA 118+40 - 118+90 LT  
 STA 150+89 - 151+01.5 RT

TEMPORARY AND DURABLE 24in STOP BAR

STA 125+40 RT NUTTING RD  
 STA 151+98 RT REAGAN RD

TEMPORARY AND DURABLE LETTER OR SYMBOL

STA 125+40 RT "STOP"  
 STA 151+98 RT "STOP"

YIELDING MARKER POST

STA 118+83 RT

REMOVING SIGNS  
 4

CURVE #23  
 PC = 144+00  
 PT = 146+00  
 R = 10,000ft - LT  
 SEE SHEET 25 FOR SUPERELEVATION DIAGRAM

CURVE #22  
 PC = 124+70  
 PT = 132+70  
 R = 2,450ft - LT  
 SEE SHEET 25 FOR SUPERELEVATION DIAGRAM

150+89 - 151+01.5 RT  
 STEEL BEAM GUARDRAIL GALVANIZED W/ 8' STEEL POSTS

62 39  
 STA 149+55 TO 151+30 RT

REMOVAL AND DISPOSAL OF GUARD RAIL

39 89  
 STA 149+55 TO 150+93 RT

INSTALL STEEL BEAM GUARD RAIL GALVANIZED

149+01.5 149+39  
 STA 150+93 TO 151+30 RT

INSTALL MANUFACTURED TERMINAL SECTION, FLARED & STA 151+01.5 - 151+39 RT

148+95 - 149+55 RT

INSTALL 15'x30' CPEP

60  
 STA 149+55 RT (ELIM)


INSTALL BURIED END TERMINAL w/CULVERT. SEE SHEET 32 FOR DETAIL

**LEGEND**

N	= NEW
R	= REMOVE
R&S	= REMOVE & SALVAGE
S	= SALVAGE
RET	= RETAIN
B-TO-B	= BACK TO BACK
⊠	CATCH BASIN/DI
⊙	EXISTING THROAT DI
(N.W.)	NO WORK REQUIRED (TYP. FOR W.V.'S, C.S.'S, D.I.'S, C.B.'S WHERE NOTED)
I	YIELDING MARKER POST
⊕	UTILITY POLE
---	DRIVE

DITCHING LOCATIONS  
 STA 108+00 - 112+67 RT  
 STA 111+90 - 116+60 LT  
 STA 123+50 - 127+30 LT  
 STA 141+80 - 142+98 RT  
 STA 143+60 - 149+20 LT

STONE FILL DITCH  
 STA 112+ 67 - 118+50 RT  
 STA 142+98 - 149+95 RT

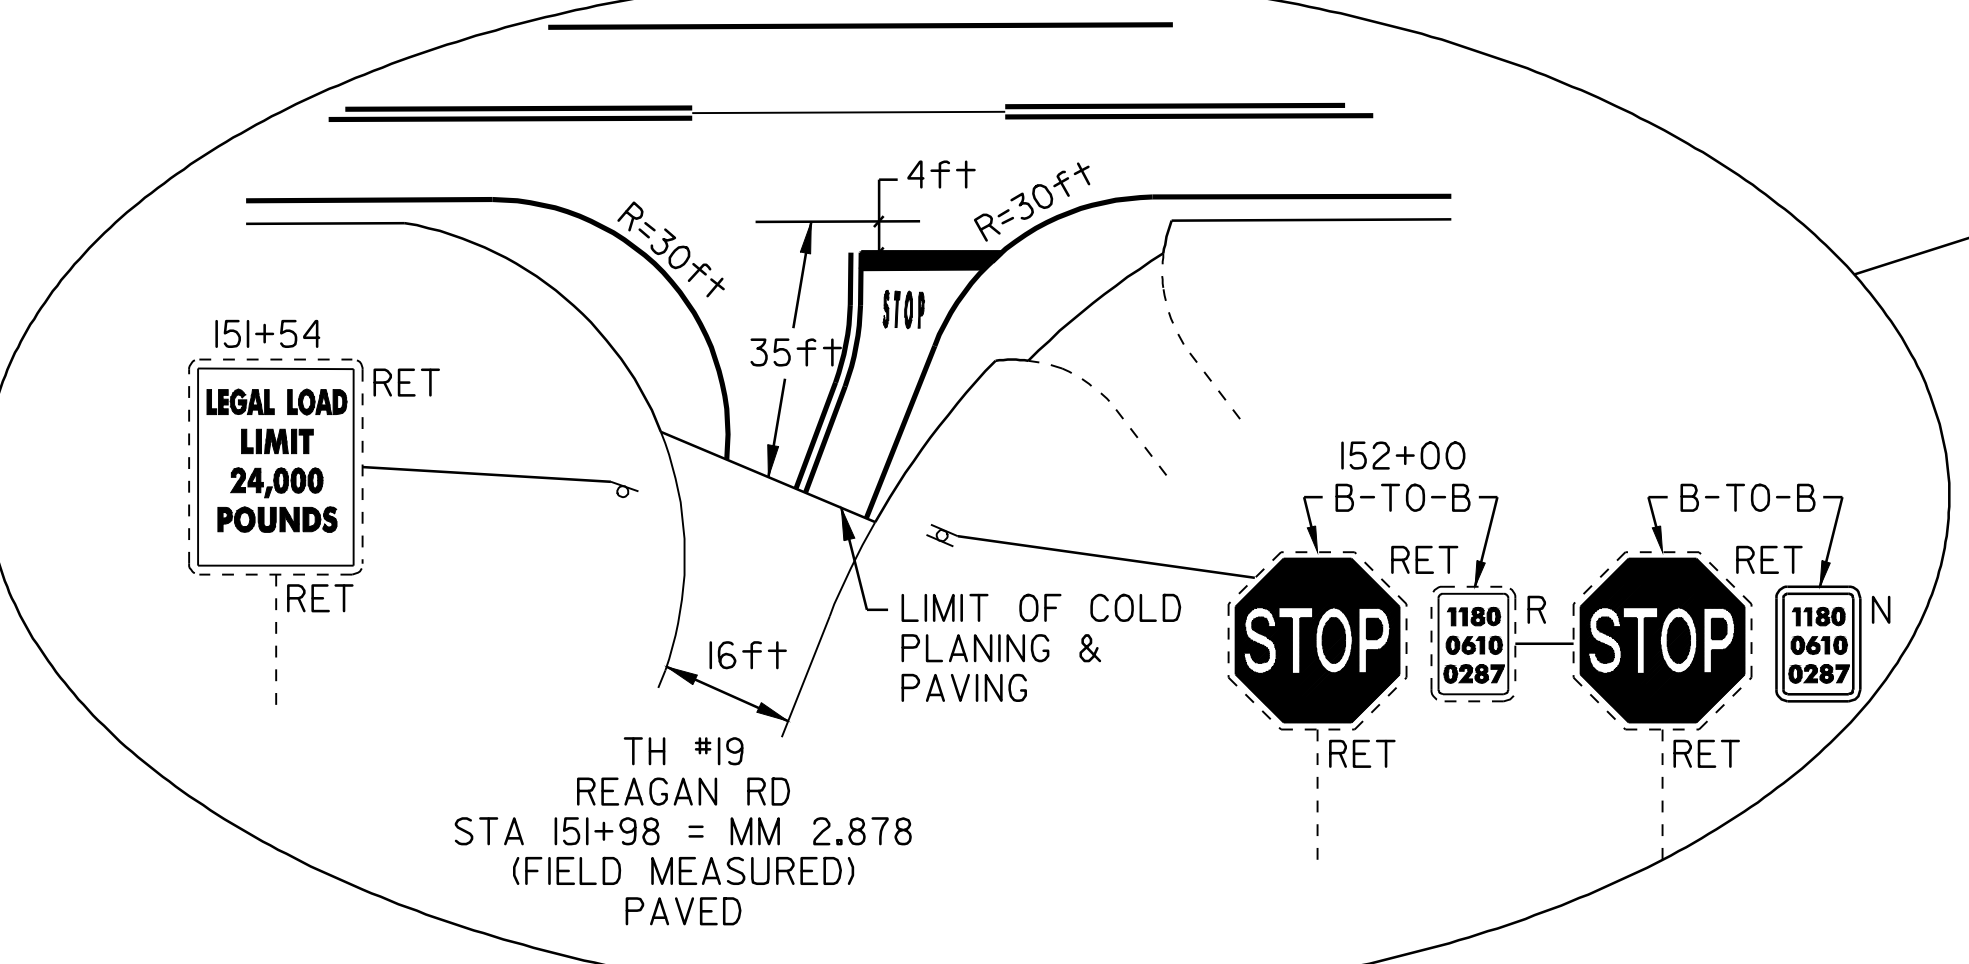

## PAVING PROJECT LAYOUT SHEET #6

DESIGNED BY BCE/PJM DATE 6-07

DRAWN BY C.E.A., INC. DATE 6-07

DESIGN FILE NO. p06cl62.dgn

PRF FILE p06cl62pp16.i DATE PLOTTED 03-NOV-2009

PROJ. NAME **BELVIDERE - MONTGOMERY**

PROJ. NO. **STP 2619(1)S**

SHEET **14** OF **33** SHEETS