


INDEX OF SHEETS

1	TITLE SHEET
2-3	PROJECT TYPICAL SHEETS
4-5	QUANTITY SHEETS
6-7	ITEM DETAIL SUMMARY SHEETS
8	DITCH CLEANING DETAIL SHEET
9-17	PAVING PROJECT LAYOUT SHEETS
18-28	SUPERELEVATION BANKING DIAGRAMS
29	TRAFFIC SIGN SUMMARY SHEET
30-31	BRIDGE DETAIL SHEETS
32	NON-YIELDING OBJECT APPROACH and BURIED END TERMINAL DETAIL SHEET
33	CONSTRUCTION APPROACH SIGNING AND DETAIL SHEET


VAOT STANDARDS

B-1	BANKING TABLES	06-01-94
D-8	REINFORCED CONCRETE DROP INLET WITH PRECAST COVER & GRATE (BOTTOM SECTION) SEE SHEETS D-9,10,11 FOR TOP SECTION	01-03-00
D-15	PRECAST REINFORCED CONC. MH-GRATES (BICYCLE SAFE) CAST IRON GRATE WITH FRAME, TYPE D CAST IRON GRATE WITH FRAME, TYPE E	06-01-94
E-100	CONSTRUCTION APPROACH SIGNS	01-02-04
E-100A	SIDE ROAD CONSTRUCTION APPROACH SIGNS	01-02-04
E-101	CONSTRUCTION SIGN DETAILS	05-30-03
E-102	CONSTRUCTION SIGN DETAILS	06-30-03
E-102A	CONSTRUCTION SIGN DETAILS	05-01-04
E-103	MAINLINE TRAFFIC CONTROL DIVIDED HIGHWAY ONE LANE CLOSED	03-01-04
E-106	TRAFFIC CONTROL - MISCELLANEOUS DETAILS	03-01-04
E-107	DELINEATION, BARRICADES AND DETOURS FOR CONSTRUCTION AREAS	06-30-03
E-107A	BREAKAWAY BARRICADE DETAILS	08-08-95
E-110	MAJOR MAINTAINANCE OPERATION LANE CLOSURE	08-08-95
E-111	MINOR MAINTAINANCE OPERATIONS	03-11-97
E-119	UTILITY WORK ZONE	03-01-04
E-120	STANDARD SIGN PLACEMENT - FREEWAY/EXPRESSWAY	08-08-95
E-121	STANDARD SIGN PLACEMENT - CONVENTIONAL ROAD	08-08-95
E-138	MARKER DETAILS - STATE AND TOWN HIGHWAYS	05-30-03
E-141	REGULATORY SIGN DETAILS	09-20-95
E-143	REGULATORY SIGN DETAILS	06-15-04
E-160	FLANGED CHANNEL STEEL SIGN POST	05-20-99
E-191	PAVEMENT MARKING DETAILS	02-01-99
E-192	PAVEMENT MARKING DETAILS	10-12-00
E-193	PAVEMENT MARKING DETAILS	08-18-95
G-1	STEEL BEAM GUARDRAIL (50MPH & OVER) HEAVY DUTY STEEL BEAM GUARDRAIL TWISTED END TERMINAL ANCHOR FOR STEEL BEAM RAIL	01-03-00
G-1D	STEEL BEAM GUARDRAIL (40MPH & LESS) HEAVY DUTY STEEL BEAM GUARDRAIL STEEL BEAM MEDIAN BARRIER ANCHOR FOR STEEL BEAM RAIL	01-03-00
G-4	MARKERS - GUIDE POSTS - PLANK GUARD RAIL PLANK RAIL GUIDE POSTS WOOD MARKER POSTS STEEL MARKER POSTS	06-01-94
G-19	GENERIC GRADING PLAN FOR GUARDRAIL END TERMINALS	11-15-02
SB-R6-82	BRIDGE RAIL - HEAVY DUTY STEEL BEAM	01-06-95

STATE OF VERMONT AGENCY OF TRANSPORTATION

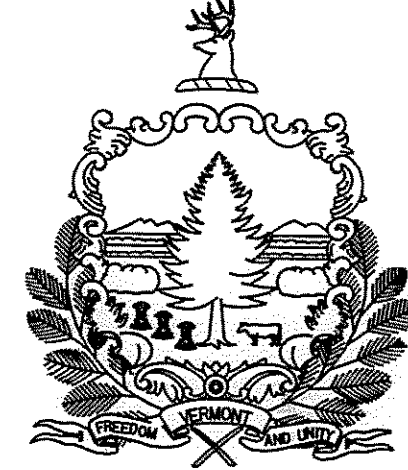

PROPOSED IMPROVEMENTS TOWNS OF BELVIDERE, AND MONTGOMERY COUNTIES OF LAMOILLE and FRANKLIN VT ROUTE 118

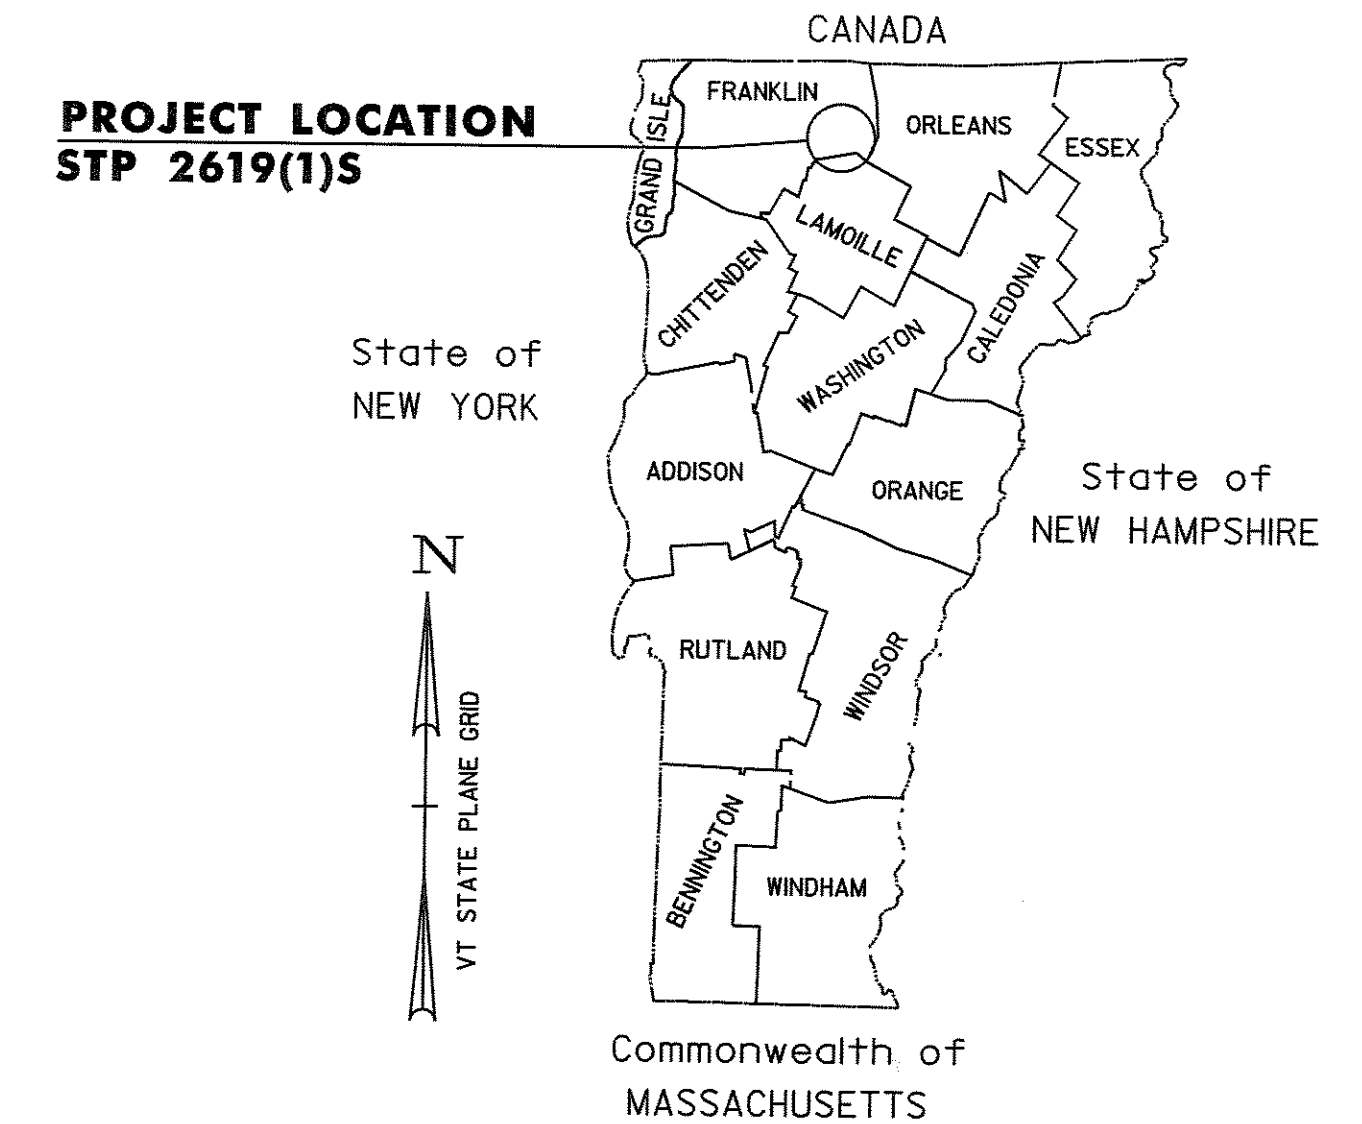

BEGINNING IN THE TOWN OF BELVIDERE AT STA 29+57 (MM 0.560) AND EXTENDING NORTHERLY ALONG VT ROUTE 118 INTO THE TOWN OF MONTGOMERY FOR A DISTANCE OF APPROXIMATELY 4,849 FEET (7.926 MILES) TO STA 293+83, (MM 5.565).



STATION TO STATION DATA	LENGTH (FEET)	(MILES)
TOWN OF BELVIDERE STA 29+57 TO STA 154+23 (MM 0.560 TO MM 2.921)	12,466	2.361
TOWN OF MONTGOMERY STA 0+00 TO STA 293+83 (MM 0.000 TO MM 5.565)	29,383	5.565
PROJECT TOTALS	41,849	7.926

TRAFFIC DATA

	ADT		DHV		FLEXIBLE ESAL'S	
	2007	2017	2007	2017	(2007-2017)	(2007-2027)
PROJECT BEGIN (MM 0.560) TO SADEN ROAD (MONT. MM 4.37)	630	720	220	230	139,000	326,000
SADEN ROAD (MONT. MM 4.37) TO NOTCH ROAD (VT 58, MM 5.59)	1,000	1,200	260	290	157,000	382,000

BELVIDERE - MONTGOMERY VT ROUTE 118, MM 0.560 TO MM 5.565	
BITUMINOUS CONCRETE PAVEMENT SUPERPAVE MIXTURE DESIGN CRITERIA	
DESIGN LANE/DESIGN LIFE ESAL	382,000
DESIGN NUMBER OF GYRATIONS	50
PERFORMANCE GRADED ASPHALT BINDER	PG 58-34

WORK TO BE PERFORMED UNDER THIS PROJECT INCLUDES RECLAIMING AND RESURFACING OF THE EXISTING HIGHWAY WITH A COMBINATION OF WEARING AND BASE COURSES, NEW PAVEMENT MARKINGS, GUARD RAIL INSTALLATION, DRAINAGE IMPROVEMENTS AND INCIDENTAL ITEMS.

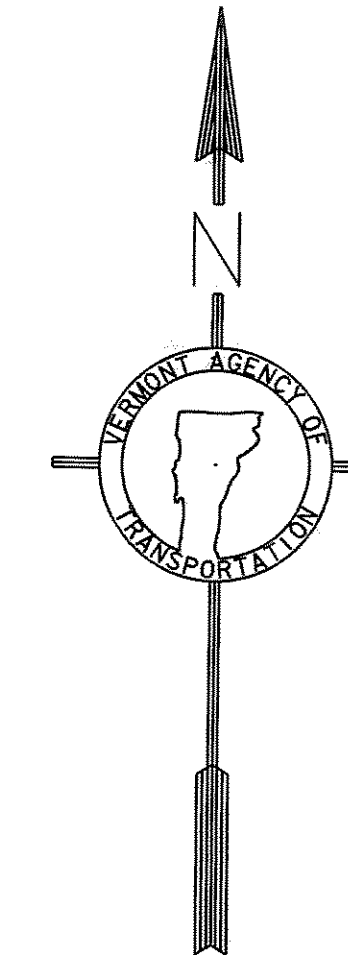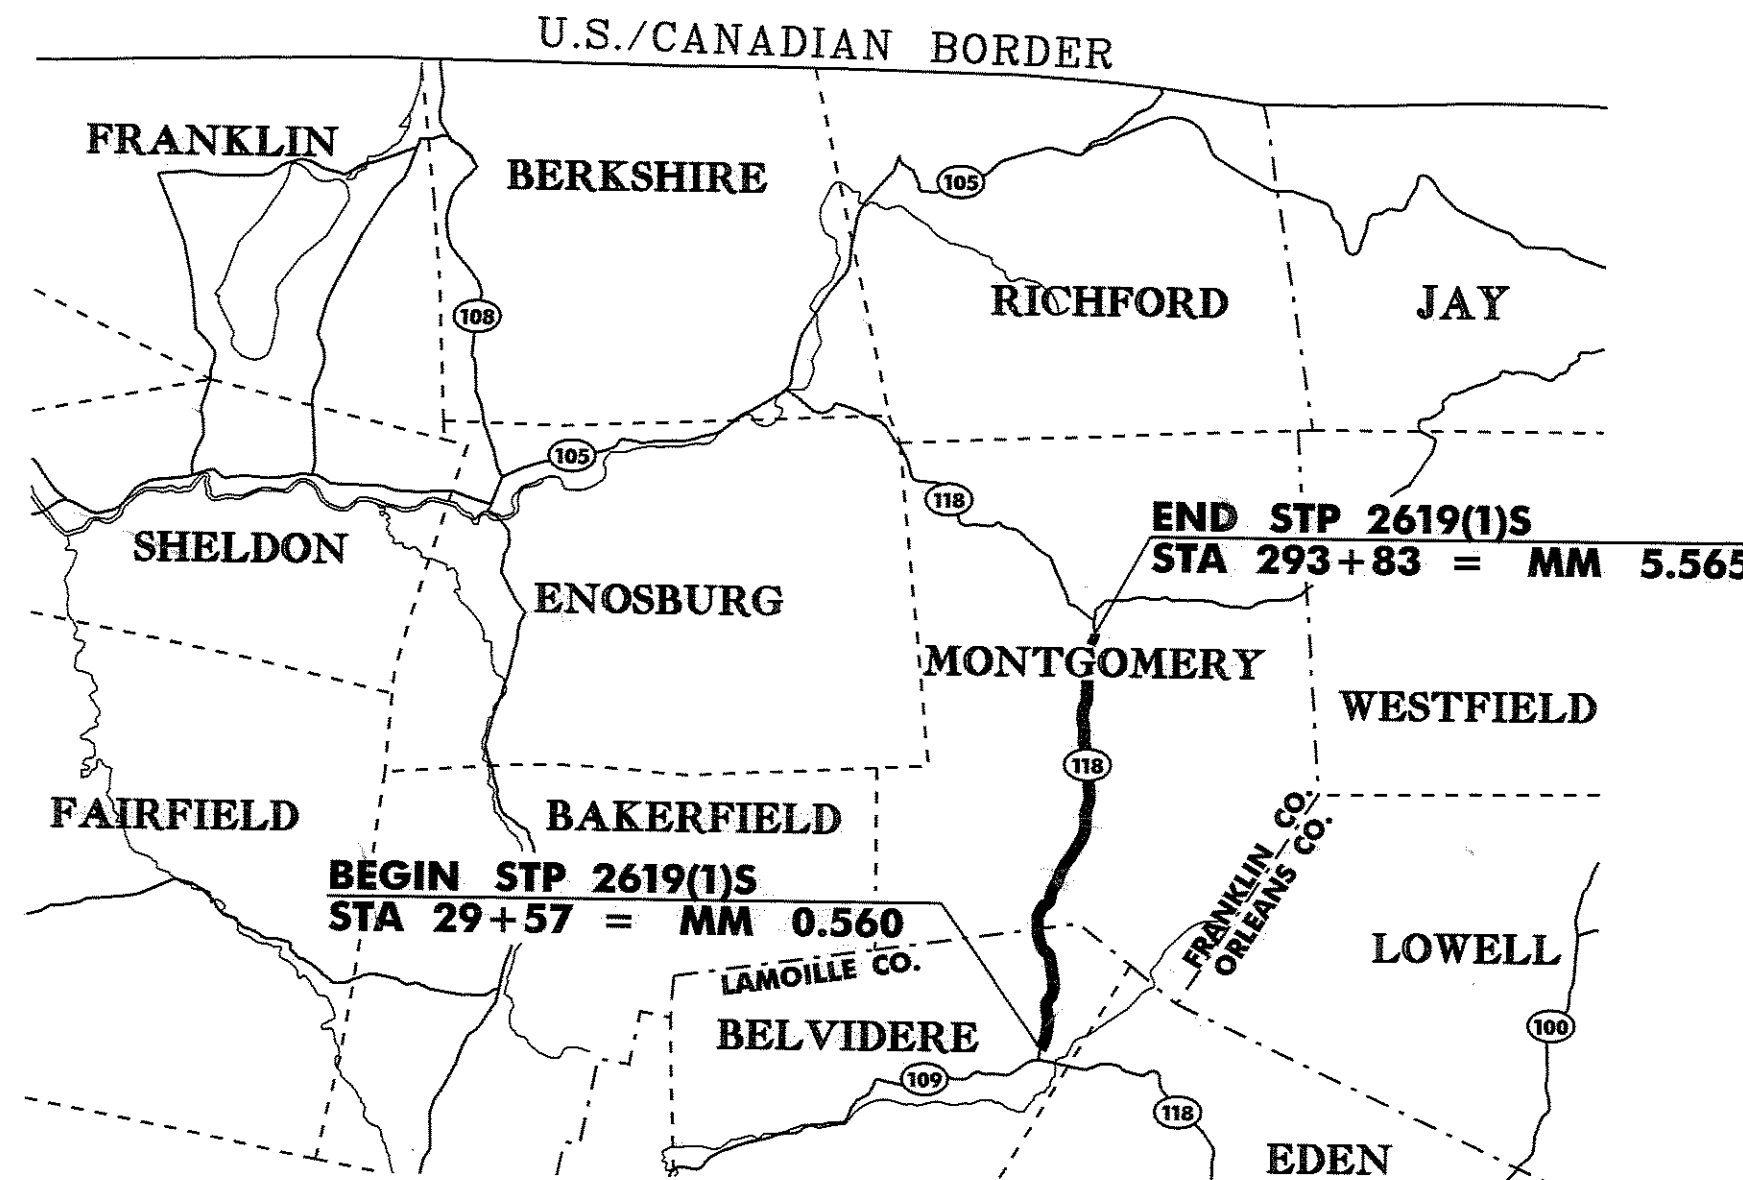

RIGHT-OF-WAY LIMITS, IF APPLICABLE, ARE PROVIDED SOLELY FOR THE CONVENIENCE OF THE STATE AND ITS CONTRACTOR DURING THE COURSE OF THIS PAVING PROJECT. ANY REFERENCES TO OFFSETS ON THESE PLANS ARE APPROXIMATE AND SHOULD NOT BE RELIED UPON FOR ANY OTHER PURPOSES.

UNLESS OTHERWISE NOTED, ALL DRAWINGS AND DETAILS ON THESE PLANS ARE DRAWN 'NOT TO SCALE'.

THESE PLANS ARE SUBJECT TO SUCH ENGINEERING CHANGES AS MAY BE REQUIRED BY THE FEDERAL HIGHWAY ADMINISTRATION OR THE DIRECTOR OF PROGRAM DEVELOPMENT.

CONSTRUCTION IS TO BE CARRIED ON IN ACCORDANCE WITH THESE PLANS AND THE STANDARD SPECIFICATIONS FOR CONSTRUCTION DATED 2006, AS APPROVED BY THE FEDERAL HIGHWAY ADMINISTRATION ON JUNE 15, 2006 FOR USE ON THIS PROJECT, INCLUDING ALL SUBSEQUENT REVISIONS AND SUCH REVISED SPECIFICATIONS AND SPECIAL PROVISIONS AS ARE INCORPORATED IN THESE PLANS.

RECORD PLANS

CONTRACTOR: PIKE INDUSTRIES, INC. - BERLIN, VT

RESIDENT ENGINEER: JON DAY

CONSTRUCTION BEGAN: APRIL 2, 2008

CONSTRUCTION COMPLETE: NOVEMBER 6, 2008

RECORD PLANS BY: JON DAY & C. PIERCE

I HEREBY CERTIFY THAT ALL THE CONSTRUCTION REQUIRED BY THIS SET OF DRAWINGS HAS BEEN ACCOMPLISHED AS INDICATED HEREIN.

BY: *Jon Day* RESIDENT ENGINEER

DATE: 10-23-09

NOTE: Any further information concerning final quantities, amounts or other details relative to this project may be found at Central Files in the electronic archives.

CONVENTIONAL SIGNS

COUNTY LINE	---
TOWN LINE	- - - -
LIMITS OF ACCESS	o-o-o-o
POINT OF ACCESS	X
FENCE LINE	-x-x-
STONE WALL	o-o-o-o
TRAVELED WAY	=====
GUARD RAIL	o-o-o-o
RAILROAD	
SURVEY LINE	+
CULVERT	--- ---
POWER POLE	o
TELEPHONE POLE	o
TREES	o * o
CONTROL OF ACCESS	---
PROPERTY LINE	---
R.O.W. TAKING LINE	---
SLOPE RIGHTS	o SR
TOP OF CUT	o
TOE OF SLOPE	o

DATUM

VERTICAL	N/A
HORIZONTAL	N/A


BY:

CIVIL ENGINEERING ASSOCIATES, INC.
P.O. BOX 488 SHELBURNE, VT 05482
802-985-2323 FAX: 802-985-2271 web: ceo-vt.com

DIRECTOR OF PROGRAM DEVELOPMENT	APPROVED: <i>Ted Domey</i> DATE: 10/27/09
PROJECT MANAGER: TED DOMEY	
PROJECT NAME: BELVIDERE - MONTGOMERY	
PROJECT NUMBER: STP 2619(1)S	
SHEET 1 OF 33 SHEETS	

NOTES

1. THE PAVEMENT WEARING COURSE SHALL BE TYPE IVS. ALL ASPHALT CEMENT USED IN THE BITUMINOUS CONCRETE PAVEMENT SHALL BE PG 58-34.
2. EMULSIFIED ASPHALT, TYPE RS-1, SHALL BE APPLIED BETWEEN ALL COURSES OF PAVEMENT (NOT INCLUDING RECLAIMED SURFACES) AT THE RATE OF 0.025 GAL/SY OR AS DIRECTED BY THE RESIDENT ENGINEER. EMULSIFIED ASPHALT, TYPE RS-1, SHALL BE APPLIED TO THE FINE GRADED RECLAIMED SURFACE FOR THE PURPOSE OF DUST CONTROL AT A RATE OF 0.10 TO 0.15 GAL/SY. QUANTITIES OF EMULSIFIED ASPHALT TO BE USED FOR DUST CONTROL HAVE BEEN ESTIMATED AT 0.125 GAL/SY. PAYMENT WILL BE UNDER ITEM 404.65 EMULSIFIED ASPHALT.
3. BITUMINOUS CONCRETE PAVEMENT TOLERANCE = +/- 1/4 in (TOTAL THICKNESS).
4. PRIOR TO RECLAIMING, EXISTING SHOULDER MATERIAL DEEMED UNSUITABLE BY THE RESIDENT ENGINEER WILL BE EXCAVATED TO A DEPTH OF 3 in +/- OR AS DIRECTED BY THE RESIDENT ENGINEER. EXCAVATED MATERIAL WILL BE SPREAD ON THE ADJACENT SLOPES OR REMOVED FROM THE PROJECT, AS DIRECTED BY THE RESIDENT ENGINEER. THIS WORK WILL BE PAID FOR USING THE APPROPRIATE RENTAL ITEMS SUCH AS ALL PURPOSE EXCAVATOR RENTAL, TYPE I, POWER GRADER RENTAL, LOADER RENTAL, TYPE I, TRUCK RENTAL, AND POWER BROOM RENTAL, TYPE I. THE METHOD OF REMOVAL AND THE USE OF RENTAL ITEMS SHALL BE APPROVED BY THE RESIDENT ENGINEER PRIOR TO ANY WORK BEING DONE. MATERIAL REMOVED SHALL BE REPLACED WITH SUBBASE OF CRUSHED GRAVEL, FINE GRADED.
5. THREE FEET OF BACKING IS REQUIRED BEHIND THE FACE OF GUARD RAIL WITH 6ft POSTS. IF THIS CANNOT BE OBTAINED THEN 8ft POSTS SHALL BE USED.
6. STEEL BEAM GUARD RAIL WITH STEEL POSTS SHALL BE USED ON THIS PROJECT.
7. COLD PLANING TO BE COMPLETED ACCORDING TO THE DETAILS OR AS NOTED OTHERWISE ON THE PLANS. A FULL DEPTH BUTT JOINT SHALL BE CONSTRUCTED AT THE PROJECT BEGIN/END AND AT ALL SIDE ROAD APPROACHES AS DENOTED ON THE PROJECT PLANS OR AS OTHERWISE DIRECTED BY THE RESIDENT ENGINEER.
8. ITEM 604.412 IS AN ESTIMATED QUANTITY AND SHALL BE PERFORMED AT LOCATIONS INDICATED ON THE LAYOUT SHEETS AND AS DIRECTED BY THE RESIDENT ENGINEER. ALL D.I.'S SHALL BE RAISED OR REHABILITATED SUCH THAT THE NEW GRATE ELEVATION IS LEVEL WITH THE SURROUNDING TERRAIN.
9. ALL EDGES OF PAVEMENT AND TREATED TIMBER CURB SHALL BE BACKED UP FULL HEIGHT WITH ITEM 402.12, AGGREGATE SHOULDERS AS DIRECTED BY THE RESIDENT ENGINEER.
10. ALL DRIVES SHALL RECEIVE A PAVED APRON OF 4 TO 10ft, AS DIRECTED BY THE RESIDENT ENGINEER. ANY REQUIRED EXCAVATION SHALL BE AS DIRECTED AND WILL BE PAID FOR UNDER THE APPLICABLE RENTAL ITEM(S). IF REQUIRED, A NEW SUBBASE SHALL BE CONSTRUCTED AND WILL BE PAID FOR UNDER ITEM 301.28, SUBBASE OF CRUSHED GRAVEL, FINE GRADED. A NEW BITUMINOUS SURFACE SHALL BE CONSTRUCTED AS DIRECTED AND WILL BE PAID FOR UNDER ITEM 490.30. ESTIMATED QUANTITIES OF THE ABOVE ITEMS HAVE BEEN INCLUDED TO PAY FOR THIS WORK.
11. ESTIMATED QUANTITIES OF ITEMS 608.25, ALL PURPOSE EXCAVATOR RENTAL, TYPE I, 608.37, TRUCK RENTAL, AND 608.40, LOADER RENTAL, TYPE I HAVE BEEN INCLUDED FOR THE PROVISION OF CONSTRUCTING GUARD RAIL END SECTION FLARES WITH EXCAVATED DITCHING MATERIAL. AN ESTIMATED QUANTITY OF 203.30, EARTH BORROW HAS BEEN INCLUDED IN THE CASE THAT THE DITCHING MATERIAL IS NOT SUITABLE TO USE IN THE GUARD RAIL END SECTION FLARE. 25 CUBIC YARDS OF EARTH BORROW HAS BEEN ESTIMATED FOR EACH NEW GUARD RAIL END SECTION FLARE. GUARD RAIL END SECTION FLARES SHALL BE CAPPED WITH AN ESTIMATED 3' DEPTH OF AGGREGATE SHOULDERS UNLESS OTHERWISE DIRECTED BY THE RESIDENT ENGINEER. THE QUANTITIES INCLUDED REFLECT 5 TONS OF ITEM 402.12, AGGREGATE SHOULDERS FOR EACH NEW GUARD RAIL END SECTION FLARE. ITEM 653.20, TEMPORARY EROSION MATTING, SHALL BE PLACED ON SLOPES GREATER THAN 1:6 CREATED BY THE GUARD RAIL END SECTION FLARE. THE QUANTITIES INCLUDED REFLECT 25 SY OF ITEM 653.20, TEMPORARY EROSION MATTING FOR EACH NEW GUARD RAIL END SECTION FLARE.
12. COMPACTION, GRADING, AND CLEAN UP OF ITEM 301.28-SUBBASE OF CRUSHED GRAVEL, FINE GRADED, ITEM 402.12-AGGREGATE SHOULDERS, AND ITEM 651.35-TOPSOIL, IS TO BE INCLUDED IN THE CONTRACT PRICE OF EACH ITEM.
13. AN ESTIMATED THICKNESS OF 2" OF SPECIAL PROVISION (SUBBASE OF CRUSHED GRAVEL, FINE GRADED FOR RECLAIMING), HAS BEEN INCLUDED FOR THE PROVISION OF IMPROVING GRADATION DEFICIENCIES AND/OR CORRECTING SUPERELEVATION, AS NECESSARY, OR AS DIRECTED BY THE RESIDENT ENGINEER. THIS MATERIAL SHALL BE RECLAIMED INTO THE RECLAIMED STABILIZED BASE. PAYMENT FOR THIS SECOND RECLAIMING OPERATION WILL BE INCIDENTAL TO ITEM 900.680 SPECIAL PROVISION (SUBBASE OF CRUSHED GRAVEL, FINE GRADED FOR RECLAIMING).
14. STABILIZING AGENT FOR RECLAIMED STABILIZED BASE WILL BE WATER. PAYMENT SHALL BE INCIDENTAL TO ITEM 310.20.
15. AN ESTIMATED QUANTITY OF ITEM 619.17, YIELDING MARKER POSTS HAS BEEN INCLUDED TO DELINEATE CULVERT ENDS AND DROP INLETS LOCATED OUTSIDE OF THE PAVEMENT SURFACE OR AS DIRECTED BY THE RESIDENT ENGINEER.

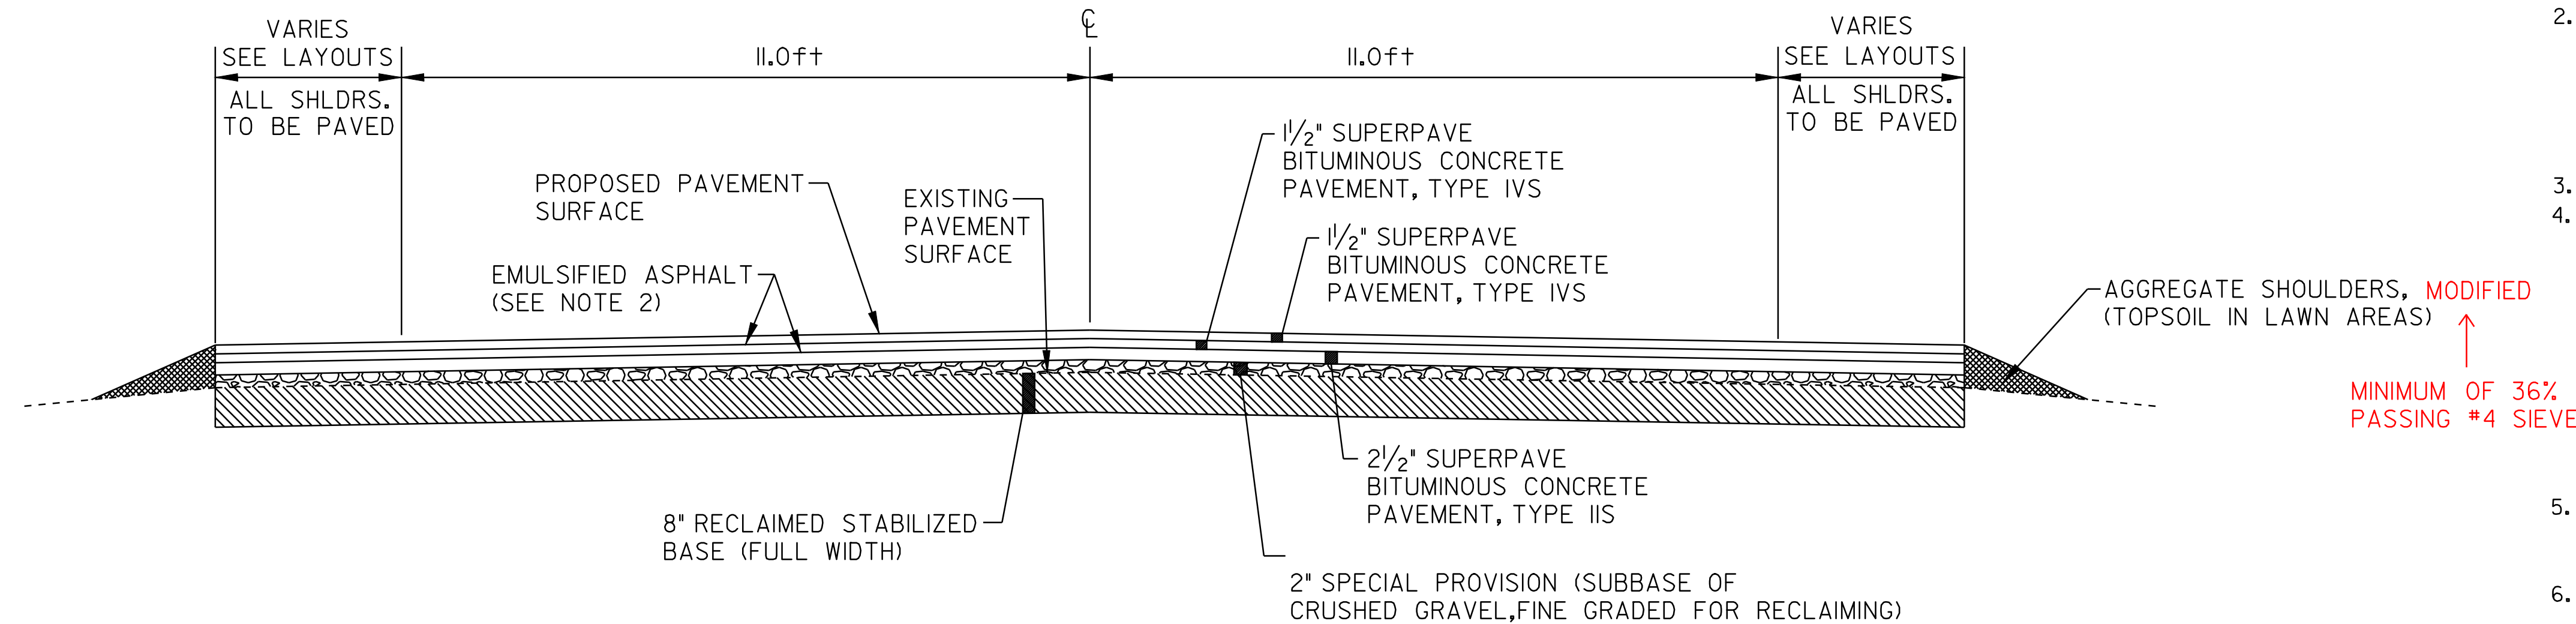

RECLAIM TYPICAL SECTION

BELVIDERE
STA 29+57 TO 154+23
31+07
MONTGOMERY
STA 0+00 TO 293+83

PROJECT PAVING LIMITS

TOWN & ROUTE	BEGIN STATION	END STATION	LANE TYPICAL	WEARING DEPTH	LEVELING Tons	NOTES
BELVIDERE - VT ROUTE 118	29+57	154+23	VARIABLE -11.0FT-11.0FT- VARIABLE	1/2 in	--	RECLAIM 8", MIX 2" SPECIAL PROVISION (SUBBASE OF CRUSHED GRAVEL, FINE GRADED, FOR RECLAIMING) IN RECLAIM AREA, PAVE w/ 2 1/2" TYPE IIS, & 2 - LIFTS 1/2" TYPE IVS
MONTGOMERY - VT ROUTE 118	0+00	293+83	VARIABLE -11.0FT-11.0FT- VARIABLE	1/2 in	--	RECLAIM 8", MIX 2" SPECIAL PROVISION (SUBBASE OF CRUSHED GRAVEL, FINE GRADED FOR RECLAIMING), IN RECLAIM AREA, PAVE w/ 2 1/2" TYPE IIS, & 2 - LIFTS 1/2" TYPE IVS

CONSERVATION SEED MIX

RURAL AREA - SEED MIXTURE

% WT.	lbs./ACRE	NAME	PUR%	GERM%
37.5	22.5	CREeping RED FESCUE	98	85
37.5	22.5	TALL FESCUE	95	90
5.0	3	RED TOP	95	90
15.0	9	BIRDFOOT TREFOIL	98	85
5.0	3	ANNUAL RYEGRASS	95	85
100.0	60			

SEED MIXTURE:
 SHALL NOT HAVE A WEED CONTENT EXCEEDING 0.40% BY WEIGHT AND SHALL BE FREE OF ALL NOXIOUS SEED.


SEED:
 TO BE APPLIED PER SEEDING FORMULAS OR AS DIRECTED BY THE ENGINEER.

FERTILIZER:
 FORMULA 10-20-10, TO BE USED WITH SEED, APPLIED AT THE RATE OF 500 lbs/ACRE. (HYDRO SEEDERS MAY USE 19-19-19 FORMULA)

AGRICULTURAL LIMESTONE:
 TO BE APPLIED AT THE RATE OF 2.0 TONS/ACRE, OR AS DIRECTED BY THE ENGINEER.

HAY MULCH:
 TO BE PLACED ON EARTH SLOPES AT THE RATE OF 2.0 TONS/ACRE, OR AS DIRECTED BY THE ENGINEER.


TOPSOIL:
 TO BE USED AS INDICATED ON THE PLANS, OR AS DIRECTED BY THE ENGINEER.

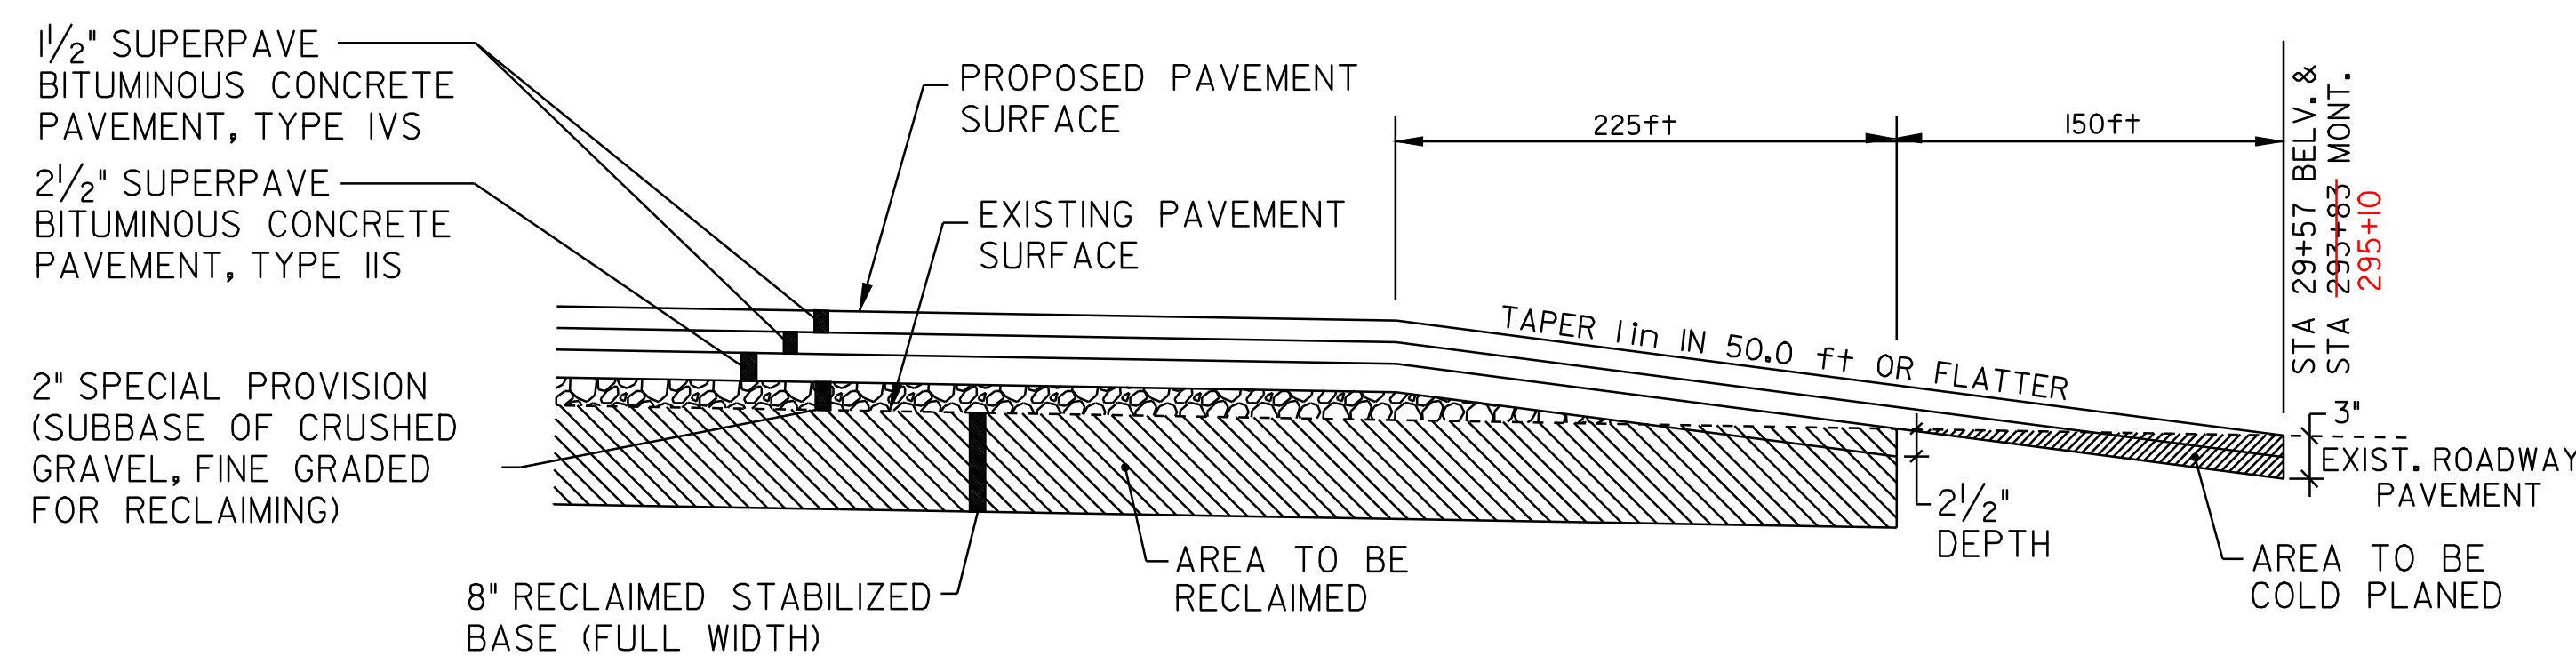


- APPROACH AREA DETAIL -
BELVIDERE
STA 29+57 (BEGIN PROJECT)
MONTGOMERY
STA 293+83 (END PROJECT)
295+10

PROJECT TYPICAL SHEET #1



DESIGNED BY	BCE/PJM	DATE	6-07
DRAWN BY	C.E.A., INC.	DATE	6-07
DESIGN FILE NO.	p06cl62.dgn		
PRF FILE	p06cl62+sl.1	DATE PLOTTED	03-NOV-2009
PROJ. NAME	BELVIDERE - MONTGOMERY		
PROJ. NO.	STP 2619(1)S		
SHEET	2	OF	33 SHEETS

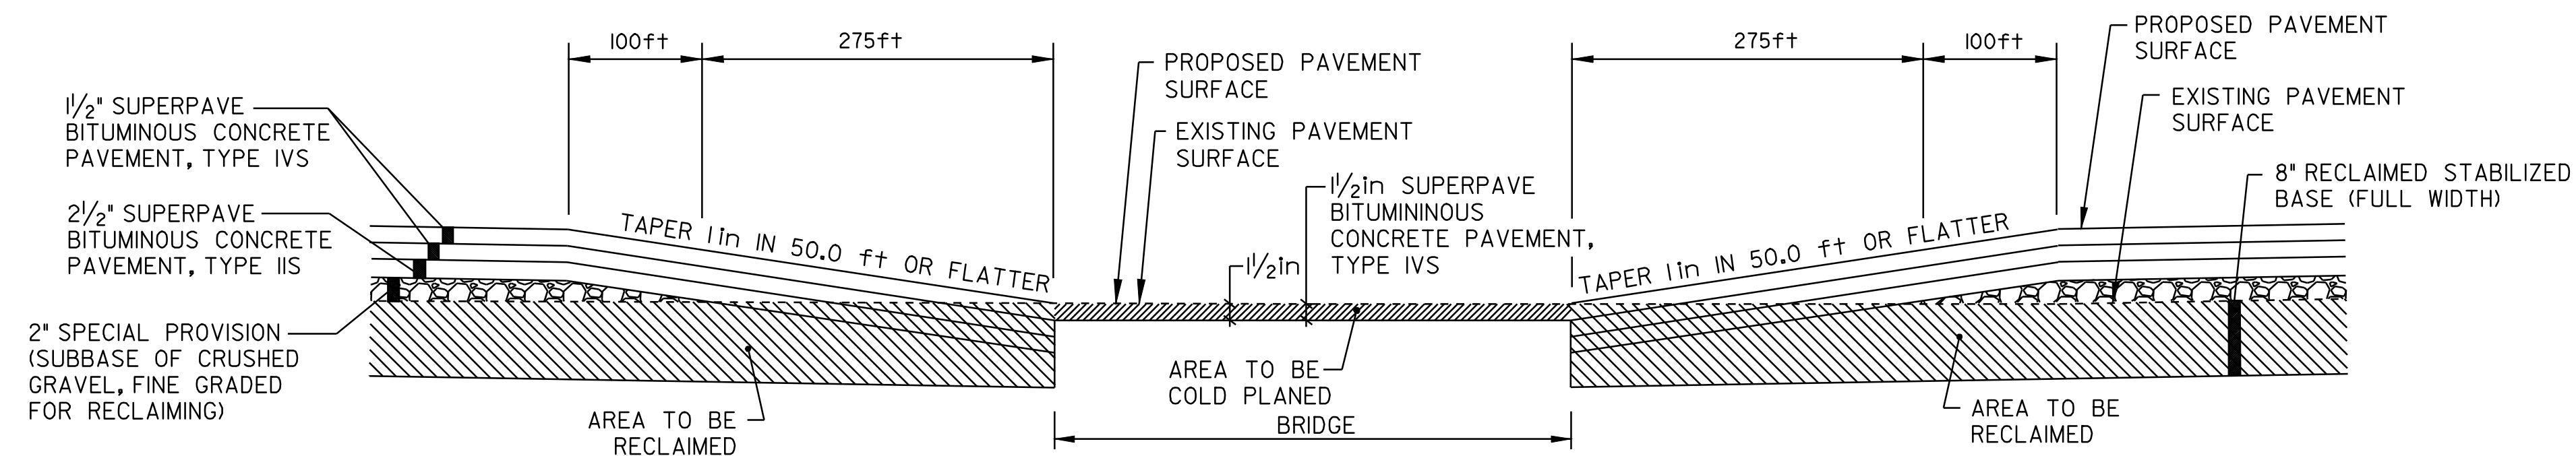

- COLD PLANING DETAIL @ BRIDGE -
MONTGOMERY
BRIDGE #12 - STA 157+15

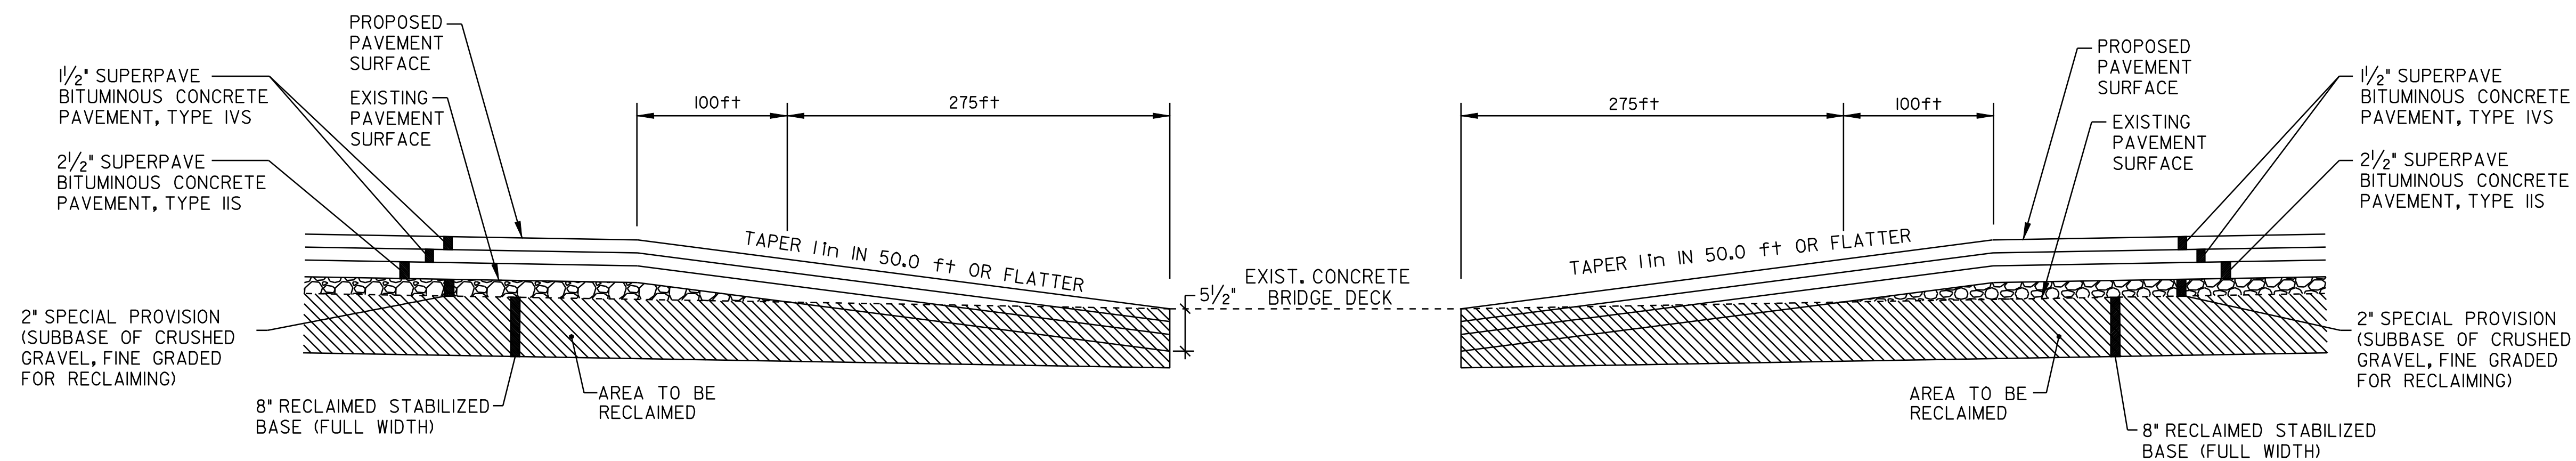

- BRIDGE APPROACH DETAIL -
MONTGOMERY
BRIDGE #11
STA 119+64 = MM 2.266

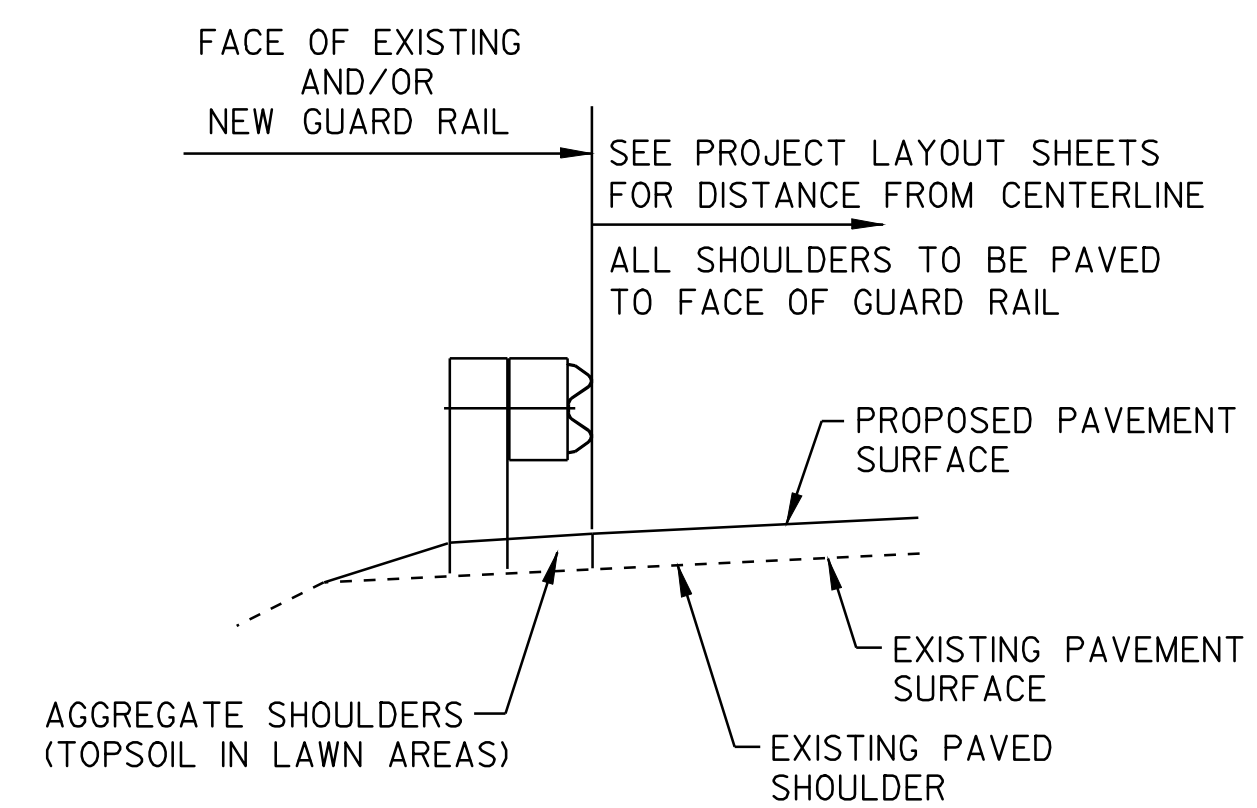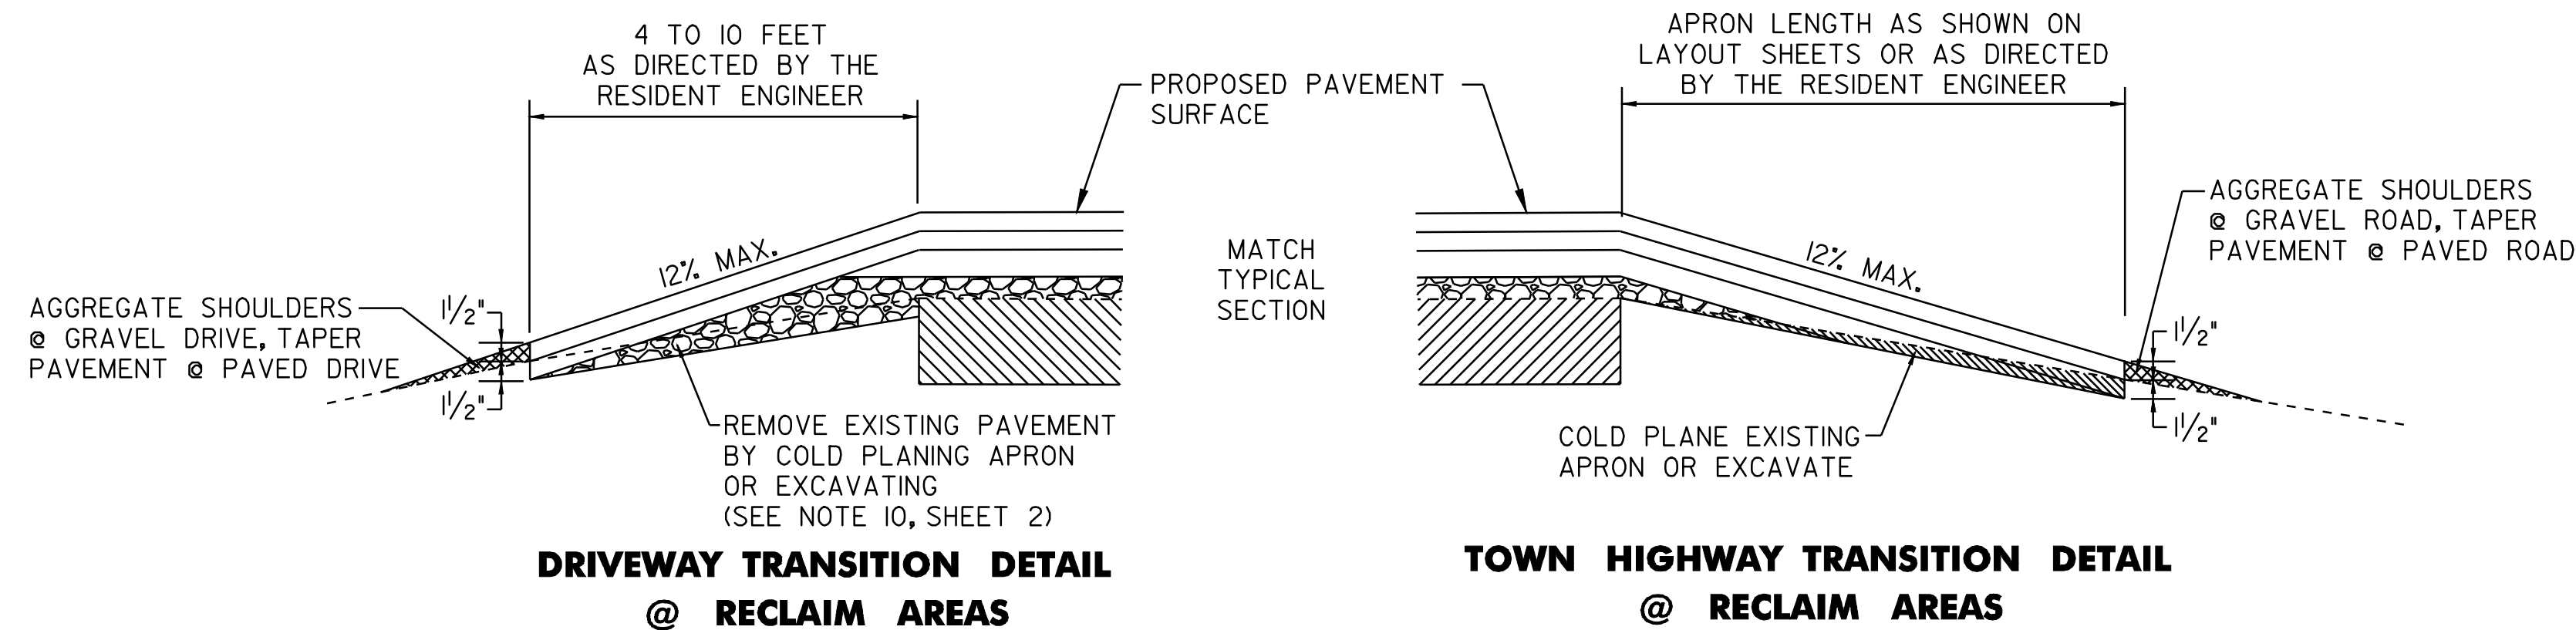

- TYPICAL SECTION AT GUARD RAIL -

PROJECT TYPICAL SHEET #2	DESIGNED BY	BCE/PJM	DATE	6-07
	DRAWN BY	C.E.A., INC.	DATE	6-07
	DESIGN FILE NO.	p06cl62.dgn	DATE	
	PRF FILE	p06cl62+ts2.1	DATE PLOTTED	03-NOV-2009
	PROJ. NAME	BELVIDERE - MONTGOMERY		
PROJ. NO.	STP 2619(1)S			
SHEET	3	OF	33	SHEETS

ITEM DETAIL SUMMARY SHEET 1

LOCATION			MISCELLANEOUS ITEMS						DRAINAGE ITEMS						GUARD RAIL ITEMS										REMARKS
STA	STA	POS.	203.30	301.28	402.12	617.10	653.20	604.412						616.35	619.17	621.20	621.205	621.21	621.50	621.60	621.80	676.10	900.680		
			EARTH BORROW	SUBBASE OF CRUSHED GRAVEL, FINE	AGG. SHOULD.	RELOCATE MAILBOX SINGLE SUPPORT	TEMP. EROSION MATTING	REHAB. D.I. CLASS I	DIA.	CSP (0.064)	RCP	CPEP	TREATED TIMBER CURB	YIELDING MARKER POSTS	STEEL BEAM G.R.	STEEL BEAM G.R. 8" POSTS	HEAVY DUTY S.B. G.R.	MANUF. TERMINAL SECTION, FLARED	ANCHOR FOR S.B. RAIL	REMOVE & DISP. OF GUARD RAIL	DELIN. w/STEEL POSTS	SPECIAL PROVISION (SUBBASE OF CRUSHED GRAVEL, FINE GRADED FOR RECLAIMING)			
			CY	TON	TON	EA	SY	EA	in	LF	LF	LF	LF	EA	LF	LF	LF	EA	EA	LF	EA	TON			
BELVIDERE																									
29+57	154+23	LT&RT		50	1,400																	4,700	ESTIMATED QUANTITIES TO BE USED AS DIRECTED BY THE RESIDENT ENGINEER.		
31+88		RT				±																	RELOCATE MAILBOX, SINGLE SUPPORT.		
31+88	40+63	RT	50		10		50								687.5					887.5			REPLACE EXISTING STEEL BEAM GUARD RAIL.		
78+00	80+75	RT	50		10		50								800	125				875	2		REPLACE EXISTING STEEL BEAM GUARD RAIL.		
78+00	80+75	RT	50		10		50								175	200				287.5			REPLACE EXISTING STEEL BEAM GUARD RAIL.		
78+50	81+25	LT	50		10		50								212.5					275	2		REPLACE EXISTING STEEL BEAM GUARD RAIL.		
102+60	106+35	RT	50		10		50								325					375	2		REPLACE EXISTING STEEL BEAM GUARD RAIL.		
104+00	106+00	LT	50		10		50									125				200	2		REPLACE EXISTING STEEL BEAM GUARD RAIL.		
114+94	119+69	LT	50		10		50								87.5					475	2		REPLACE EXISTING STEEL BEAM GUARD RAIL.		
116+05	125+80	RT	50		10		50								400	325				975	2		REPLACE EXISTING STEEL BEAM GUARD RAIL.		
149+37	153+37	LT	50		10		50									325				400	2		REPLACE EXISTING STEEL BEAM GUARD RAIL.		
BELV. MONT.																									
150+42	144+20	RT	50		10		50								612.5					800	2		REPLACE EXISTING STEEL BEAM GUARD RAIL.		
MONTGOMERY																									
0+00	293+83	LT&RT		200	3,305									10								10,900	ESTIMATED QUANTITIES TO BE USED AS DIRECTED BY THE RESIDENT ENGINEER.		
10+89	15+80	RT	50		10		50								137.5					500	2		REPLACE EXISTING STEEL BEAM GUARD RAIL.		
13+89	20+14	LT	50		10		25								175					625	2		REPLACE EXISTING STEEL BEAM GUARD RAIL. INSTALL BURIED END TERMINAL		
22+66	37+66	LT	50		10		50								607.5	432.5		± 2	± 0	1,500	2		REDUCED POST SPACING @ STA 16+20, SEE DETAILS, SHEET 32.		
26+30		RT													435								REPLACE EXISTING STEEL BEAM GUARD RAIL & TIMBER CURB, REDUCED POST SPACING REQUIRED @ STA 35+25.		
31+32		RT													1								REHAB D. I.		
31+32		RT													1								REHAB D. I.		
58+57	63+57	LT	50		10		50								137.5					500	2		REPLACE EXISTING STEEL BEAM GUARD RAIL.		
71+77	77+90	RT	50		10		25								425	300				500	2		REPLACE EXISTING STEEL BEAM GUARD RAIL.		
71+76	79+40	LT	50		10		25								250	575		± 2	± 0	612.5	2		REPLACE EXISTING STEEL BEAM GUARD RAIL. INSTALL BURIED END TERMINAL		
72+03	79+40	LT	50		10		25								487.5	737.5		1	± 2	737.5	2		W/CULVERT @ STA 71+77, SEE DETAIL SHEET 32.		
81+80	87+42	RT	50		10		25								137.5	525		± 2	± 0	562.5	2		REPLACE EXISTING STEEL BEAM GUARD RAIL. INSTALL BURIED END TERMINAL		
83+84	88+46	LT	50		10		25								262.5	425		± 2	± 0	462.5	2		W/CULVERT @ STA 81+80, SEE DETAIL SHEET 32.		
95+50	99+75	RT	50		10		50								275	62.5				425	2		REPLACE EXISTING STEEL BEAM GUARD RAIL.		
99+20	101+70	LT	50		10		50								150	175				250	2		REPLACE EXISTING STEEL BEAM GUARD RAIL.		
101+65	107+65	RT	50		10		50								300	525				600	2		REPLACE EXISTING STEEL BEAM GUARD RAIL.		
104+18	108+00	LT	50		10		50								252					462.5	2		REPLACE EXISTING STEEL BEAM GUARD RAIL.		
111+93		RT													1	15									
117+40	118+90	LT	25		5		25								62.5					1			REPLACE EXISTING STEEL BEAM GUARD RAIL, ATTACH TO EXISTING BRIDGE APPROACH RAIL.		
119+65	120+02	LT	25		5		25								112.5	50				150	1		REPLACE EXISTING STEEL BEAM GUARD RAIL.		
119+88	120+25	RT	25		5		25								52.5					37.5	1		REPLACE EXISTING STEEL BEAM GUARD RAIL.		
149+55	151+30	RT	50		10		25								150					175	2		REPLACE EXISTING STEEL BEAM GUARD RAIL. INSTALL BURIED END TERMINAL		
															137.5	12.5		± 2	± 0				W/CULVERT @ STA 149+55, SEE DETAIL SHEET 32.		

SHEET SUB-TOTALS			1,175	250	4,940	± 0	1,000								23	15		150	435	10	6,690	4,137.5	--	40	14	12,275	47	15,600
															240						6,467	4,665		45	3	12,339	48	

ITEM DETAIL SUMMARY SHEET #1

DESIGNED BY BCE/PJM DATE 6-07

DRAWN BY C.E.A., INC. DATE 6-07

DESIGN FILE NO. p06cl62.dgn

PRF FILE p06cl621dl1 DATE PLOTTED 03-NOV-2009 10

PROJ. NAME: **BELVIDERE - MONTGOMERY**

PROJ. NO.: **STP 2619(1)S**

SHEET **6** OF **33** SHEETS

ITEM DETAIL SUMMARY SHEET 2

LOCATION			MISCELLANEOUS ITEMS						DRAINAGE ITEMS					GUARD RAIL ITEMS										REMARKS
STA	STA	POS.	203.30	301.28	402.12	617.10	653.20	604.412	NEW PIPE					616.35	619.17	621.20	621.205	621.21	621.50	621.60	621.80	676.10	900.680	
			EARTH BORROW	SUBBASE OF CRUSHED GRAVEL, FINE	AGG. SHOULD.	RELOCATE MAILBOX SINGLE SUPPORT	TEMP. EROSION MATTING		REHAB. D.I. CLASS I	DIA.	CSP (0.064)	RCP	CPEP											
			CY	TON	TON	EA	SY	EA	in	LF	LF	LF	LF	EA	LF	LF	LF	EA	EA	LF	EA	TON		
MONTGOMERY CONT'D																								
156+42		LT				±																	RELOCATE MAILBOX, SINGLE SUPPORT	
156+43	157+05	LT			5		25												32.5	1	50	1	ATTACH TO NEW BRIDGE RAIL @ STA. 157+05, COORD. WITH SHEET 31.	
156+55	157+05	RT			5		25								27	32.5	17.5	±	1	50	1	ATTACH TO NEW BRIDGE RAIL @ STA. 157+05, COORD. WITH SHEET 31.		
157+30	157+92	LT			5		25								27			±	1	25	1	ATTACH TO NEW BRIDGE RAIL @ STA. 157+30, COORD. WITH SHEET 31.		
157+30	157+92	RT			5		25											32.5	1	37.5	1	ATTACH TO NEW BRIDGE RAIL @ STA. 157+30, COORD. WITH SHEET 31.		
21	21																							
166+19	171+19	RT	50		10		50								425				2	500	2	REPLACE EXISTING STEEL BEAM GUARD RAIL.		
98	73															812.5								
166+95	175+70	LT	50		10		50									800			2	875	2	REPLACE EXISTING STEEL BEAM GUARD RAIL.		
61	24																							
178+53	182+27	RT	50		10		25			15		30			350			±2	2	362.5	2	REPLACE EXISTING STEEL BEAM GUARD RAIL. INSTALL BURIED END TERMINAL W/CULVERT @ STA 182+27, SEE DETAIL SHEET 32.		
59.5	22															687.5				762.5				
178+53	186+03	LT	50		10	1	50								362.5	312.5			2	750	2	REPLACE EXISTING STEEL BEAM GUARD RAIL. RELOCATE MAILBOX, SINGLE SUPPORT @ STA 185+40.		
7+14.5	89														432.5									
206+02	211+57	RT	50		10		50								420				2	387.5	2	REPLACE 2 SECTIONS OF EXISTING STEEL BEAM GUARD RAIL REDUCED POST SPACING REQUIRED @ STA 211+05, SEE DETAIL, SHEET 32.		
64.5	2+02																							
214+22	221+60	RT	50		10	±	25			15		30			700			±2	2	737.5	2	REPLACE EXIST. S.B. GUARD RAIL. INSTALL B.C.T. W/CULVERT @ STA 214+22, SEE DETAIL SHEET 32, RELOCATE MAILBOX SINGLE SUPPORT @ STA 221+60.		
8+29	90																							
217+88	222+50	LT	50		10		25			15		30			425			±2	2	462.5	2	REPLACE EXISTING STEEL BEAM GUARD RAIL. INSTALL BURIED END TERMINAL W/CULVERT @ STA 217+88, SEE DETAIL SHEET 32.		
3+34	46.5																							
232+91	235+04	RT	50		10		50								137.5				2	212.5	2	REPLACE EXISTING STEEL BEAM GUARD RAIL.		
57	57																							
233+10	235+10	LT	50		10		50								125				2	200	2	REPLACE EXISTING STEEL BEAM GUARD RAIL.		
9+18	93														700					775				
238+58	246+46	LT	50		10	±	50								712.5				2	787.5	2	REPLACE EXISTING STEEL BEAM GUARD RAIL, RELOCATE MAILBOX, SINGLE SUPPORT, STA 238+70.		
5+15	89																							
254+49	257+24	LT	50		10		50								200				2	275	2	REPLACE EXISTING STEEL BEAM GUARD RAIL.		
8+63	60+49																							
257+01	259+78	LT	50		10		50								112.5				2	187.5	2	REPLACE EXISTING STEEL BEAM GUARD RAIL.		
4+35	3+35																							
263+67	272+67	LT	50		10	1	50								825				2	900	2	REPLACE EXISTING STEEL BEAM GUARD RAIL, RELOCATE MAILBOX, SINGLE SUPPORT, STA 269+90.		
98	9+02														300	125								
273+25	278+25	LT	50		10	1	50								225	200			2	500	2	REPLACE EXISTING STEEL BEAM GUARD RAIL.		
293+40		RT								± 0												REHAB D.I.		
SHEET SUB-TOTALS			700	--	160	5 3	725	± 0	15		90	--	--	4,670	1,787.5	130		2930	6-2	7,312.5	32	--		
ID#1 SUB-TOTALS			1,175	250	4,940	±	1,000	2 3	15		240	150	435	10	4876,690	4,197.5	115		40-45	14 3	12,275	-47-8	15,600	
PROJECT SUB-TOTALS			1,875	250	5,100	6 3	1,725	3	15		240	435	10	11,360	5,787.5	115		69-75	20 5	19,587.5	79-80	15,600		
ROUNDING			25	--	--	--	--	--	--		--	--	--	--	40	12.5	130	--	--	162.5	--	--		
PROJECT TOTALS			1,900	250	5,100	6 3	1,725	3	15		240	435	10	11,400	5,800	115		69-75	20 5	19,750	79-80	15,600		


339
639
639

ITEM DETAIL SUMMARY SHEET #2

DESIGNED BY BCE/PJM DATE 6-07
 DRAWN BY C.E.A., INC. DATE 6-07
 DESIGN FILE NO. p06cl62.dgn
 PRF FILE p06cl621d2.1 DATE PLOTTED 03-NOV-2009 10
 PROJ. NAME: **BELVIDERE - MONTGOMERY**
 PROJ. NO.: **STP 2619(1)S**
 SHEET **7** OF **33** SHEETS

LOCATION				FEET OF DITCHING				MISC. ITEMS			REMARKS	LOCATION				FEET OF DITCHING				MISC. ITEMS			REMARKS		
SITE	STATION	STATION	POS.	PERCENT GRADE				653.20	613.10	649.31		SITE	STATION	STATION	POS.	PERCENT GRADE				653.20	613.10	649.31			
				0-1	1-2.5	2.5-10	>10	TEMP. EROS. MATT.	STONE FILL TYP. I	GEOT. UNDER STONE FILL						0-1	1-2.5	2.5-10	>10	TEMP. EROS. MATT.	STONE FILL TYP. I	GEOT. UNDER STONE FILL			
																								0-1	1-2.5
VT ROUTE 118, BELVIDERE DISTRICT #8								SY	CY	SY									SY	CY	SY				
1	55+10	59+00	RT	390																					
2	59+00	66+10	LT		380	330		169	49	220															
3	72+15	77+75	LT	560																					
4	123+65	133+00	LT		345	590		153	87	393															
5	144+30	149+40	LT			510			75	340															
6	144+30	150+30	RT			600			89	400															
VT ROUTE 118, MONTGOMERY																									
7	18+00	43+60	RT	330		2,230			330	1,487															
8	55+80	71+80	RT		1,600			711																	
9	78+00	81+80	RT			380			56	253															
10	92+50	95+00	LT&RT			500			74	333															
11	111+50	118+90	RT		410	330		182	49	220															
12	111+90	117+00	LT		290	220		129	32	147															
13	134+50	148+90	LT	800		640			95	427															
14	134+50	149+20	RT	800		670			99	447															
15	157+70	166+00	RT	830																					
16	171+20	178+50	RT	730																					
17	182+30	190+30	RT		800			355																	
18	211+60	214+10	RT			250			37	167															
19	221+80	232+70	RT	320		770			114	513															
20	235+10	238+50	LT		340			151																	
21	235+00	239+00	RT		400			178																	
22	246+70	255+80	RT		910			404																	
23	259+20	274+20	RT	1,500																					
24	277+20	286+30	RT		330	580		147	86	387															
PROJECT SUBTOTALS				6,260	5,805	8,600		2,579	1,272	5,734															
ROUNDING				40	45	50		21	8	16															
PROJECT TOTALS				6,300	5,850	8,650		2,600	1,280	5,750															

SEE LAYOUT SHEETS FOR LOCATION CHANGES

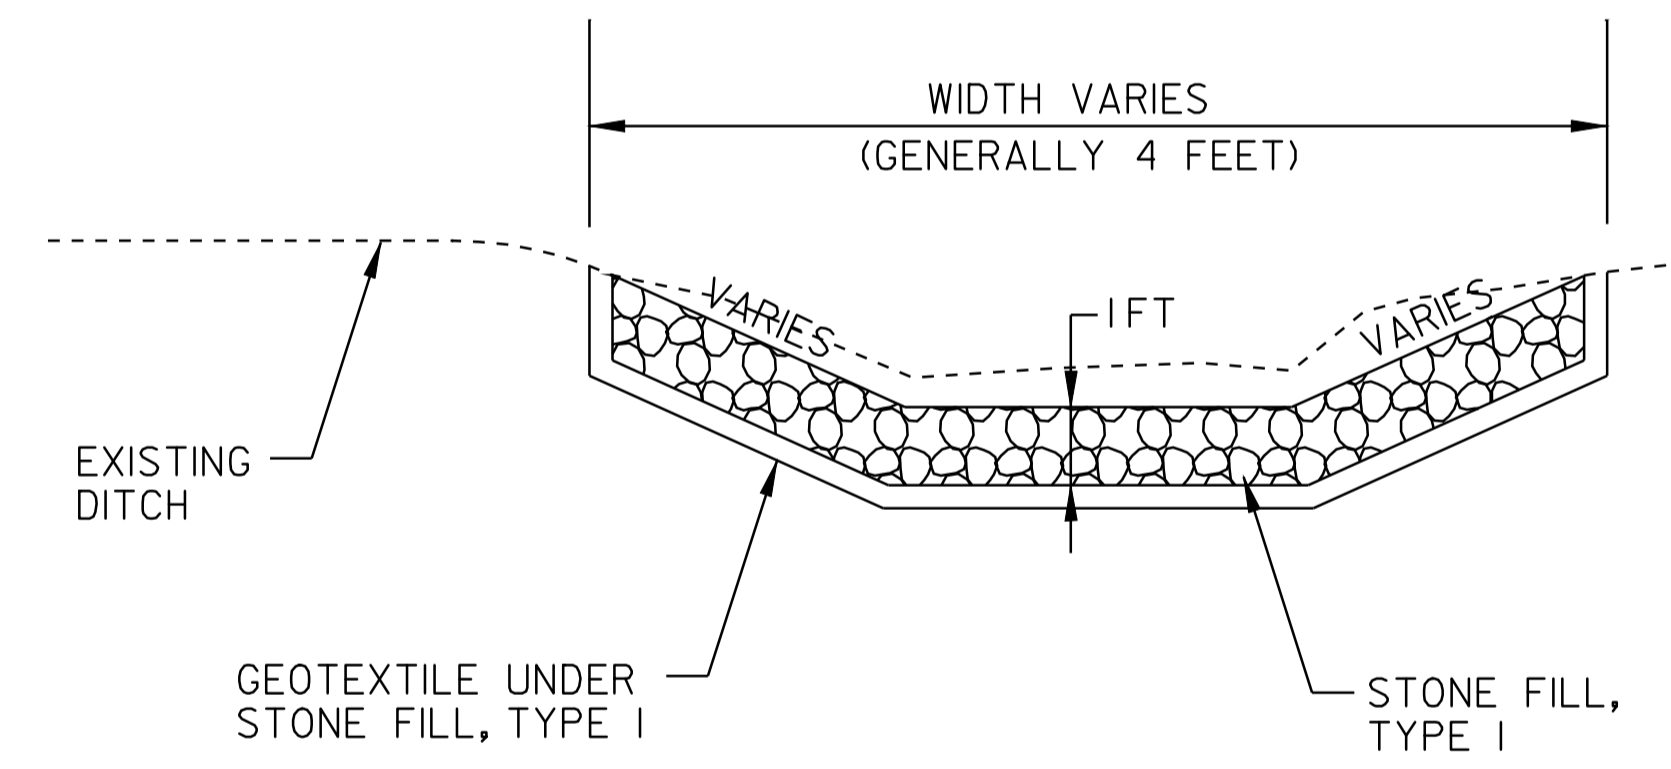

DITCH DETAIL
NOT TO SCALE

- NOTES:
- PIPE INLET AND OUTLET AREAS, AND DITCH CLEANING THROUGH PROJECT, SHALL BE PERFORMED AT LOCATIONS INDICATED ON THIS SHEET AND AS DIRECTED BY THE RESIDENT ENGINEER. PAYMENT WILL BE UNDER THE APPLICABLE EQUIPMENT RENTAL ITEMS).
 - ESTIMATED QUANTITIES OF TEMPORARY EROSION MATTING, SEED, AND STONE FILL TYPE I HAVE BEEN INCLUDED AS NEEDED. DITCHES WITH A GRADE LESS THAN 1 PERCENT SHALL BE SEEDED. TEMPORARY EROSION MATTING SHALL BE USED IN ALL DITCHES WITH A GRADE BETWEEN 1 AND 2 1/2 PERCENT AND STONE FILL TYPE I SHALL BE USED IN ALL DITCHES WITH A GRADE BETWEEN 2 1/2 AND 10 PERCENT.

DITCH CLEANING DETAIL SHEET	PROJECT : BELVIDERE - MONTGOMERY	PROJECT NO. : STP 2619(I)S
	DESIGN FILE NAME: p06cl62.dgn	
	IPARM FILE NAME: p06cl62ded.i	PLOT DATE: 03-NOV-2009
	SURVEYED BY: CEA	SURVEY DATE:
	SQUAD LEADER: BCE	DRAWN BY: PJM
	SHEET: 8 OF 33	

TEMPORARY 4in YELLOW LINE (PAINT)
 DURABLE 4in YELLOW LINE (THERMOPLASTIC)

65 STA 29+57 TO 34+30 25
 25 STA 34+30 TO 41+70 57
 57 STA 41+70 TO 42+20 15
 15 STA 42+20 TO 49+10 05
 05 STA 49+10 TO 75+50

SOLID LT&RT
 SOLID LT & DASHED RT
 SOLID LT&RT
 DASHED LT & SOLID RT
 SOLID LT&RT

TEMPORARY 4in WHITE LINE (PAINT)
 DURABLE 4in WHITE LINE (THERMOPLASTIC)

STA 29+57 TO 75+50
 65


SOLID LT&RT

CURVE #1
 PC = 32+10
 PT = 37+50
 R = 2,000ft - RT
 SEE SHEET 18 FOR
 SUPERELEVATION DIAGRAM

CURVE #2
 PC = 45+60
 PT = 51+90
 R = 1,900ft - LT
 SEE SHEET 18 FOR
 SUPERELEVATION DIAGRAM

CURVE #4
 PC = 62+10
 PT = 67+40
 R = 2,000ft - LT
 SEE SHEET 19 FOR
 SUPERELEVATION DIAGRAM

CURVE #3
 PC = 55+60
 PT = 58+00
 R = 5,000ft - RT
 SEE SHEET 19 FOR
 SUPERELEVATION DIAGRAM

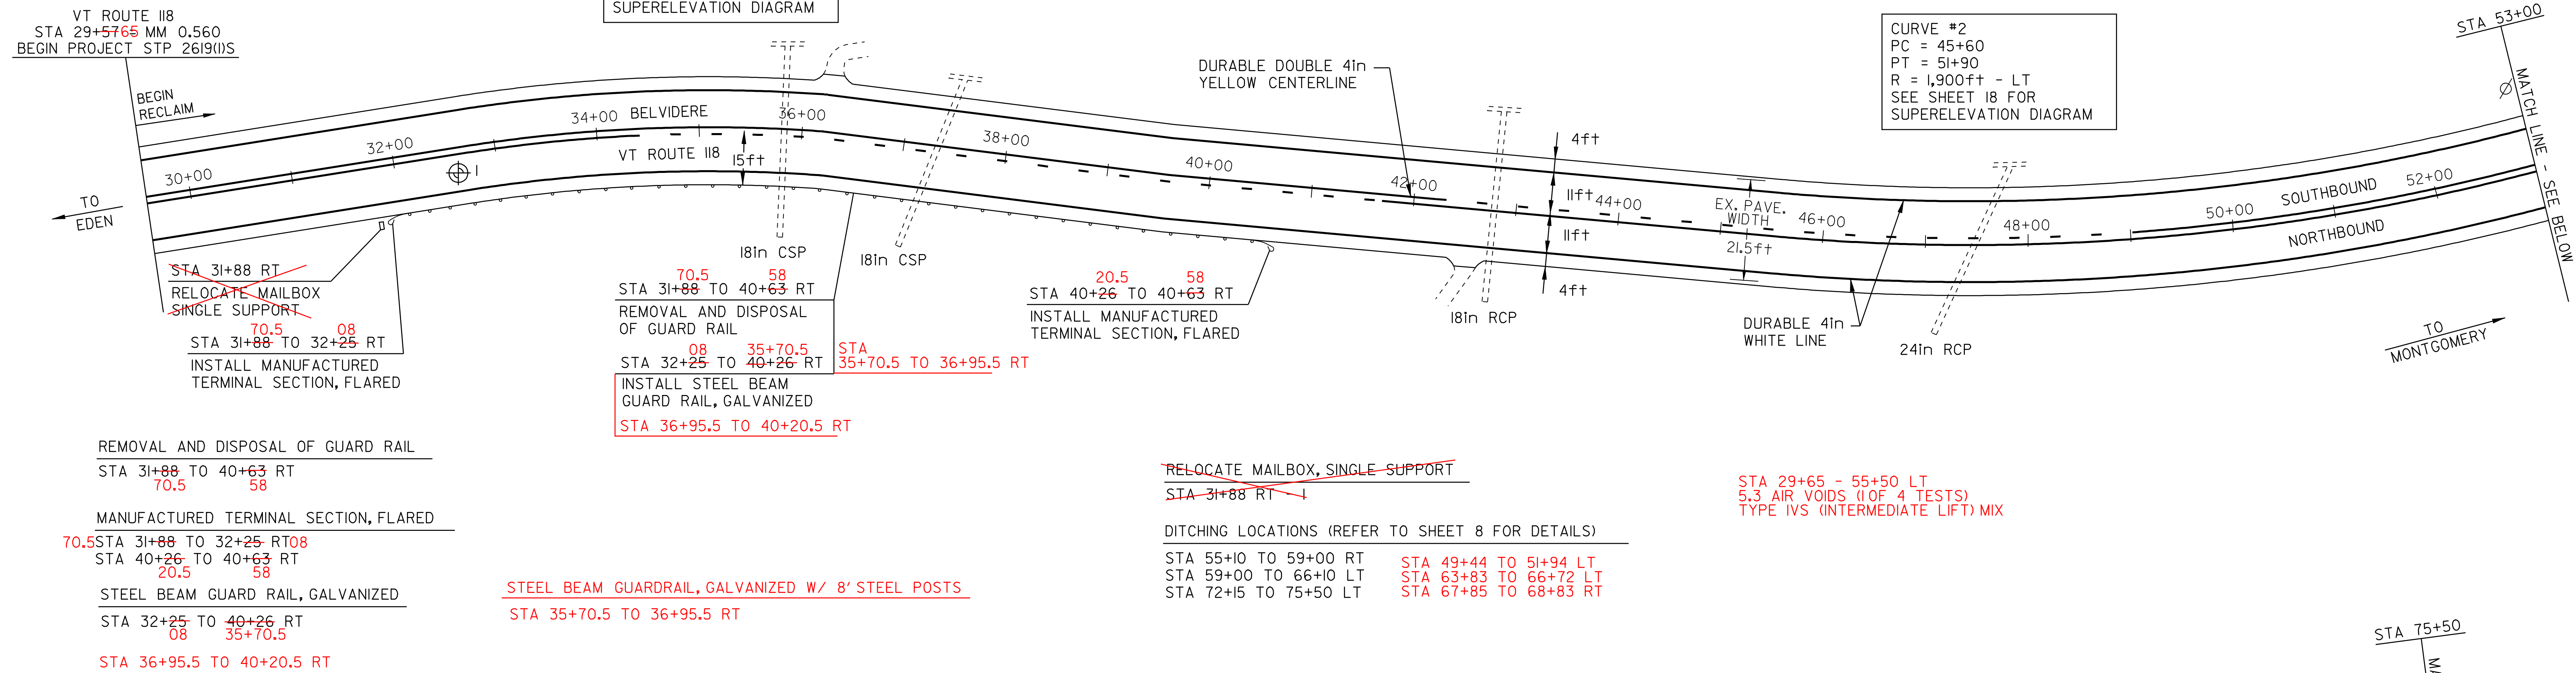

REMOVAL AND DISPOSAL OF GUARD RAIL
 STA 31+88 TO 40+63 RT
 70.5 58

MANUFACTURED TERMINAL SECTION, FLARED
 70.5 STA 31+88 TO 32+25 RT 08
 STA 40+26 TO 40+63 RT 58


STEEL BEAM GUARD RAIL, GALVANIZED
 STA 32+25 TO 40+26 RT 08
 STA 35+70.5 TO 40+20.5 RT

~~RELOCATE MAILBOX, SINGLE SUPPORT~~
~~STA 31+88 RT~~

DITCHING LOCATIONS (REFER TO SHEET 8 FOR DETAILS)
 STA 55+10 TO 59+00 RT
 STA 59+00 TO 66+10 LT
 STA 72+15 TO 75+50 LT

STA 49+44 TO 51+94 LT
 STA 63+83 TO 66+72 LT
 STA 67+85 TO 68+83 RT

STA 29+65 - 55+50 LT
 5.3 AIR VOIDS (1 OF 4 TESTS)
 TYPE IVS (INTERMEDIATE LIFT) MIX

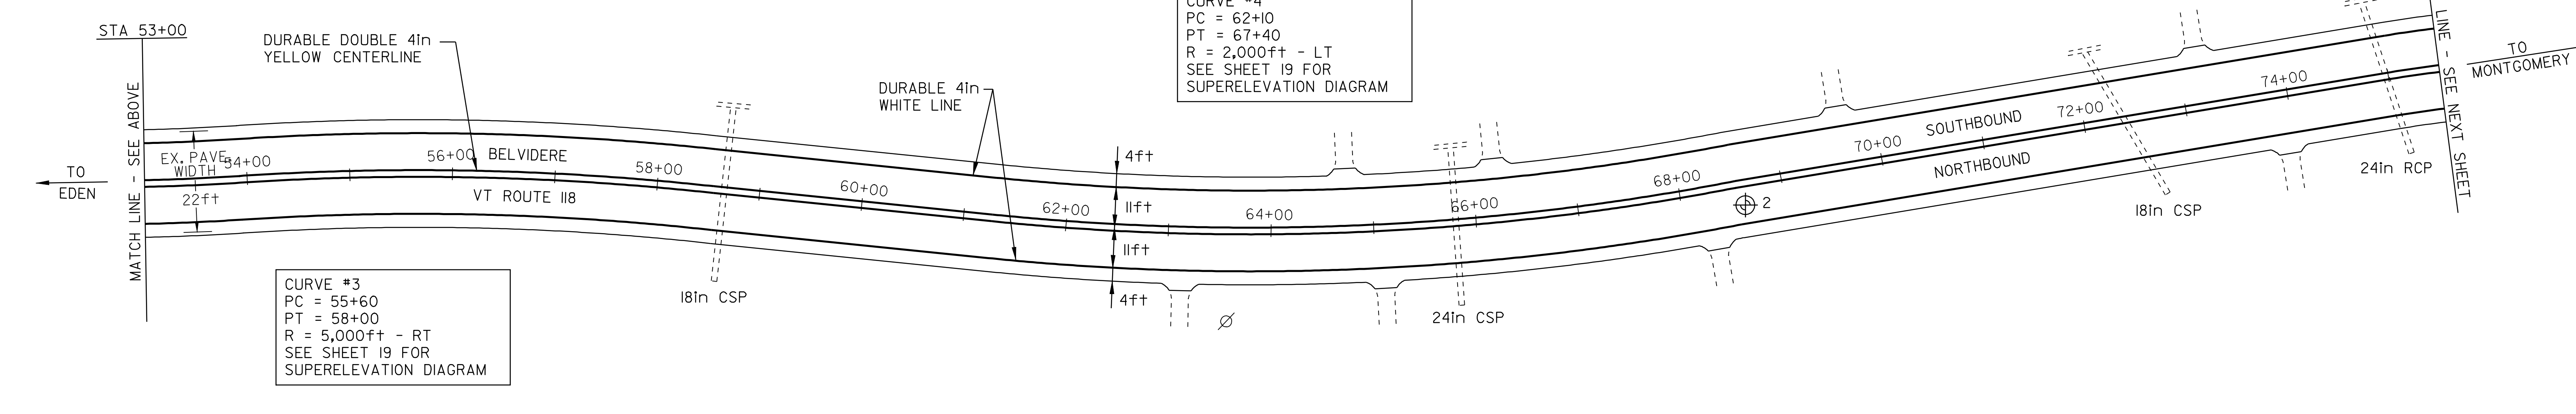

PAVEMENT CORES -

#	TOTAL DEPTH (in)	SOLID CORE	DRAINABLE BASE	COMMENTS
1	5.0	NO	YES	RUT 1 1/2" S.B.
2	4.0	YES	YES	RUT 1/2"

NOTE:
 - NO PCC UNDER ANY CORES
 - NO CORES OVER ASPHALTED
 - NO SHOULDER CORES


- LEGEND
- N = NEW
 - R = REMOVE
 - R&S = REMOVE & SALVAGE
 - S = SALVAGE
 - RET = RETAIN
 - B-TO-B = BACK TO BACK
 - CATCH BASIN/DI
 - EXISTING THROAT DI
 - (N.W.) NO WORK REQUIRED (TYP. FOR W.V.'S, C.S.'S, D.I.'S, C.B.'S WHERE NOTED)
 - YIELDING MARKER POST
 - UTILITY POLE
 - DRIVE

PAVING PROJECT LAYOUT SHEET #1

DESIGNED BY BCE/PJM DATE 6-07
 DRAWN BY C.E.A., INC. DATE 6-07
 DESIGN FILE NO. p06cl62.dgn
 PRF FILE p06cl62pp1.i DATE PLOTTED 03-NOV-2009
 PROJ. NAME **BELVIDERE - MONTGOMERY**
 PROJ. NO. **STP 2619(1)S**
 SHEET **9** OF **33** SHEETS

TEMPORARY 4in YELLOW LINE (PAINT)
DURABLE 4in YELLOW LINE (THERMOPLASTIC)

TEMPORARY 4in WHITE LINE (PAINT)
DURABLE 4in WHITE LINE (THERMOPLASTIC)

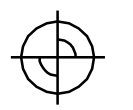PAVEMENT CORES - 

STA 75+50 TO 97+65 SOLID LT&RT
STA 97+65 TO 105+58.60 SOLID LT & DASHED RT
60 STA 105+58 TO 113+50.40 DASHED
40 STA 113+50 TO 120+87.12+00 DASHED LT & SOLID RT
STA 120+87 TO 121+00 SOLID LT&RT


STA 75+50 TO 121+00 SOLID LT&RT

#	TOTAL DEPTH (in)	SOLID CORE	DRAINABLE BASE	COMMENTS
3	4.25	YES	YES	

NOTE:
- NO PCC UNDER ANY CORES
- NO CORES OVER ASPHALTED
- NO SHOULDER CORES

CURVE #5
PC = 75+70
PT = 82+50
R = 975ft - RT
SEE SHEET 19 FOR SUPERELEVATION DIAGRAM

CURVE #6
PC = 86+20
PT = 99+90
R = 1,950ft - LT
SEE SHEET 19 FOR SUPERELEVATION DIAGRAM

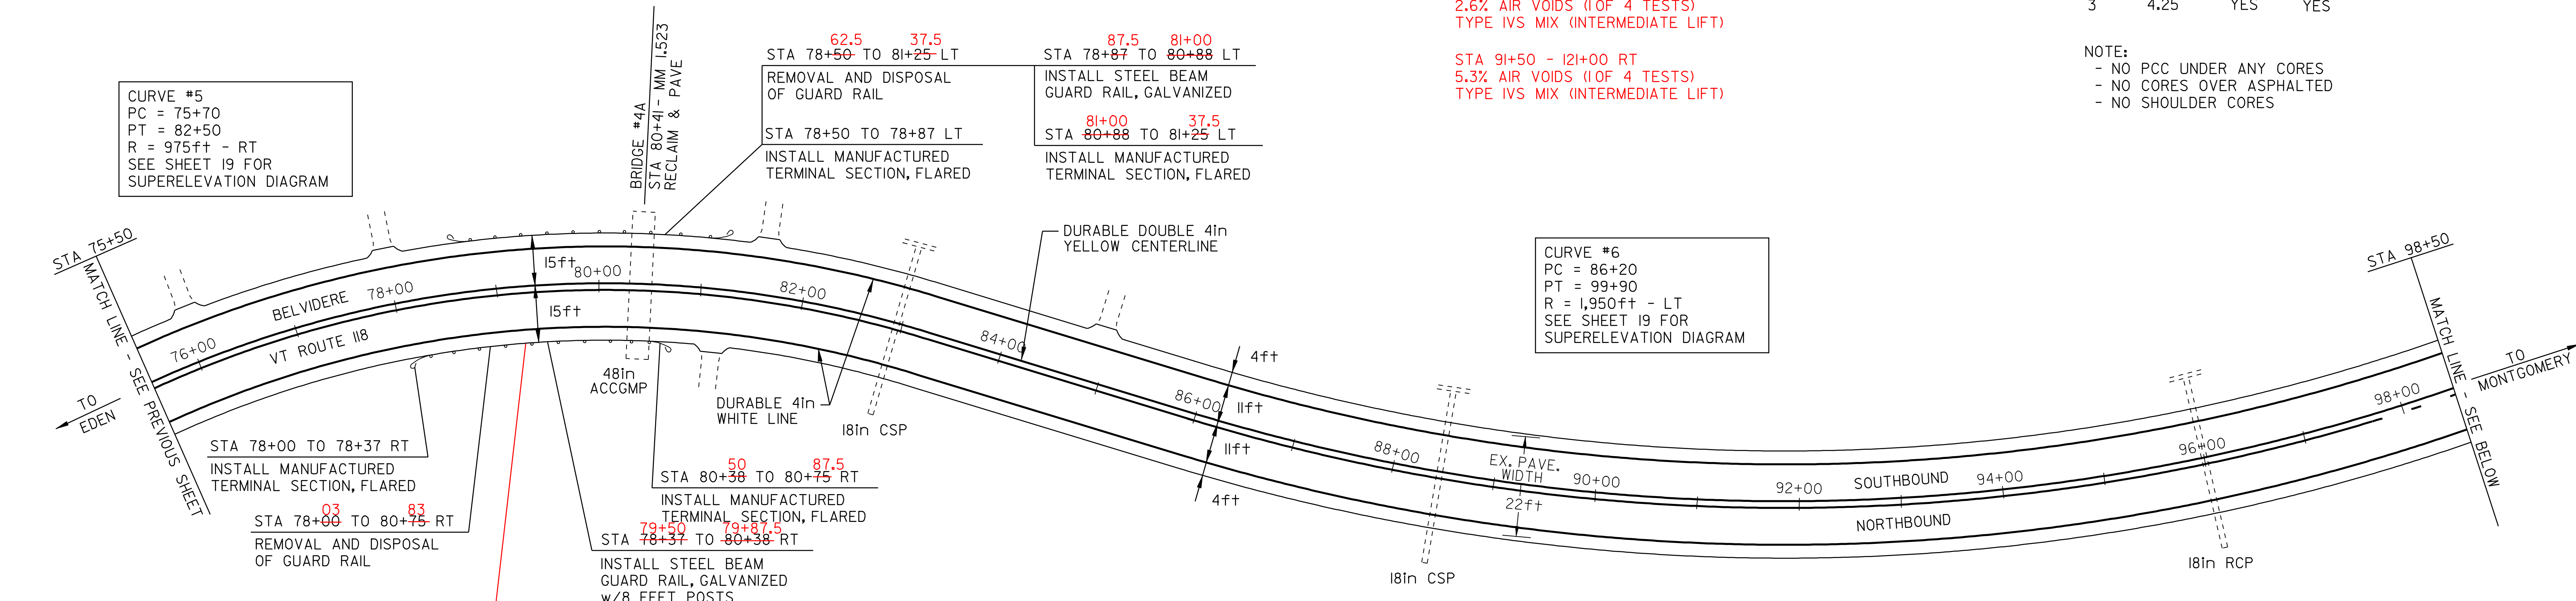

STA 78+37 TO 79+50 RT
STA 79+87.5 TO 80+50 RT
STEEL BEAM GUARDRAIL, GALVANIZED

REMOVAL AND DISPOSAL OF GUARD RAIL
STA 78+00 TO 80+75 RT 83
62.5 STA 78+50 TO 81+25 LT 37.5
STA 102+60 TO 106+35 RT 9
STA 104+00 TO 106+00 LT 3
STA 114+94 TO 119+69 LT 9
STA 116+05 TO 121+00 RT 15+83.5


MANUFACTURED TERMINAL SECTION, FLARED
STA 78+00 TO 78+37 RT
STA 78+50 TO 78+87 LT
50 STA 80+38 TO 80+75 RT 87.5
81+00 STA 80+88 TO 81+25 LT 37.5
39 STA 102+60 TO 102+97 RT 76.5
03 STA 104+00 TO 104+37 LT 40.5
65.5 STA 105+63 TO 106+00 LT 03
106+01 STA 105+98 TO 106+35 RT 39
115+04 STA 114+94 TO 115+32 LT 41.5
115+83.5 STA 116+05 TO 116+42 RT 21
54 STA 119+32 TO 119+69 LT 91.5

DITCHING LOCATIONS (REFER TO SHEET 8 FOR DETAILS)
STA 75+50 TO 77+75 LT
STA 95+95 TO 97+03 LT
STEEL BEAM GUARDRAIL, GALVANIZED W/ 8' STEEL POSTS
STA 116+16.5 TO 119+41.5 LT
STA 119+41.5 TO 119+54 LT

STA 104+00 TO 106+00 LT 03
REMOVAL AND DISPOSAL OF GUARD RAIL
STA 104+00 TO 104+37 LT 03
INSTALL MANUFACTURED TERMINAL SECTION, FLARED
STA 104+37 TO 105+63 LT 40.5
INSTALL STEEL BEAM GUARD RAIL, GALVANIZED W/8 FEET POSTS
STA 105+63 TO 106+00 LT 65.5
INSTALL MANUFACTURED TERMINAL SECTION, FLARED

STEEL BEAM GUARD RAIL, GALVANIZED W/8 FEET POSTS
STA 78+37 TO 80+38 RT 79+50
STA 104+37 TO 105+63 LT 65.5
STA 116+16.5 TO 119+41.5 LT
STEEL BEAM GUARD RAIL, GALVANIZED
STA 78+87.5 TO 80+88 LT 81+00
76.5 STA 102+97 TO 105+98 RT 01.5
41.5 STA 115+32 TO 119+32 LT 16.5
STA 116+42 TO 121+00 RT 21
STA 78+37 TO 79+50 RT
STA 79+87.5 TO 80+50 RT
STA 119+41.5 TO 119+54 LT



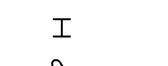
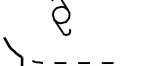
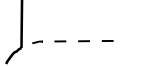
STA 115+04 TO 119+69 LT 79
REMOVAL AND DISPOSAL OF GUARD RAIL
STA 115+04 TO 115+32 LT 41.5
INSTALL MANUFACTURED TERMINAL SECTION, FLARED
STA 116+16.5 TO 119+41.5 LT 41.5
INSTALL STEEL BEAM GUARD RAIL, GALVANIZED
STA 119+32 TO 119+69 LT 91.5
INSTALL MANUFACTURED TERMINAL SECTION, FLARED

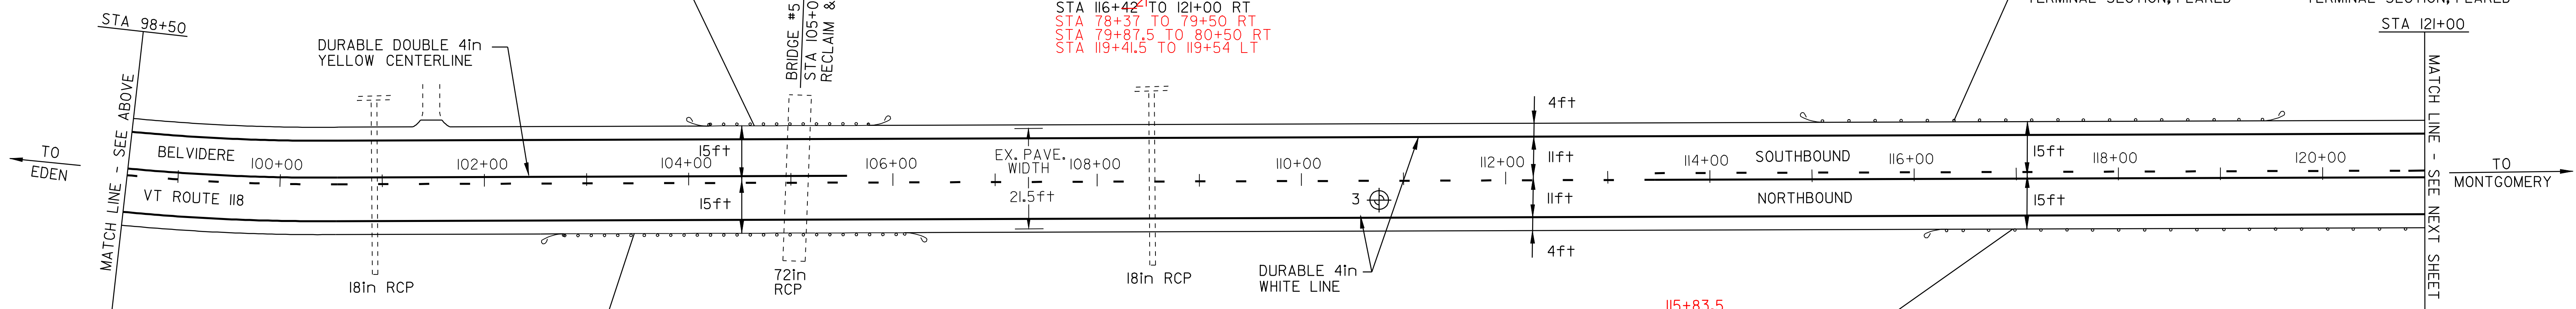

STA 102+60 TO 106+35 RT 62
REMOVAL AND DISPOSAL OF GUARD RAIL
STA 102+60 TO 102+97 RT 39
INSTALL MANUFACTURED TERMINAL SECTION, FLARED
STA 102+97 TO 105+98 RT 76.5
INSTALL STEEL BEAM GUARD RAIL, GALVANIZED
STA 105+98 TO 106+35 RT 39
INSTALL MANUFACTURED TERMINAL SECTION, FLARED

STA 115+83.5 TO 121+00 RT 21
REMOVAL AND DISPOSAL OF GUARD RAIL
STA 115+83.5 TO 116+42 RT 21
INSTALL MANUFACTURED TERMINAL SECTION, FLARED
STA 116+42 TO 121+00 RT 21
INSTALL STEEL BEAM GUARD RAIL, GALVANIZED

LEGEND

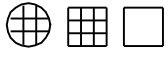N	= NEW
R	= REMOVE
R&S	= REMOVE & SALVAGE
S	= SALVAGE
RET	= RETAIN
B-TO-B	= BACK TO BACK
	CATCH BASIN/DI
	EXISTING THROAT DI
(N.W.)	NO WORK REQUIRED (TYP. FOR W.V.'S, C.S.'S, D.I.'S, C.B.'S WHERE NOTED)
	YIELDING MARKER POST
	UTILITY POLE
	DRIVE

PAVING PROJECT LAYOUT SHEET #2


DESIGNED BY	BCE/PJM	DATE	6-07
DRAWN BY	C.E.A., INC.	DATE	6-07
DESIGN FILE NO.	p06cl62.dgn		
PRF FILE	p06cl62ppi2.i	DATE PLOTTED	03-NOV-2009
PROJ. NAME	BELVIDERE - MONTGOMERY		
PROJ. NO.	STP 2619(1)S		
SHEET	10	OF	33 SHEETS

TEMPORARY 4in YELLOW LINE (PAINT)
DURABLE 4in YELLOW LINE (THERMOPLASTIC)

TOWN OF BELVIDERE
STA 121+00 TO 149+37-33
STA 149+37-33 TO 154+23
STA 121+00 TO 121+10
TOWN OF MONTGOMERY
STA 0+00 TO 1+57-52
52 STA 1+57 TO 2+36-88
88 STA 2+36 TO 8+98-9+08
STA 8+98 TO 13+00
9+08


TEMPORARY 4in WHITE LINE (PAINT)
DURABLE 4in WHITE LINE (THERMOPLASTIC)

TOWN OF BELVIDERE
STA 121+00 TO 154+23
TOWN OF MONTGOMERY
STA 0+00 TO 13+00

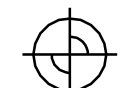PAVEMENT CORES - 

#	TOTAL DEPTH (in)	SOLID CORE	DRAINABLE BASE	COMMENTS
4	7.0	YES	YES	LITTLE RUT, LEVELED

NOTE:
- NO PCC UNDER ANY CORES
- NO CORES OVER ASPHALTED
- NO SHOULDER CORES

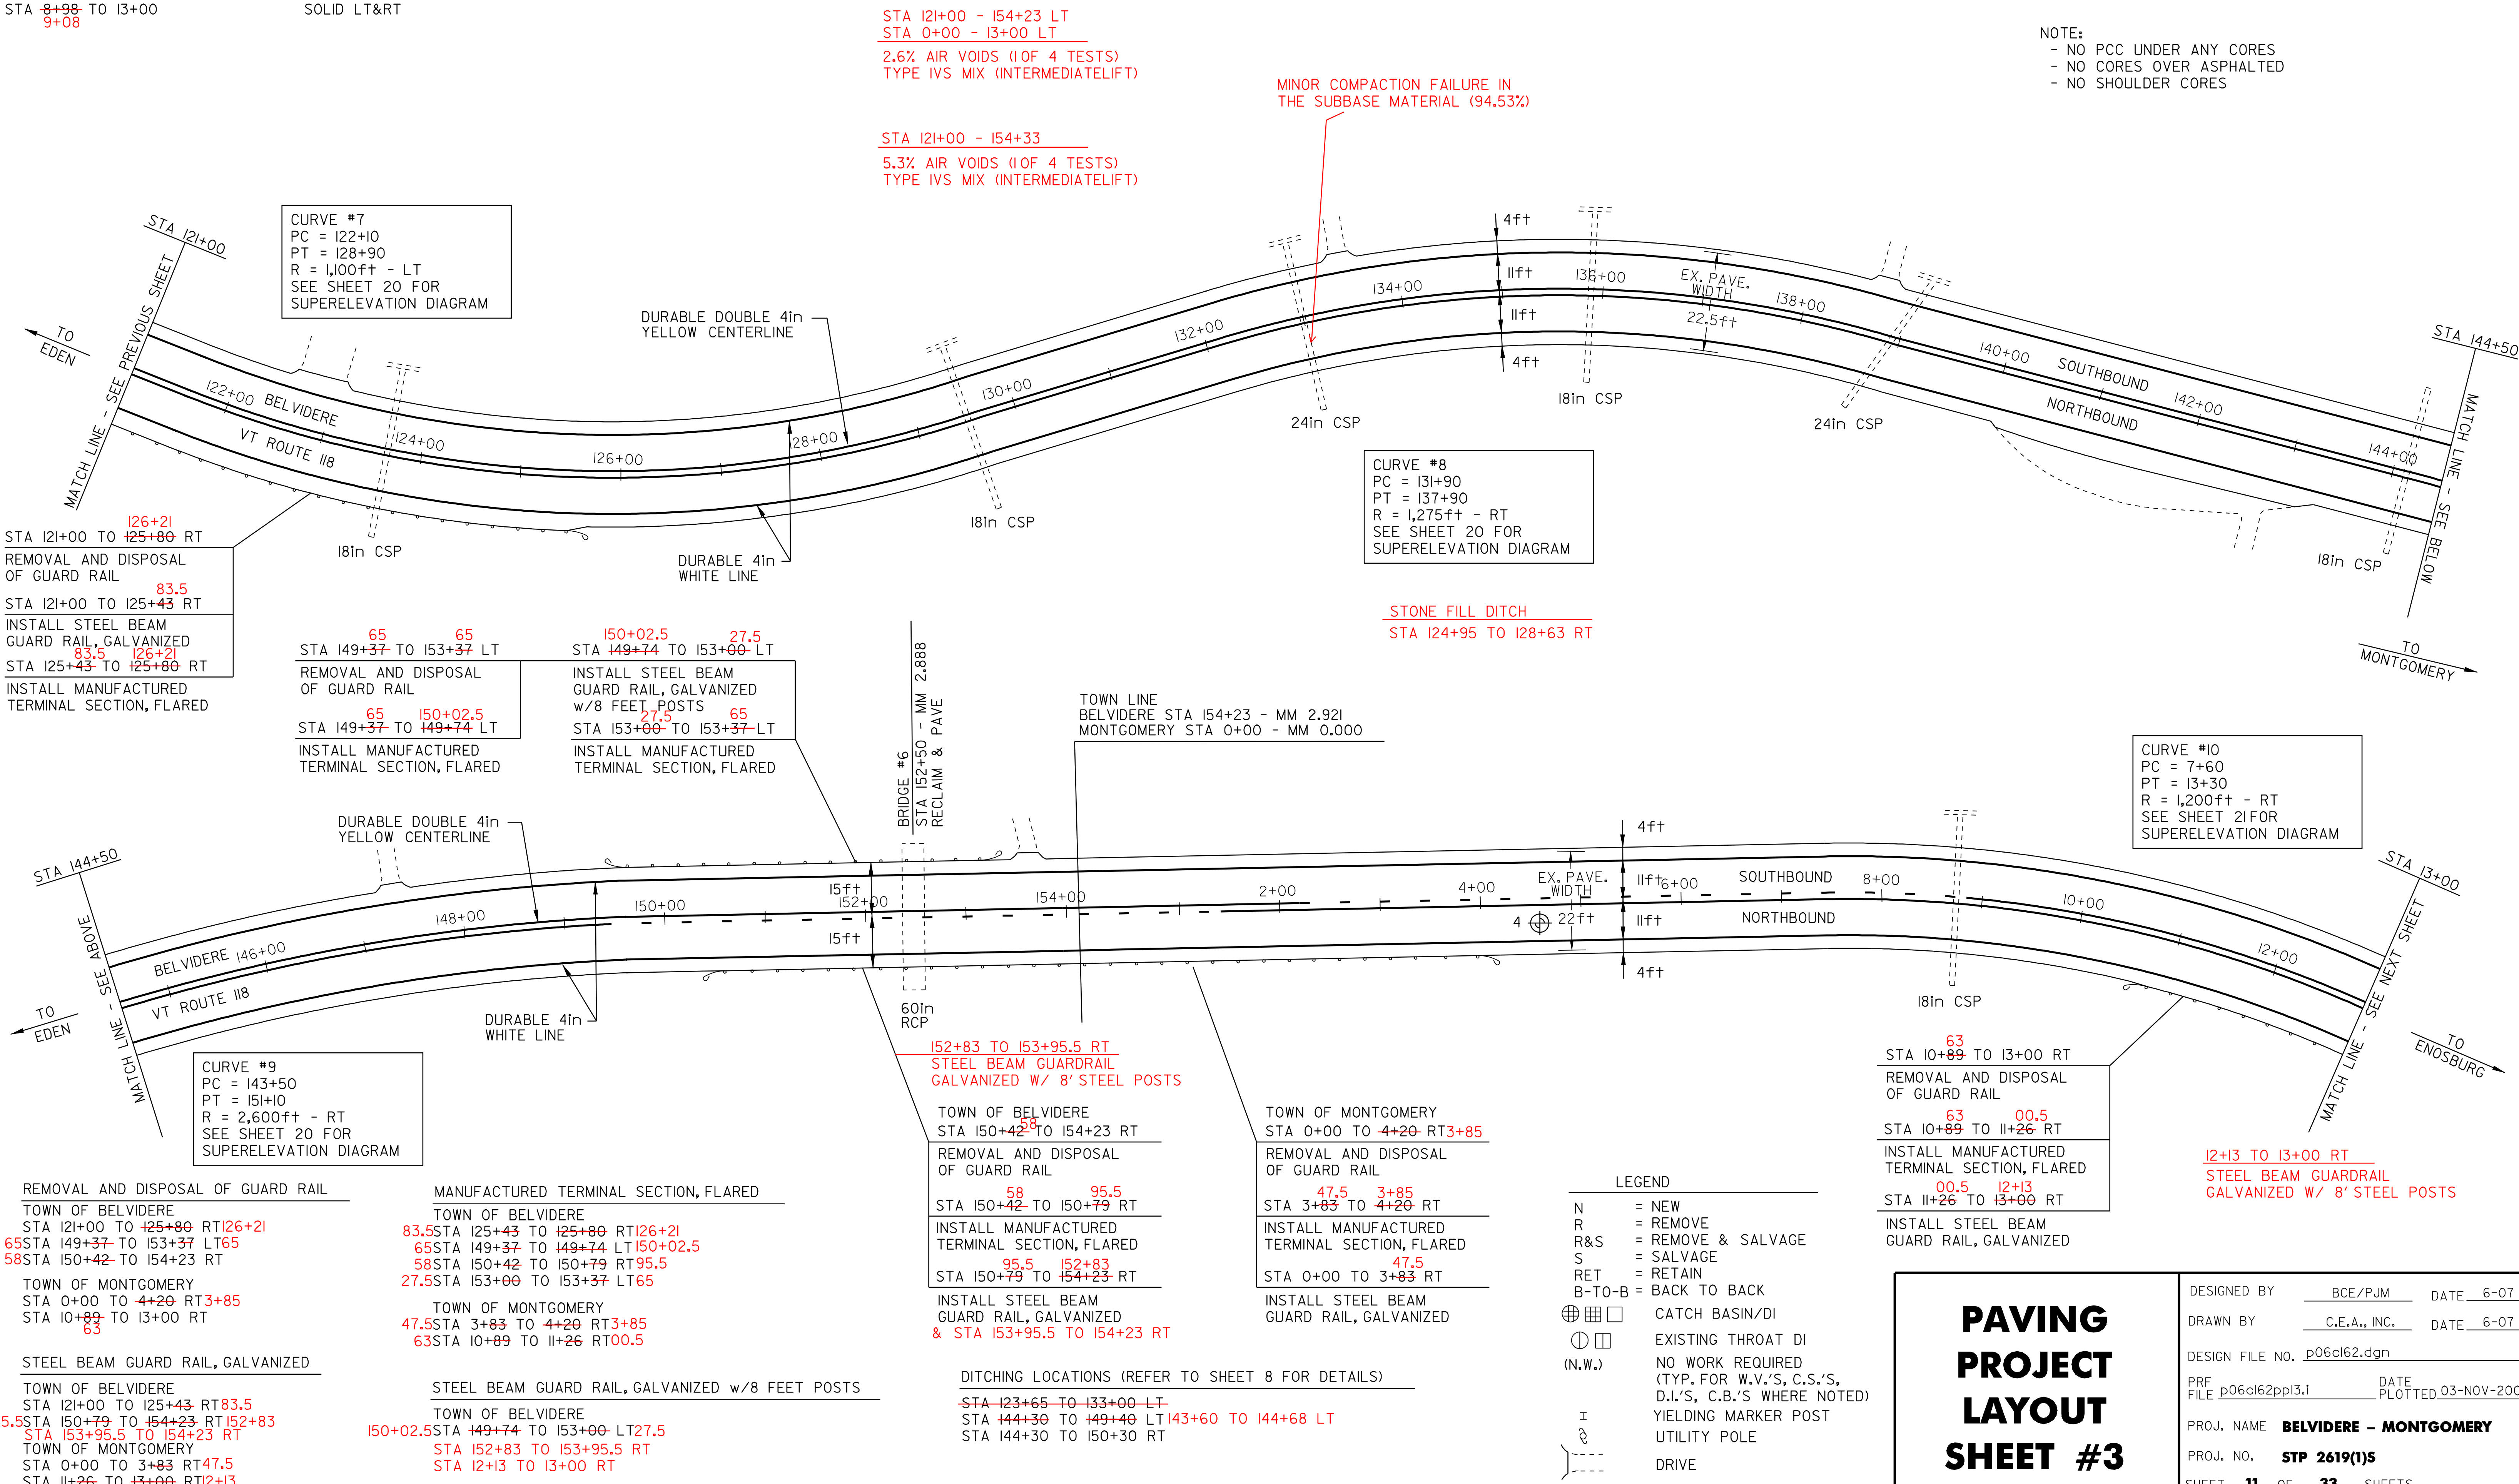

126+21
STA 121+00 TO 125+80 RT
REMOVAL AND DISPOSAL OF GUARD RAIL
83.5
STA 121+00 TO 125+43 RT
INSTALL STEEL BEAM GUARD RAIL, GALVANIZED
83.5 126+21
STA 125+43 TO 125+80 RT
INSTALL MANUFACTURED TERMINAL SECTION, FLARED

65 65
STA 149+37 TO 153+37 LT
REMOVAL AND DISPOSAL OF GUARD RAIL
65 150+02.5
STA 149+37 TO 149+74 LT
INSTALL MANUFACTURED TERMINAL SECTION, FLARED

150+02.5 27.5
STA 149+74 TO 153+00 LT
INSTALL STEEL BEAM GUARD RAIL, GALVANIZED W/ 8 FEET POSTS
27.5 65
STA 153+00 TO 153+37 LT
INSTALL MANUFACTURED TERMINAL SECTION, FLARED

BRIDGE #6
STA 152+50 - MM 2.888
RECLAIM & PAVE

TOWN LINE
BELVIDERE STA 154+23 - MM 2.921
MONTGOMERY STA 0+00 - MM 0.000

63
STA 10+89 TO 13+00 RT
REMOVAL AND DISPOSAL OF GUARD RAIL
63 00.5
STA 10+89 TO 11+26 RT
INSTALL MANUFACTURED TERMINAL SECTION, FLARED
00.5 12+13
STA 11+26 TO 13+00 RT
INSTALL STEEL BEAM GUARD RAIL, GALVANIZED




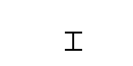
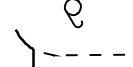
12+13 TO 13+00 RT
STEEL BEAM GUARDRAIL GALVANIZED W/ 8' STEEL POSTS

REMOVAL AND DISPOSAL OF GUARD RAIL
TOWN OF BELVIDERE
STA 121+00 TO 125+80 RT 126+21
65 STA 149+37 TO 153+37 LT 65
58 STA 150+42 TO 154+23 RT
TOWN OF MONTGOMERY
STA 0+00 TO 4+20 RT 3+85
STA 10+89 TO 13+00 RT 63

MANUFACTURED TERMINAL SECTION, FLARED
TOWN OF BELVIDERE
83.5 STA 125+43 TO 125+80 RT 126+21
65 STA 149+37 TO 149+74 LT 150+02.5
58 STA 150+42 TO 150+79 RT 95.5
27.5 STA 153+00 TO 153+37 LT 65
TOWN OF MONTGOMERY
47.5 STA 3+83 TO 4+20 RT 3+85
63 STA 10+89 TO 11+26 RT 00.5

152+83 TO 153+95.5 RT
STEEL BEAM GUARDRAIL GALVANIZED W/ 8' STEEL POSTS
TOWN OF BELVIDERE
STA 150+42 TO 154+23 RT
REMOVAL AND DISPOSAL OF GUARD RAIL
58 95.5
STA 150+42 TO 150+79 RT
INSTALL MANUFACTURED TERMINAL SECTION, FLARED
95.5 152+83
STA 150+79 TO 154+23 RT
INSTALL STEEL BEAM GUARD RAIL, GALVANIZED
& STA 153+95.5 TO 154+23 RT

TOWN OF MONTGOMERY
STA 0+00 TO 4+20 RT 3+85
REMOVAL AND DISPOSAL OF GUARD RAIL
47.5 3+85
STA 3+83 TO 4+20 RT
INSTALL MANUFACTURED TERMINAL SECTION, FLARED
47.5
STA 0+00 TO 3+83 RT
INSTALL STEEL BEAM GUARD RAIL, GALVANIZED

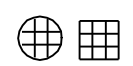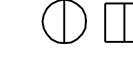- LEGEND
- N = NEW
 - R = REMOVE
 - R&S = REMOVE & SALVAGE
 - S = SALVAGE
 - RET = RETAIN
 - B-TO-B = BACK TO BACK
 -  CATCH BASIN/DI
 -  EXISTING THROAT DI
 - (N.W.) NO WORK REQUIRED (TYP. FOR W.V.'S, C.S.'S, D.I.'S, C.B.'S WHERE NOTED)
 -  YIELDING MARKER POST
 -  UTILITY POLE
 -  DRIVE

PAVING PROJECT LAYOUT SHEET #3

DESIGNED BY BCE/PJM DATE 6-07
DRAWN BY C.E.A., INC. DATE 6-07
DESIGN FILE NO. p06cl62.dgn
PRF FILE p06cl62pp13.i DATE PLOTTED 03-NOV-2009
PROJ. NAME BELVIDERE - MONTGOMERY
PROJ. NO. STP 2619(1)S
SHEET 11 OF 33 SHEETS

TEMPORARY 4in YELLOW LINE (PAINT)
DURABLE 4in YELLOW LINE (THERMOPLASTIC)


STA 13+00 TO 36+93.37+60 SOLID LT&RT
STA 736+93 TO 44+87.45+15 SOLID LT & DASHED RT
STA 44+87 TO 60+50 DASHED
45+15

TEMPORARY 4in WHITE LINE (PAINT)
DURABLE 4in WHITE LINE (THERMOPLASTIC)

STA 13+00 TO 60+50 SOLID LT&RT

REHABILITATION OF C.B.'S, D.I.'S, OR M.H.'S

STA 26+30 RT
STA 31+32 RT

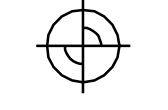PAVEMENT CORES - 

#	TOTAL DEPTH (in)	SOLID CORE	DRAINABLE BASE	COMMENTS
5	5.0	NO	NO	BROKE UP, END OF LEVELING

NOTE:
- NO PCC UNDER ANY CORES
- NO CORES OVER ASPHALTED
- NO SHOULDER CORES

STA 14+00 TO 18+12.5 LT
STEEL BEAM GUARDRAIL GALVANIZED W/ 8' STEEL POSTS

62.5 00
STA 13+89 TO 14+26 LT
INSTALL MANUFACTURED TERMINAL SECTION, FLARED

63
STA 13+00 TO 15+88 RT
REMOVAL AND DISPOSAL OF GUARD RAIL

15+00.5 25.5
STA 13+00 TO 15+51 RT
INSTALL STEEL BEAM GUARD RAIL, GALVANIZED

25.5 63
STA 15+51 TO 15+88 RT
INSTALL MANUFACTURED TERMINAL SECTION, FLARED

13+00 TO 15+00.5 RT
STEEL BEAM GUARDRAIL GALVANIZED W/ 8' STEEL POSTS

13.5 51
STA 37+29 TO 37+66 LT
INSTALL MANUFACTURED TERMINAL SECTION, FLARED

13.5 51
STA 37+29 TO 37+66 LT
INSTALL MANUFACTURED TERMINAL SECTION, FLARED

70 19+85
STA 13+89 TO 20+14 LT
REMOVAL AND DISPOSAL OF GUARD RAIL

18+12.5 19+87.5
STA 14+26 TO 20+14 LT
INSTALL STEEL BEAM GUARD RAIL, GALVANIZED

16+20 LT
REDUCED POST SPACING REQUIRED, SEE DETAIL, SHEET 32.

16+00 18+00 20+00
MONTGOMERY
VT ROUTE 118

16+00 18+00 20+00
MONTGOMERY
VT ROUTE 118

20+14 LT
INSTALL BURIED END TERMINAL, SEE SHEET 32 FOR DETAIL

20+14 LT
INSTALL BURIED END TERMINAL, SEE SHEET 32 FOR DETAIL

19+87.5 TO 20+25 LT
MANUFACTURED TERMINAL SECTION, FLARED

19+87.5 TO 20+25 LT
MANUFACTURED TERMINAL SECTION, FLARED

38.5 22+76
STA 22+66 TO 23+03 LT
INSTALL MANUFACTURED TERMINAL SECTION, FLARED

38.5 51
STA 22+66 TO 37+66 LT
REMOVAL AND DISPOSAL OF GUARD RAIL

22+76 13.5
STA 23+03 TO 24+03 LT
INSTALL STEEL BEAM GUARD RAIL, GALVANIZED

22+76 13.5
STA 23+03 TO 24+03 LT
INSTALL STEEL BEAM GUARD RAIL, GALVANIZED

34+76 TO 35+26 LT
REDUCED SPC. 50' x 1.4

35+26 TO 36+26 LT

13.5 28+13.5
STA 24+03 TO 29+28 LT
INSTALL STEEL BEAM GUARD RAIL, GALVANIZED

65 00
STA 24+85 TO 29+20 LT
INSTALL TREATED TIMBER CURB

36+26 13.5
STA 29+28 TO 37+29 LT
INSTALL STEEL BEAM GUARD RAIL, GALVANIZED

36+26 13.5
STA 29+28 TO 37+29 LT
INSTALL STEEL BEAM GUARD RAIL, GALVANIZED

CURVE #11
PC = 18+80
PT = 22+30
R = 750ft - RT
SEE SHEET 21 FOR SUPERELEVATION DIAGRAM

CURVE #12
PC = 25+40
PT = 28+70
R = 420ft - LT
SEE SHEET 21 FOR SUPERELEVATION DIAGRAM

CURVE #15
PC = 45+70
PT = 50+60
R = 4,000ft - LT
SEE SHEET 22 FOR SUPERELEVATION DIAGRAM

CURVE #14
PC = 37+10
PT = 40+10
R = 2,100ft - RT
SEE SHEET 22 FOR SUPERELEVATION DIAGRAM

CURVE #13
PC = 31+90
PT = 33+10
R = 750ft - RT
SEE SHEET 22 FOR SUPERELEVATION DIAGRAM




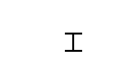
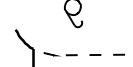
CURVE #16
PC = 52+60
PT = 57+90
R = 5,000ft - RT
SEE SHEET 22 FOR SUPERELEVATION DIAGRAM

STA 41+10 - 60+50 LT
5.4% AIR VOIDS (1 OF 5 TESTS)
IN THE TYPE IVS (INTERMEDIATE LIFT) MIX

STA 13+00 - 41+10 LT
2.6% AIR VOIDS (1 OF 4 TESTS)
TYPE IVS (INTERMEDIATE LIFT) MIX

STA 26+20 - 26+30 RT
INSTALL 15' x 10' CPEP

STONE FILL DITCH
STA 22+26 - 36+72 RT

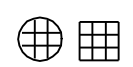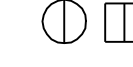- LEGEND
- N = NEW
 - R = REMOVE
 - R&S = REMOVE & SALVAGE
 - S = SALVAGE
 - RET = RETAIN
 - B-TO-B = BACK TO BACK
 -  CATCH BASIN/DI
 -  EXISTING THROAT DI
 - (N.W.) NO WORK REQUIRED (TYP. FOR W.V.'S, C.S.'S, D.I.'S, C.B.'S WHERE NOTED)
 -  YIELDING MARKER POST
 -  UTILITY POLE
 -  DRIVE

PAVING PROJECT LAYOUT SHEET #4

DESIGNED BY BCE/PJM DATE 6-07

DRAWN BY C.E.A., INC. DATE 6-07

DESIGN FILE NO. p06cl62.dgn

PRF FILE p06cl62pp14.i DATE 03-NOV-2009

PROJ. NAME **BELVIDERE - MONTGOMERY**

PROJ. NO. **STP 2619(1)S**

SHEET **12** OF **33** SHEETS

REMOVAL AND DISPOSAL OF GUARD RAIL
STA 13+00 TO 15+88 RT 63
70 STA 13+89 TO 20+14 LT 19+85
38.5 STA 22+66 TO 37+66 LT 51
50 STA 58+57 TO 60+50 LT


MANUFACTURED TERMINAL SECTION, FLARED
62.5 STA 13+89 TO 14+26 LT 00
25.5 STA 15+51 TO 15+88 RT 63
38.5 STA 22+66 TO 23+03 LT 22+76
13.5 STA 37+29 TO 37+66 LT 51
36.5 STA 58+57 TO 58+94 LT 74
STA 19+87.5 TO 20+25 LT

STEEL BEAM GUARD RAIL, GALVANIZED
STA 13+00 TO 15+51 RT 15+00.5 TO 15+25.5 RT
STA 14+26 TO 20+14 LT 18+12.5 TO 19+87.5 LT
22+76 STA 23+03 TO 24+03 LT 13.5
STA 29+28 TO 37+29 LT ALSO:
STA 58+94 TO 60+50 LT STA 28+13.5 TO 31+63.5 LT
74 59+74 STA 36+26 TO 37+13.5 LT

STEEL BEAM GUARD RAIL, GALVANIZED w/8 FEET POSTS
13 8 13.5
STA 24+03 TO 29+28 LT
ANCHOR FOR STEEL BEAM RAIL
STA 20+14 LT -2

TREATED TIMBER CURB
STA 24+85 TO 29+20 LT
65 00

DITCHING LOCATIONS (REFER TO SHEET 8 FOR DETAILS)
20
STA 18+00 TO 43+60 RT 22+26 36+72 - 43+49 RT
STA 55+80 TO 60+50 RT 49+44 - 51+60 RT

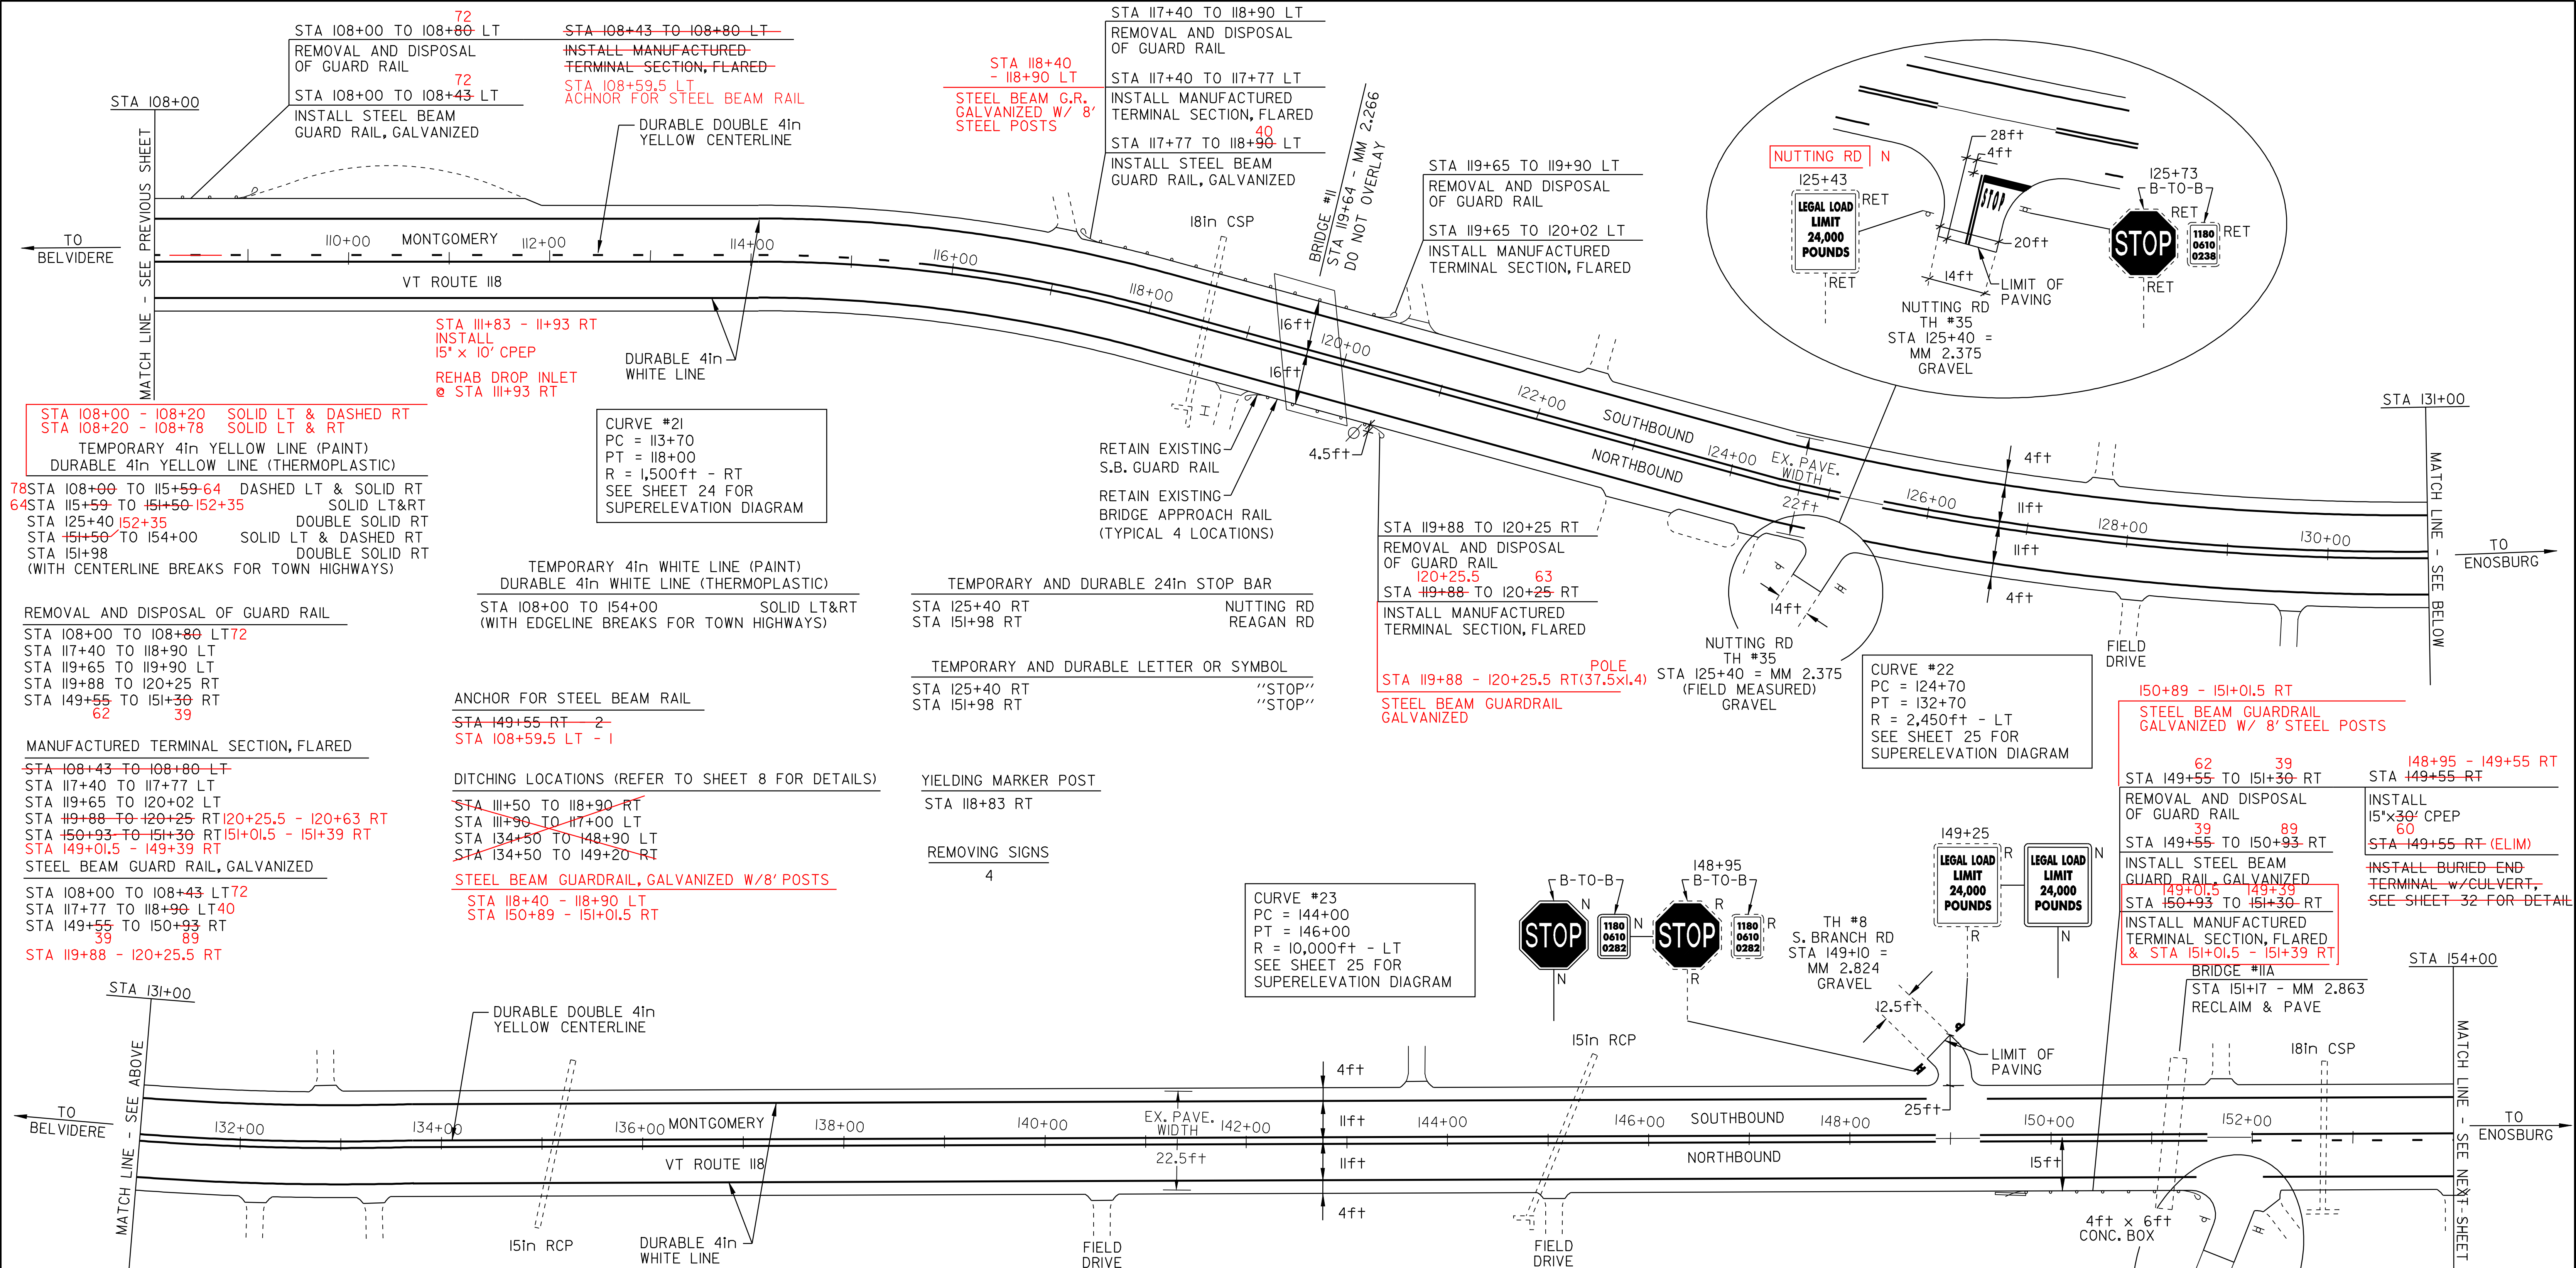

STA 108+00 - 108+20 SOLID LT & DASHED RT
 STA 108+20 - 108+78 SOLID LT & RT
 TEMPORARY 4in YELLOW LINE (PAINT)
 DURABLE 4in YELLOW LINE (THERMOPLASTIC)

78 STA 108+00 TO 115+59.64 DASHED LT & SOLID RT
 64 STA 115+59 TO 151+50-152+35 SOLID LT&RT
 STA 125+40 152+35 DOUBLE SOLID RT
 STA 151+50 TO 154+00 SOLID LT & DASHED RT
 STA 151+98 DOUBLE SOLID RT
 (WITH CENTERLINE BREAKS FOR TOWN HIGHWAYS)

REMOVAL AND DISPOSAL OF GUARD RAIL

STA 108+00 TO 108+80 LT 72
 STA 117+40 TO 118+90 LT
 STA 119+65 TO 119+90 LT
 STA 119+88 TO 120+25 RT
 STA 149+55 TO 151+30 RT
 62 39

MANUFACTURED TERMINAL SECTION, FLARED

~~STA 108+43 TO 108+80 LT~~
~~STA 117+40 TO 117+77 LT~~
~~STA 119+65 TO 119+90 LT~~
~~STA 119+88 TO 120+25 RT~~
~~STA 150+93 TO 151+30 RT~~
~~STA 149+01.5 - 149+39 RT~~
 STEEL BEAM GUARD RAIL, GALVANIZED

STA 108+00 TO 108+43 LT 72
 STA 117+77 TO 118+90 LT 40
 STA 149+55 TO 150+93 RT
 39 89
 STA 119+88 - 120+25.5 RT

CURVE #21
 PC = 113+70
 PT = 118+00
 R = 1,500ft - RT
 SEE SHEET 24 FOR SUPERELEVATION DIAGRAM

TEMPORARY 4in WHITE LINE (PAINT)
 DURABLE 4in WHITE LINE (THERMOPLASTIC)

STA 108+00 TO 154+00 SOLID LT&RT
 (WITH EDGELINE BREAKS FOR TOWN HIGHWAYS)

ANCHOR FOR STEEL BEAM RAIL

~~STA 149+55 RT - 2~~
 STA 108+59.5 LT - 1

DITCHING LOCATIONS (REFER TO SHEET 8 FOR DETAILS)

~~STA 111+50 TO 118+90 RT~~
~~STA 111+90 TO 117+00 LT~~
~~STA 134+50 TO 148+90 LT~~
~~STA 134+50 TO 149+20 RT~~

STEEL BEAM GUARDRAIL, GALVANIZED W/8' POSTS

STA 118+40 - 118+90 LT
 STA 150+89 - 151+01.5 RT

TEMPORARY AND DURABLE 24in STOP BAR

STA 125+40 RT NUTTING RD
 STA 151+98 RT REAGAN RD

TEMPORARY AND DURABLE LETTER OR SYMBOL

STA 125+40 RT "STOP"
 STA 151+98 RT "STOP"

YIELDING MARKER POST

STA 118+83 RT

REMOVING SIGNS


4

CURVE #23
 PC = 144+00
 PT = 146+00
 R = 10,000ft - LT
 SEE SHEET 25 FOR SUPERELEVATION DIAGRAM

- LEGEND**
- N = NEW
 - R = REMOVE
 - R&S = REMOVE & SALVAGE
 - S = SALVAGE
 - RET = RETAIN
 - B-TO-B = BACK TO BACK
 - ☐ = CATCH BASIN/DI
 - ⊙ = EXISTING THROAT DI
 - (N.W.) = NO WORK REQUIRED (TYP. FOR W.V.'S, C.S.'S, D.I.'S, C.B.'S WHERE NOTED)
 - I = YIELDING MARKER POST
 - ⊕ = UTILITY POLE
 - = DRIVE

DITCHING LOCATIONS
 STA 108+00 - 112+67 RT
 STA 111+90 - 116+60 LT
 STA 123+50 - 127+30 LT
 STA 141+80 - 142+98 RT
 STA 143+60 - 149+20 LT

STONE FILL DITCH
 STA 112+67 - 118+50 RT
 STA 142+98 - 149+95 RT

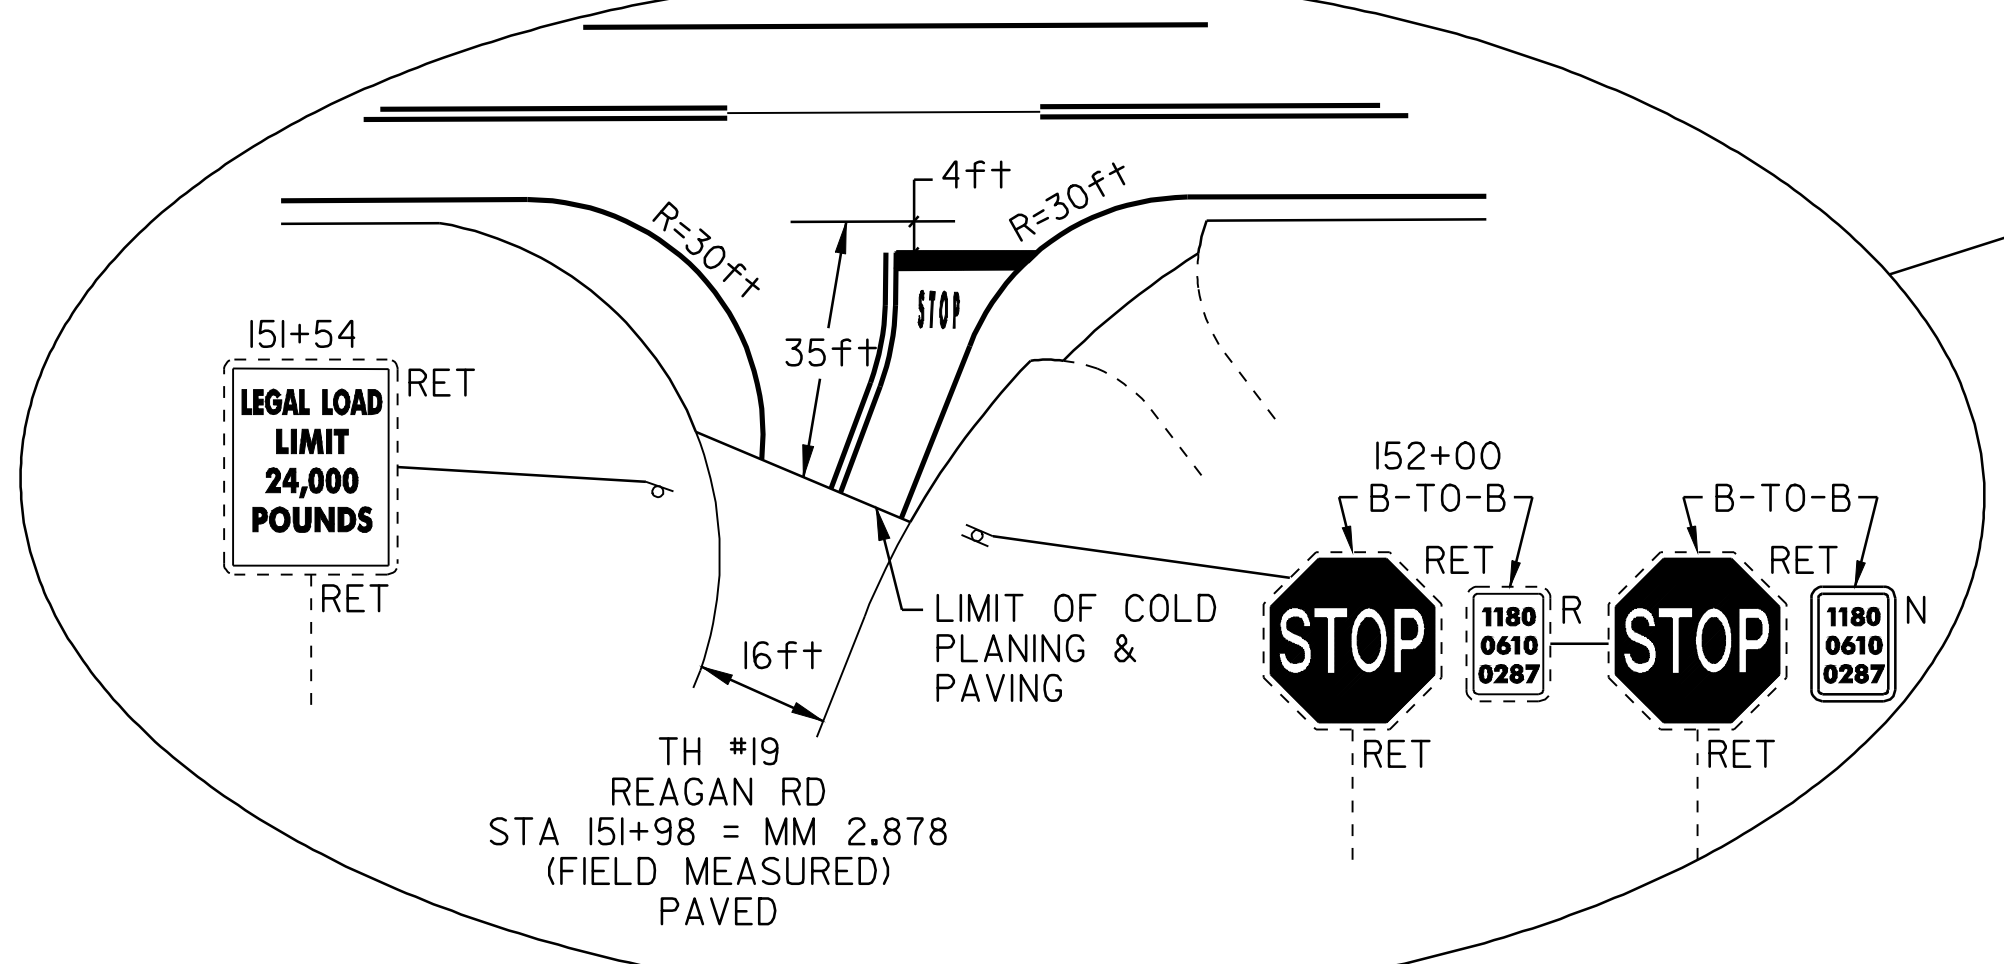

PAVING PROJECT LAYOUT SHEET #6

DESIGNED BY BCE/PJM DATE 6-07

DRAWN BY C.E.A., INC. DATE 6-07



DESIGN FILE NO. p06cl62.dgn

PRF FILE p06cl62pp16.i DATE PLOTTED 03-NOV-2009

PROJ. NAME **BELVIDERE - MONTGOMERY**

PROJ. NO. **STP 2619(1)S**

SHEET **14** OF **33** SHEETS

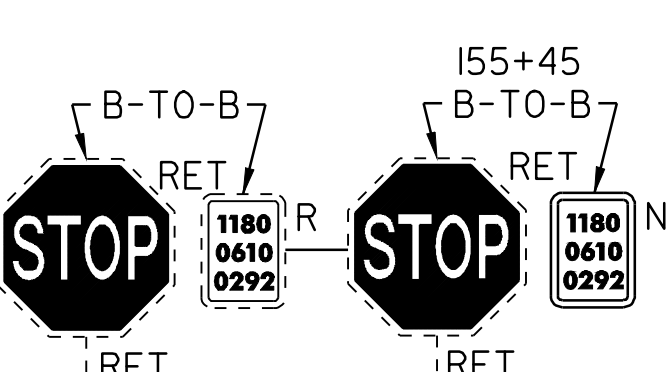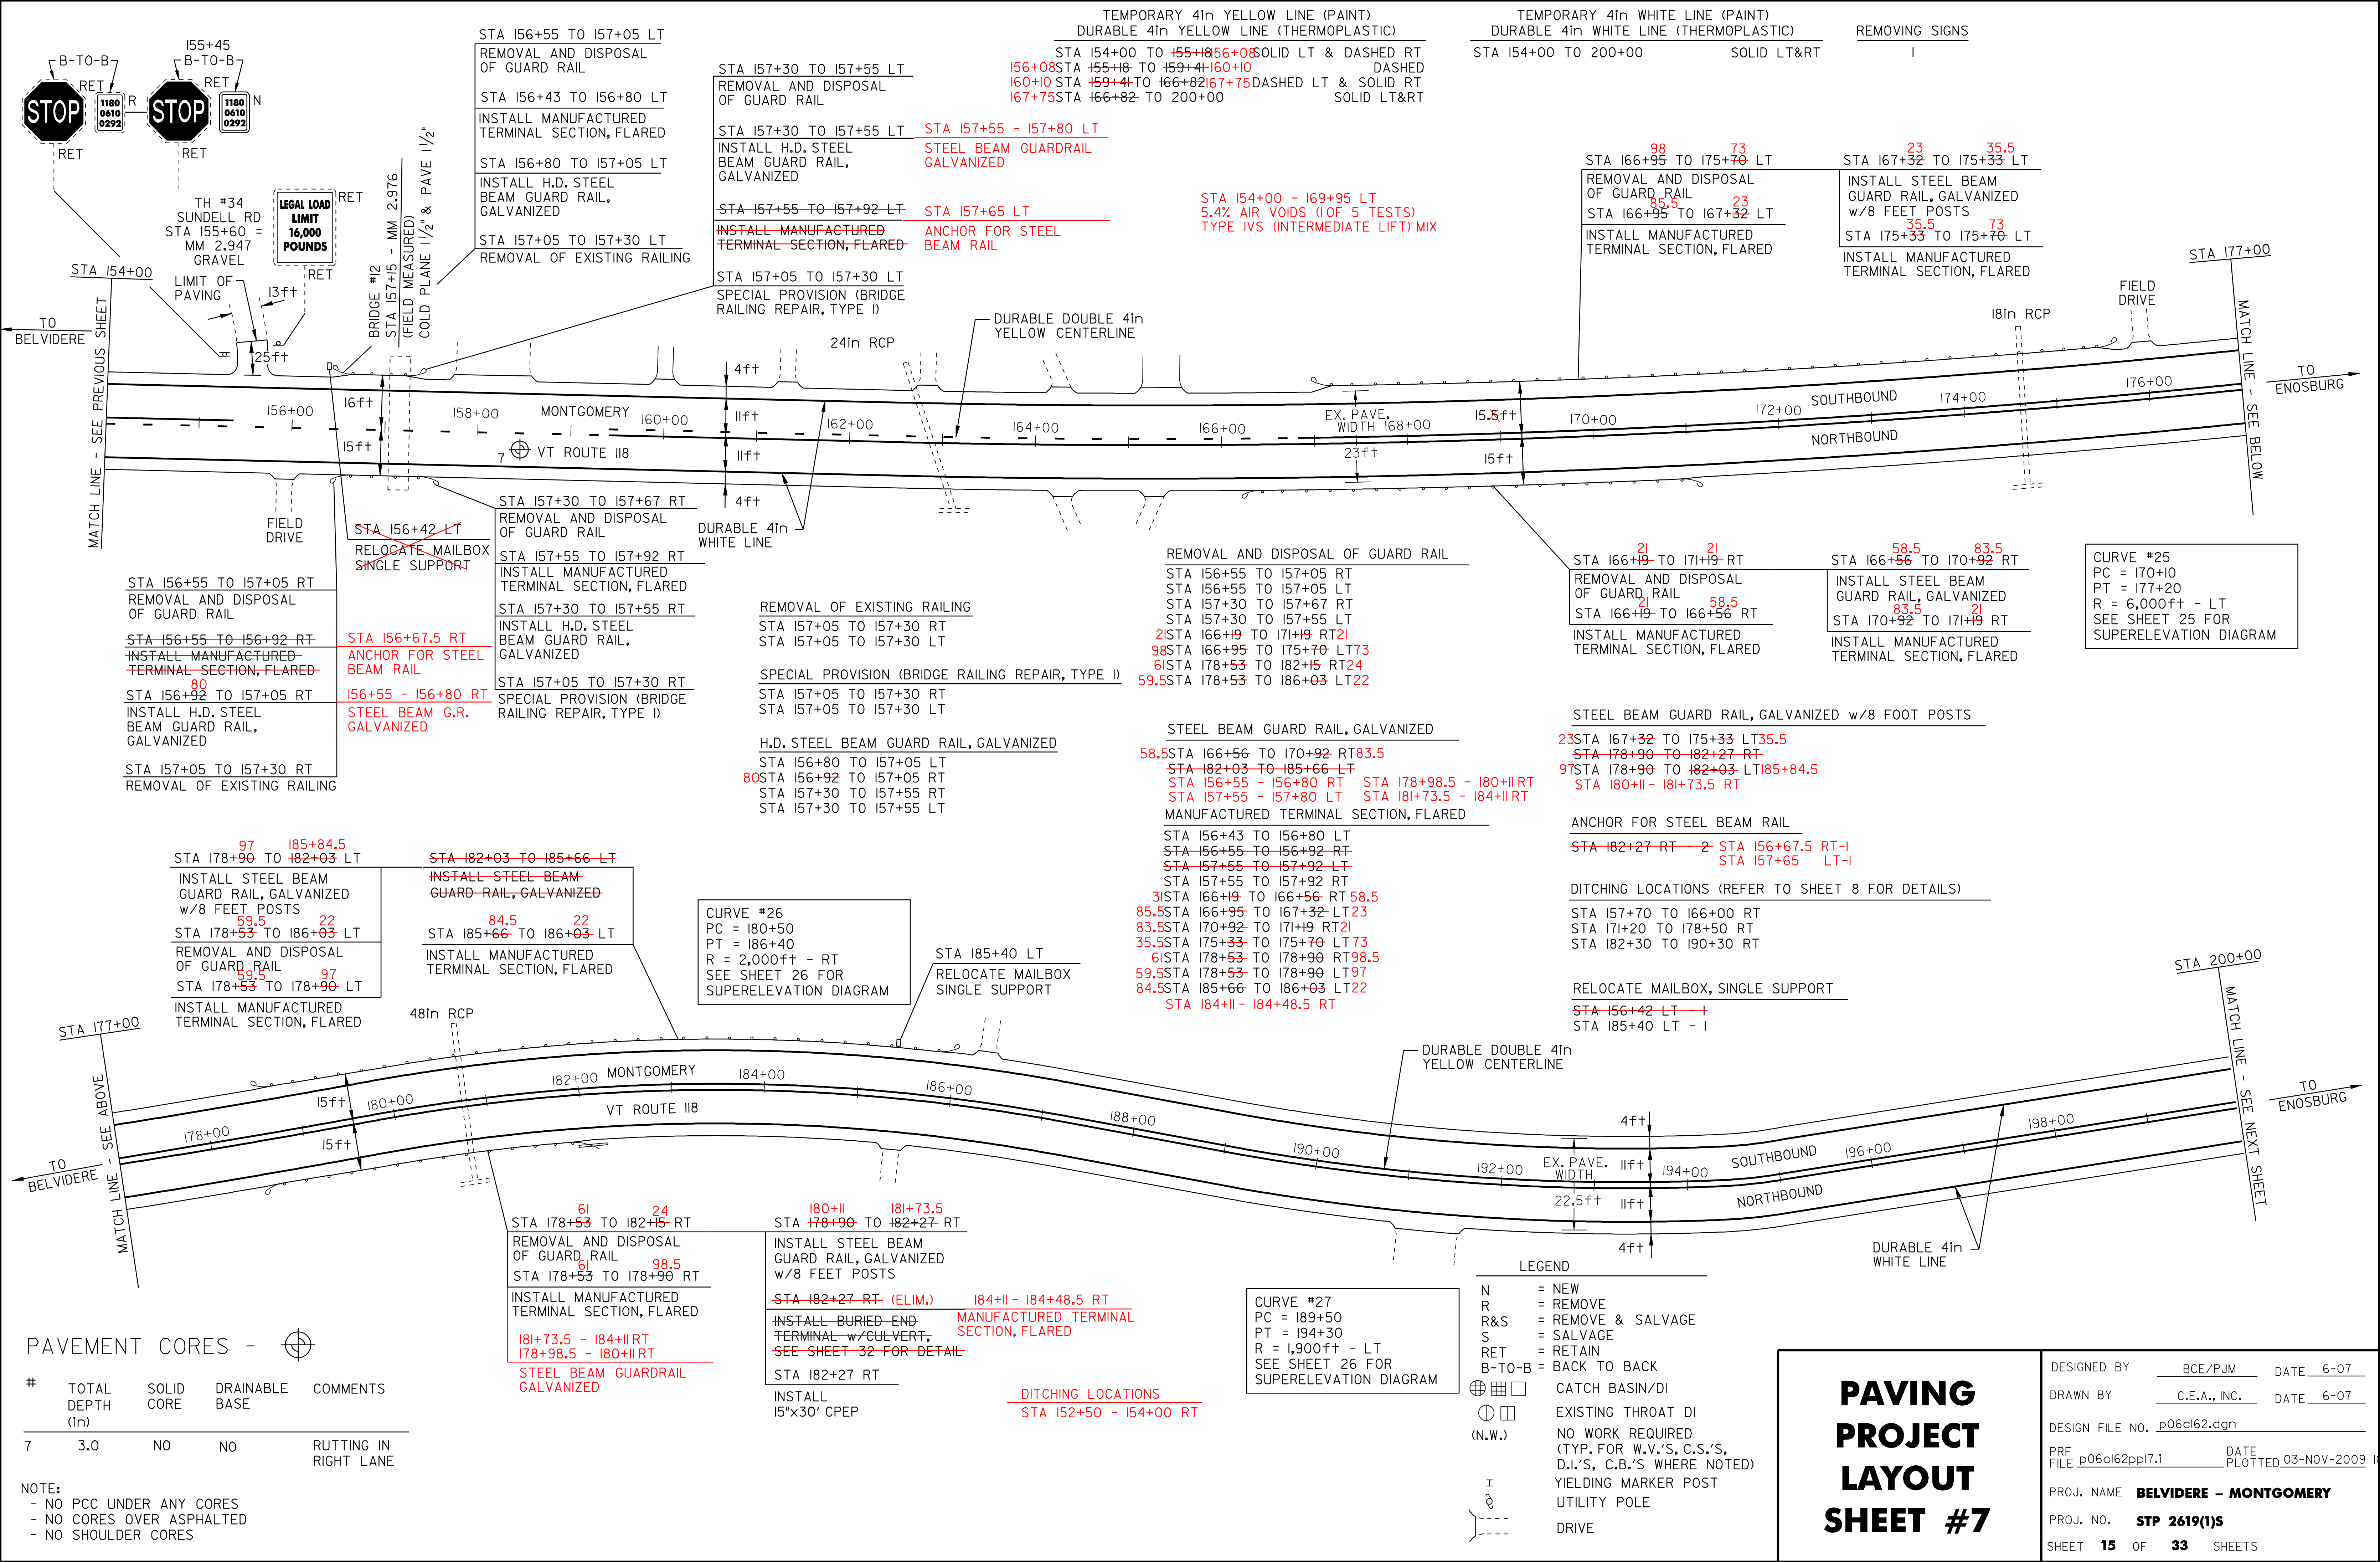

155+45 B-T-O-B
155+60 SUNDELL RD
MM 2,947 GRAVEL
TH #34
LEGAL LOAD LIMIT 16,000 POUNDS

STA 154+00
LIMIT OF PAVING
13ft
125ft
BRIDGE #12
STA 157+15 - MM 2,976
(FIELD MEASURED)
COLD PLANE 1/2 & PAVE 1/2

STA 156+55 TO 157+05 RT
REMOVAL AND DISPOSAL OF GUARD RAIL
STA 156+55 TO 156+92 RT
INSTALL MANUFACTURED TERMINAL SECTION, FLARED
STA 156+92 TO 157+05 RT
INSTALL H.D. STEEL BEAM GUARD RAIL, GALVANIZED
STA 157+05 TO 157+30 RT
REMOVAL OF EXISTING RAILING

STA 156+55 TO 157+05 LT
REMOVAL AND DISPOSAL OF GUARD RAIL
STA 156+55 TO 156+92 LT
INSTALL MANUFACTURED TERMINAL SECTION, FLARED
STA 156+92 TO 157+05 LT
INSTALL H.D. STEEL BEAM GUARD RAIL, GALVANIZED
STA 157+05 TO 157+30 LT
REMOVAL OF EXISTING RAILING

STA 156+43 TO 156+80 LT
INSTALL MANUFACTURED TERMINAL SECTION, FLARED
STA 156+80 TO 157+05 LT
INSTALL H.D. STEEL BEAM GUARD RAIL, GALVANIZED
STA 157+05 TO 157+30 LT
REMOVAL OF EXISTING RAILING

STA 157+30 TO 157+55 LT
REMOVAL AND DISPOSAL OF GUARD RAIL
STA 157+30 TO 157+55 LT
INSTALL H.D. STEEL BEAM GUARD RAIL, GALVANIZED
STA 157+55 TO 157+92 LT
INSTALL MANUFACTURED TERMINAL SECTION, FLARED
STA 157+92 TO 157+30 LT
SPECIAL PROVISION (BRIDGE RAILING REPAIR, TYPE I)

STA 157+05 TO 157+30 LT
SPECIAL PROVISION (BRIDGE RAILING REPAIR, TYPE I)

STA 157+30 TO 157+55 LT
REMOVAL AND DISPOSAL OF GUARD RAIL
STA 157+30 TO 157+55 LT
INSTALL H.D. STEEL BEAM GUARD RAIL, GALVANIZED
STA 157+55 TO 157+92 LT
INSTALL MANUFACTURED TERMINAL SECTION, FLARED
STA 157+92 TO 157+30 LT
SPECIAL PROVISION (BRIDGE RAILING REPAIR, TYPE I)

STA 157+30 TO 157+67 RT
REMOVAL AND DISPOSAL OF GUARD RAIL
STA 157+55 TO 157+92 RT
INSTALL MANUFACTURED TERMINAL SECTION, FLARED
STA 157+30 TO 157+55 RT
INSTALL H.D. STEEL BEAM GUARD RAIL, GALVANIZED
STA 157+05 TO 157+30 RT
SPECIAL PROVISION (BRIDGE RAILING REPAIR, TYPE I)

STA 157+30 TO 157+55 LT
REMOVAL AND DISPOSAL OF GUARD RAIL
STA 157+30 TO 157+55 LT
INSTALL H.D. STEEL BEAM GUARD RAIL, GALVANIZED
STA 157+55 TO 157+92 LT
INSTALL MANUFACTURED TERMINAL SECTION, FLARED
STA 157+92 TO 157+30 LT
SPECIAL PROVISION (BRIDGE RAILING REPAIR, TYPE I)

STA 154+00 TO 155+18
DURABLE 4in YELLOW LINE (THERMOPLASTIC)
156+08 STA 155+18 TO 159+41
160+10 STA 159+41 TO 166+82
167+75 STA 166+82 TO 200+00
SOLID LT & DASHED RT
DASHED
DASHED LT & SOLID RT
SOLID LT&RT

STA 154+00 TO 200+00
DURABLE 4in WHITE LINE (THERMOPLASTIC)
SOLID LT&RT

STA 154+00 TO 200+00
DURABLE 4in WHITE LINE (THERMOPLASTIC)
SOLID LT&RT

REMOVING SIGNS
STA 166+95 TO 175+70 LT
REMOVAL AND DISPOSAL OF GUARD RAIL
STA 166+95 TO 167+32 LT
INSTALL MANUFACTURED TERMINAL SECTION, FLARED
STA 167+32 TO 175+33 LT
INSTALL STEEL BEAM GUARD RAIL, GALVANIZED w/8 FEET POSTS
STA 175+33 TO 175+70 LT
INSTALL MANUFACTURED TERMINAL SECTION, FLARED

PAVEMENT CORES -

#	TOTAL DEPTH (in)	SOLID CORE	DRAINABLE BASE	COMMENTS
7	3.0	NO	NO	RUTTING IN RIGHT LANE

NOTE:
- NO PCC UNDER ANY CORES
- NO CORES OVER ASPHALTED
- NO SHOULDER CORES

CURVE #26
PC = 180+50
PT = 186+40
R = 2,000ft - RT
SEE SHEET 26 FOR SUPERELEVATION DIAGRAM

STA 185+40 LT
RELOCATE MAILBOX SINGLE SUPPORT

CURVE #27
PC = 189+50
PT = 194+30
R = 1,900ft - LT
SEE SHEET 26 FOR SUPERELEVATION DIAGRAM

- LEGEND
- N = NEW
 - R = REMOVE
 - R&S = REMOVE & SALVAGE
 - S = SALVAGE
 - RET = RETAIN
 - B-T-O-B = BACK TO BACK
 - ☒ = CATCH BASIN/DI
 - ⊙ = EXISTING THROAT DI
 - (N.W.) = NO WORK REQUIRED (TYP. FOR W.V.'S, C.S.'S, D.I.'S, C.B.'S WHERE NOTED)
 - ⊥ = YIELDING MARKER POST
 - ⊕ = UTILITY POLE
 - ⊖ = DRIVE

PAVING PROJECT LAYOUT SHEET #7

DESIGNED BY BCE/PJM DATE 6-07
 DRAWN BY C.E.A., INC. DATE 6-07
 DESIGN FILE NO. p06cl62.dgn
 PRF FILE p06cl62pp17.i DATE PLOTTED 03-NOV-2009
 PROJ. NAME **BELVIDERE - MONTGOMERY**
 PROJ. NO. **STP 2619(1)S**
 SHEET **15** OF **33** SHEETS


TEMPORARY 4in YELLOW LINE (PAINT)
 DURABLE 4in YELLOW LINE (THERMOPLASTIC)
 STA 200+00 TO 246+00 SOLID LT&RT
 STA 210+60 DOUBLE SOLID LT
 (WITH CENTERLINE BREAKS FOR TOWN HIGHWAYS)

TEMPORARY 4in WHITE LINE (PAINT)
 DURABLE 4in WHITE LINE (THERMOPLASTIC)
 STA 200+00 TO 246+00 SOLID LT&RT
 (WITH EDGELINE BREAKS FOR TOWN HIGHWAYS)

TEMPORARY AND DURABLE 24in STOP BAR
 STA 210+60 LT GIBOU RD

TEMPORARY AND DURABLE LETTER OR SYMBOL
 STA 210+60 LT "STOP"

REMOVING SIGNS
 8

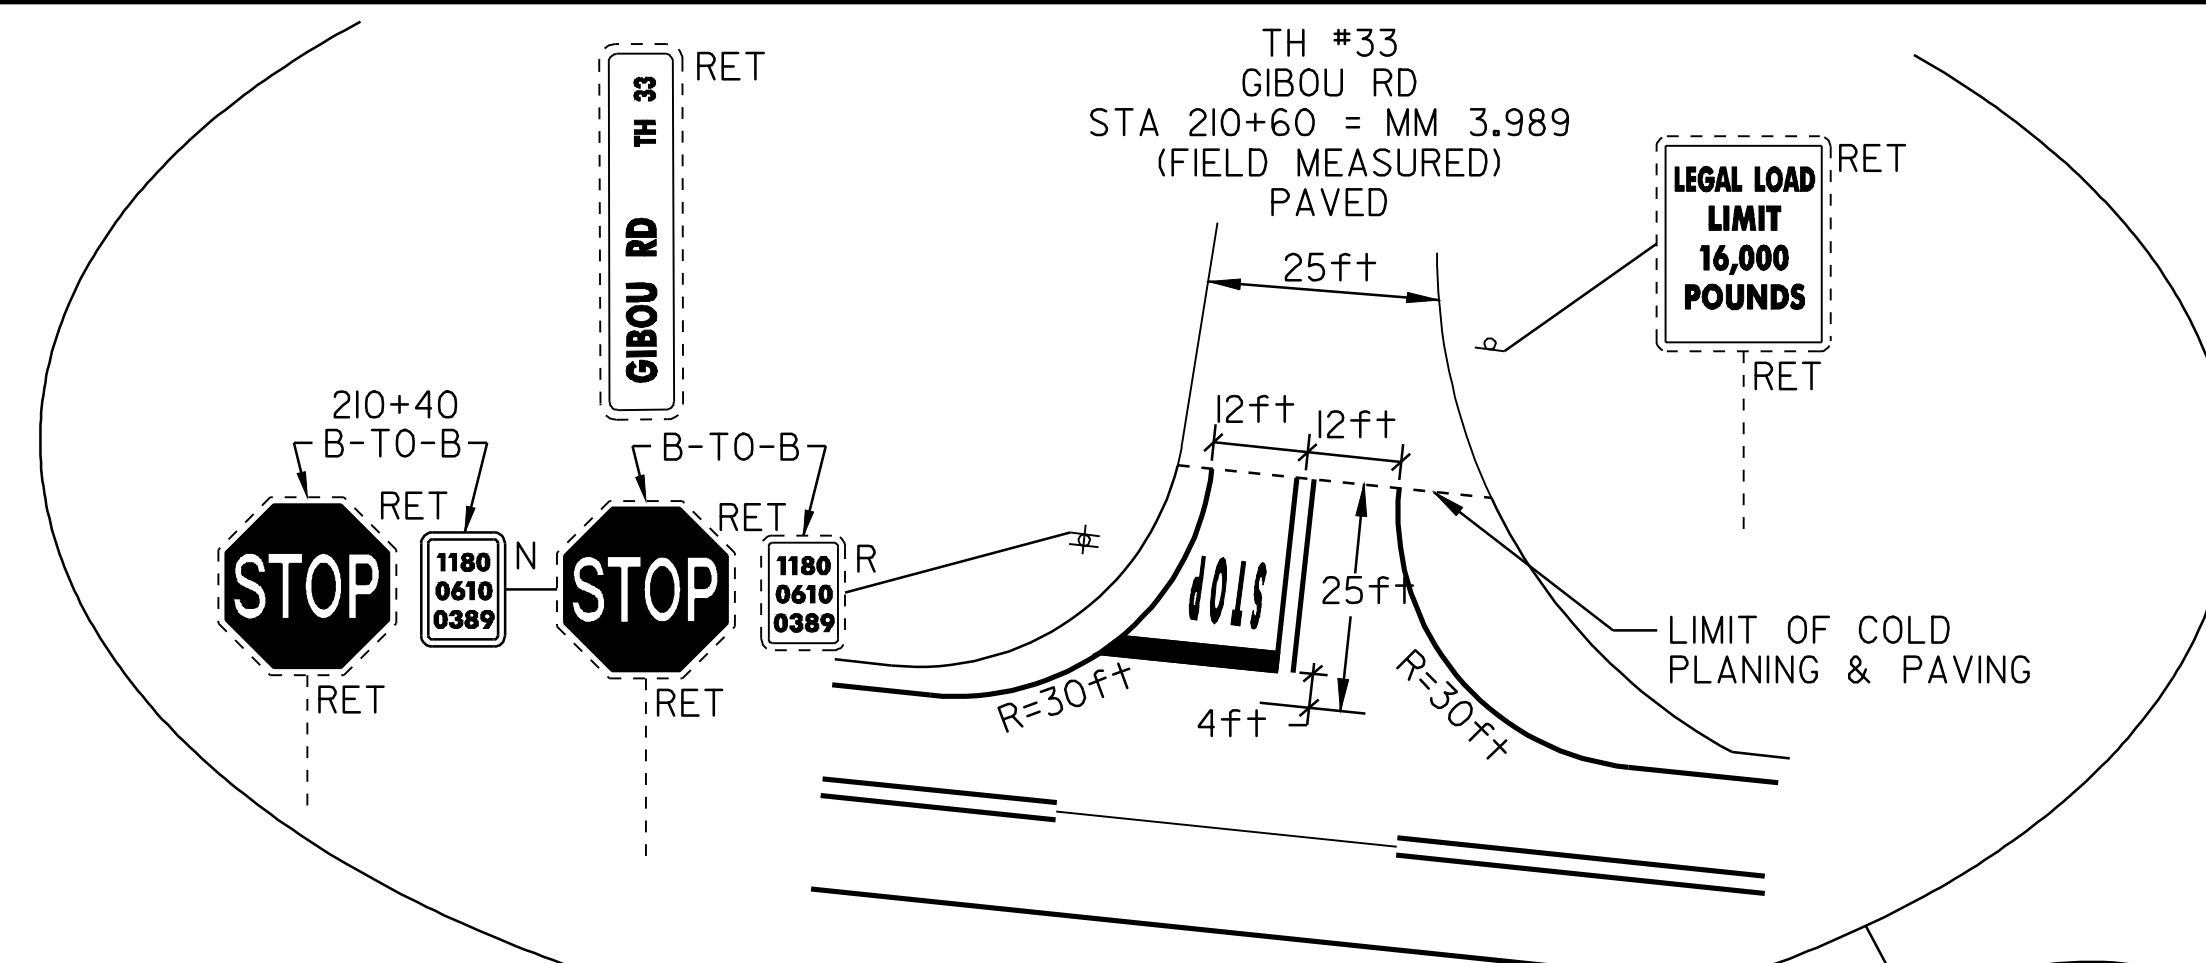


DITCHING LOCATIONS (REFER TO SHEET 8 FOR DETAILS)

STA 211+60 TO 214+10 RT
 222+42 STA 221+80 TO 232+70 RT
 STA 235+10 TO 238+50 LT
 STA 235+00 TO 239+00 RT
 242+89

STA 201+84 - 203+55 LT
 STA 202+11 - 204+23 RT
 STA 214+00 - 216+00 RT
 STA 214+00 - 217+00 LT

RELOCATE MAILBOX, SINGLE SUPPORT
 STA 221+60 RT - 1
 STA 238+70 LT - 1

STONE FILL DITCH
 STA 203+45 - 208+18 LT
 STA 204+23 - 204+54 RT
 STA 223+02 - 225+60 LT
 STA 242+89 - 245+05 RT

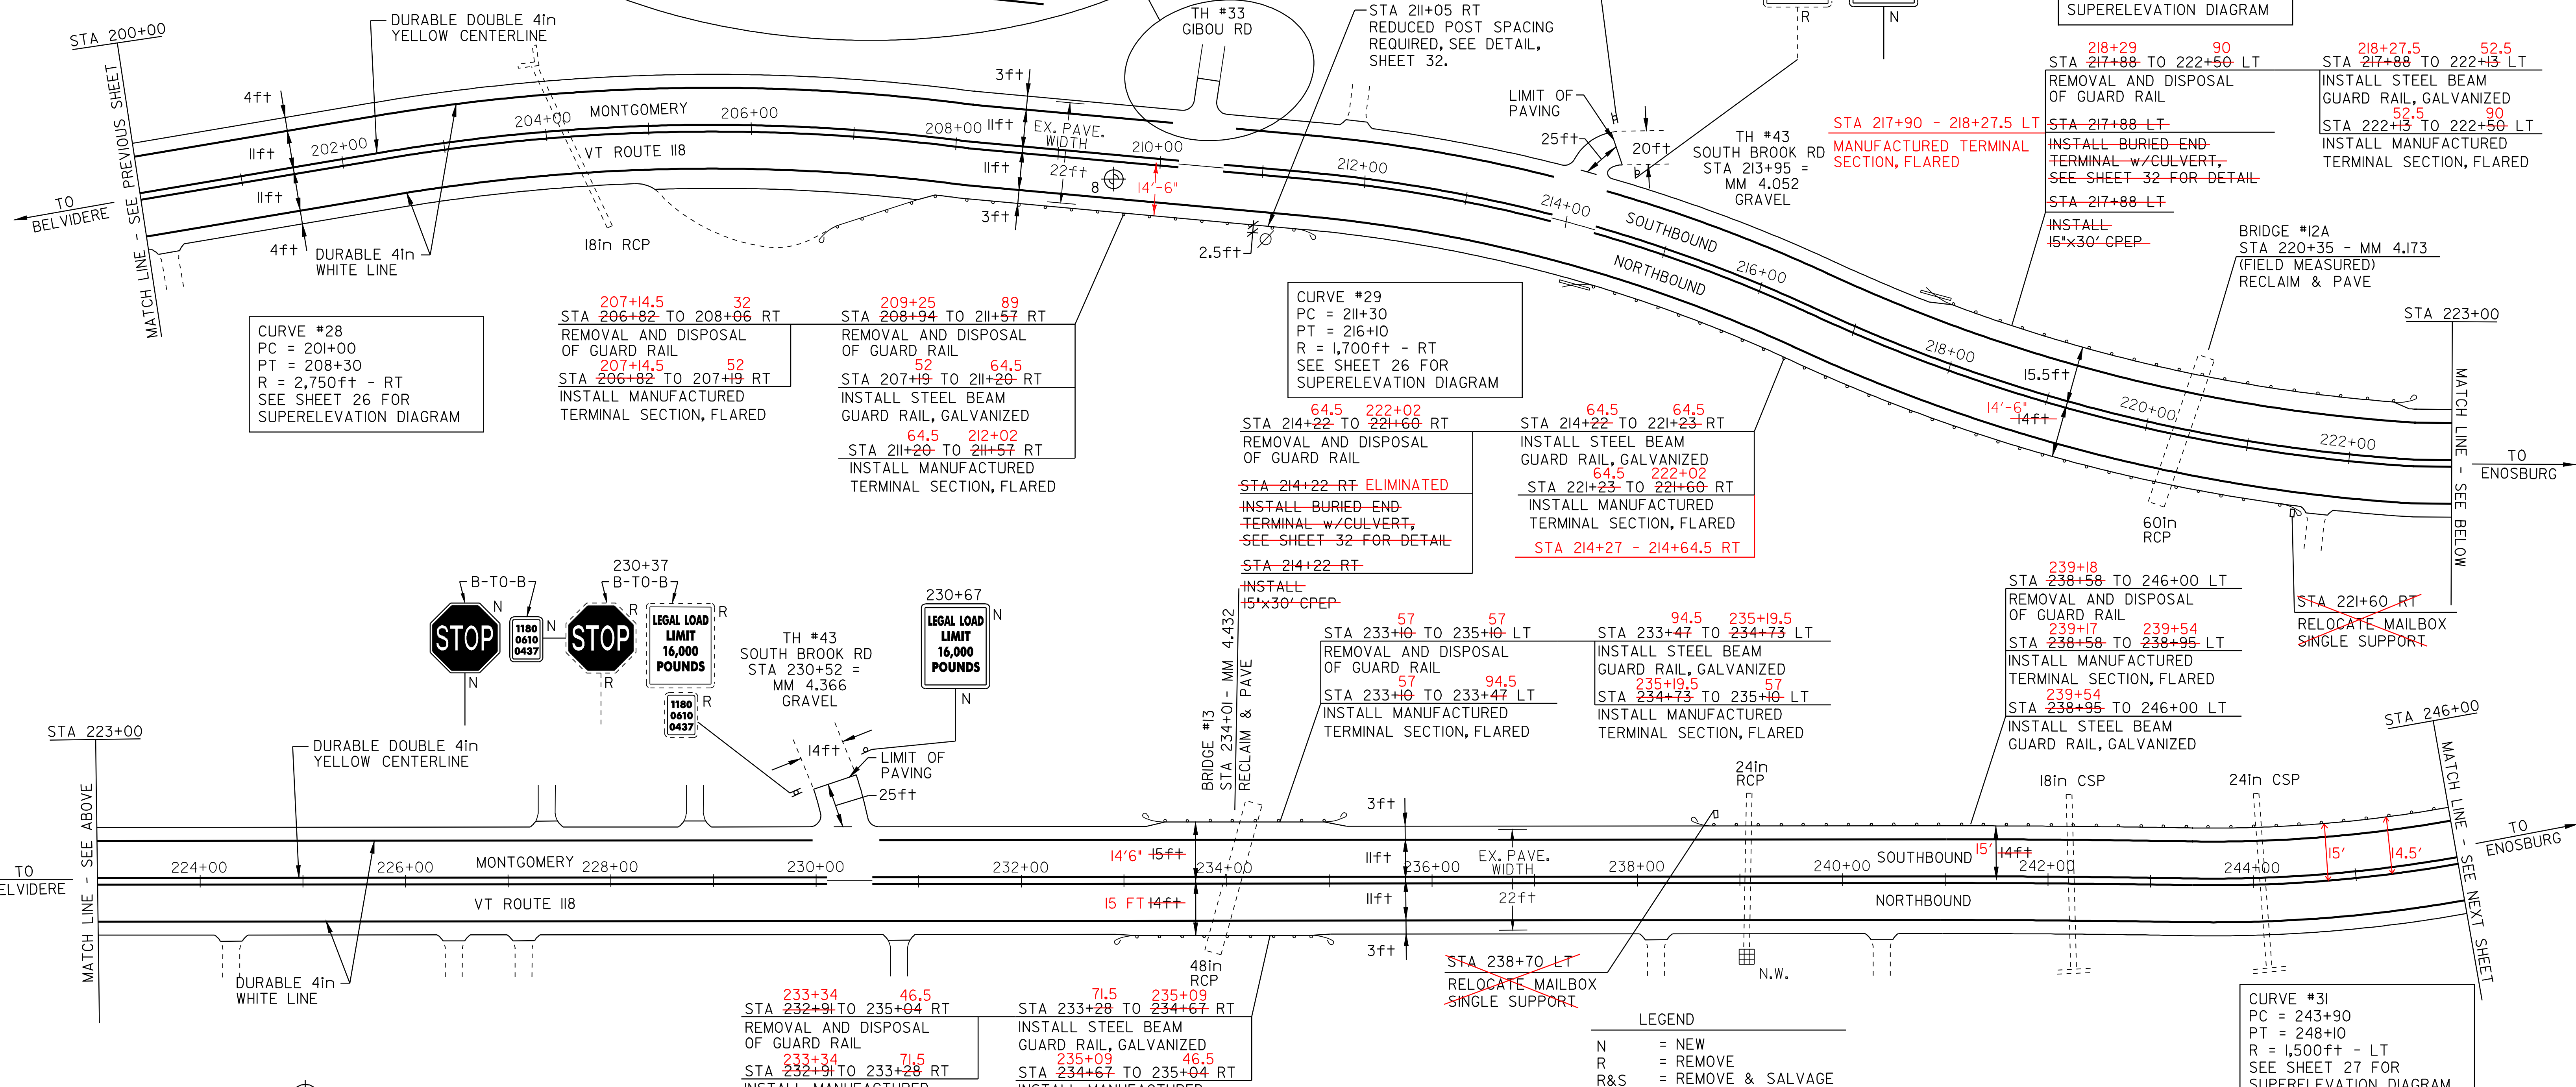

CURVE #28
 PC = 201+00
 PT = 208+30
 R = 2,750ft - RT
 SEE SHEET 26 FOR SUPERELEVATION DIAGRAM

207+14.5 32
 STA 206+82 TO 208+06 RT
 REMOVAL AND DISPOSAL
 OF GUARD RAIL
 207+14.5 52
 STA 206+82 TO 207+19 RT
 INSTALL MANUFACTURED
 TERMINAL SECTION, FLARED

209+25 89
 STA 208+94 TO 211+57 RT
 REMOVAL AND DISPOSAL
 OF GUARD RAIL
 207+19 64.5
 STA 207+19 TO 211+20 RT
 INSTALL STEEL BEAM
 GUARD RAIL, GALVANIZED
 64.5 212+02
 STA 211+20 TO 211+57 RT
 INSTALL MANUFACTURED
 TERMINAL SECTION, FLARED

CURVE #29
 PC = 211+30
 PT = 216+10
 R = 1,700ft - RT
 SEE SHEET 26 FOR SUPERELEVATION DIAGRAM

64.5 222+02
 STA 214+22 TO 221+60 RT
 REMOVAL AND DISPOSAL
 OF GUARD RAIL
 STA 214+22 RT ELIMINATED
 INSTALL BURIED END
 TERMINAL w/ CULVERT,
 SEE SHEET 32 FOR DETAIL
 STA 214+22 RT
 INSTALL
 15'x30' CPEP

64.5 64.5
 STA 214+22 TO 221+23 RT
 INSTALL STEEL BEAM
 GUARD RAIL, GALVANIZED
 64.5 222+02
 STA 221+23 TO 221+60 RT
 INSTALL MANUFACTURED
 TERMINAL SECTION, FLARED
 STA 214+27 - 214+64.5 RT


STA 217+90 - 218+27.5 LT
 MANUFACTURED TERMINAL
 SECTION, FLARED

CURVE #30
 PC = 217+50
 PT = 224+70
 R = 2,000ft - LT
 SEE SHEET 26 FOR SUPERELEVATION DIAGRAM

218+29 90
 STA 217+88 TO 222+50 LT
 REMOVAL AND DISPOSAL
 OF GUARD RAIL
 STA 217+88 LT
 INSTALL BURIED END
 TERMINAL w/ CULVERT,
 SEE SHEET 32 FOR DETAIL
 STA 217+88 LT
 INSTALL
 15'x30' CPEP

218+27.5 52.5
 STA 217+88 TO 222+13 LT
 INSTALL STEEL BEAM
 GUARD RAIL, GALVANIZED
 52.5 90
 STA 222+13 TO 222+50 LT
 INSTALL MANUFACTURED
 TERMINAL SECTION, FLARED

BRIDGE #12A
 STA 220+35 - MM 4.173
 (FIELD MEASURED)
 RECLAIM & PAVE

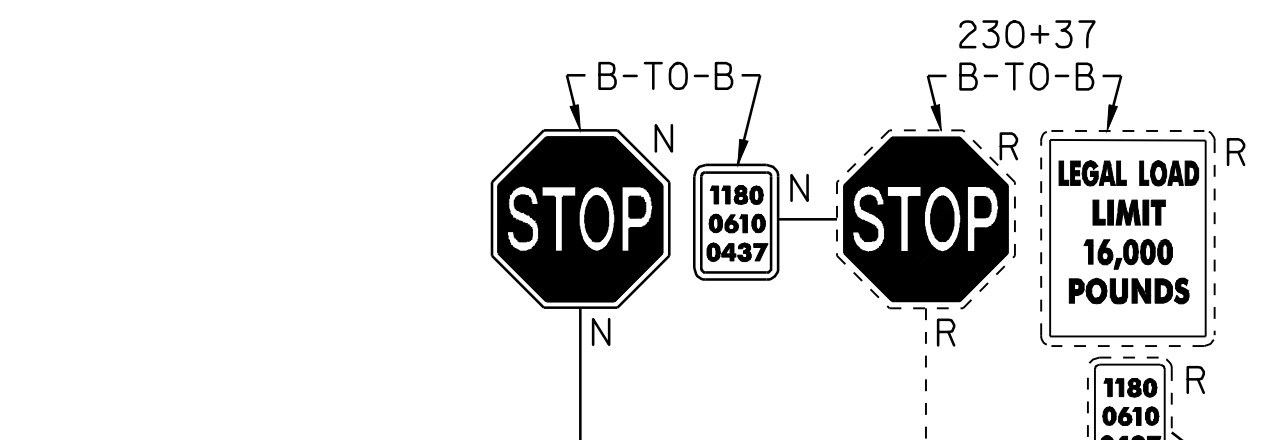

TH #43
 SOUTH BROOK RD
 STA 230+52 =
 MM 4.366
 GRAVEL

57 57
 STA 233+10 TO 235+10 LT
 REMOVAL AND DISPOSAL
 OF GUARD RAIL
 57 94.5
 STA 233+10 TO 233+47 LT
 INSTALL MANUFACTURED
 TERMINAL SECTION, FLARED

94.5 235+19.5
 STA 233+47 TO 234+73 LT
 INSTALL STEEL BEAM
 GUARD RAIL, GALVANIZED
 235+19.5 57
 STA 234+73 TO 235+10 LT
 INSTALL MANUFACTURED
 TERMINAL SECTION, FLARED

239+18
 STA 238+58 TO 246+00 LT
 REMOVAL AND DISPOSAL
 OF GUARD RAIL
 239+17 239+54
 STA 238+58 TO 238+95 LT
 INSTALL MANUFACTURED
 TERMINAL SECTION, FLARED
 239+54
 STA 238+95 TO 246+00 LT
 INSTALL STEEL BEAM
 GUARD RAIL, GALVANIZED

STA 221+60 RT
 RELOCATE MAILBOX
 SINGLE SUPPORT

PAVEMENT CORES -

#	TOTAL DEPTH (in)	SOLID CORE	DRAINABLE BASE	COMMENTS
8	3.0	NO	NO	RUTTING

NOTE:
 - NO PCC UNDER ANY CORES
 - NO CORES OVER ASPHALTED
 - NO SHOULDER CORES

REMOVAL AND DISPOSAL OF GUARD RAIL	MANUFACTURED TERMINAL SECTION, FLARED	STEEL BEAM GUARD RAIL, GALVANIZED
207+14.5 STA 206+82 TO 208+06 RT 32	207+14.5 STA 206+82 TO 207+19 RT 52	52 STA 207+19 TO 211+20 RT 64.5
209+25 STA 208+94 TO 211+57 RT 89	64.5 STA 211+20 TO 211+57 RT 212+02	27 STA 214+22 TO 221+23 RT 64.5
64.5 STA 214+22 TO 221+60 RT 222+02	64.5 STA 221+23 TO 221+60 RT 222+02	218+27.5 STA 217+88 TO 222+13 LT 52.5
218+29 STA 217+88 TO 222+50 LT 90	52.5 STA 222+13 TO 222+50 LT 90	71.5 STA 233+28 TO 234+67 RT 235+09
233+34 STA 232+91 TO 235+04 RT 46.5	233+34 STA 232+91 TO 233+28 RT 71.5	94.5 STA 233+47 TO 234+73 LT 235+19.5
57 STA 233+10 TO 235+10 LT 57	57 STA 233+10 TO 233+47 LT 94.5	239+54 STA 238+95 TO 246+00 LT
239+18 STA 238+58 TO 246+00 LT	235+09 STA 234+67 TO 235+04 RT 46.5	
	235+19.5 STA 234+73 TO 235+10 LT 57	
	239+18 STA 238+58 TO 239+95 LT 239+54	
	STA 214+27 - 214+64.5 RT	
	STA 217+90 - 218+27.5 LT	

- LEGEND
- N = NEW
 - R = REMOVE
 - R&S = REMOVE & SALVAGE
 - S = SALVAGE
 - RET = RETAIN
 - B-T-O-B = BACK TO BACK
 - ⊕ ⊞ ⊠ CATCH BASIN/DI
 - ⊕ ⊞ ⊠ EXISTING THROAT DI
 - (N.W.) NO WORK REQUIRED (TYP. FOR W.V.'S, C.S.'S, D.I.'S, C.B.'S WHERE NOTED)
 - ⊕ YIELDING MARKER POST
 - ⊕ UTILITY POLE
 - ⊕ DRIVE

PAVING PROJECT LAYOUT SHEET #8

DESIGNED BY BCE/PJM DATE 6-07

DRAWN BY C.E.A., INC. DATE 6-07

DESIGN FILE NO. p06cl62.dgn

PRF FILE p06cl62pp8.i DATE PLOTTED 03-NOV-2009

PROJ. NAME **BELVIDERE - MONTGOMERY**


PROJ. NO. **STP 2619(1)S**

SHEET **16** OF **33** SHEETS

TEMPORARY 4in YELLOW LINE (PAINT)
 DURABLE 4in YELLOW LINE (THERMOPLASTIC)
 STA 246+00 TO ~~293+83~~
 295+10 SOLID LT&RT
 TEMPORARY 4in WHITE LINE (PAINT)
 DURABLE 4in WHITE LINE (THERMOPLASTIC)
 STA 246+00 TO ~~293+83~~
 295+10 SOLID LT&RT


~~DITCHING LOCATIONS (REFER TO SHEET 8 FOR DETAILS)~~
~~STA 246+70 TO 255+80 RT~~
~~STA 259+20 TO 274+20 RT~~
~~STA 277+20 TO 286+30 RT~~

RELOCATE MAILBOX, SINGLE SUPPORT
 STA 269+90 LT - I
 REHABILITATION OF C.B.'S, D.I.'S, OR M.H.'S
 STA 293+40 RT

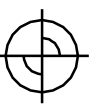PAVEMENT CORES - 

#	TOTAL DEPTH (in)	SOLID CORE	DRAINABLE BASE	COMMENTS
9	4.5	NO	NO	1" RUTTING

NOTE:
 - NO PCC UNDER ANY CORES
 - NO CORES OVER ASPHALTED
 - NO SHOULDER CORES

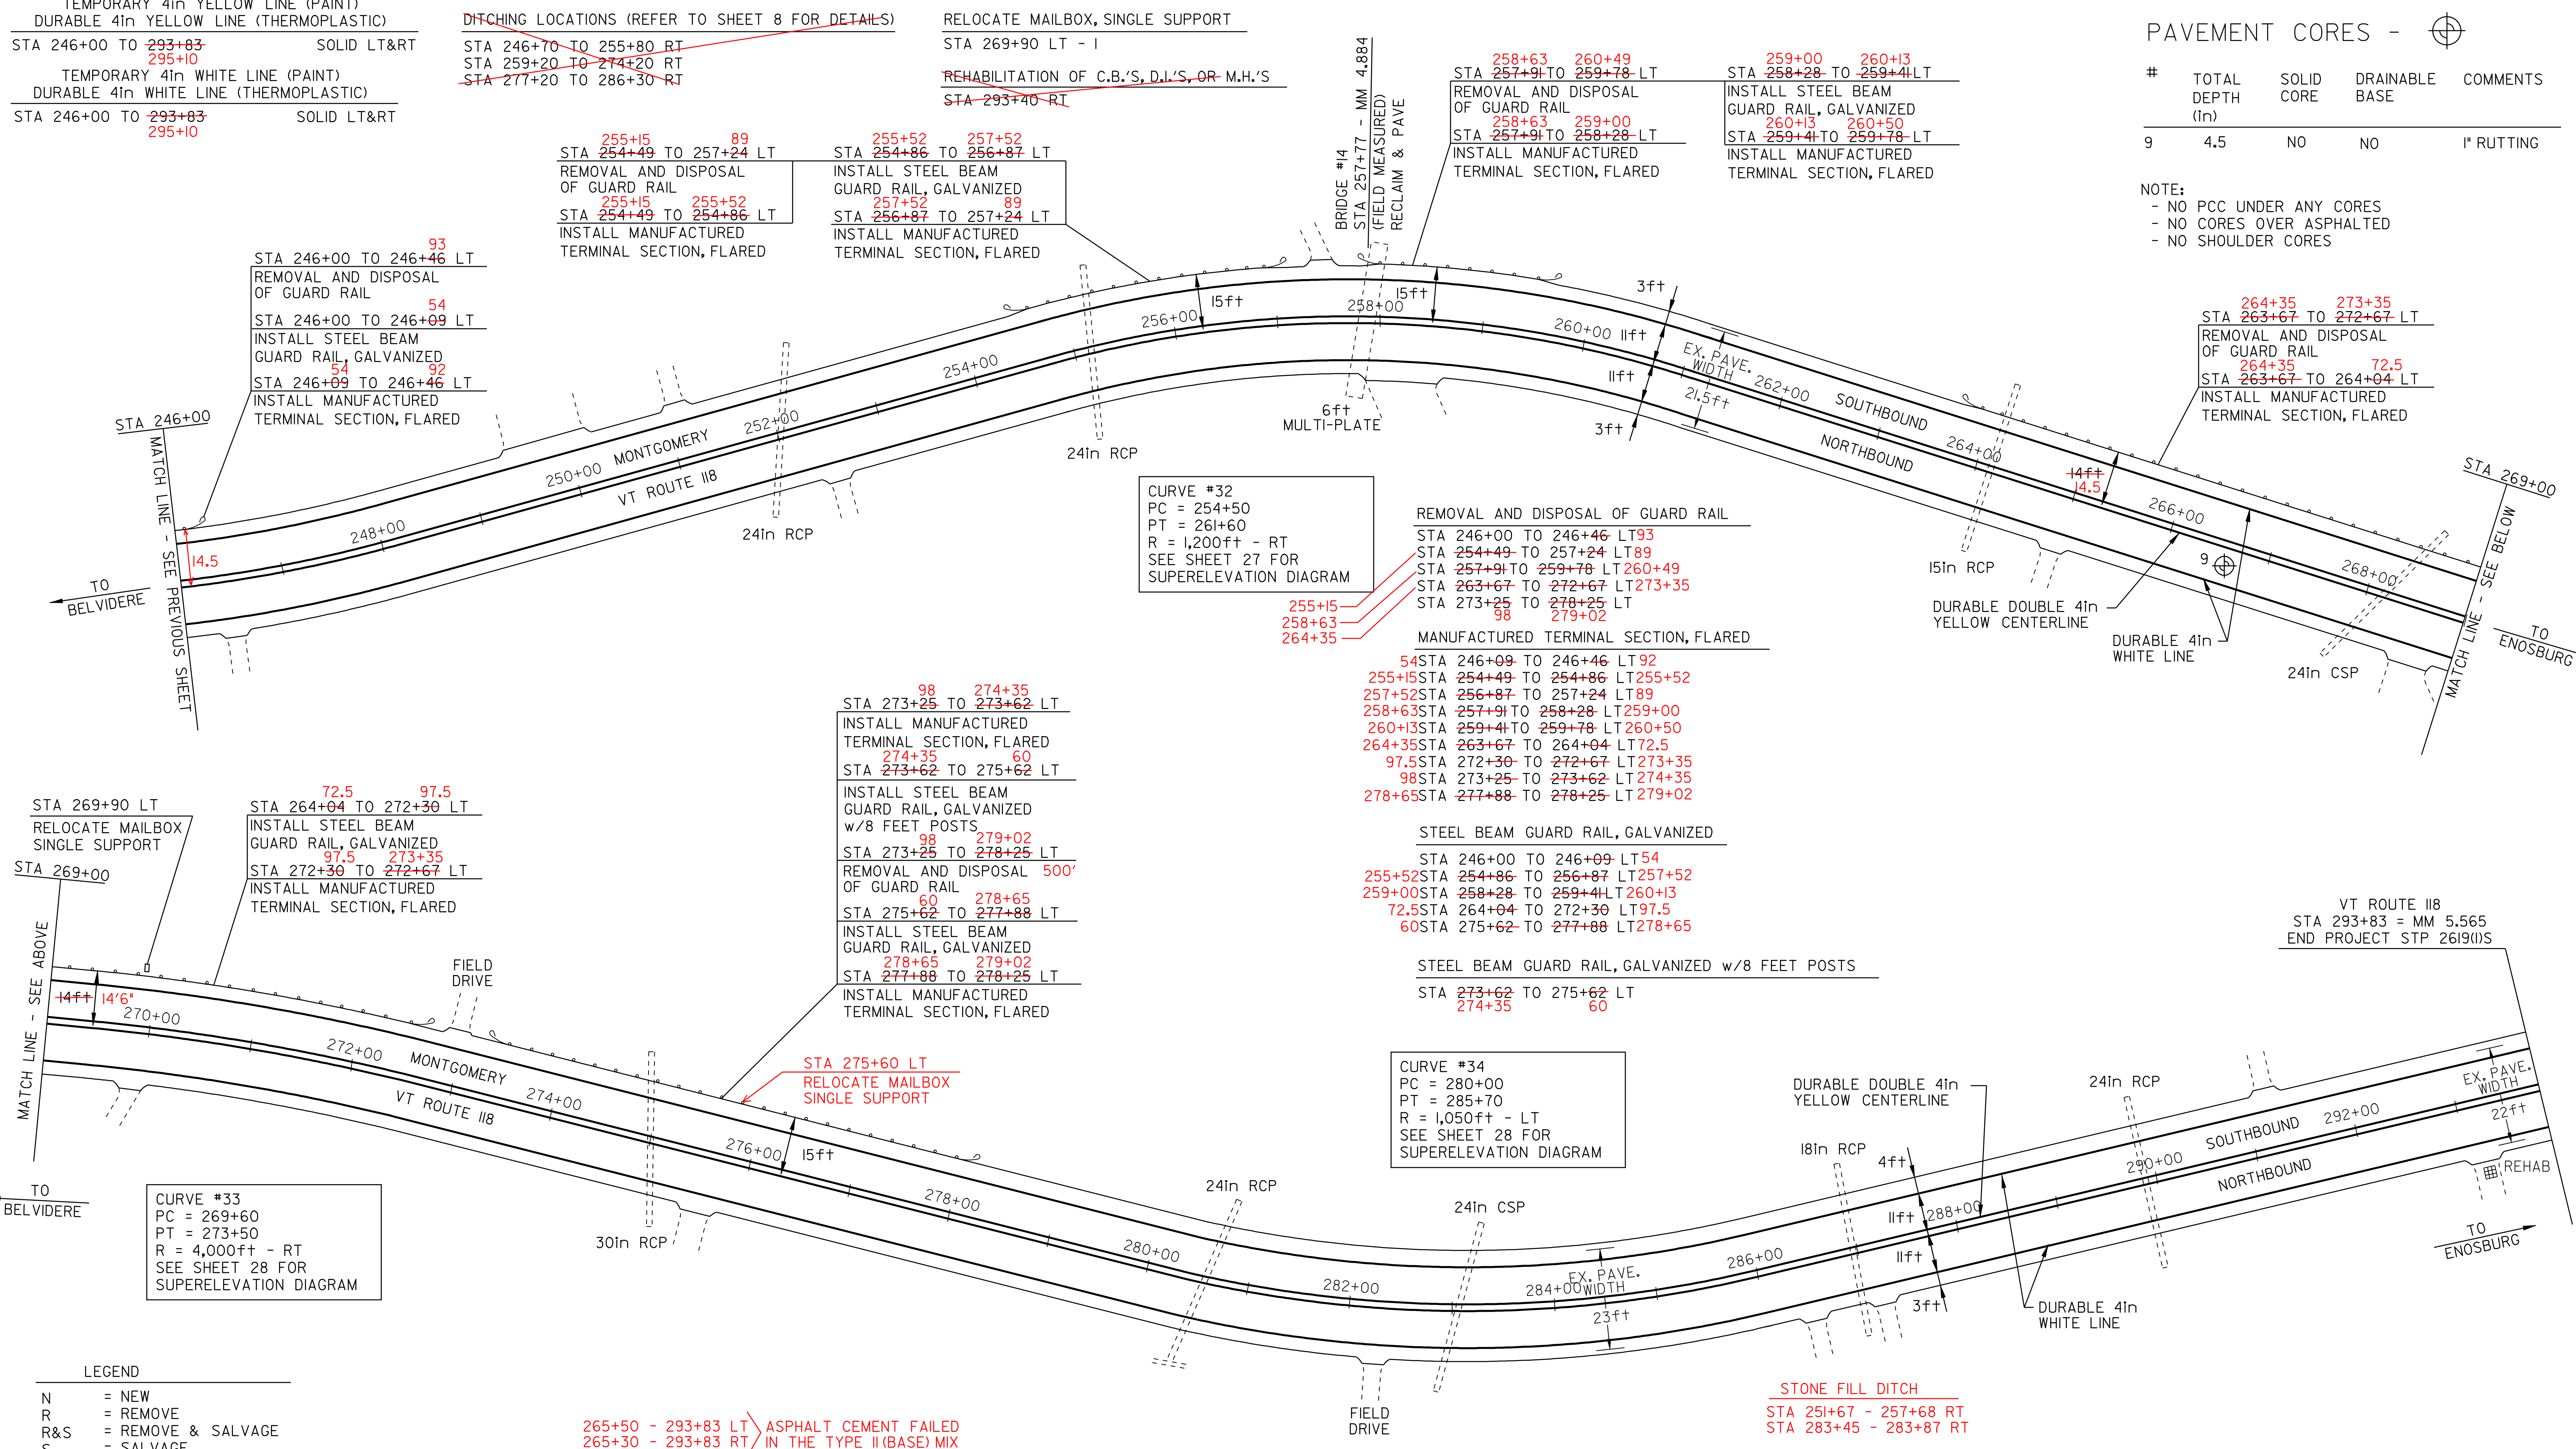

STA 269+90 LT
 RELOCATE MAILBOX
 SINGLE SUPPORT
 STA 269+00
 STA 264+04 TO 272+30 LT
 INSTALL STEEL BEAM
 GUARD RAIL, GALVANIZED
 97.5 273+35
 STA 272+30 TO 272+67 LT
 INSTALL MANUFACTURED
 TERMINAL SECTION, FLARED

98 274+35
 STA 273+25 TO 273+62 LT
 INSTALL MANUFACTURED
 TERMINAL SECTION, FLARED
 274+35 60
 STA 273+62 TO 275+62 LT
 INSTALL STEEL BEAM
 GUARD RAIL, GALVANIZED
 w/8 FEET POSTS
 98 279+02
 STA 273+25 TO 278+25 LT
 REMOVAL AND DISPOSAL
 OF GUARD RAIL 500'
 60 278+65
 STA 275+62 TO 277+88 LT
 INSTALL STEEL BEAM
 GUARD RAIL, GALVANIZED
 278+65 279+02
 STA 277+88 TO 278+25 LT
 INSTALL MANUFACTURED
 TERMINAL SECTION, FLARED

REMOVAL AND DISPOSAL OF GUARD RAIL
 STA 246+00 TO 246+46 LT 93
 STA 254+49 TO 257+24 LT 89
 STA 257+91 TO 259+78 LT 260+49
 STA 263+67 TO 272+67 LT 273+35
 STA 273+25 TO 278+25 LT
 98 279+02
 MANUFACTURED TERMINAL SECTION, FLARED
 54 STA 246+09 TO 246+46 LT 92
 255+15 STA 254+49 TO 254+86 LT 255+52
 257+52 STA 256+87 TO 257+24 LT 89
 258+63 STA 257+91 TO 258+28 LT 259+00
 260+13 STA 259+41 TO 259+78 LT 260+50
 264+35 STA 263+67 TO 264+04 LT 72.5
 97.5 STA 272+30 TO 272+67 LT 273+35
 98 STA 273+25 TO 273+62 LT 274+35
 278+65 STA 277+88 TO 278+25 LT 279+02



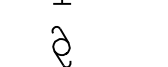

STEEL BEAM GUARD RAIL, GALVANIZED
 STA 246+00 TO 246+09 LT 54
 255+52 STA 254+86 TO 256+87 LT 257+52
 259+00 STA 258+28 TO 259+41 LT 260+13
 72.5 STA 264+04 TO 272+30 LT 97.5
 60 STA 275+62 TO 277+88 LT 278+65
 STEEL BEAM GUARD RAIL, GALVANIZED w/8 FEET POSTS
 STA 273+62 TO 275+62 LT
 274+35 60

CURVE #34
 PC = 280+00
 PT = 285+70
 R = 1,050ft - LT
 SEE SHEET 28 FOR
 SUPERELEVATION DIAGRAM

CURVE #33
 PC = 269+60
 PT = 273+50
 R = 4,000ft - RT
 SEE SHEET 28 FOR
 SUPERELEVATION DIAGRAM



265+50 - 293+83 LT ASPHALT CEMENT FAILED
 265+30 - 293+83 RT IN THE TYPE II (BASE) MIX

DITCHING LOCATIONS
 STA 249+48 - 251+67 RT
 STA 262+65 - 268+30 RT
 STA 270+73 - 272+15 RT
 STA 279+00 - 281+00 RT

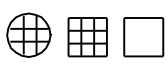- LEGEND
- N = NEW
 - R = REMOVE
 - R&S = REMOVE & SALVAGE
 - S = SALVAGE
 - RET = RETAIN
 - B-TO-B = BACK TO BACK
 -  CATCH BASIN/DI
 -  EXISTING THROAT DI
 - (N.W.) NO WORK REQUIRED (TYP. FOR W.V.'S, C.S.'S, D.I.'S, C.B.'S WHERE NOTED)
 - I YIELDING MARKER POST
 -  UTILITY POLE
 -  DRIVE



PAVING PROJECT LAYOUT SHEET #9

DESIGNED BY	BCE/PJM	DATE	6-07
DRAWN BY	C.E.A., INC.	DATE	6-07
DESIGN FILE NO.	p06cl62.dgn		
PRF FILE	p06cl62pp19.i	DATE PLOTTED	03-NOV-2009
PROJ. NAME	BELVIDERE - MONTGOMERY		
PROJ. NO.	STP 2619(1)S		
SHEET	17	OF	33 SHEETS

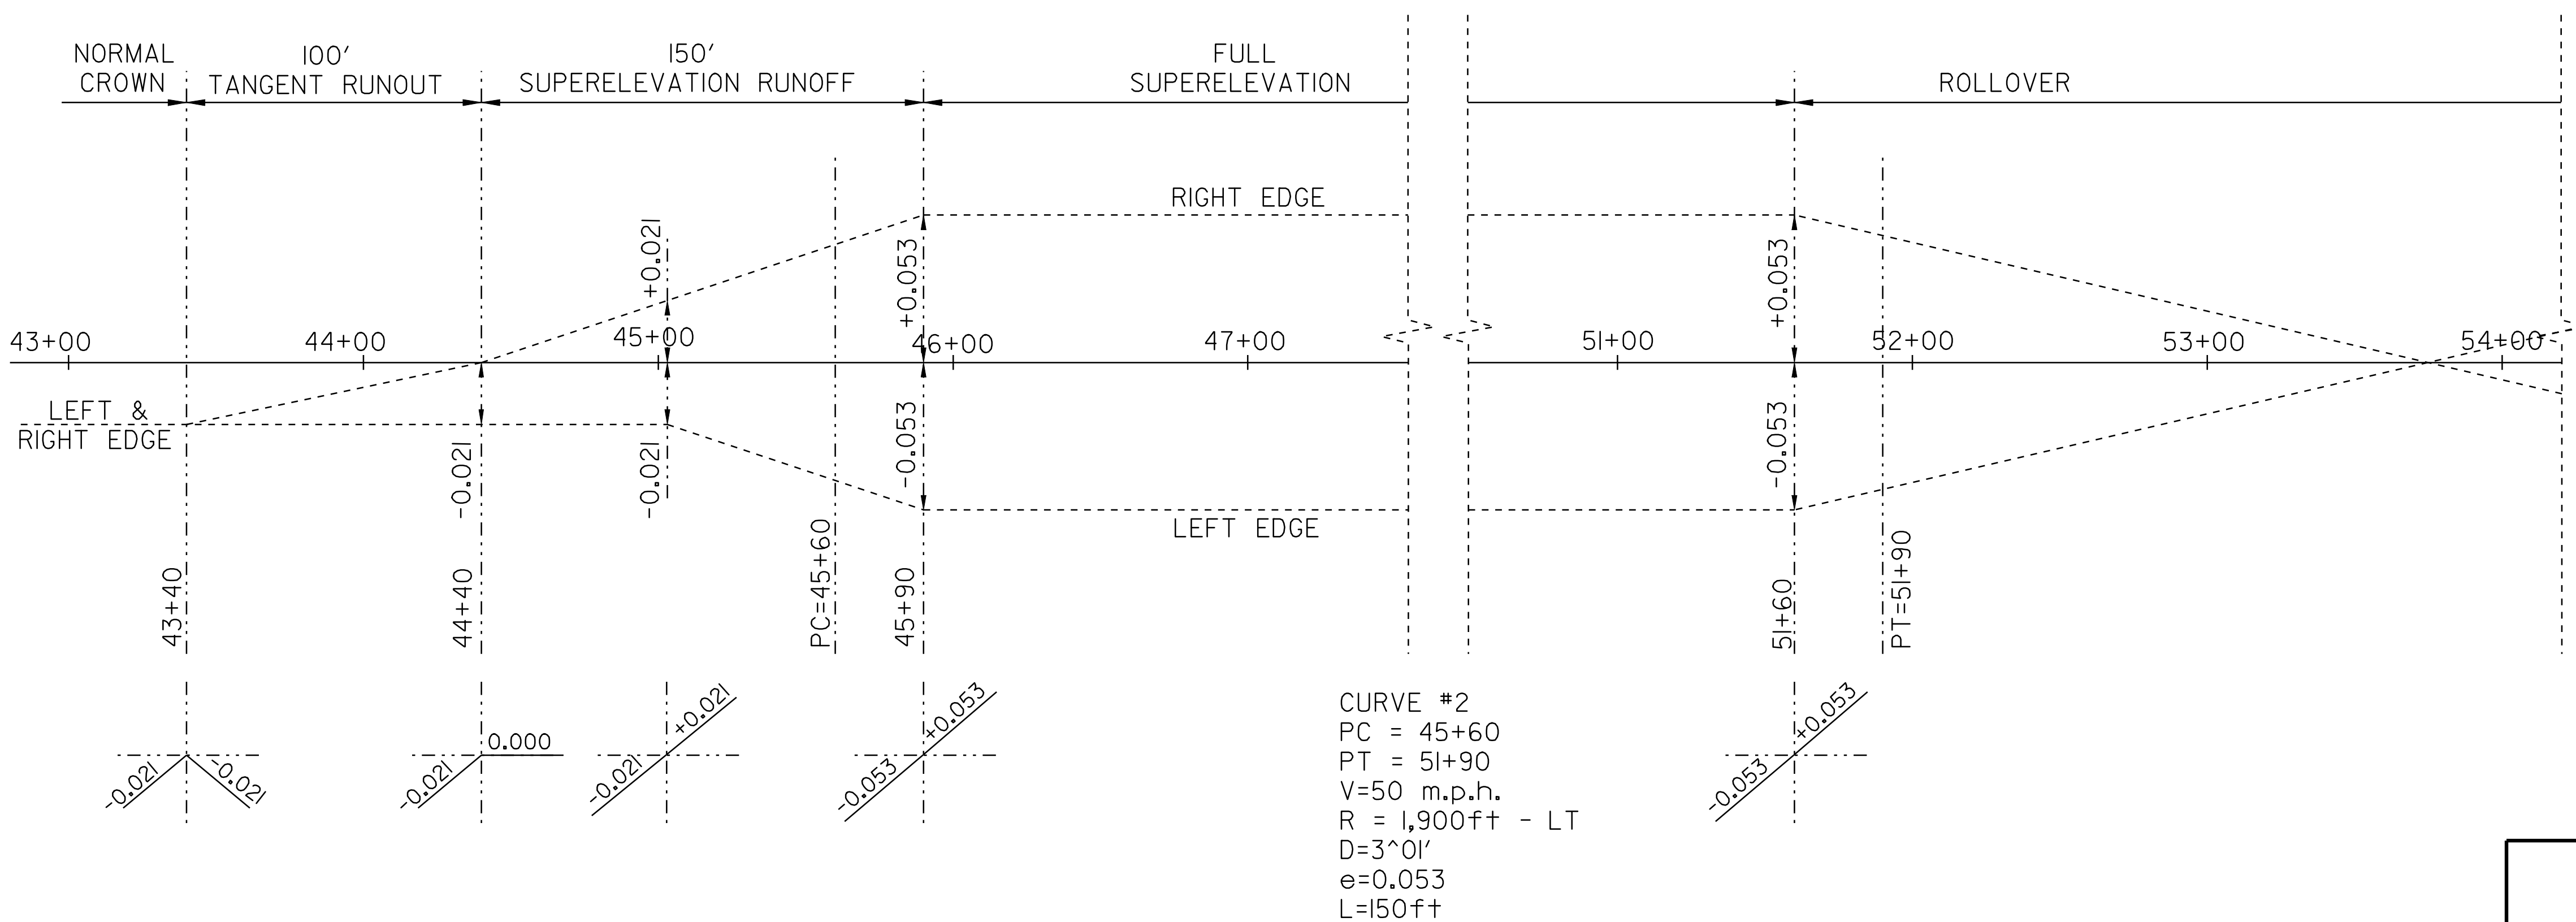
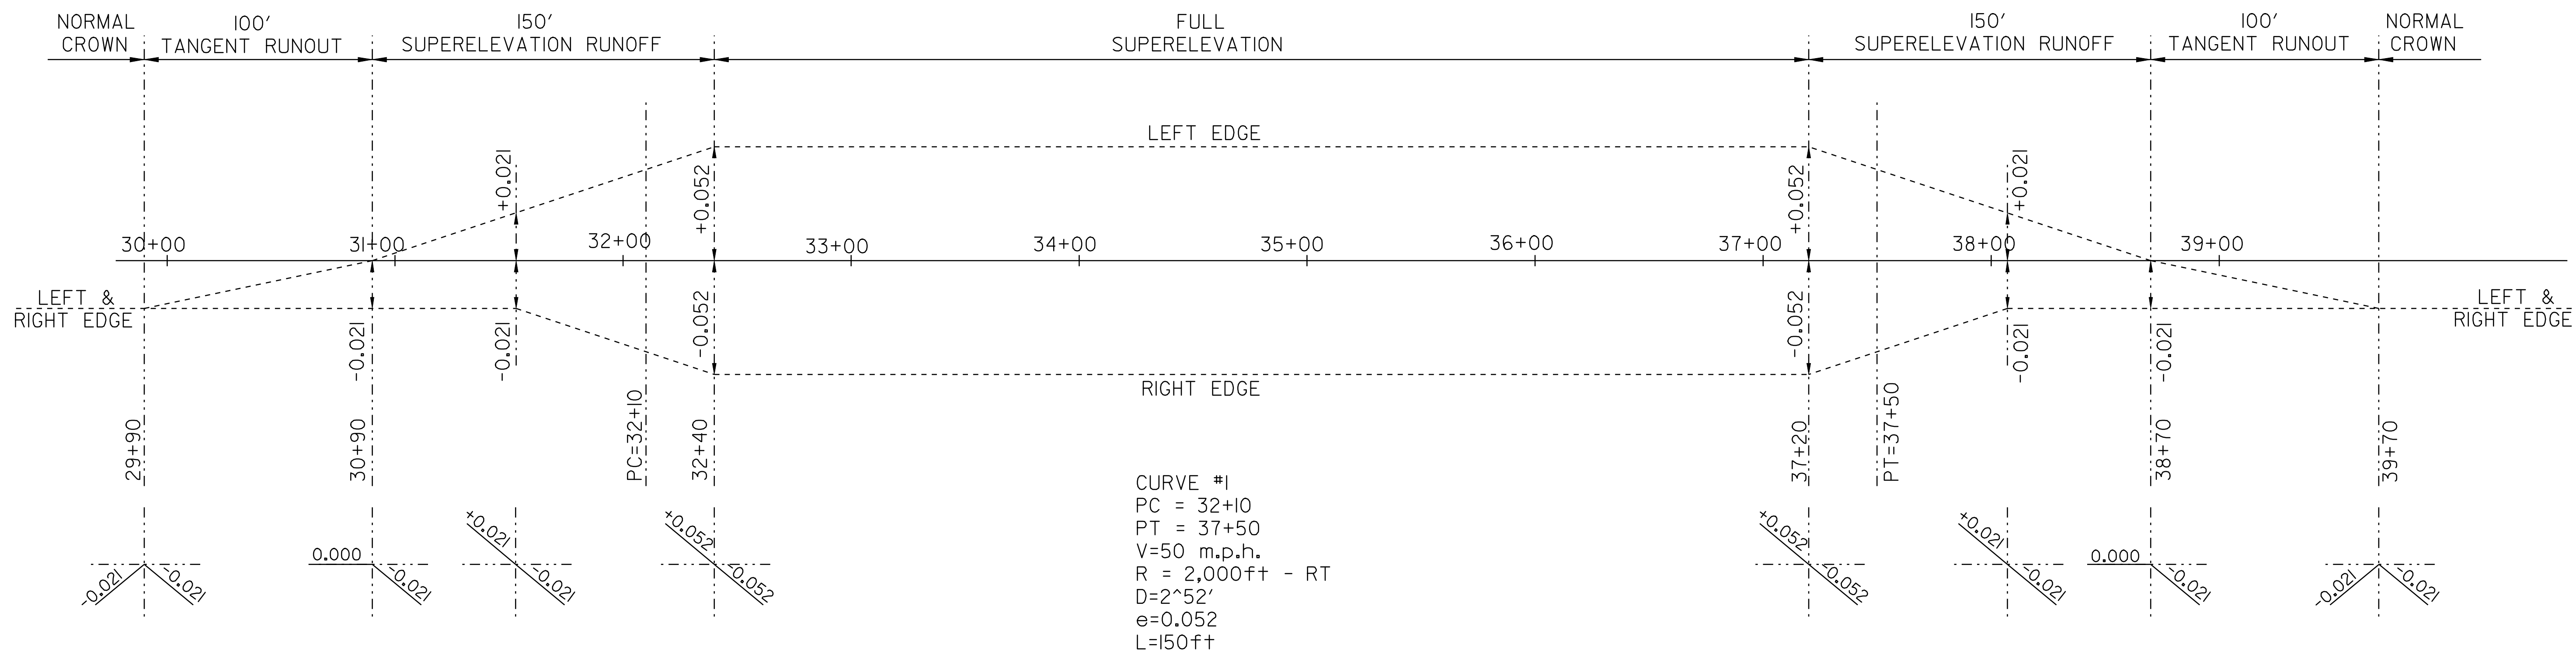


SUPERELEVATION BANKING DIAGRAM SHEET #1

DESIGNED BY	BCE/PJM	DATE	6-07
DRAWN BY	C.E.A., INC.	DATE	6-07
DESIGN FILE NO.	p06cl62.dgn		
PRF FILE	p06cl62sbd01.1	DATE PLOTTED	03-NOV-2009 10
PROJ. NAME	BELVIDERE - MONTGOMERY		
PROJ. NO.	STP 2619(1)S		
SHEET	18	OF	33 SHEETS

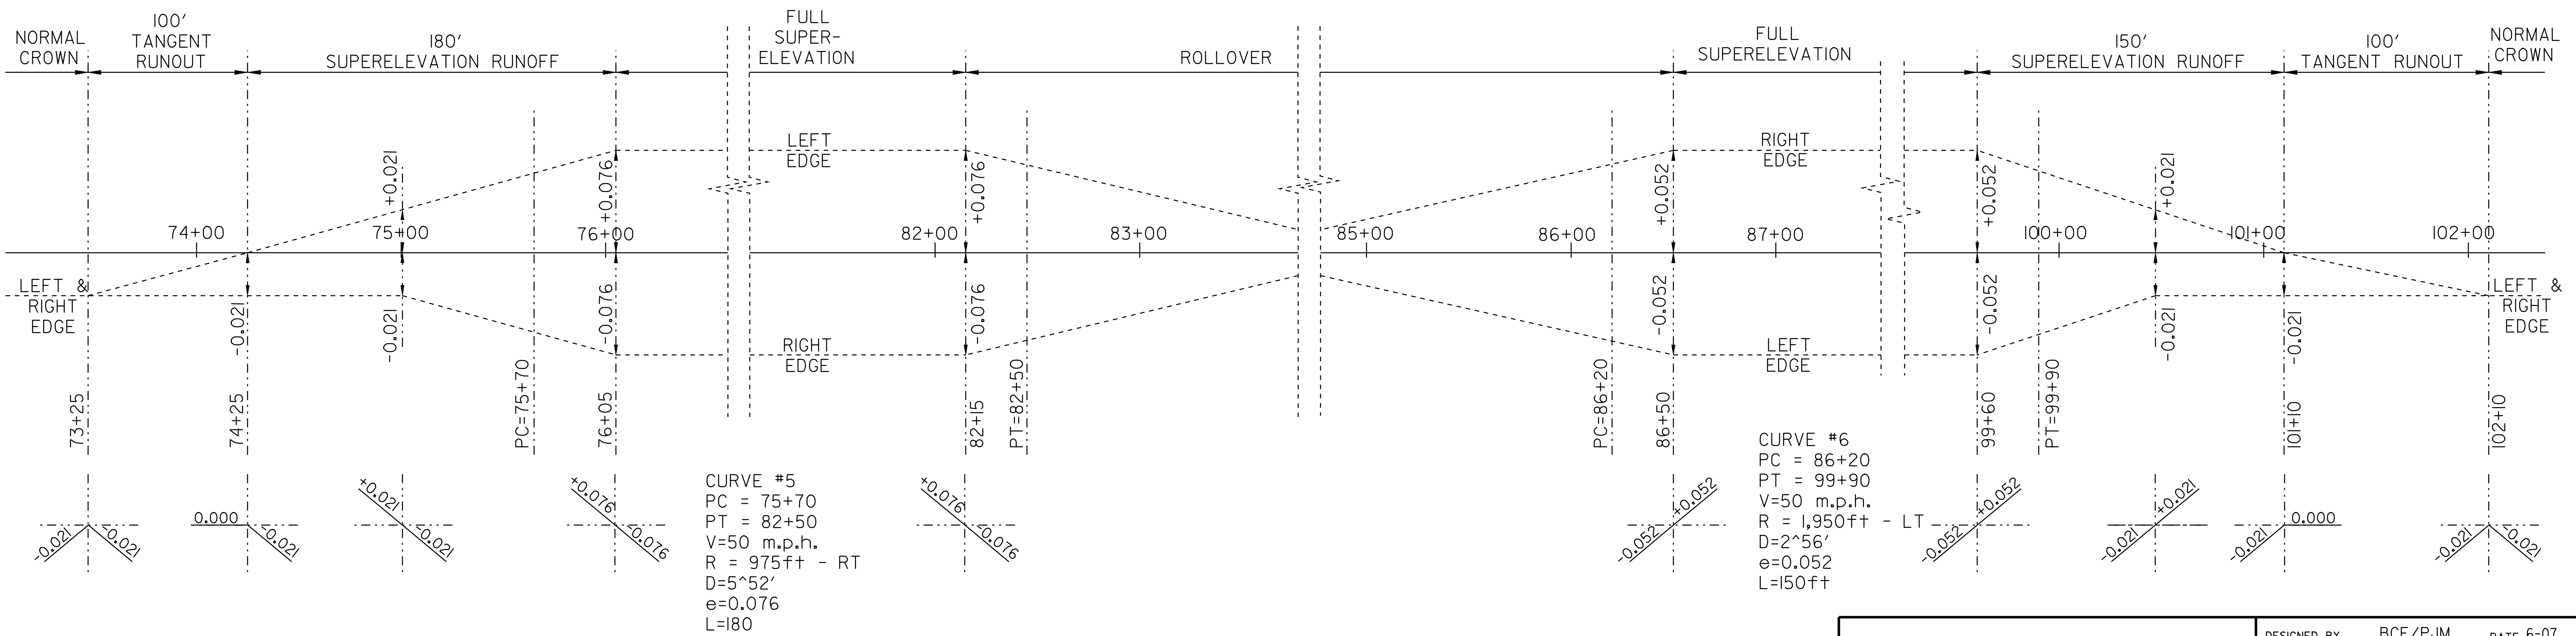
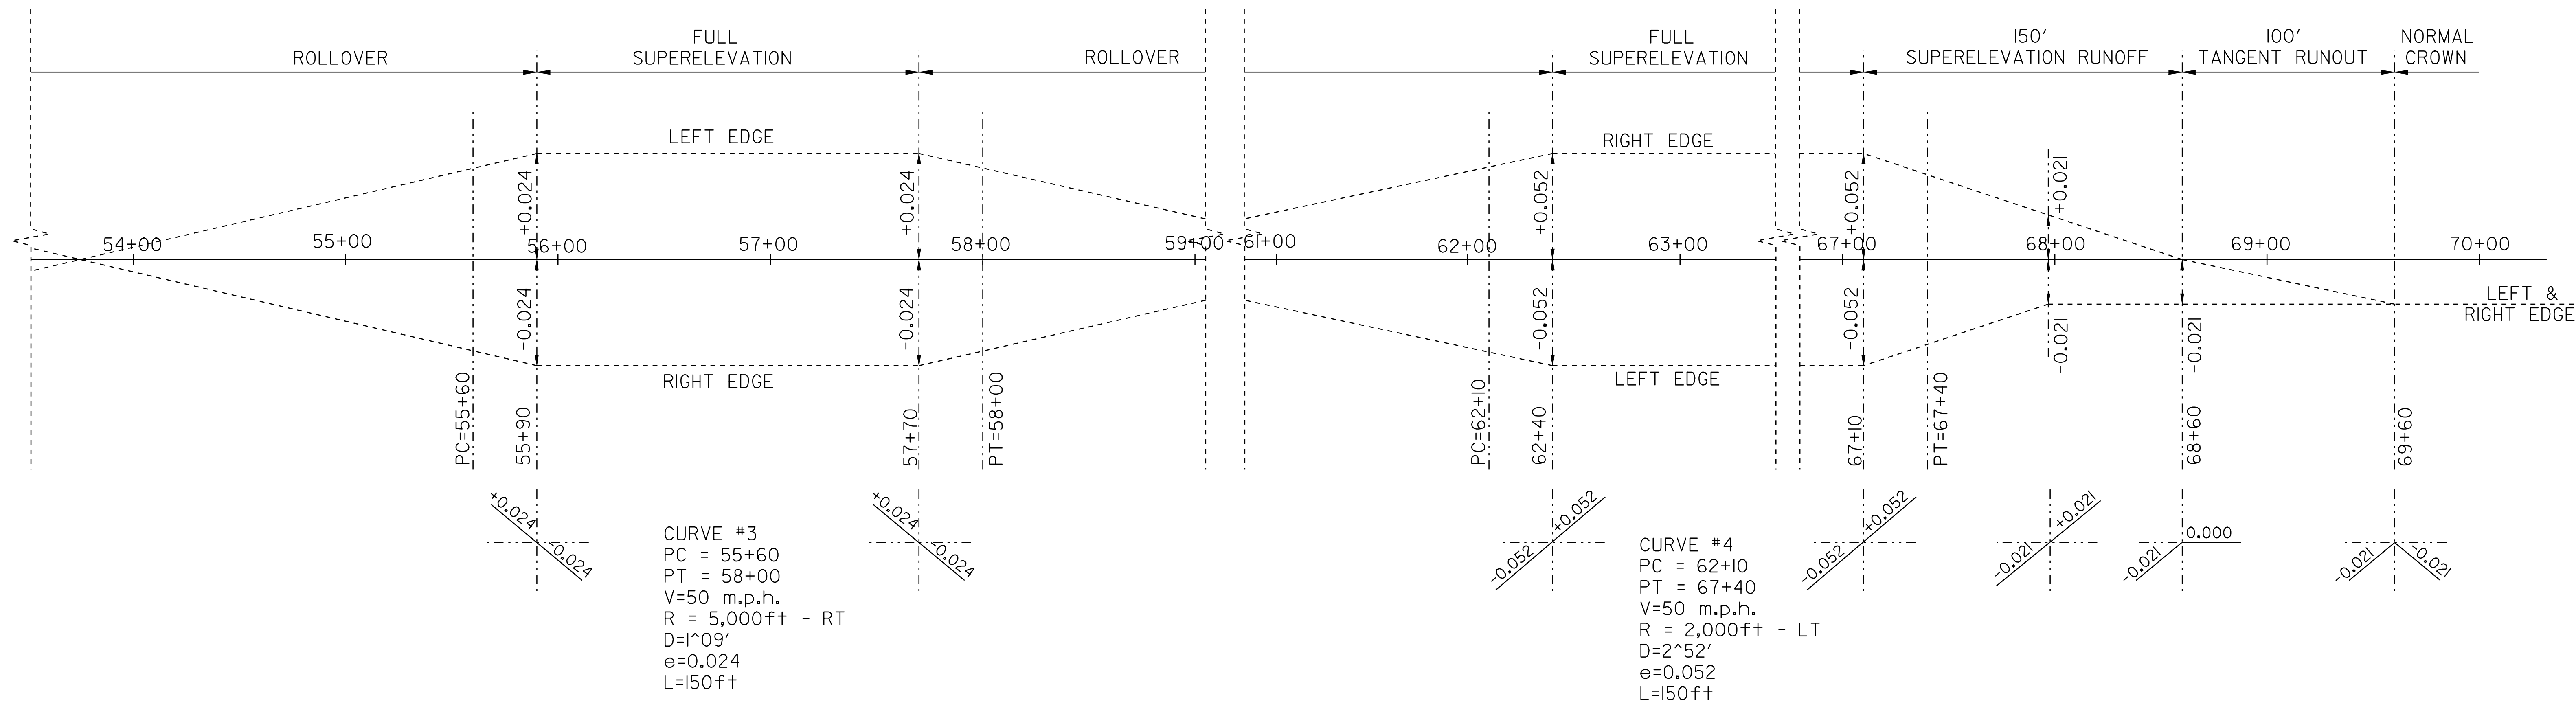


SUPERELEVATION BANKING DIAGRAM SHEET #2		DESIGNED BY	BCE/PJM	DATE	6-07
		DRAWN BY	C.E.A., INC.	DATE	6-07
		DESIGN FILE NO.	p06cl62.dgn		
		PRF FILE	p06cl62sbd02.1	DATE PLOTTED	03-NOV-2009 10
		PROJ. NAME	BELVIDERE - MONTGOMERY		
		PROJ. NO.	STP 2619(1)S		
		SHEET	19	OF	33 SHEETS

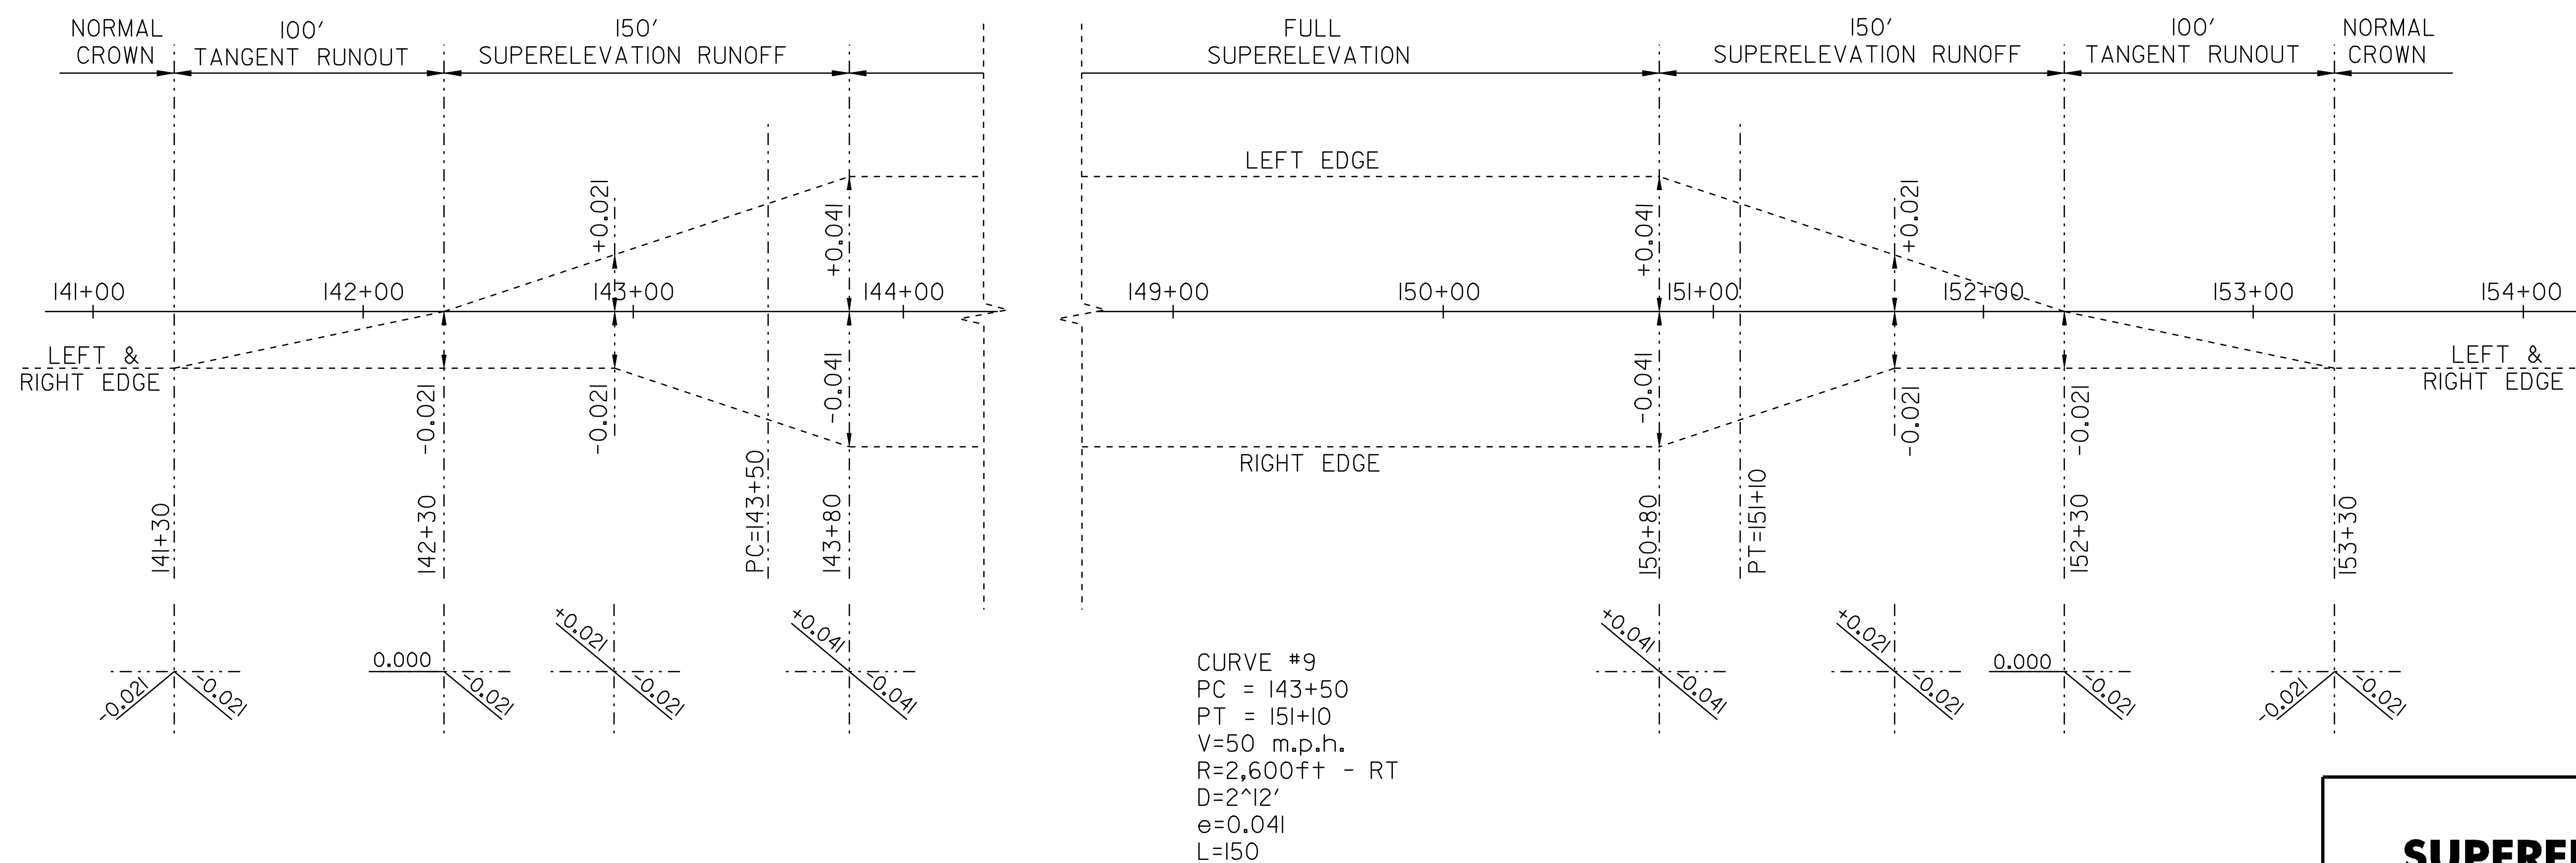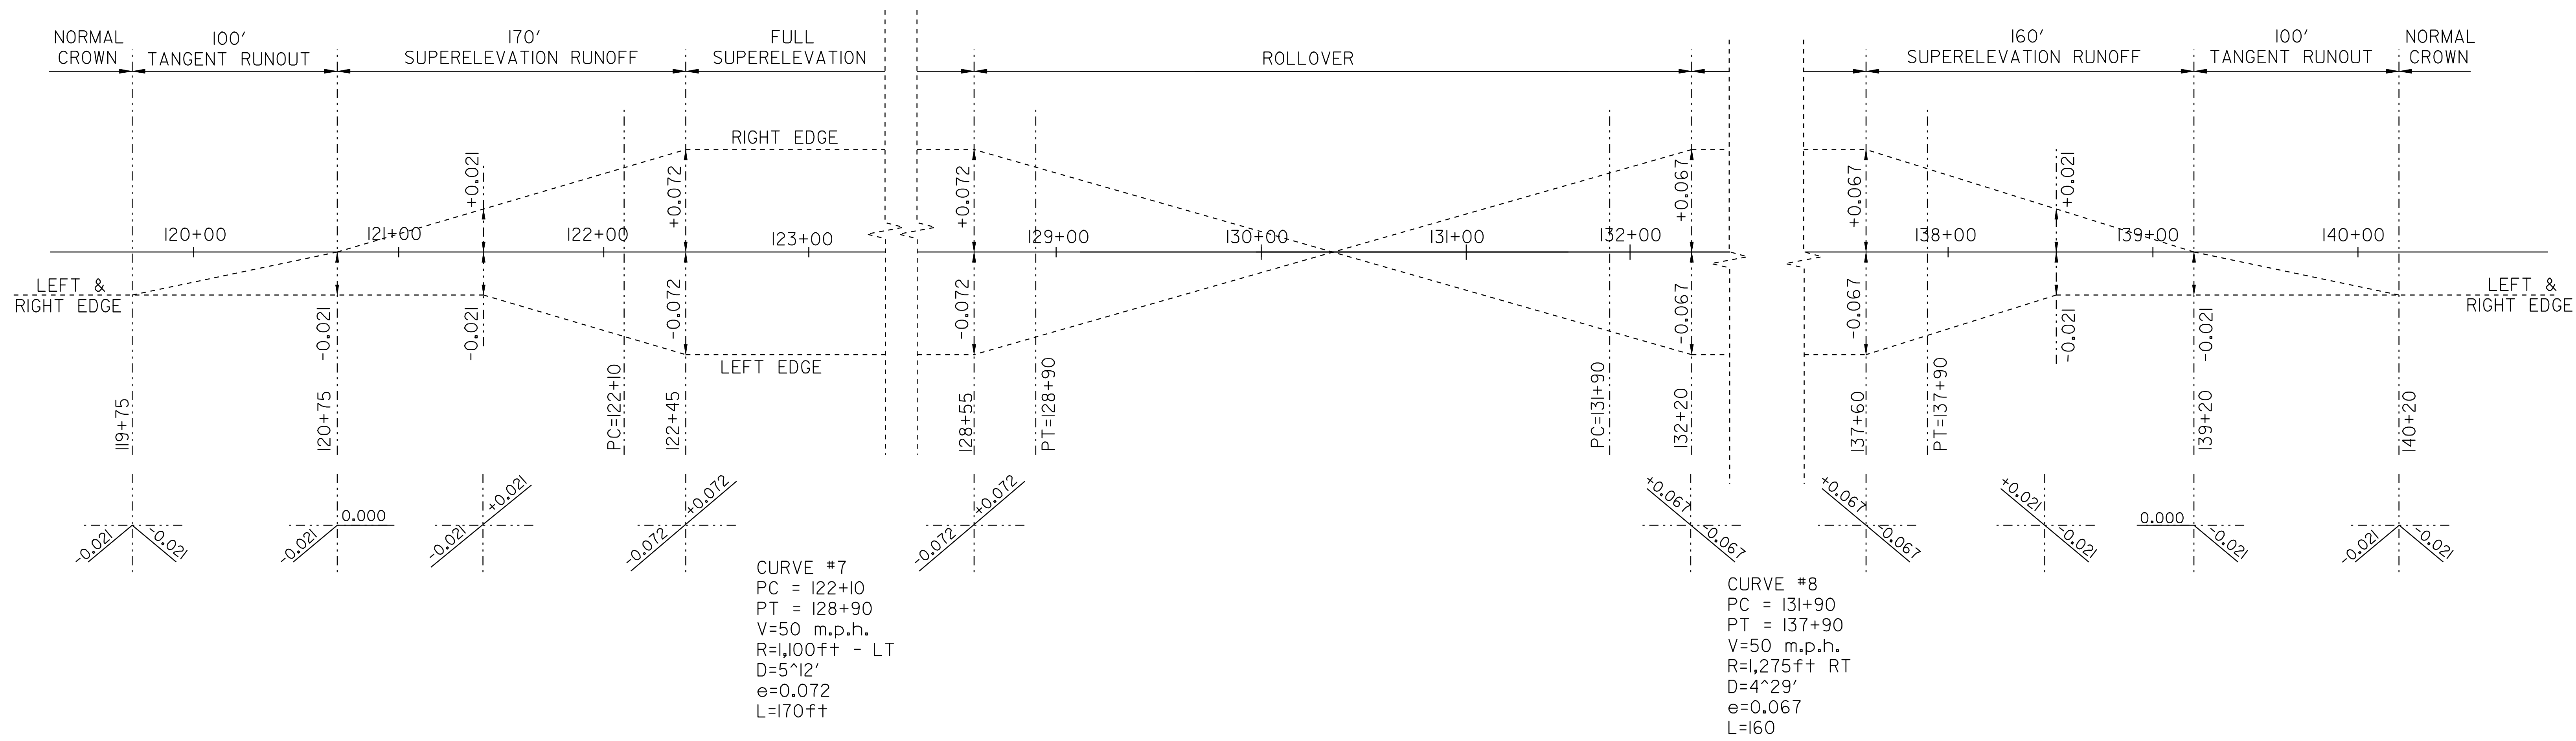

SUPERELEVATION BANKING DIAGRAM SHEET #3



DESIGNED BY	BCE/PJM	DATE	6-07
DRAWN BY	C.E.A., INC.	DATE	6-07
DESIGN FILE NO.	p06cl62.dgn		
PRF FILE	p06cl62sbd03.l	DATE PLOTTED	03-NOV-2009 10
PROJ. NAME	BELVIDERE - MONTGOMERY		
PROJ. NO.	STP 2619(1)S		
SHEET	20	OF	33 SHEETS

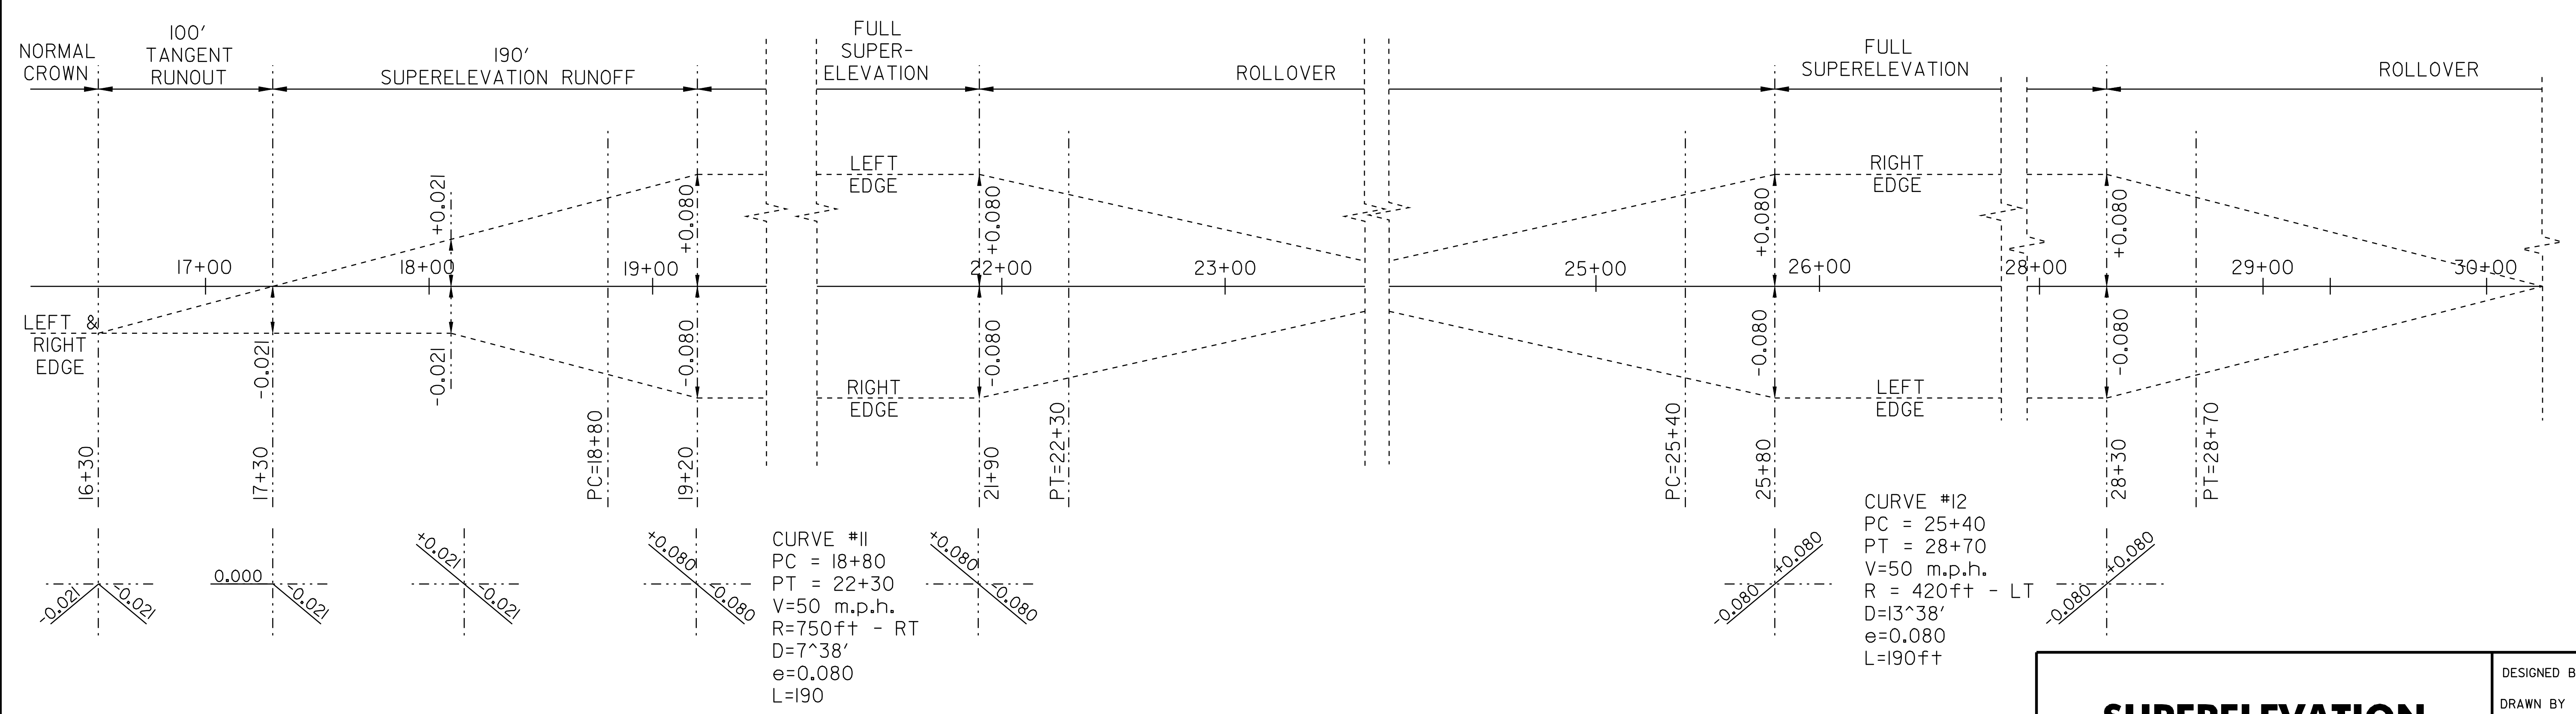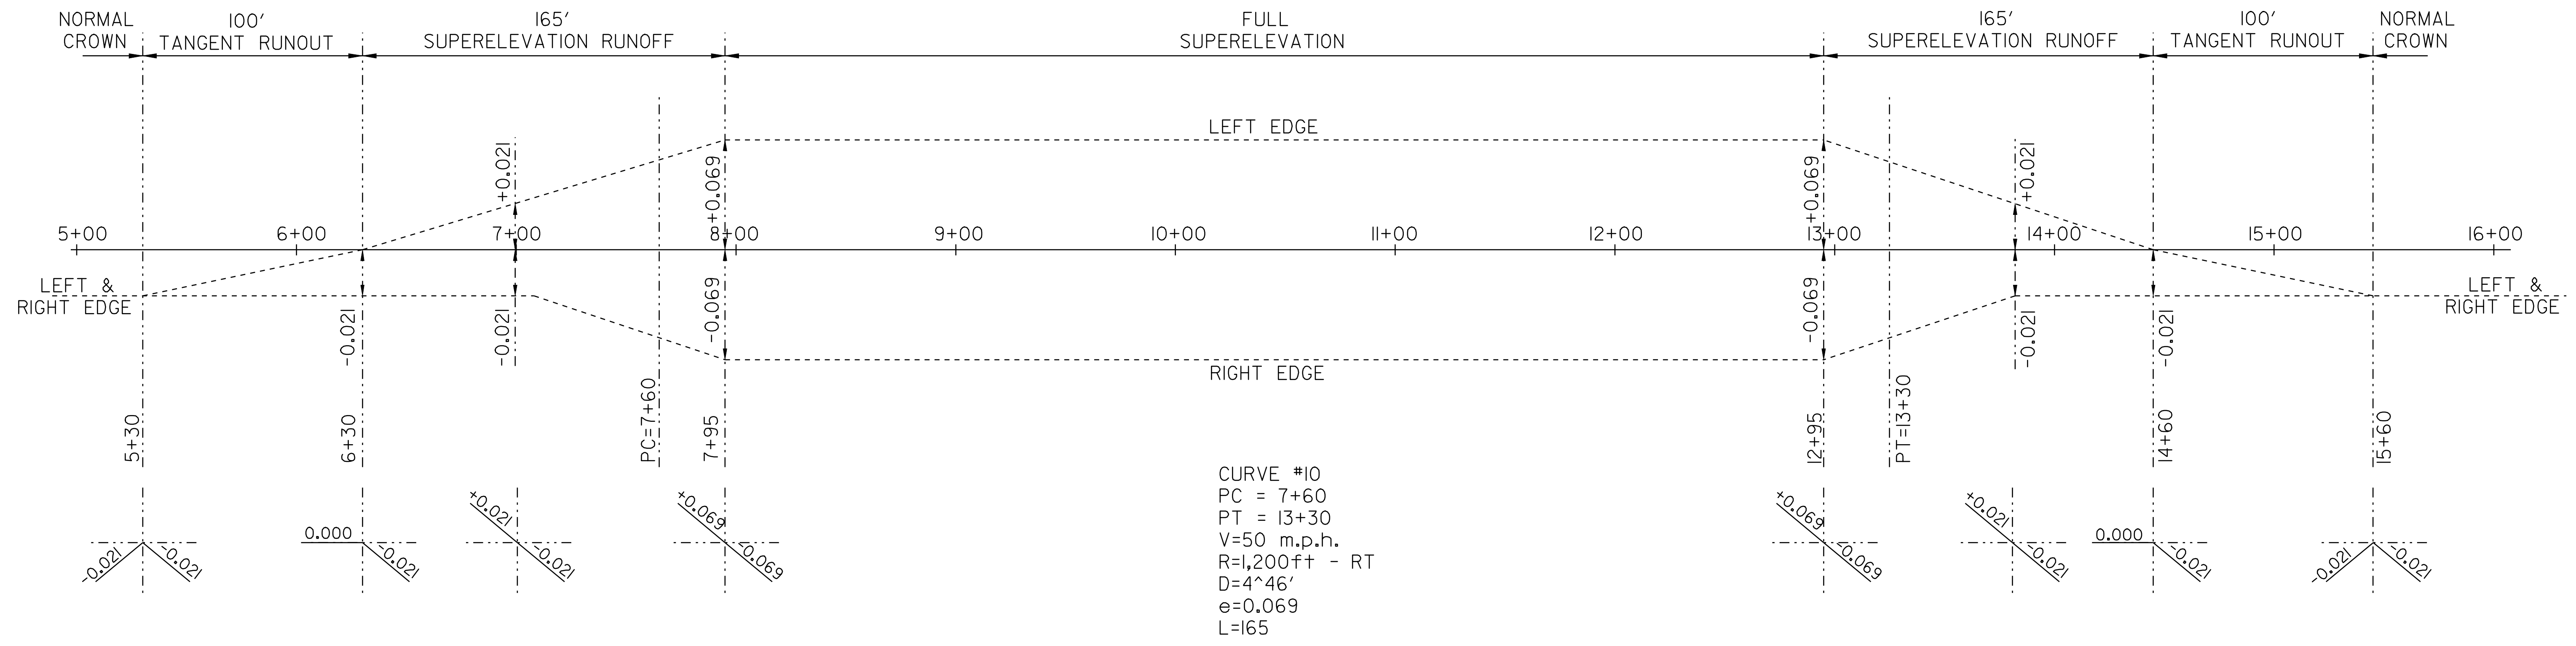

CURVE #12
 PC = 25+40
 PT = 28+70
 V=50 m.p.h.
 R = 420ft - LT
 D=13^38'
 e=0.080
 L=190ft



SUPERELEVATION BANKING DIAGRAM SHEET #4

DESIGNED BY BCE/PJM DATE 6-07
 DRAWN BY C.E.A., INC. DATE 6-07
 DESIGN FILE NO. p06cl62.dgn
 PRF FILE p06cl62sbd04.1 DATE PLOTTED 03-NOV-2009 10
 PROJ. NAME **BELVIDERE - MONTGOMERY**
 PROJ. NO. **STP 2619(1)S**
 SHEET **21** OF **33** SHEETS

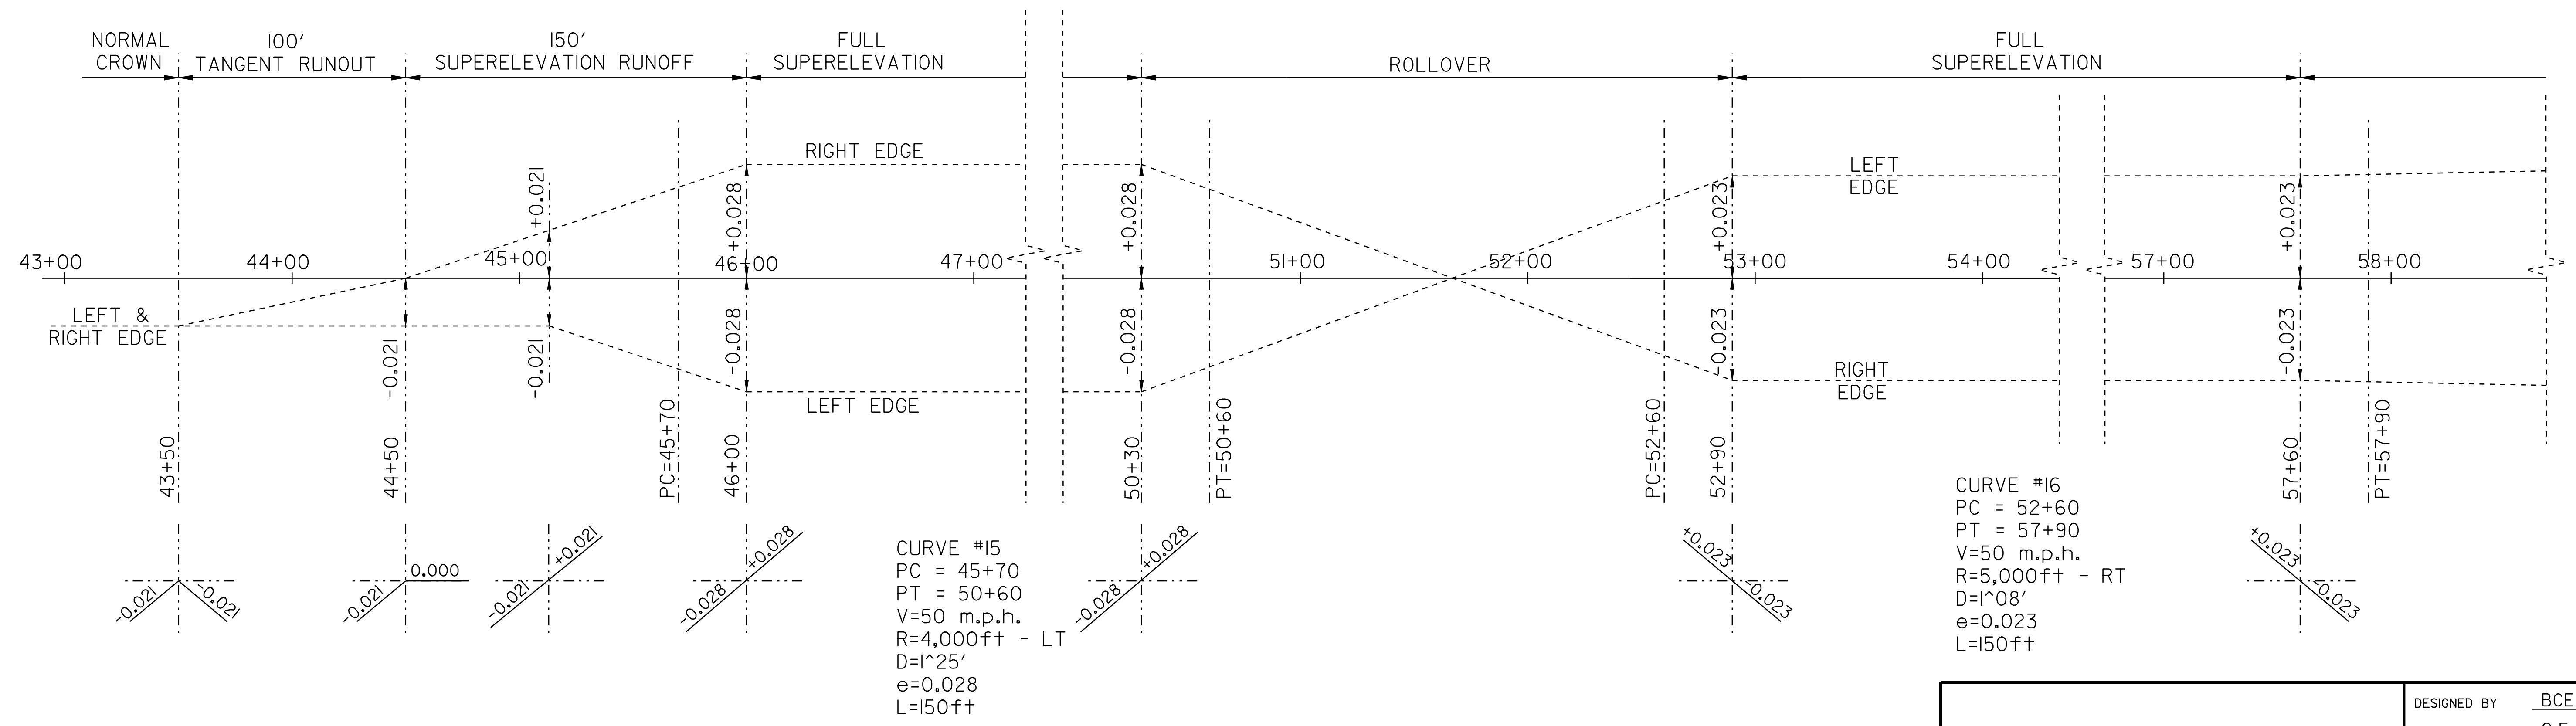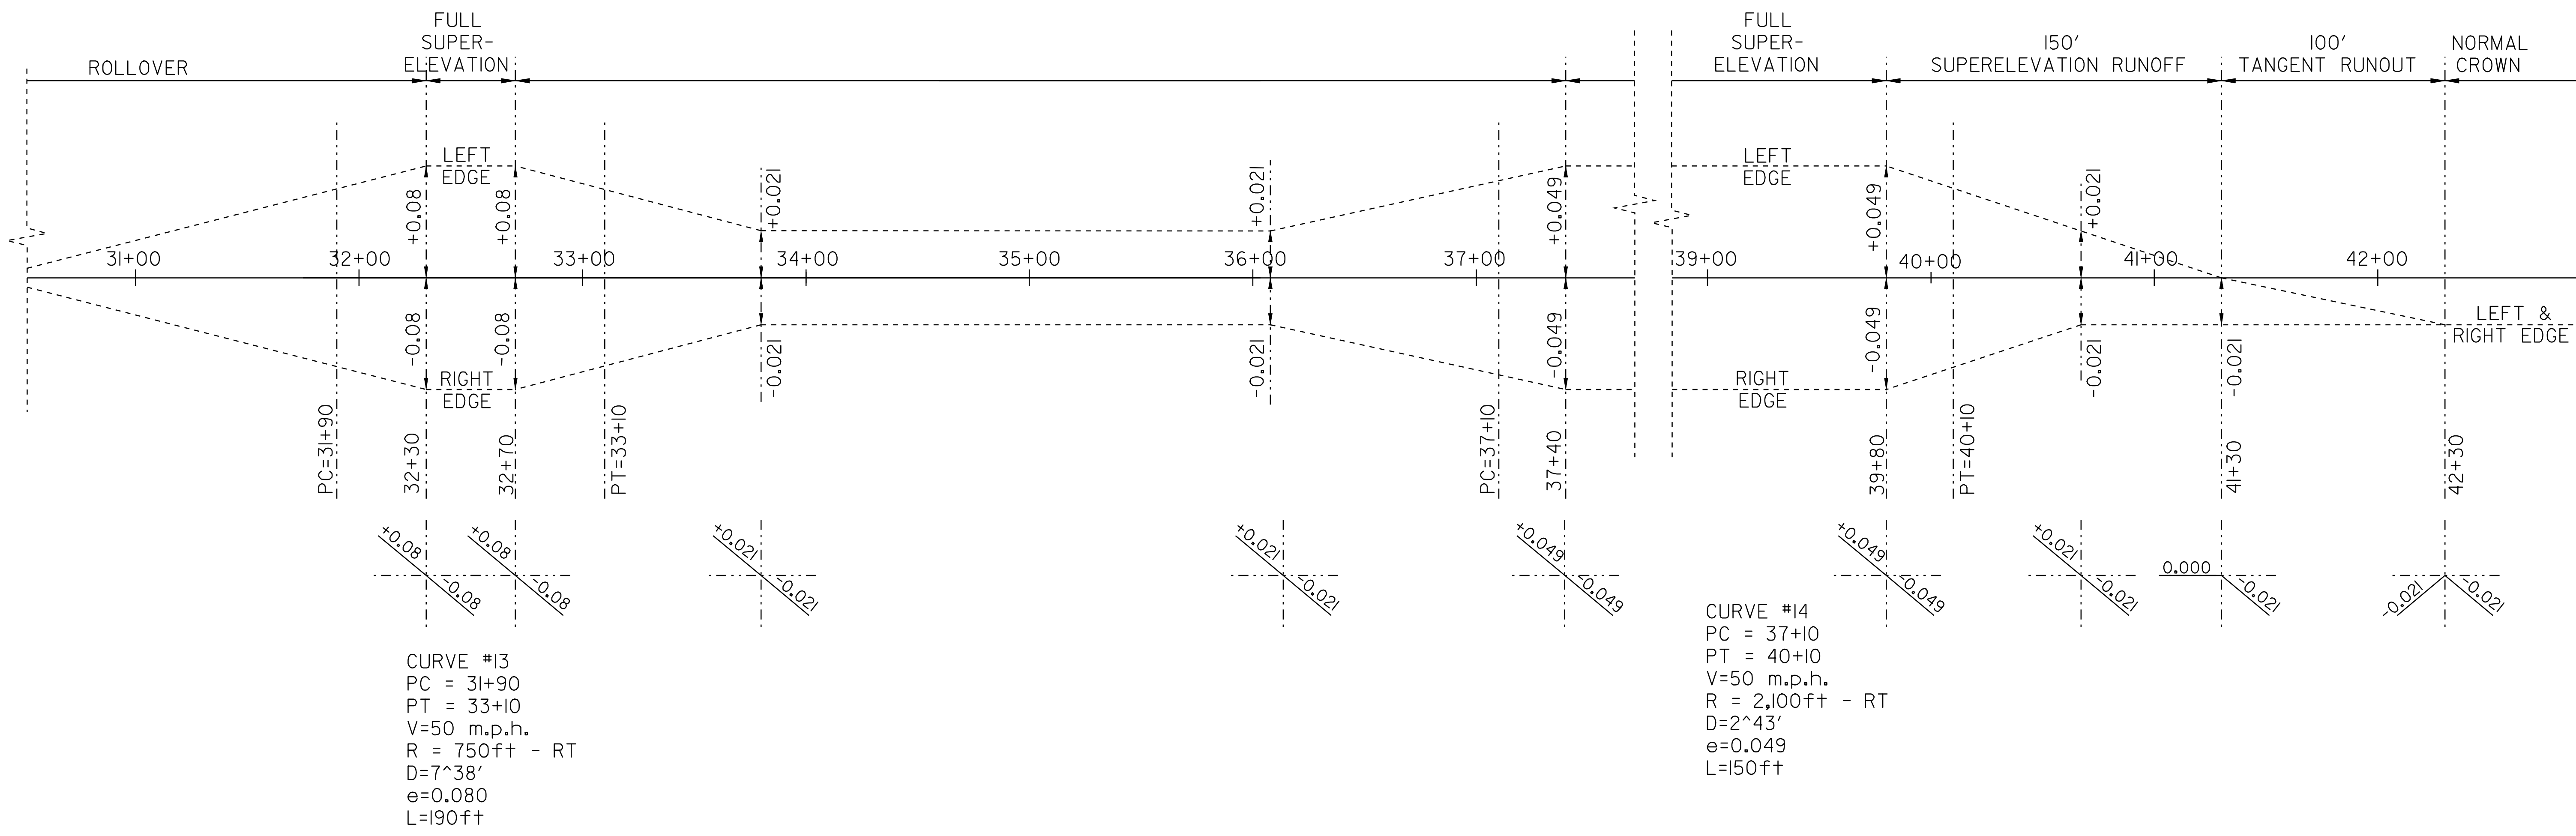



SUPERELEVATION BANKING DIAGRAM SHEET #5

DESIGNED BY	BCE/PJM	DATE	6-07
DRAWN BY	C.E.A., INC.	DATE	6-07
DESIGN FILE NO.	p06cl62.dgn		
PRF FILE	p06cl62sbd05.1	DATE PLOTTED	03-NOV-2009 10
PROJ. NAME	BELVIDERE - MONTGOMERY		
PROJ. NO.	STP 2619(1)S		
SHEET	22	OF	33 SHEETS

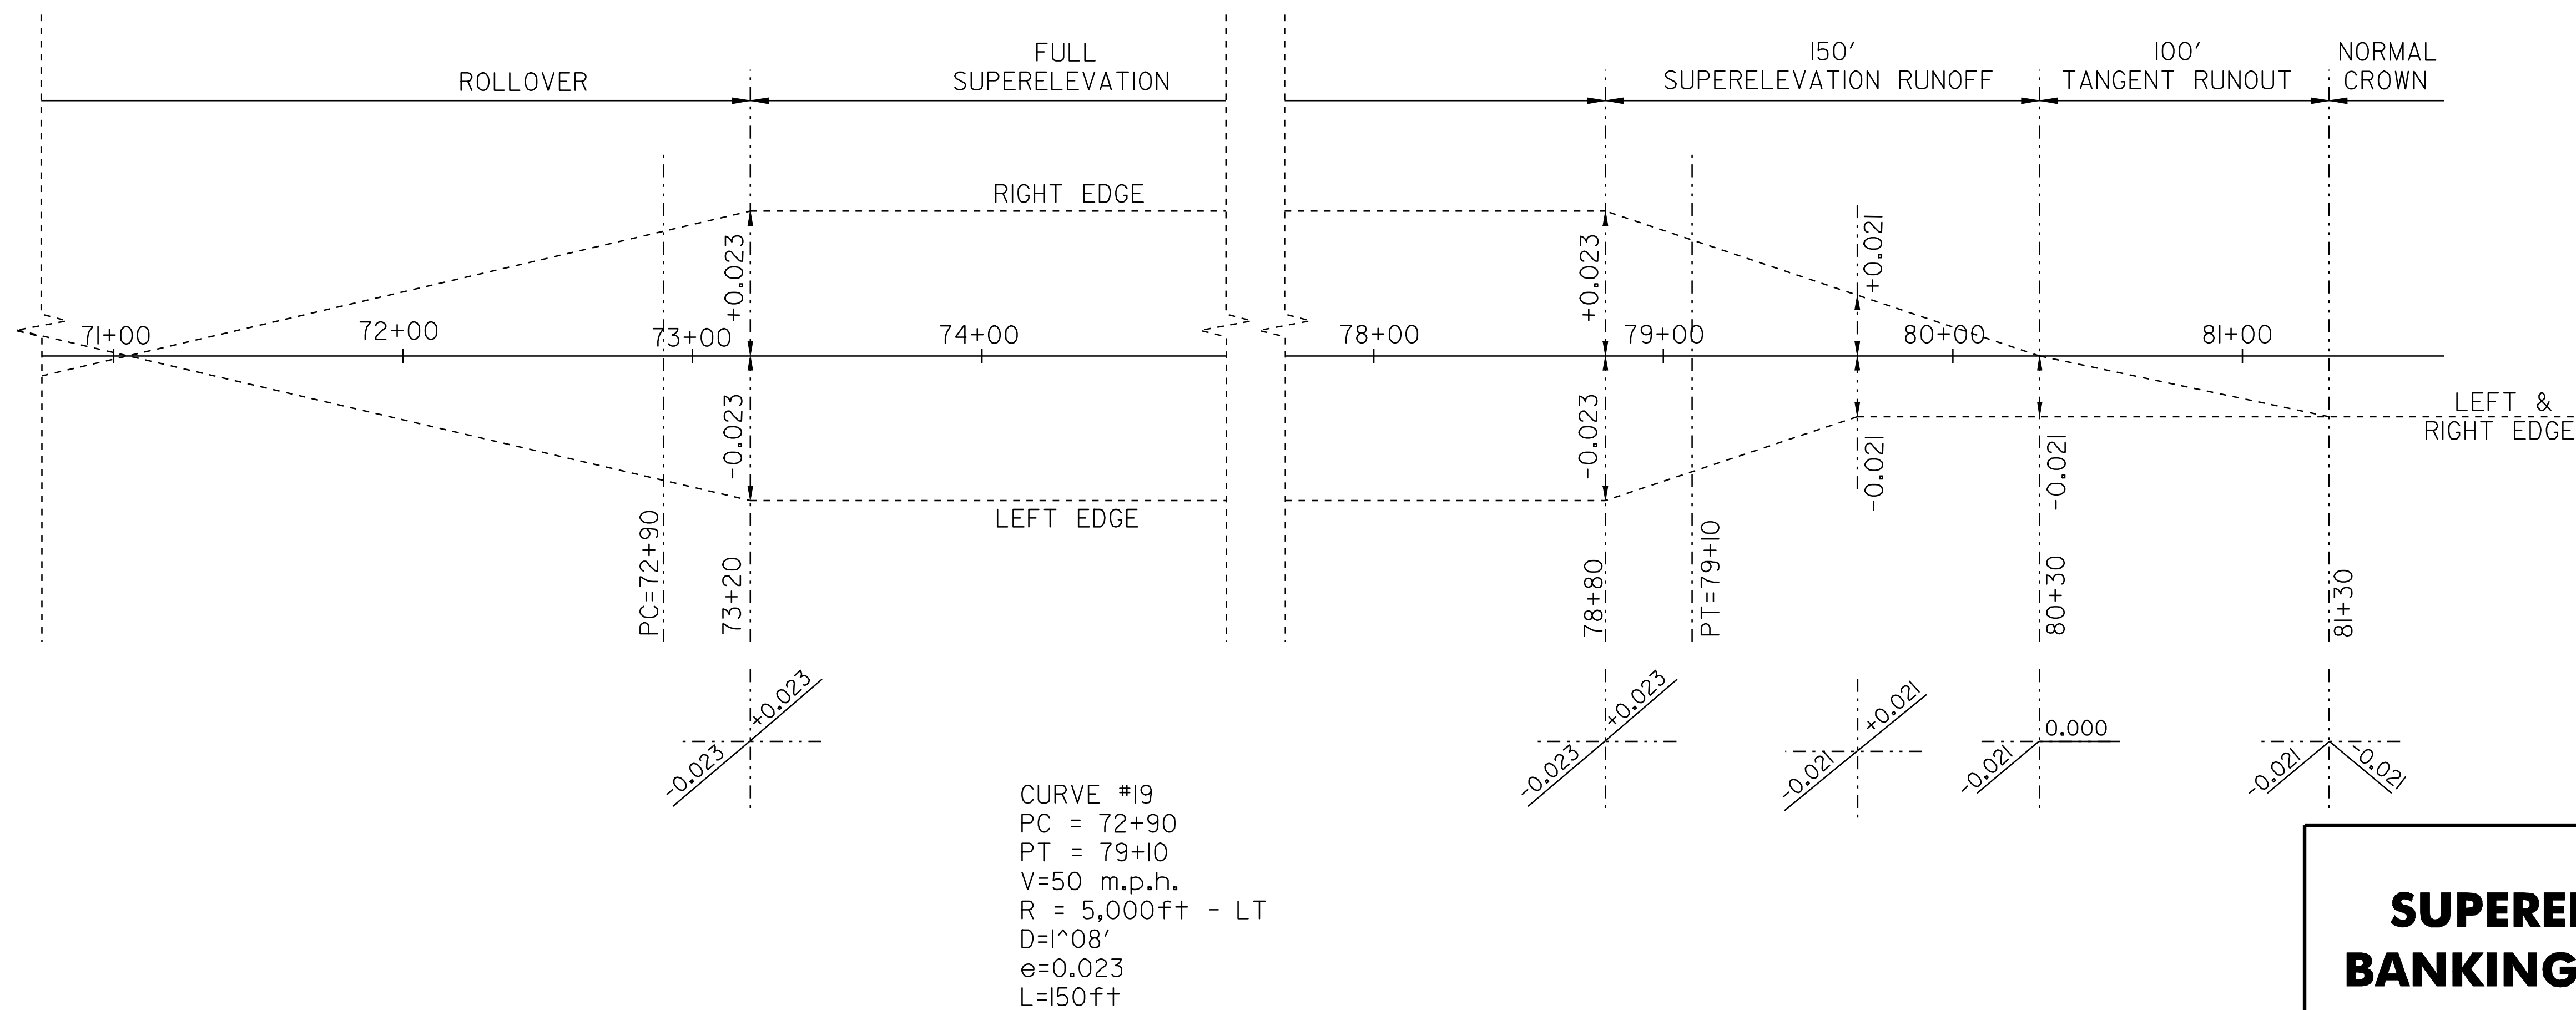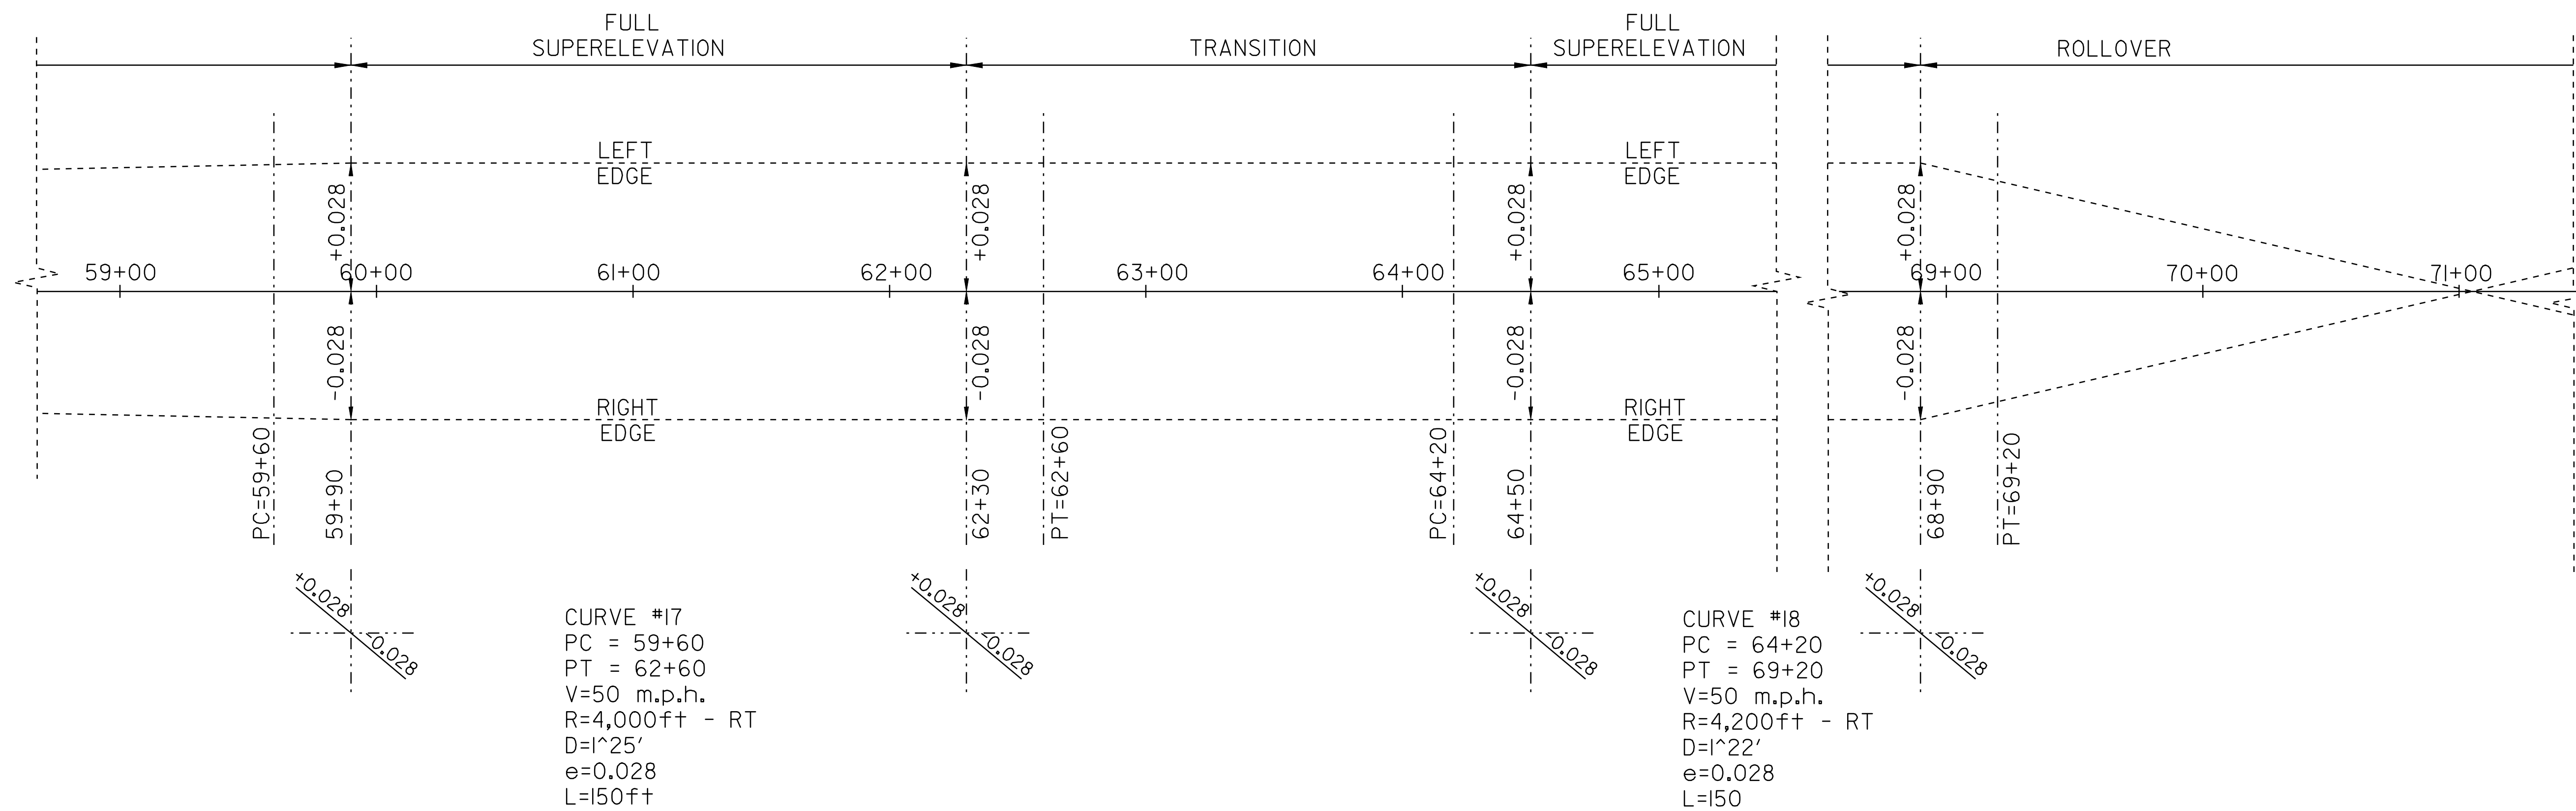




**SUPERELEVATION
 BANKING DIAGRAM
 SHEET #6**

DESIGNED BY	BCE/PJM	DATE	6-07
DRAWN BY	C.E.A., INC.	DATE	6-07
DESIGN FILE NO.	p06cl62.dgn		
PRF FILE	p06cl62sbd06.1	DATE PLOTTED	03-NOV-2009 10
PROJ. NAME	BELVIDERE - MONTGOMERY		
PROJ. NO.	STP 2619(1)S		
SHEET	23	OF	33 SHEETS

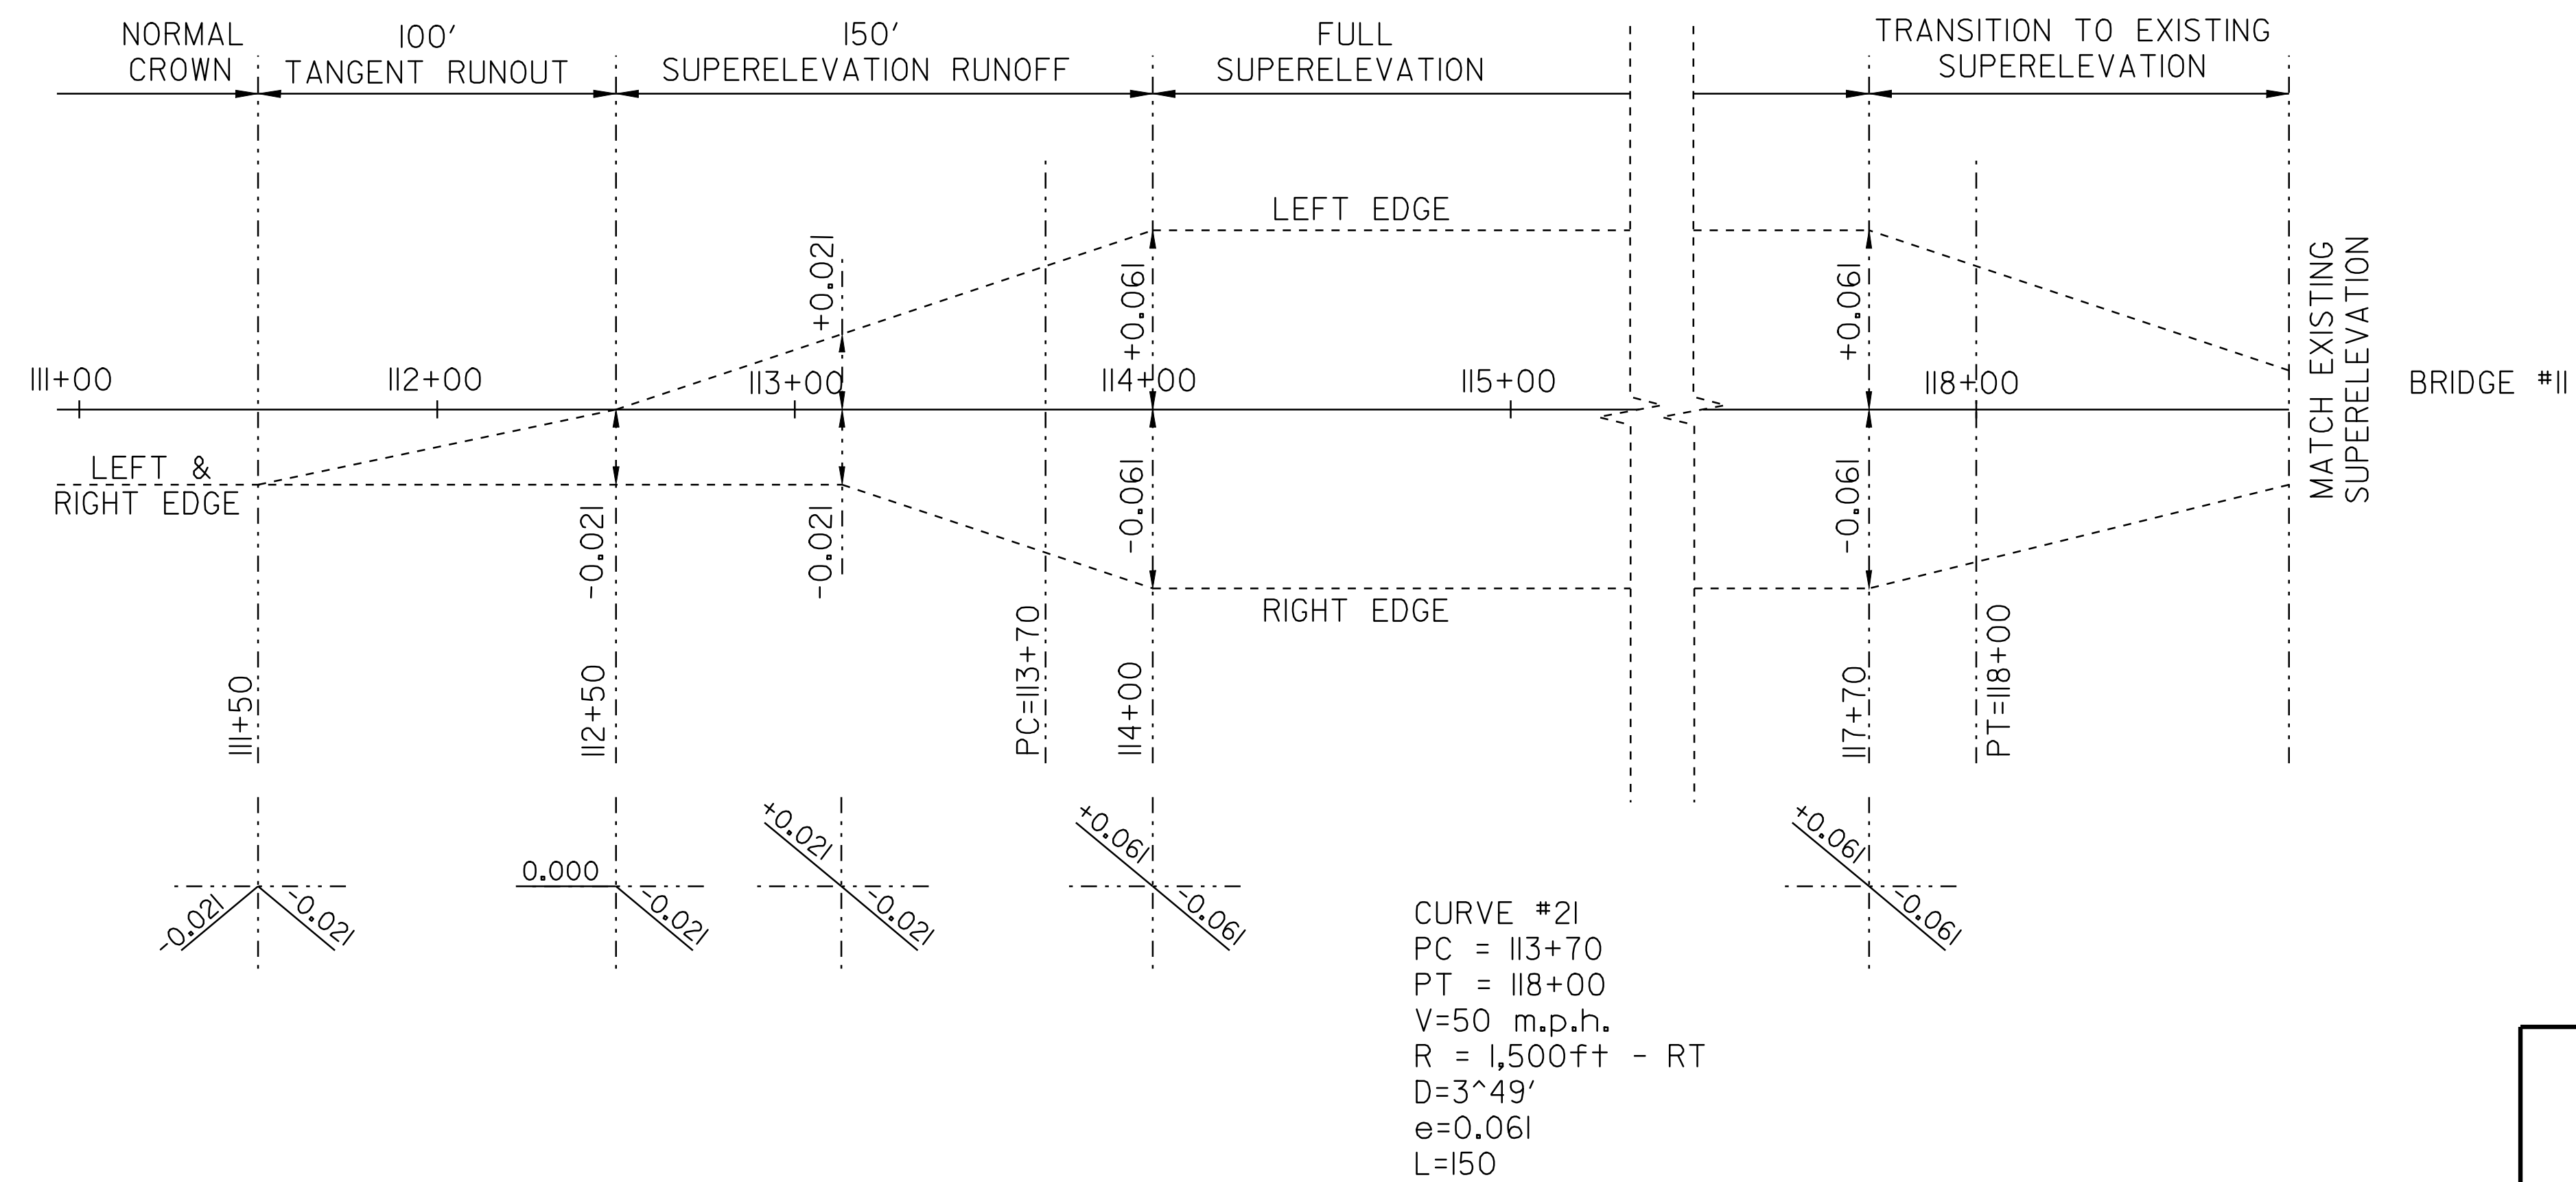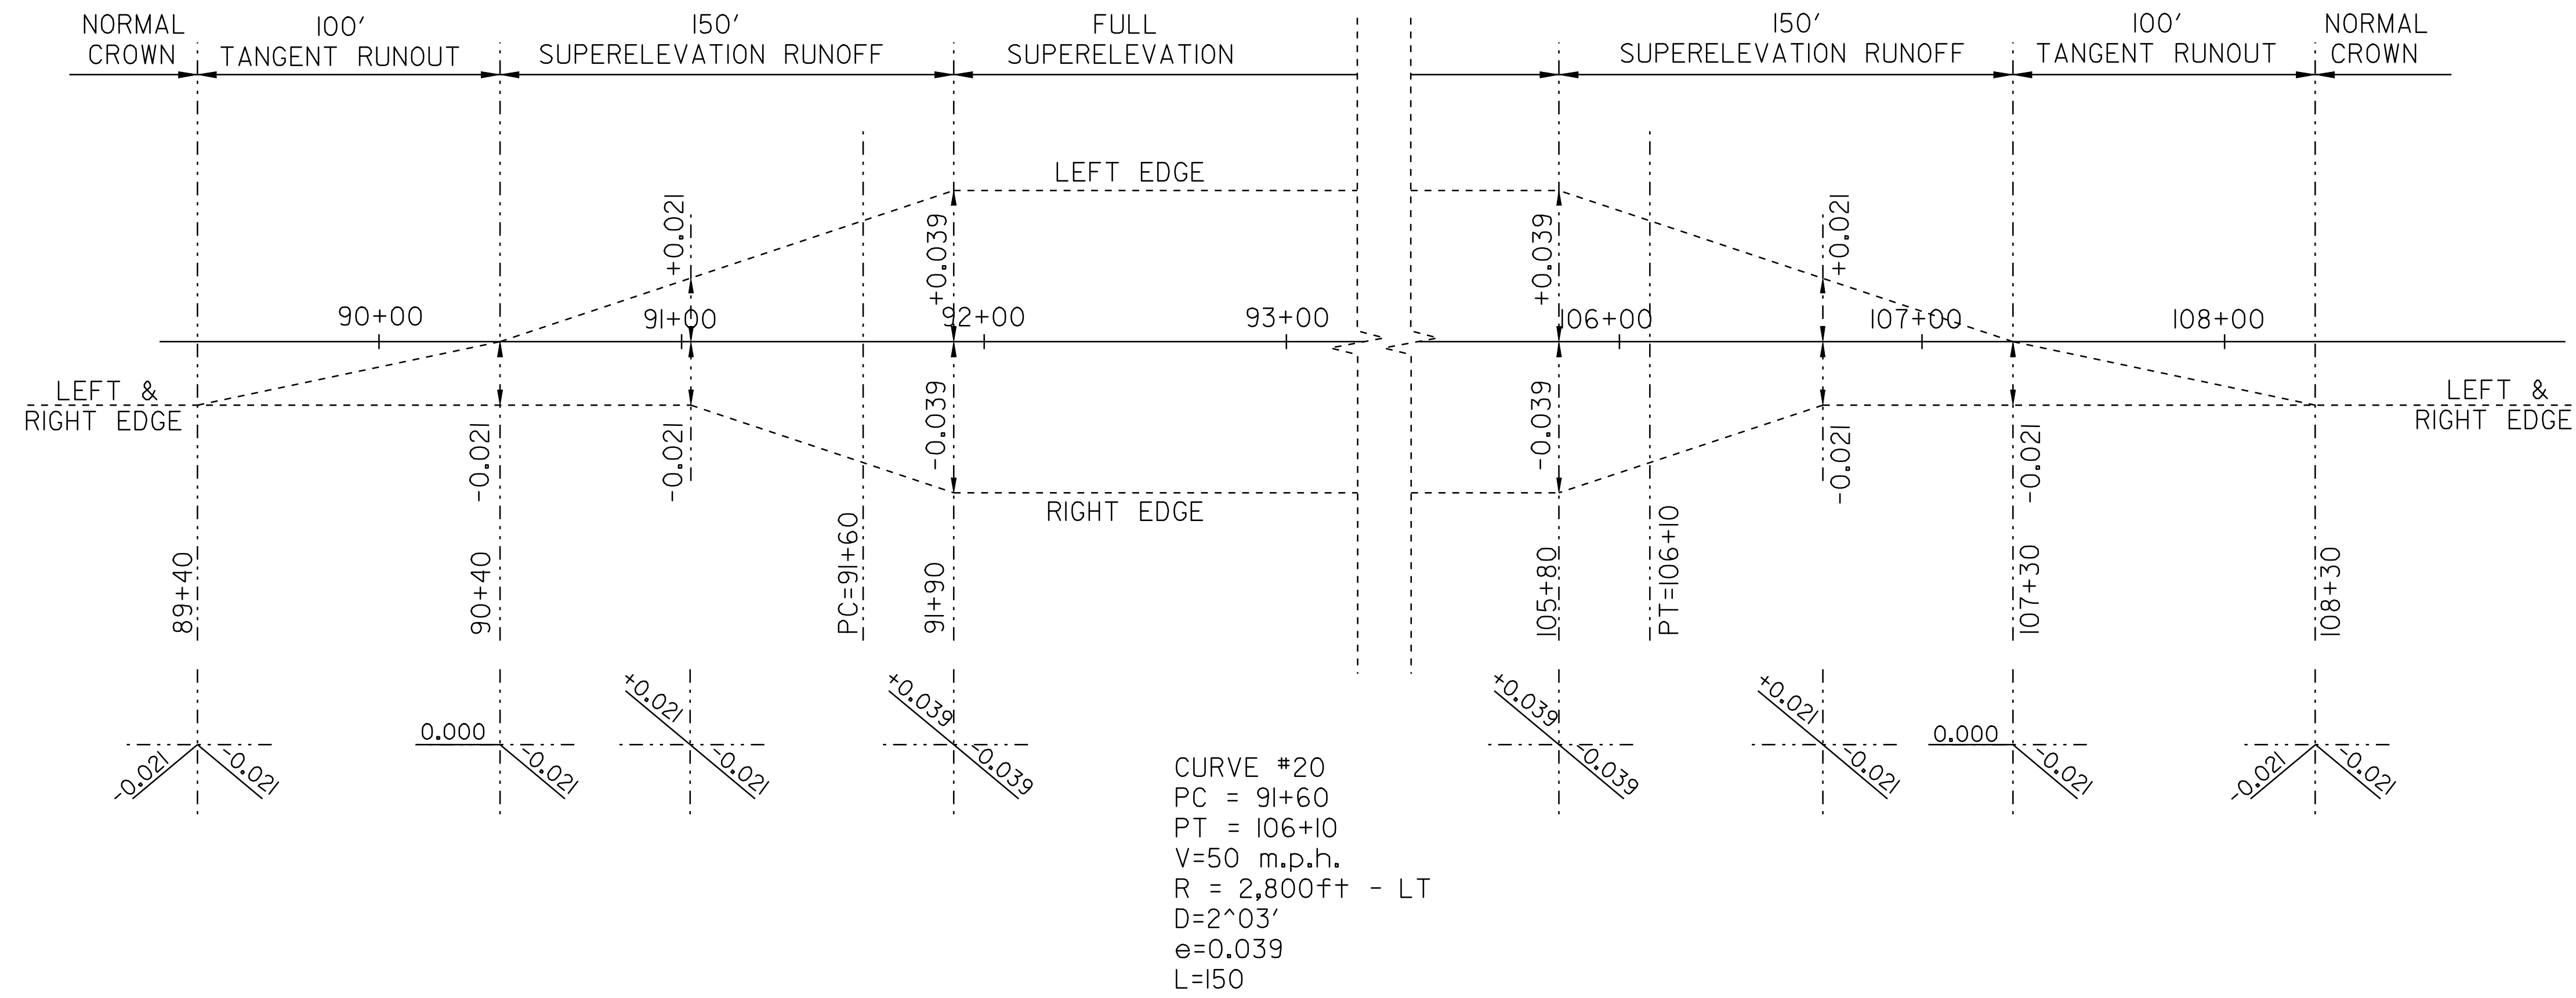



SUPERELEVATION BANKING DIAGRAM SHEET #7

DESIGNED BY	BCE/PJM	DATE	6-07
DRAWN BY	C.E.A., INC.	DATE	6-07
DESIGN FILE NO.	p06cl62.dgn		
PRF FILE	p06cl62sbd07.1	DATE PLOTTED	03-NOV-2009 10
PROJ. NAME	BELVIDERE - MONTGOMERY		
PROJ. NO.	STP 2619(1)S		
SHEET	24	OF	33 SHEETS

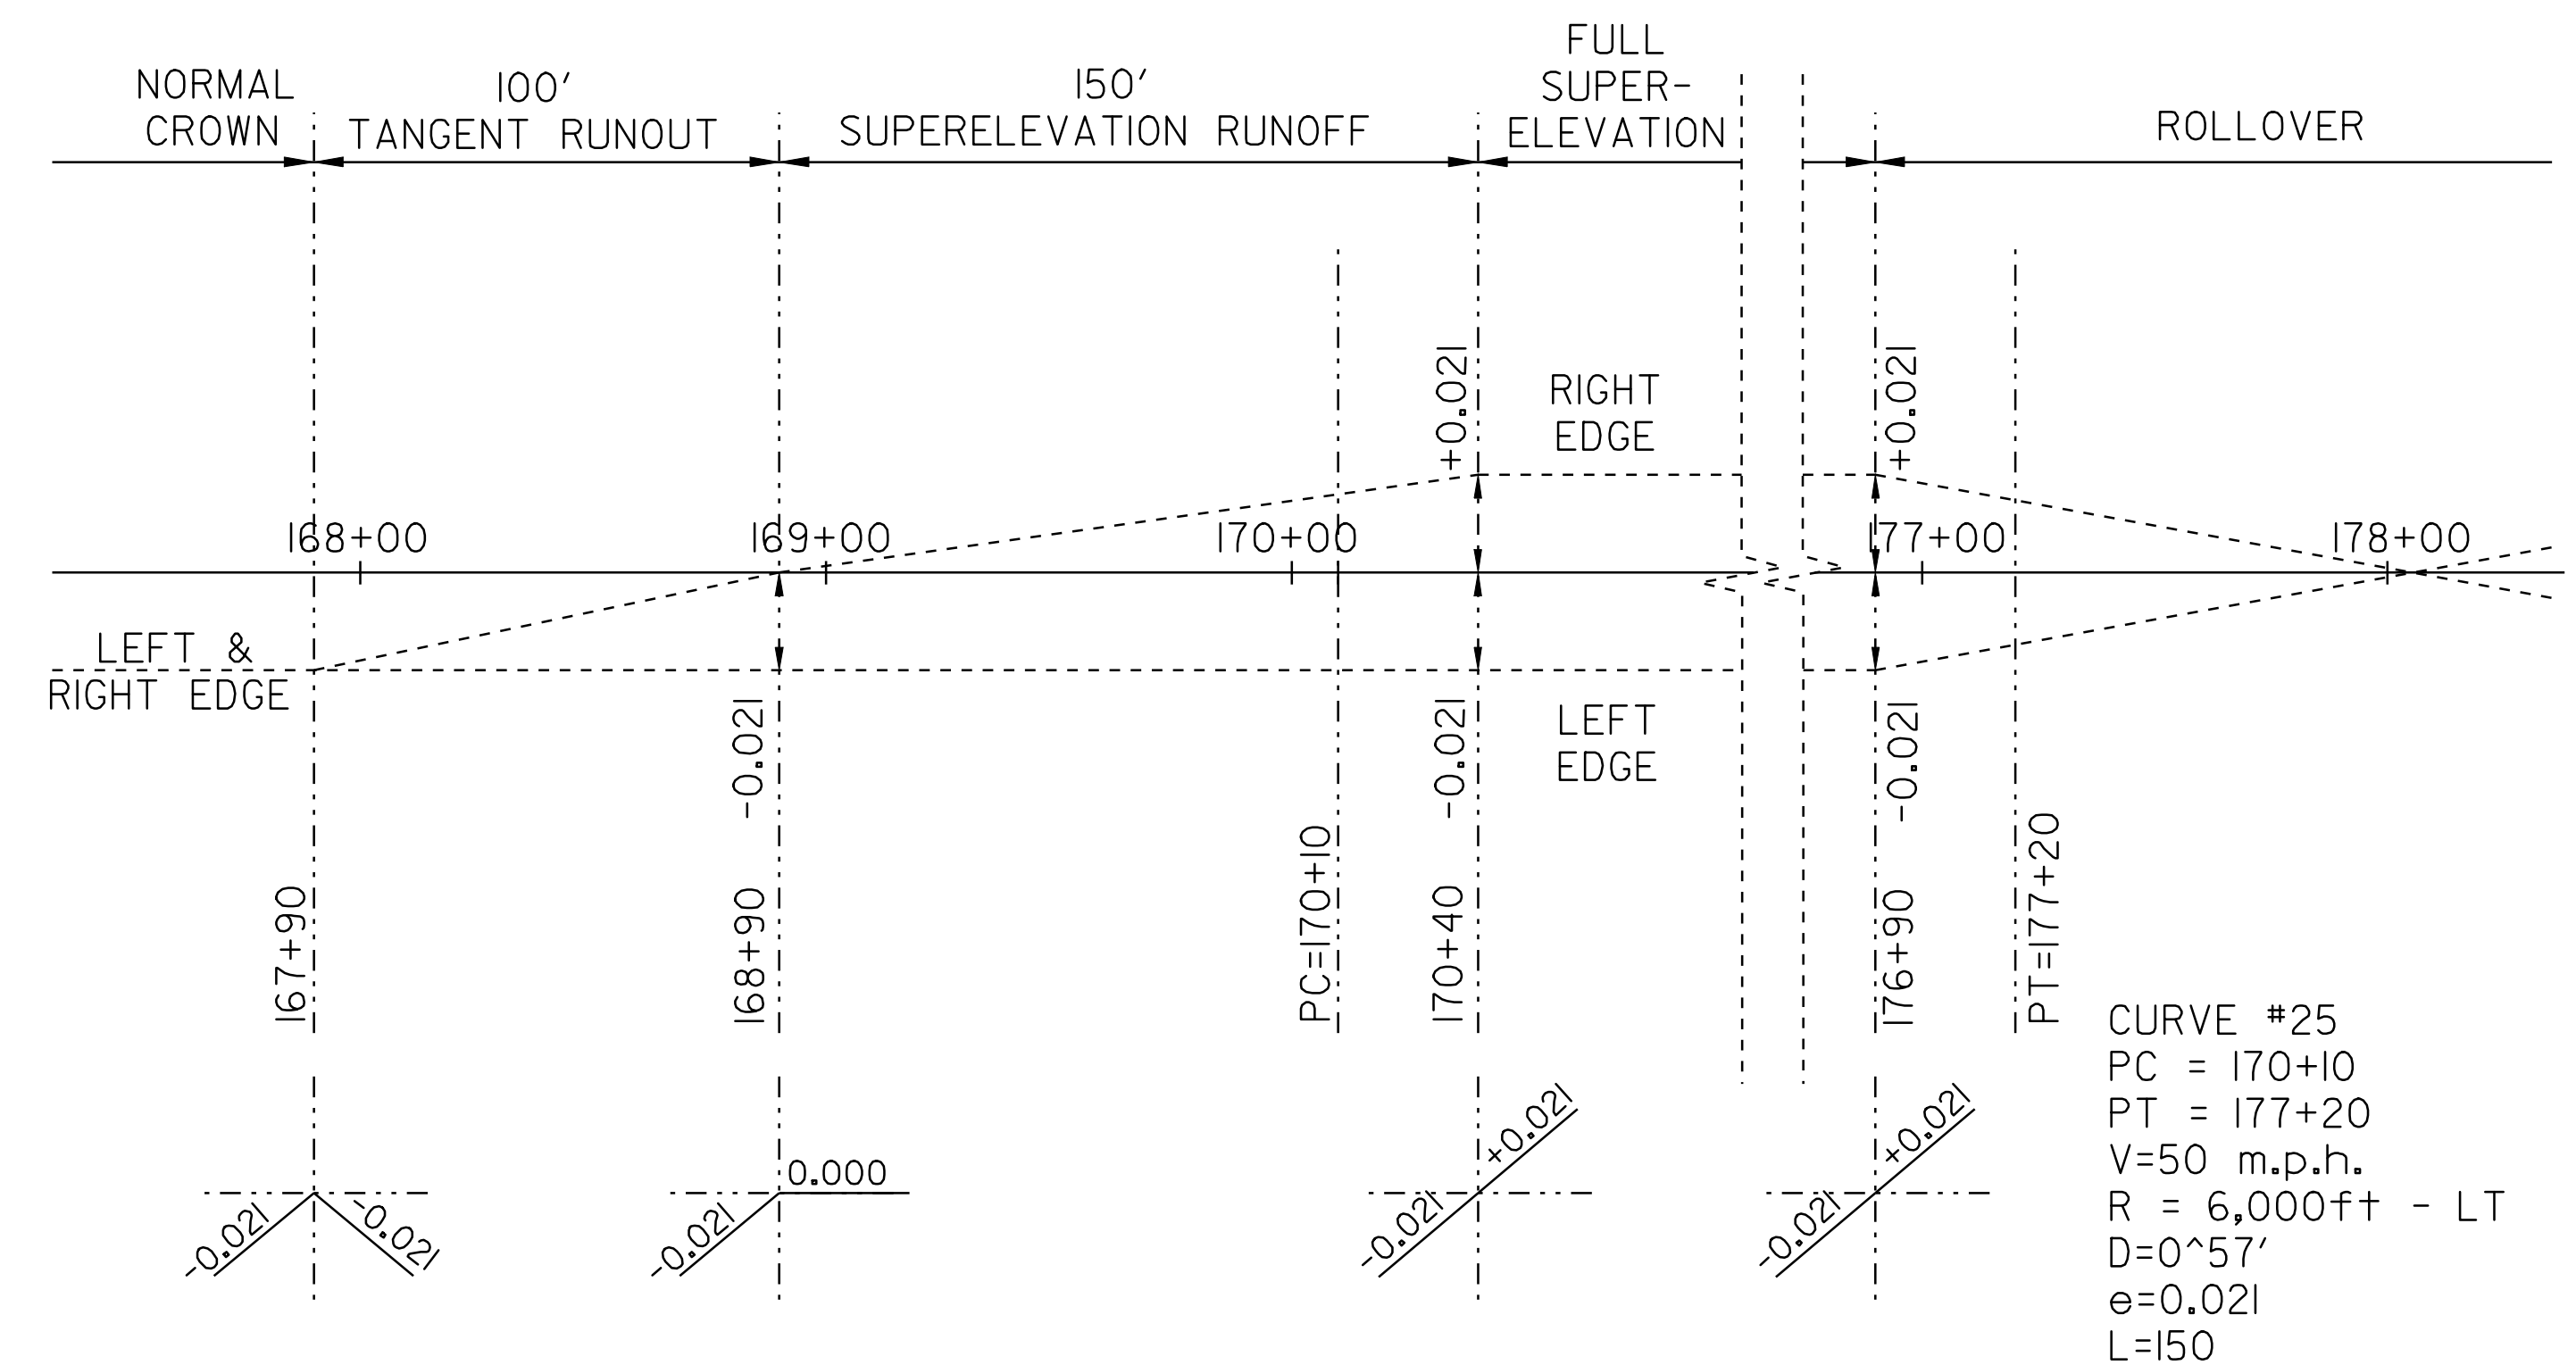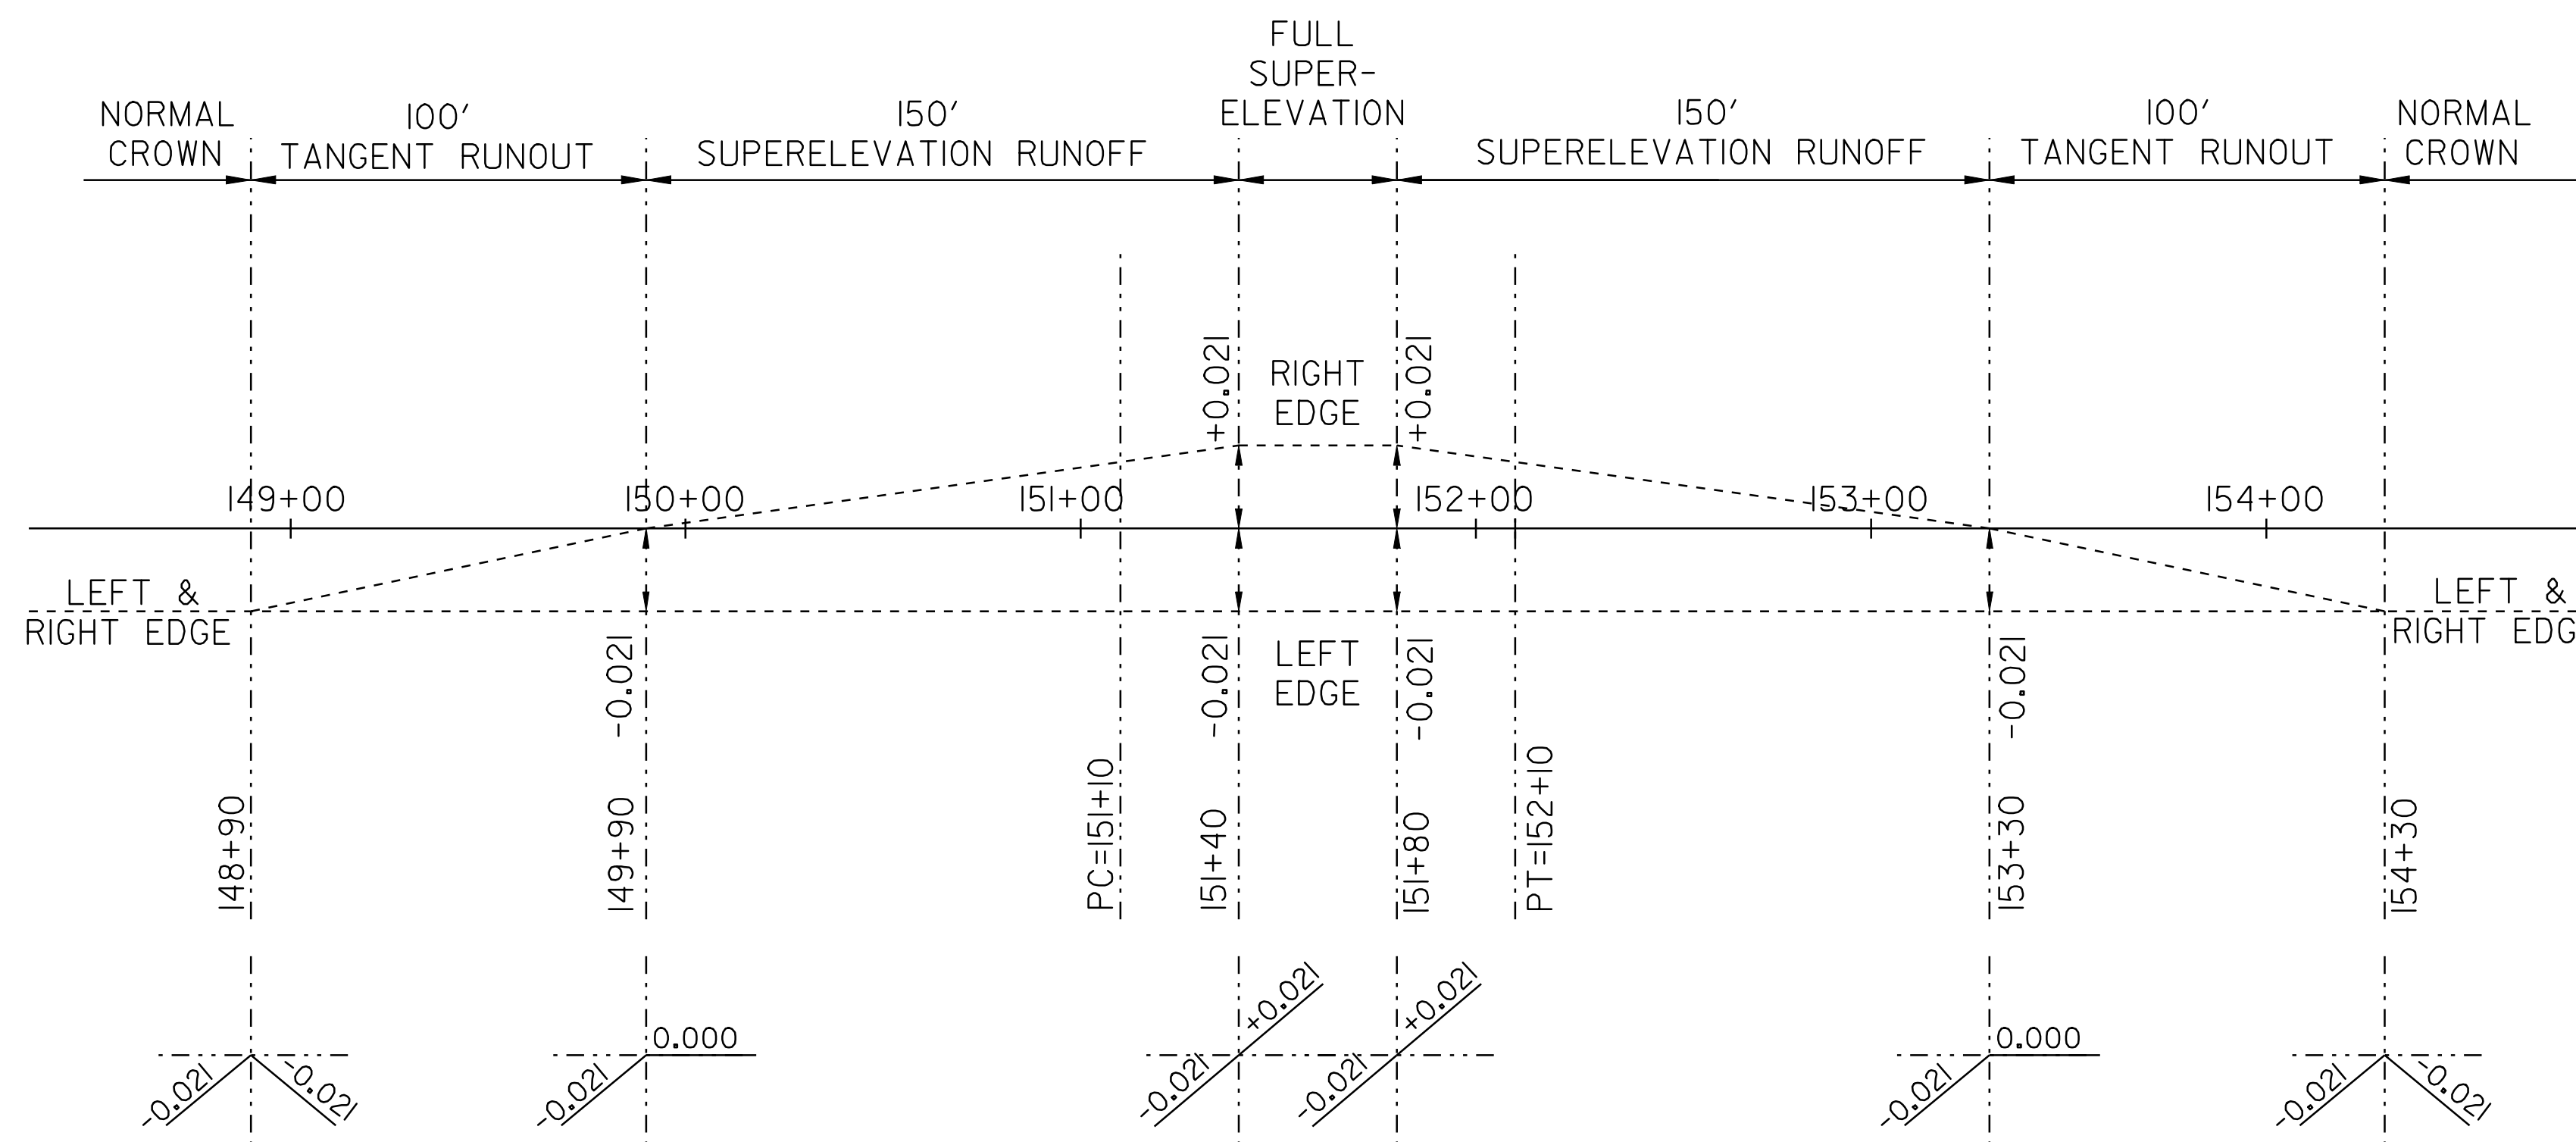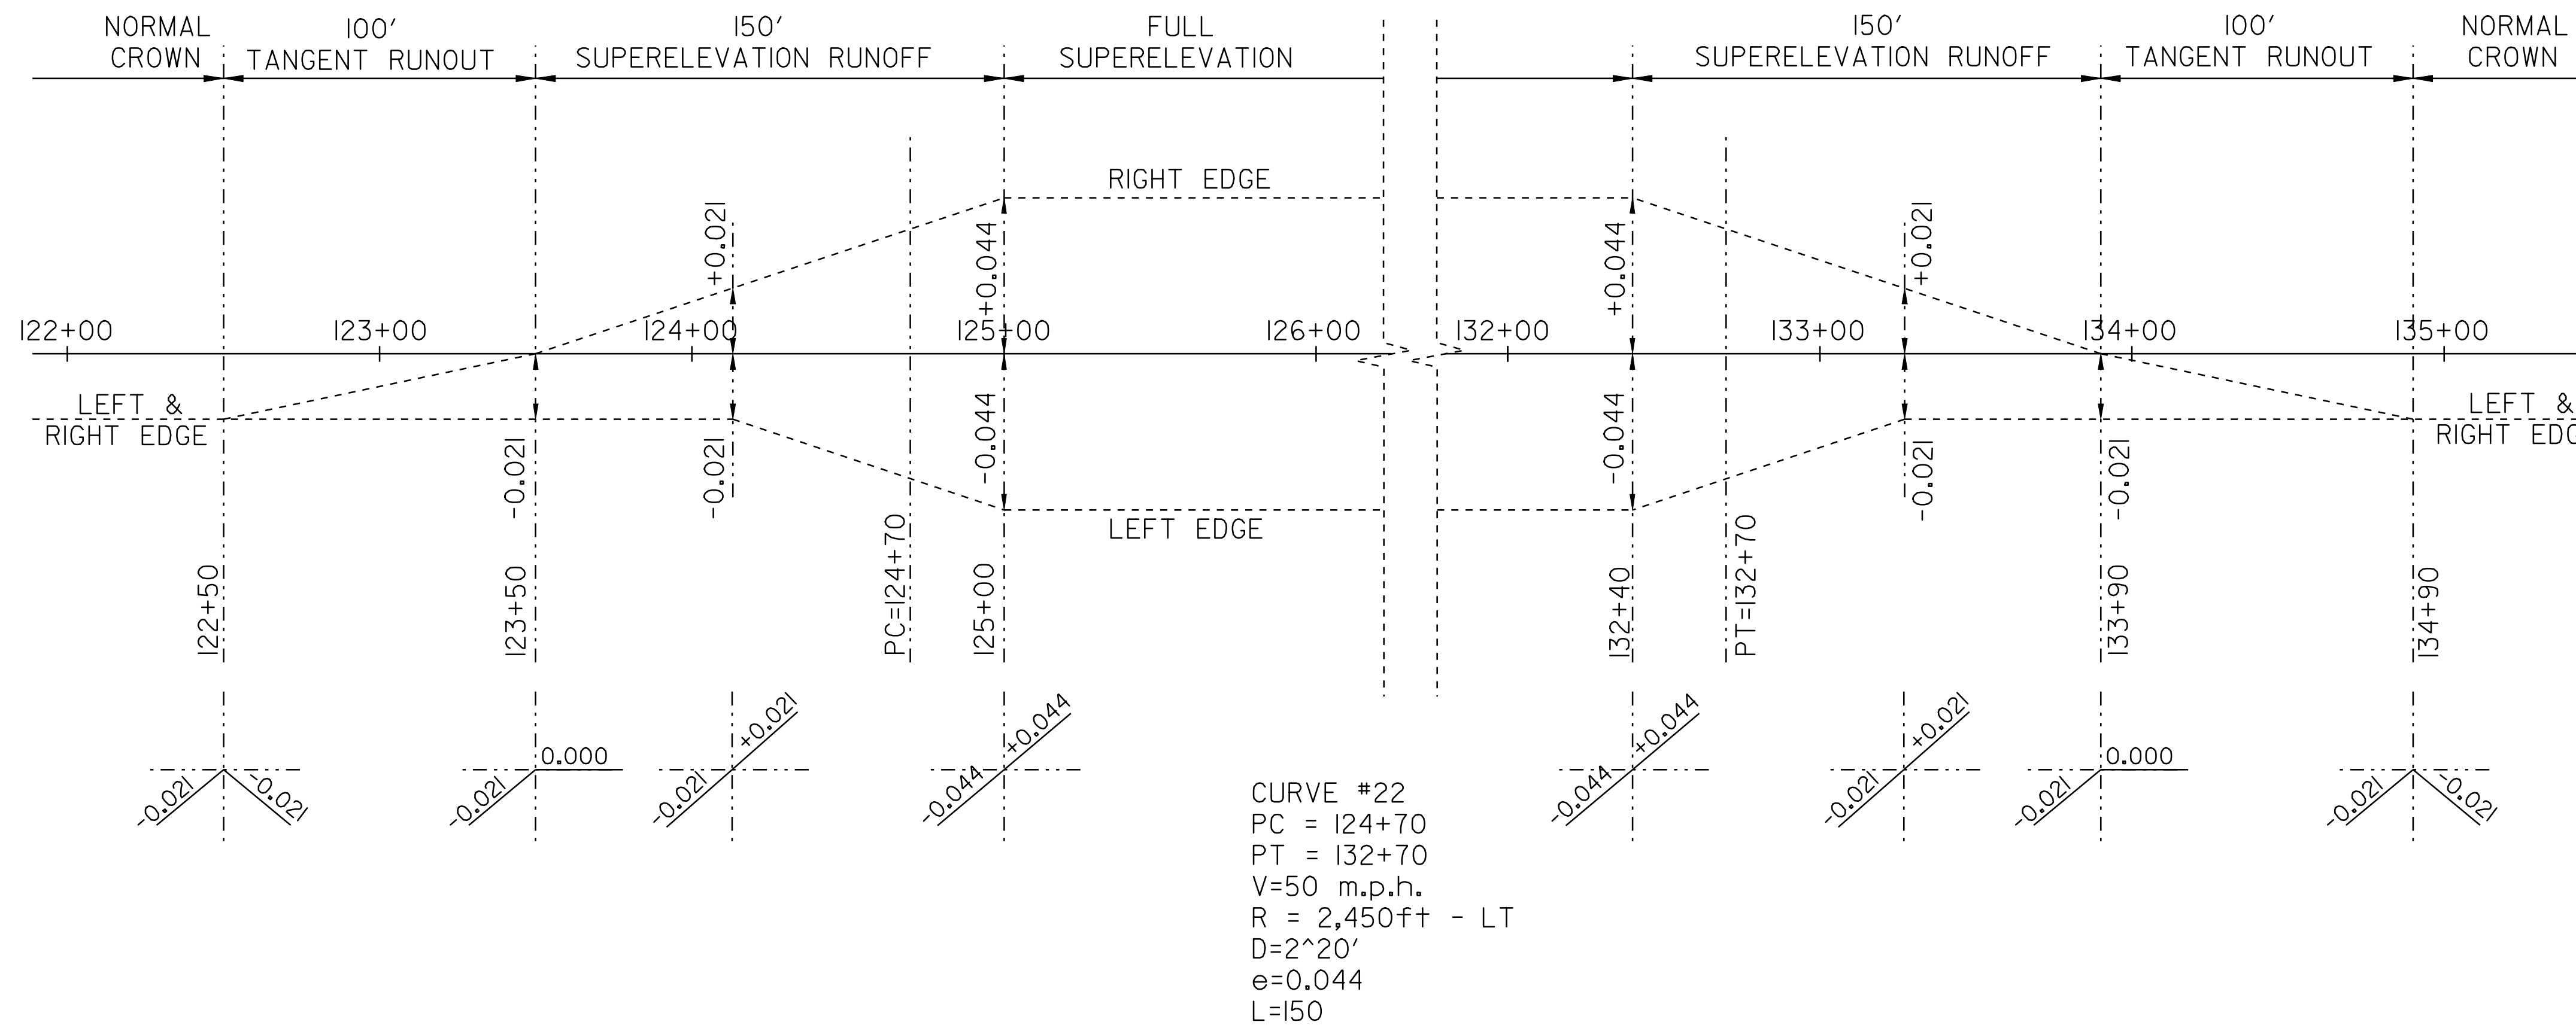



SUPERELEVATION BANKING DIAGRAM SHEET #8

DESIGNED BY BCE/PJM DATE 6-07
 DRAWN BY C.E.A., INC. DATE 6-07
 DESIGN FILE NO. p06cl62.dgn
 PRF FILE p06cl62sbd08.1 DATE PLOTTED 03-NOV-2009 10
 PROJ. NAME **BELVIDERE - MONTGOMERY**
 PROJ. NO. **STP 2619(1)S**
 SHEET **25** OF **33** SHEETS

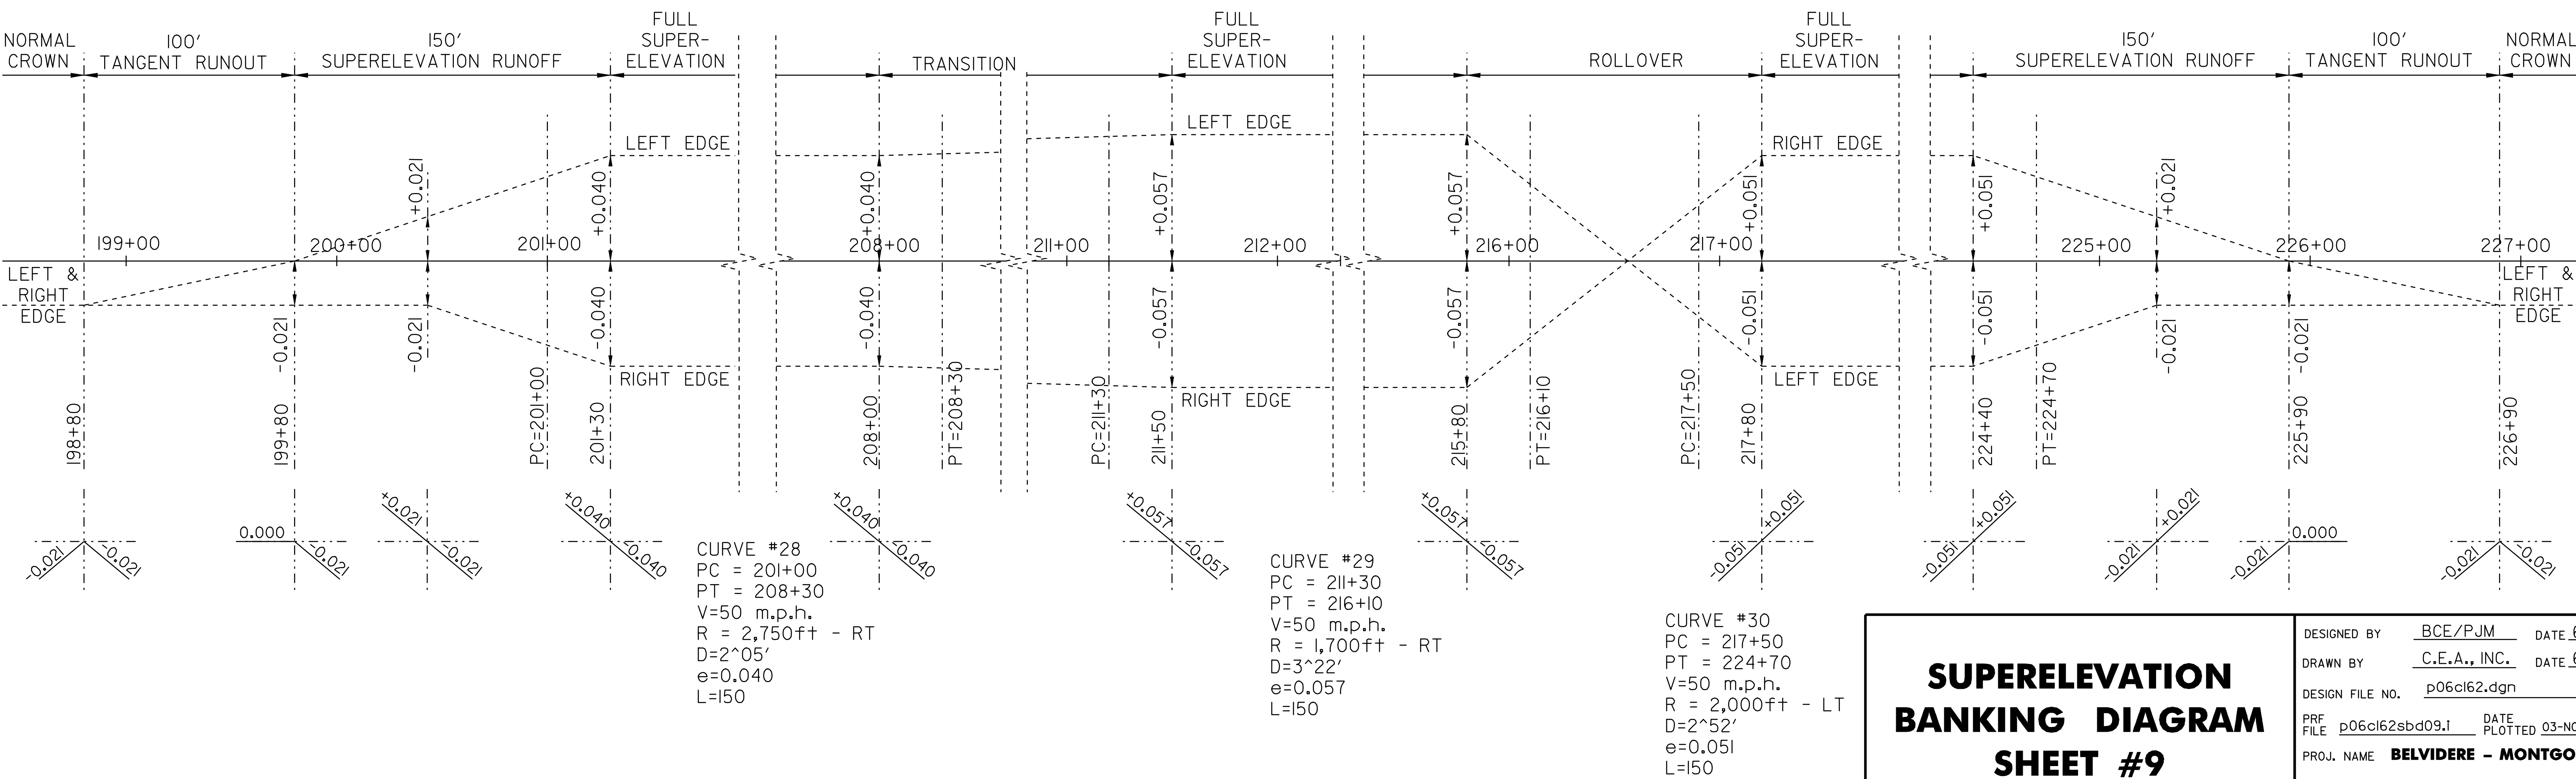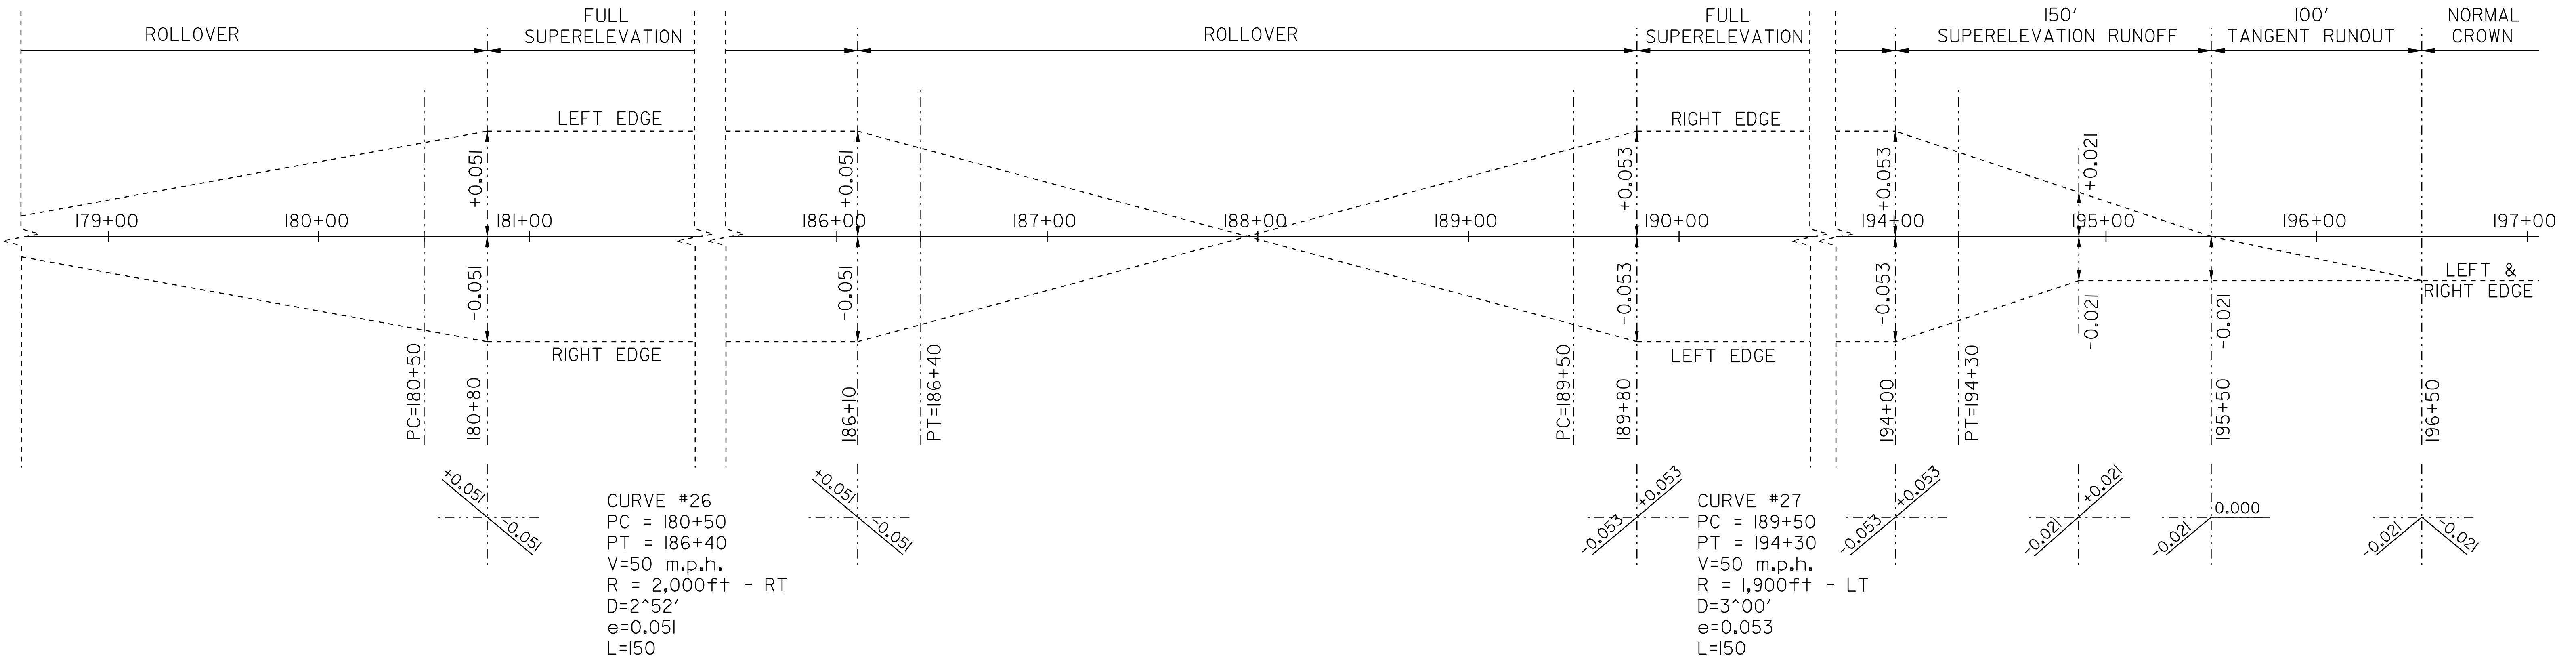



SUPERELEVATION BANKING DIAGRAM SHEET #9

DESIGNED BY BCE/PJM DATE 6-07
 DRAWN BY C.E.A., INC. DATE 6-07
 DESIGN FILE NO. p06cl62.dgn
 PRF FILE p06cl62sbd09.1 DATE PLOTTED 03-NOV-2009 10
 PROJ. NAME **BELVIDERE - MONTGOMERY**
 PROJ. NO. **STP 2619(1)S**
 SHEET **26** OF **33** SHEETS

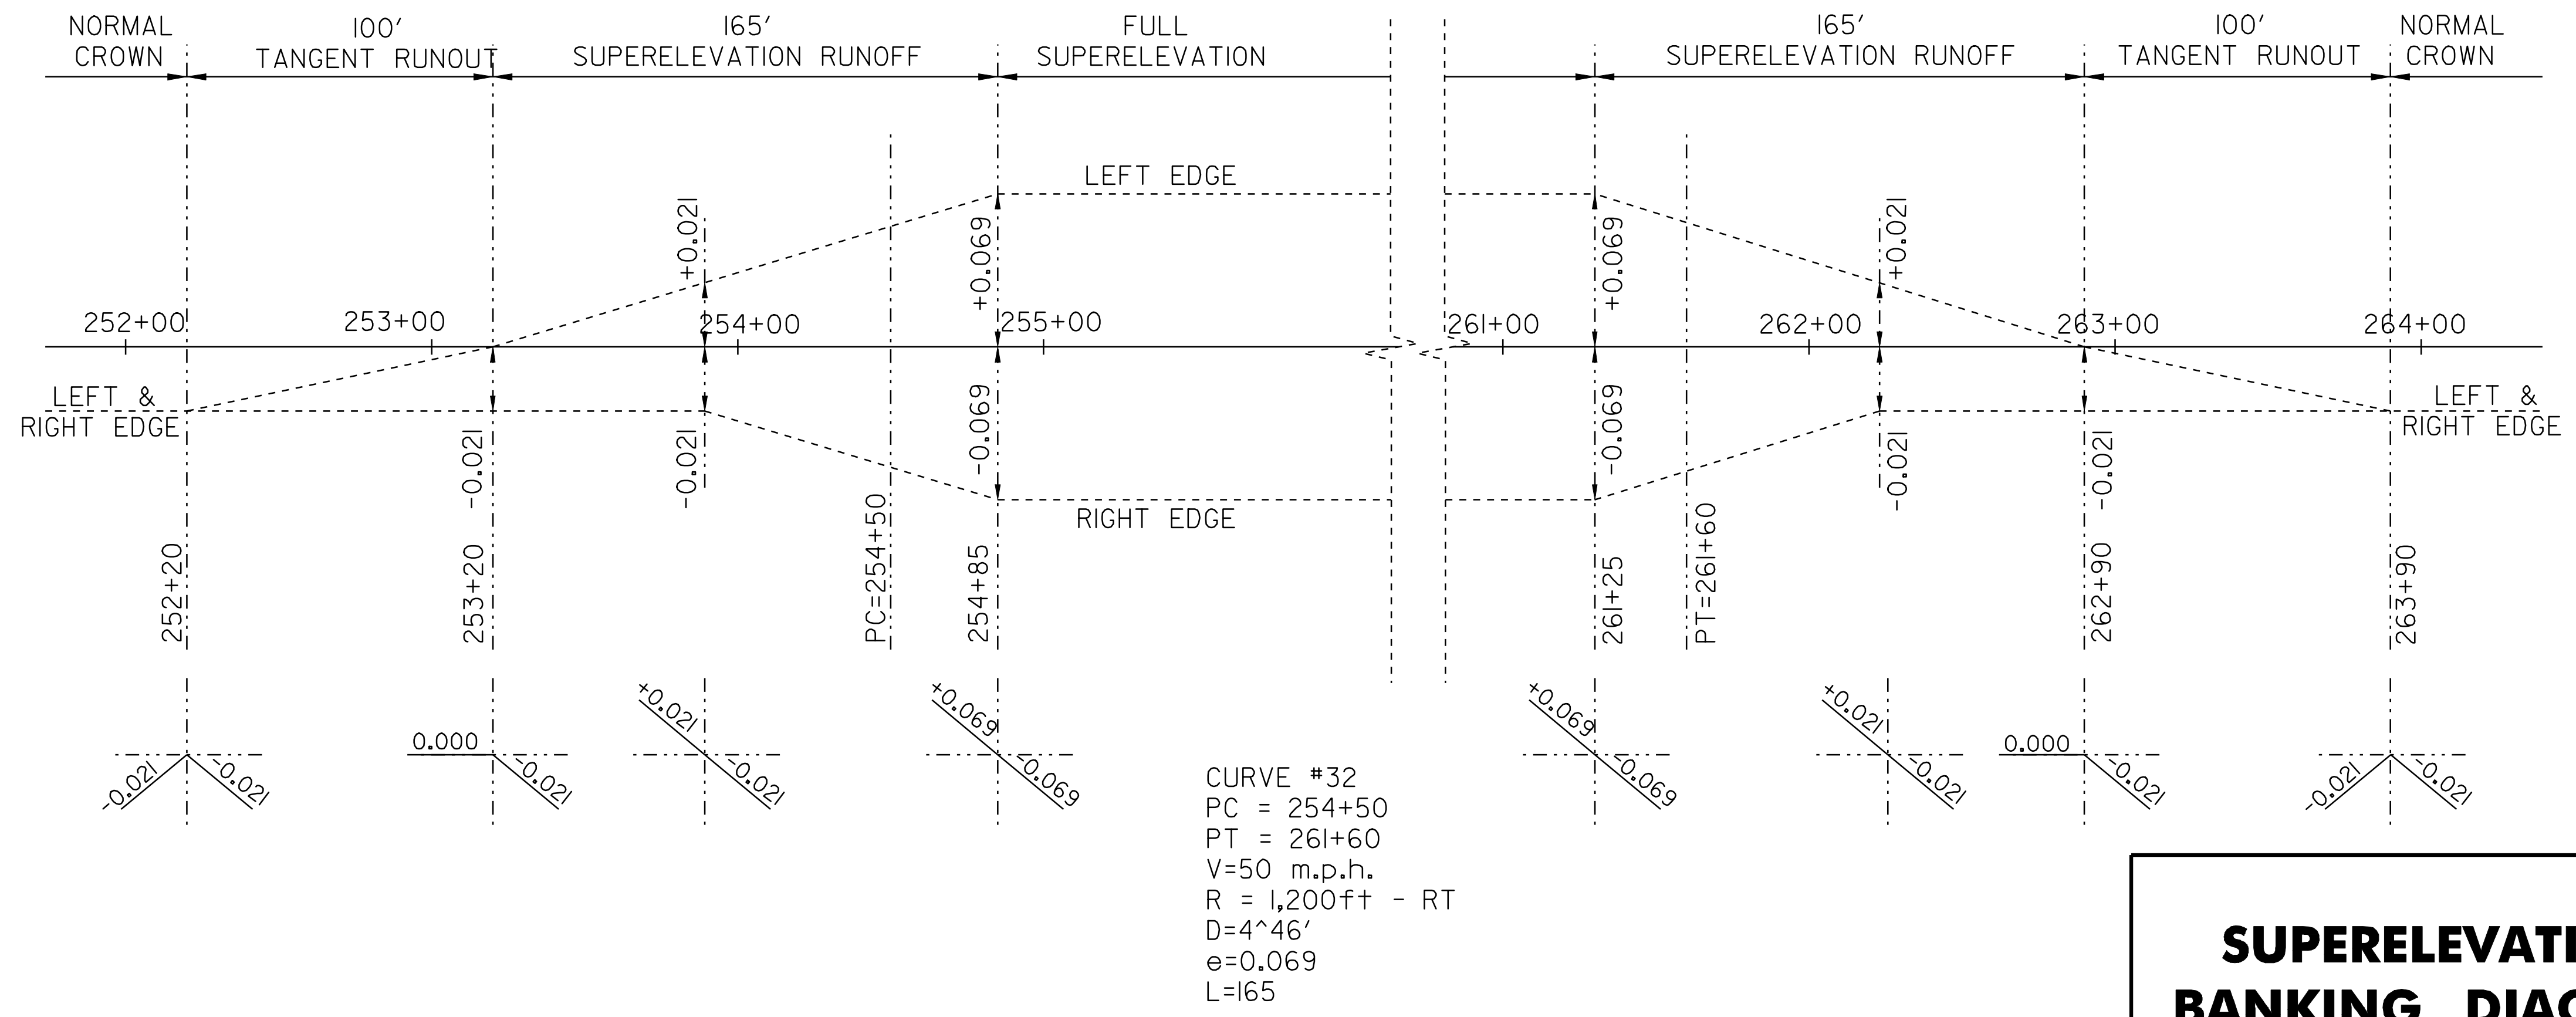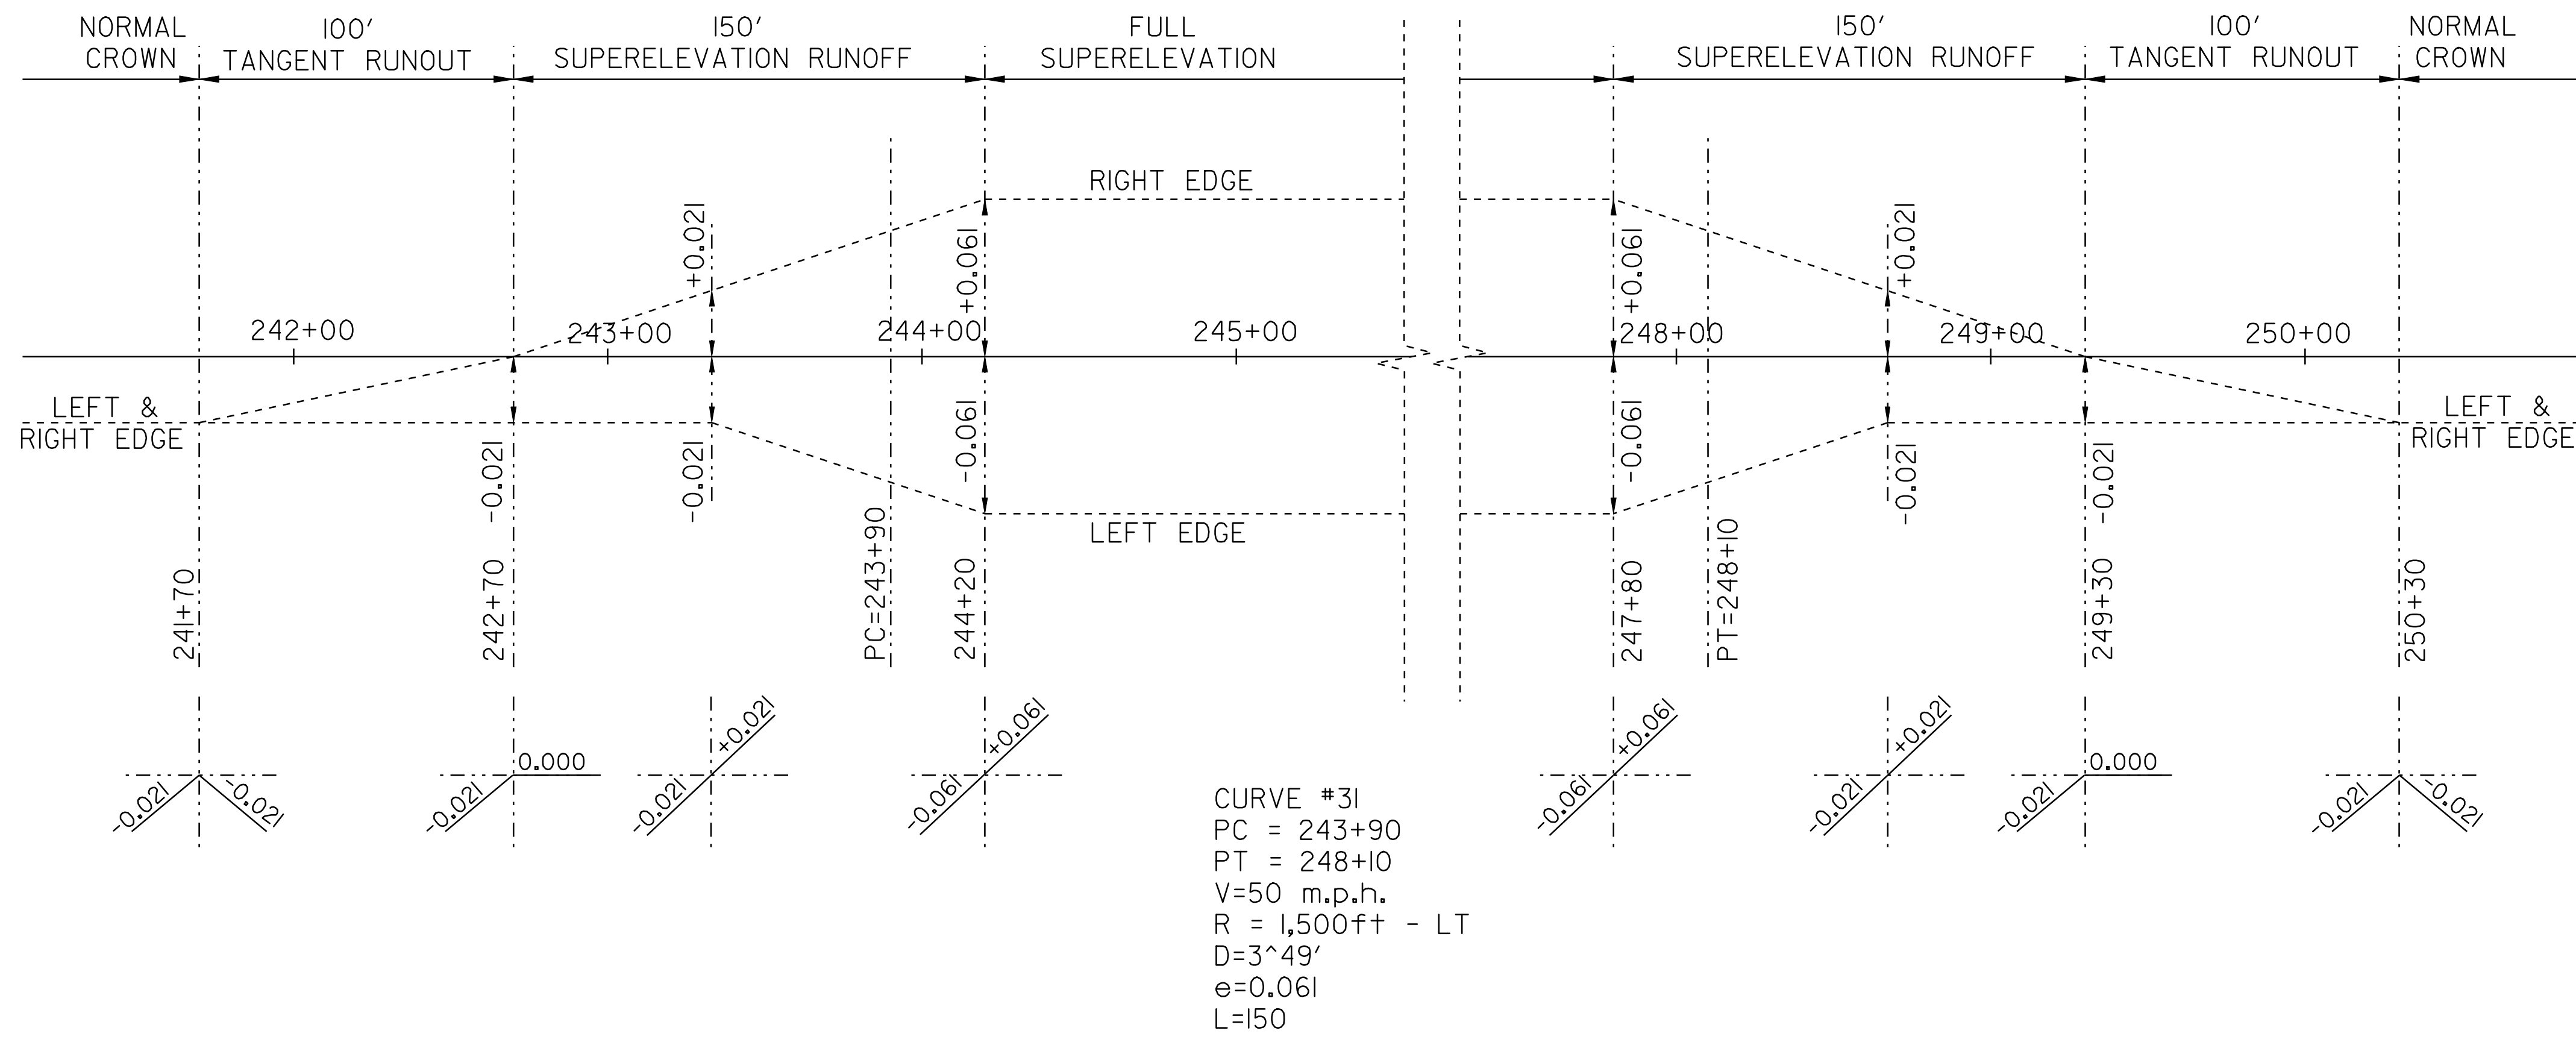

SUPERELEVATION BANKING DIAGRAM SHEET #10

DESIGNED BY	BCE/PJM	DATE	6-07
DRAWN BY	C.E.A., INC.	DATE	6-07
DESIGN FILE NO.	p06cl62.dgn		
PRF FILE	p06cl62sbd10.1	DATE PLOTTED	03-NOV-2009 10
PROJ. NAME	BELVIDERE - MONTGOMERY		
PROJ. NO.	STP 2619(1)S		
SHEET	27	OF	33 SHEETS

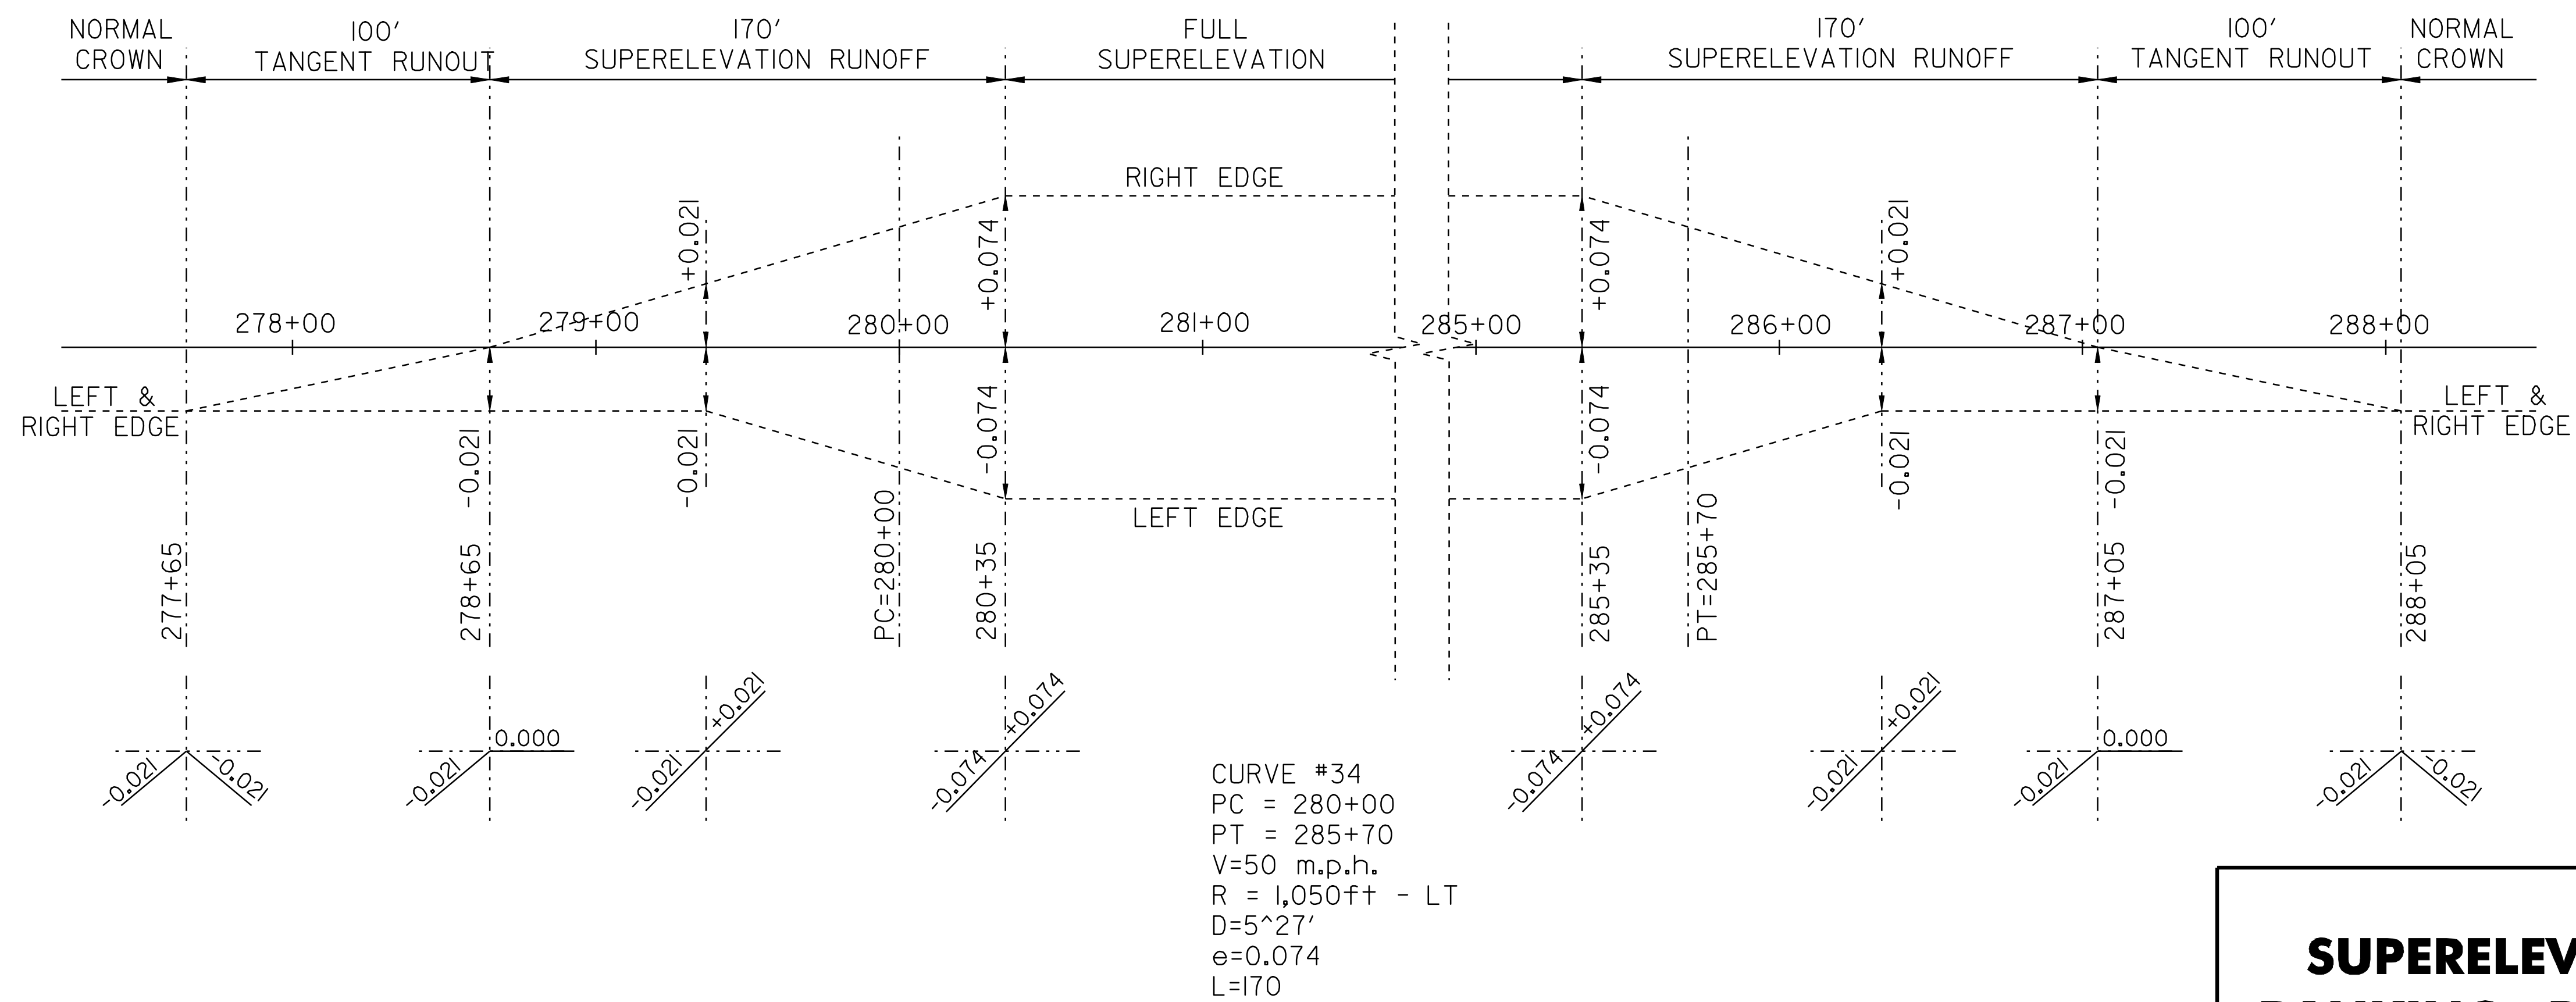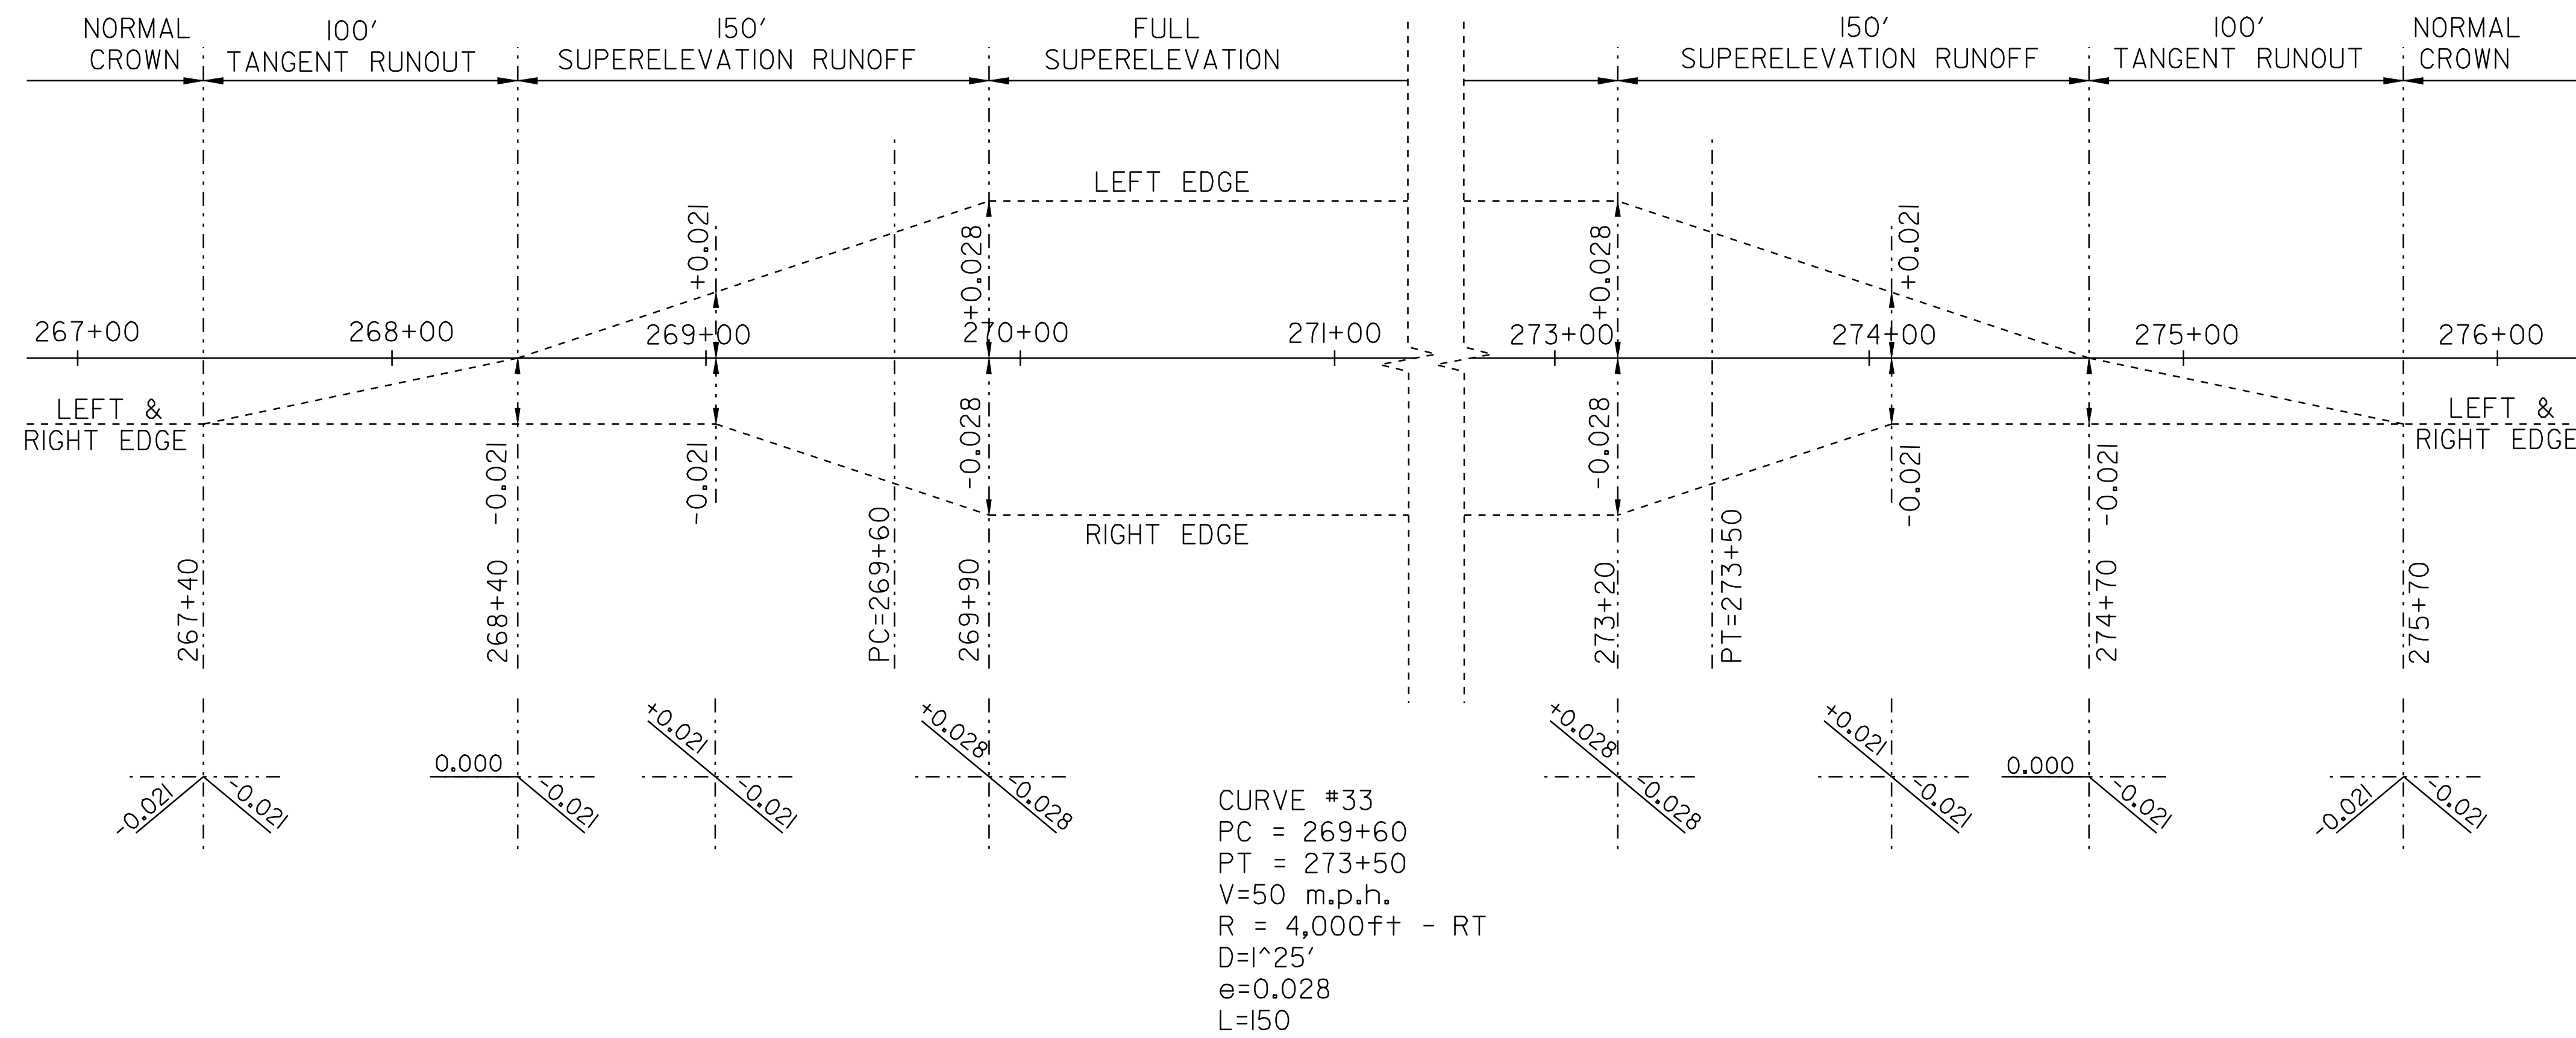

SUPERELEVATION BANKING DIAGRAM SHEET #11


DESIGNED BY	BCE/PJM	DATE	6-07
DRAWN BY	C.E.A., INC.	DATE	6-07
DESIGN FILE NO.	p06cl62.dgn		
PRF FILE	p06cl62sbdll.i	DATE PLOTTED	03-NOV-2009 10
PROJ. NAME	BELVIDERE - MONTGOMERY		
PROJ. NO.	STP 2619(1)S		
SHEET	28	OF	33 SHEETS

MILE MARKER, STATION, OR SIGN NUMBER	SIGN LEGEND	SIGN DIMENSIONS		NEW & SALVAGED SIGNS				EXIST POST RETAIN	NO. OF POSTS	NEW SIGN POSTS																REMARKS	SIGN DETAIL					
		E	A	WIDTH (in)	HEIGHT (in)	"A"	"B"			SALV SIGN	SALV TIS	FLANGED CHANNEL			SQUARE STEEL (in)			TUBULAR ALUMINUM (in)			TUBULAR STEEL (in)				W-SHAPE STEEL		DETAIL ON SHEET NUMBER	STD. SHEET NUMBER				
												lb/ft	2.0	3.0	1.75	2.0	2.5	3.0	4.0	4.0 MOD	FOUNDATION	3.0	3.5	4.0	5.0				FTG. SIZE		WEIGHT	POST SIZE
																													1.2	2.0		


OPTION ITEMS																															
MONTGOMERY																															
125+40 RT				36	12	3.00																									
148+95 LT		1	30	30	6.25				1			16		X																BACK TO BACK	E-143 E-138
149+25 LT		1	24	30	5.0				1			14		X																REFER TO STANDARD E-121 FOR PLACEMENT.	E-141
152+00 RT		1	6	10	0.42																									MOUNT NEW MILE MARKER BACK TO BACK WITH EXISTING STOP SIGN	
155+45 LT		1	6	10	0.42																									MOUNT NEW MILE MARKER BACK TO BACK WITH EXISTING STOP SIGN	E-138
210+40 LT		1	6	10	0.42																									MOUNT NEW MILE MARKER BACK TO BACK WITH EXISTING STOP SIGN	E-138
214+00 LT		1	30	30	6.25				1			14		X																BACK TO BACK	E-143 E-138
214+25 LT				36	12	3.00																								SIGN TO BE MOUNTED USING POST TOP MOUNTING BRACKET. PERPENDICULAR TO LEGAL LOAD SIGN.	
214+25 LT		1	24	30	5.0				1			14		X																REFER TO STANDARD E-121 FOR PLACEMENT.	E-141
230+37 LT		1	30	30	6.25				1			14		X																BACK TO BACK	E-143 E-138
230+67 LT		1	24	30	5.0				1			14		X																REFER TO STANDARD E-121 FOR PLACEMENT.	E-141

FINAL POST LENGTHS ARE TO BE DETERMINED IN THE FIELD. POST SIZES ARE COMPUTED BASED ON INFORMATION FURNISHED ON THE STANDARD SHEETS AND THE ROADWAY, TRAFFIC & SAFETY DIVISION'S SIGN POST DESIGN GUIDELINE.	SF	SF	EA.	SF		LF	LF	LF	LF	LF	LF	EA.	LB	LB	LB	EA.	LB	LB	LB	EA.	EA.	LB									
	PROJECT TOTALS	42	36.27				86	90																							


TRAFFIC SIGN SUMMARY SHEET	PROJECT: BELVIDERE - MONTGOMERY	PROJECT NO.: STP 2619(1)S
	DESIGN FILE NAME: p06cl62.dgn	PLOT DATE: 03-NOV-2009 10:55
	IPARM FILE NAME: p06cl62tss.l	SURVEY DATE:
	SURVEYED BY:	DRAWN BY: C.E.A., INC.
	SQUAD LEADER:	SHEET: 29 OF 33

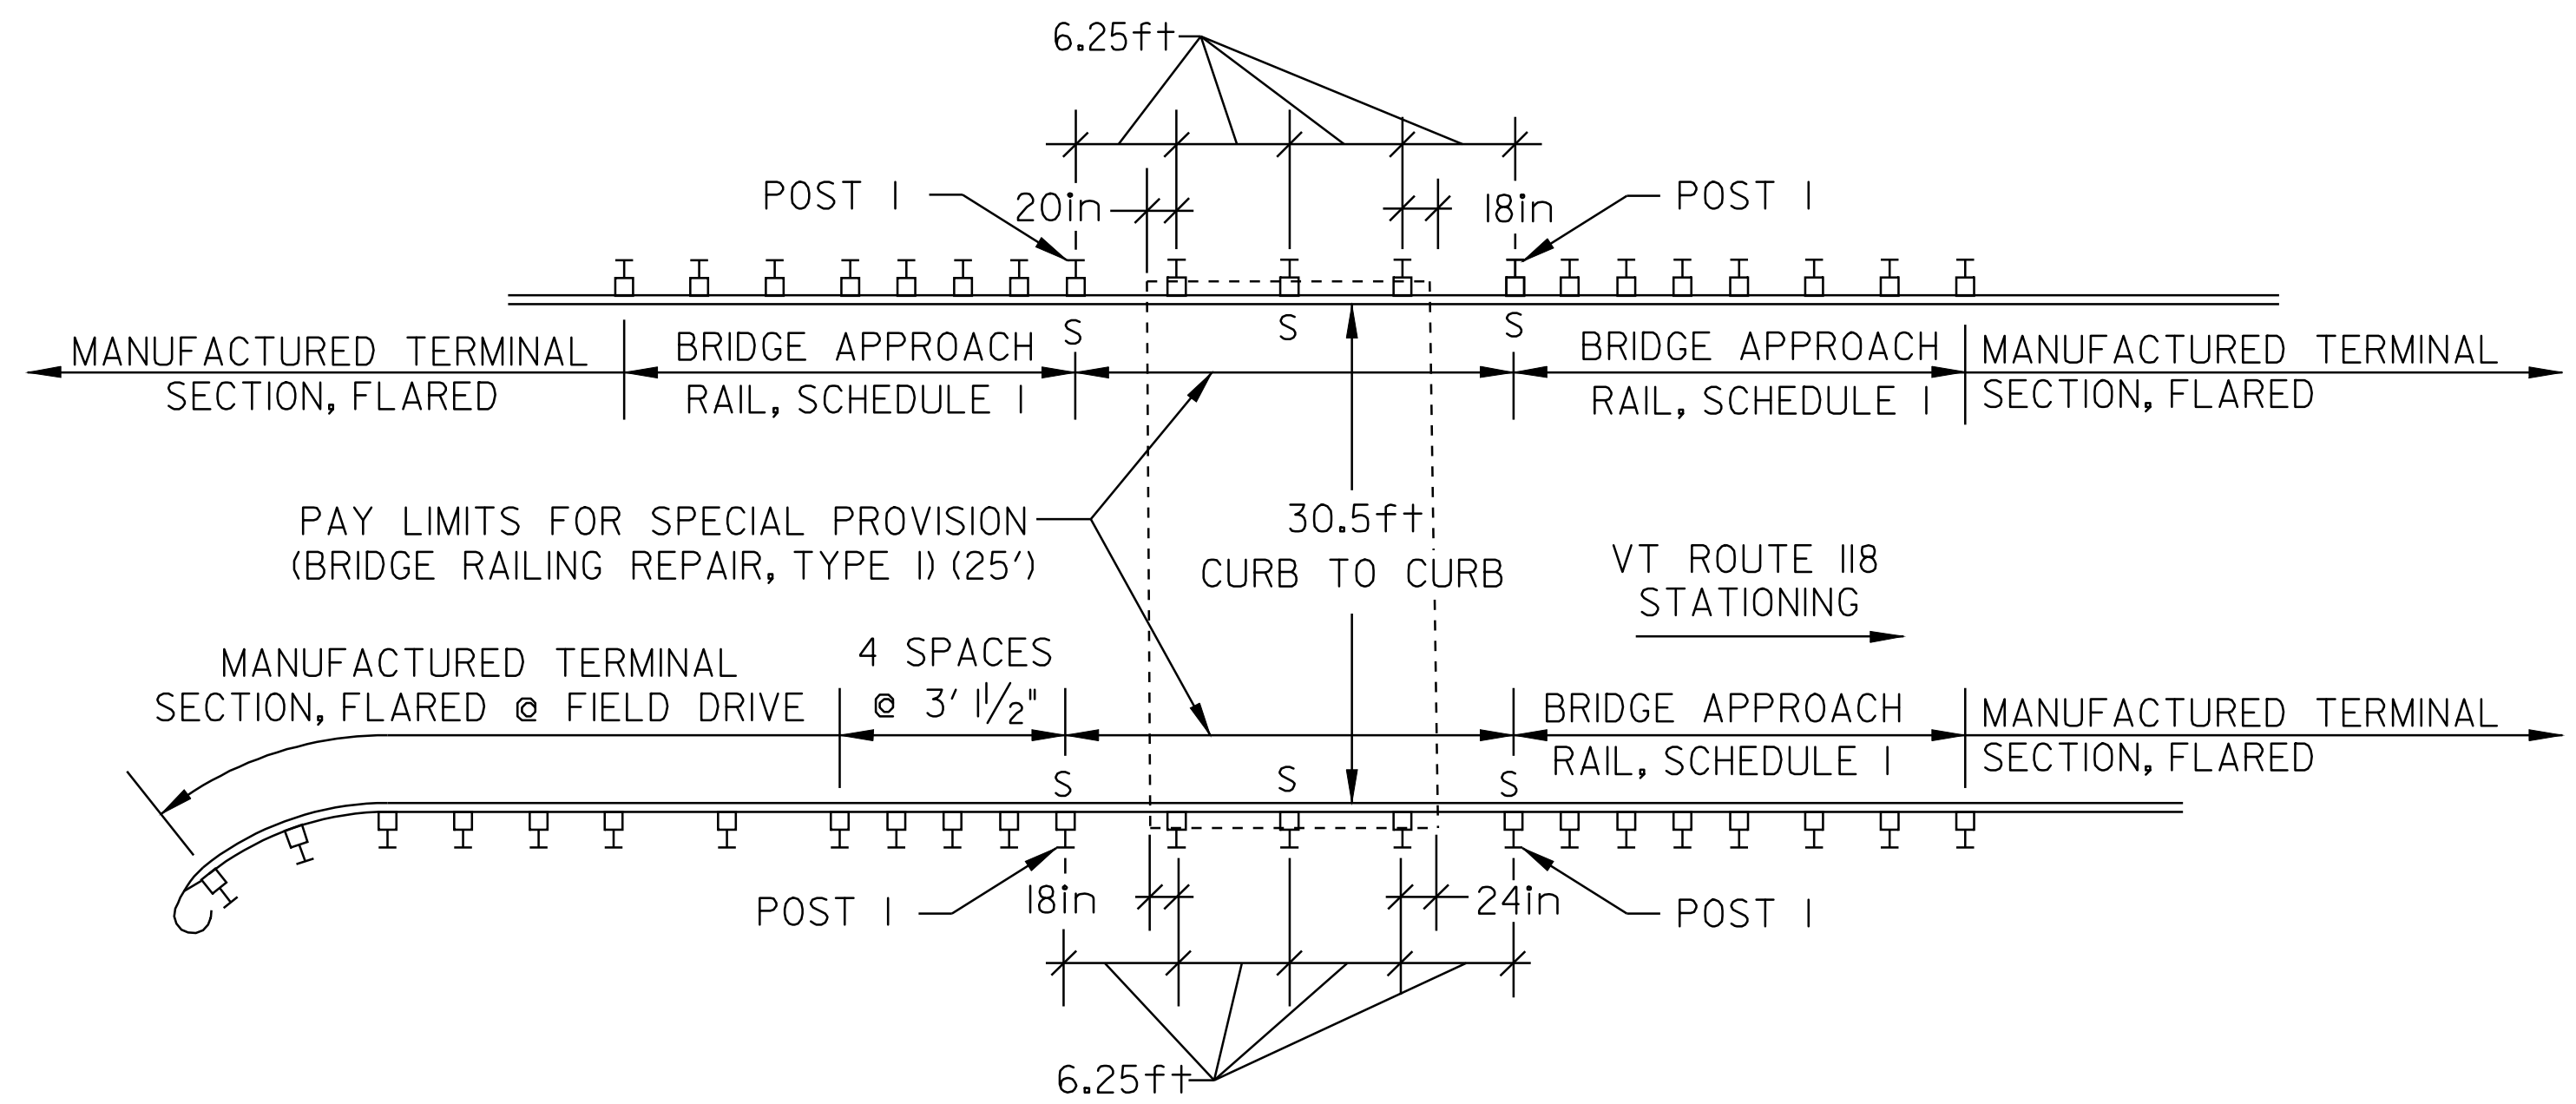

MONTGOMERY – BRIDGE #12
STA 157+15 = MM 2.976
(FIELD MEASURED)

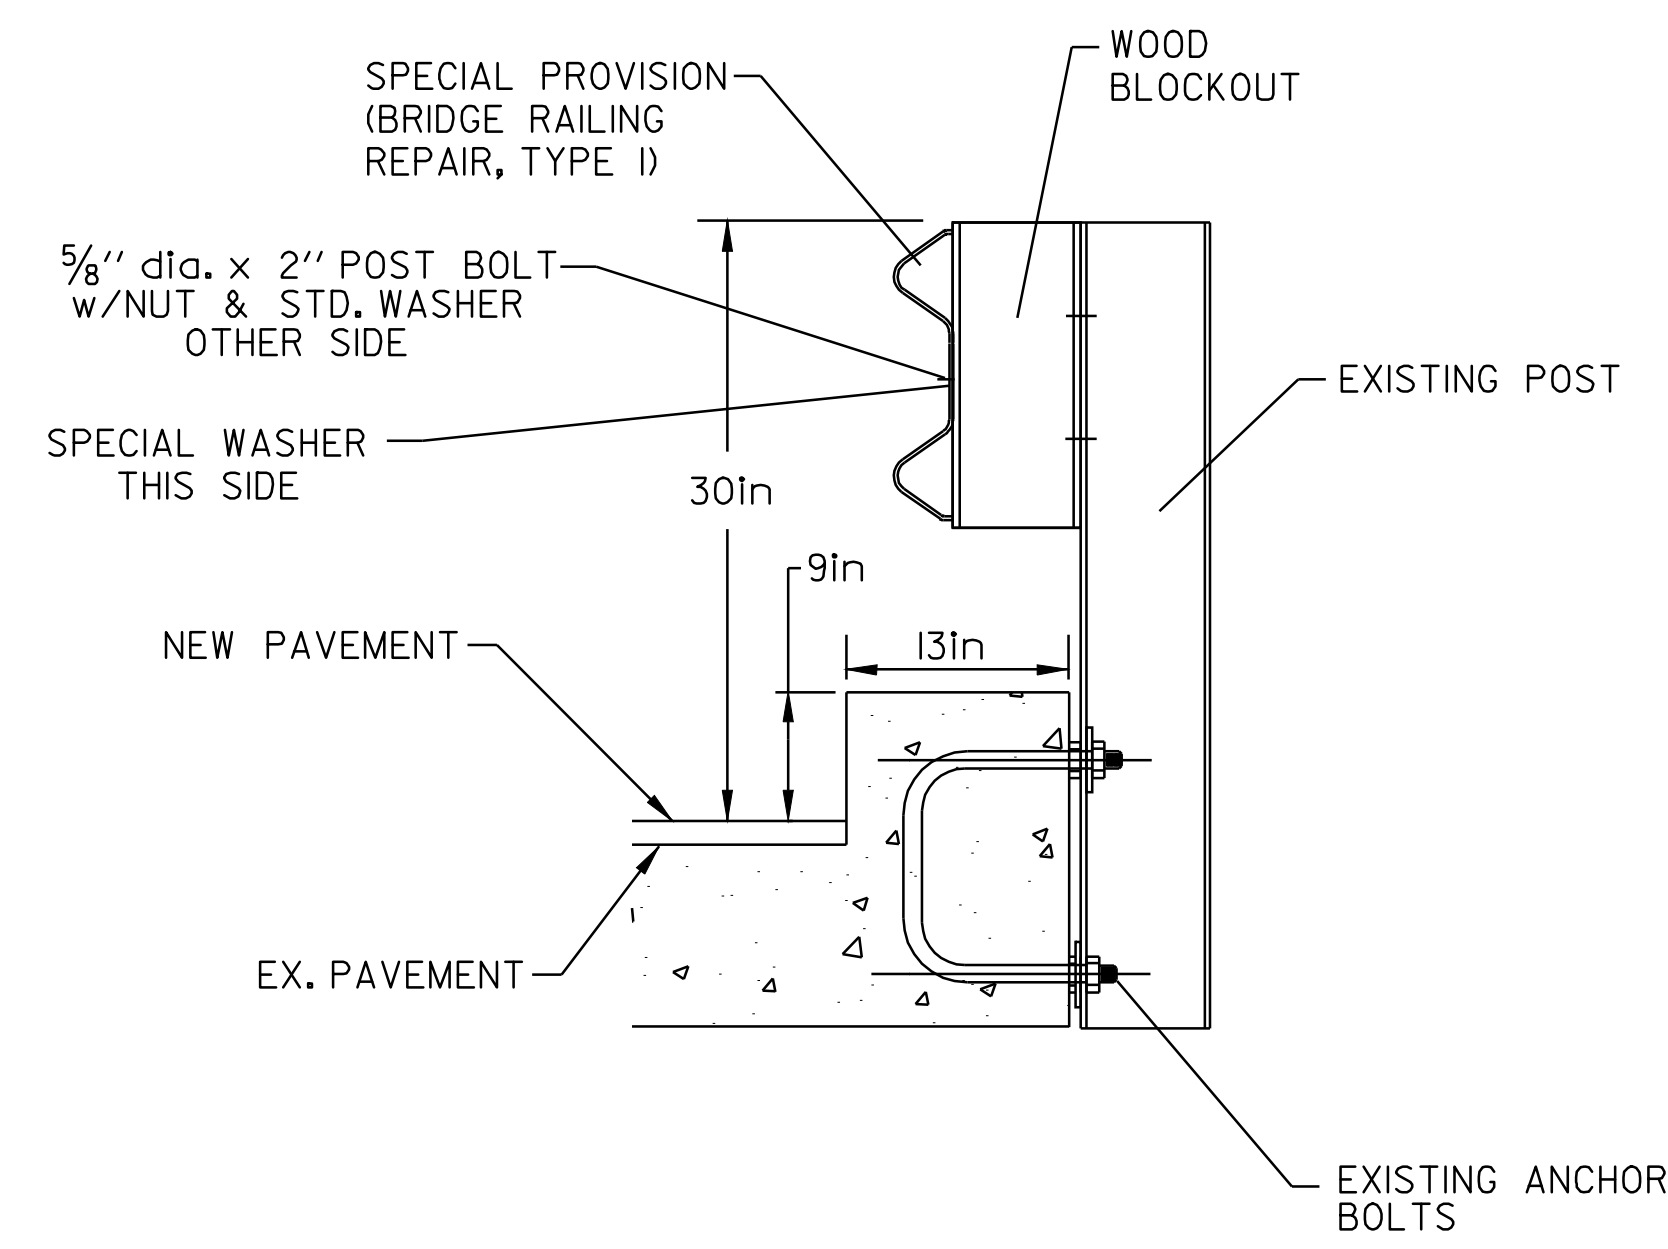

POST DETAIL

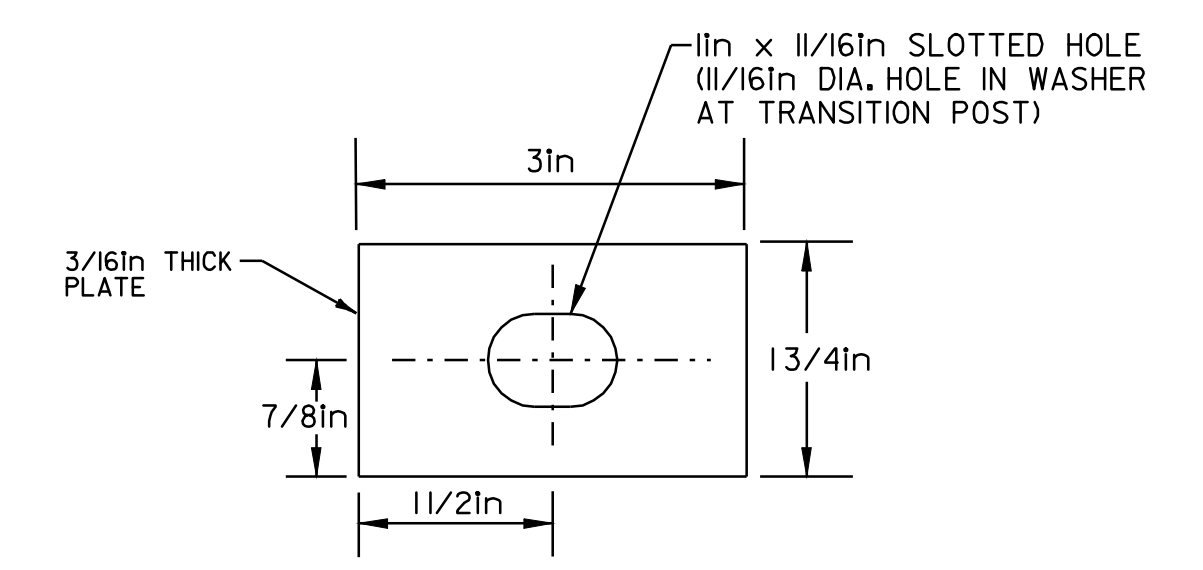



SPECIAL WASHER DETAIL
(MATERIAL SHALL MEET AASHTO M 270M/M 270 GRADE 345)

POST DETAILS

- NOTES:
1. BOLTS, NUTS & WASHERS SHALL BE GALVANIZED AND CONFORM TO SUBSECTION 714.07, EXCEPT THAT POST BOLTS SHALL CONFORM TO STANDARD G-I REQUIREMENTS AND BE CORROSION RESISTANT.
 2. POSTS, PLATE AND SPECIAL WASHER SHALL BE OF AASHTO M 270M/M 270 GRADE 345 (GRADE 50) STEEL


**BRIDGE
DETAIL
SHEET
#2**

DESIGNED BY	BCE/PJM	DATE	6-07
DRAWN BY	C.E.A., INC.	DATE	6-07
DESIGN FILE NO.	p06cl62.dgn		
PRF FILE	p06cl62bd2.1	DATE PLOTTED	03-NOV-2009 10
PROJ. NAME	BELVIDERE – MONTGOMERY		
PROJ. NO.	STP 2619(1)S		
SHEET	31	OF	33 SHEETS

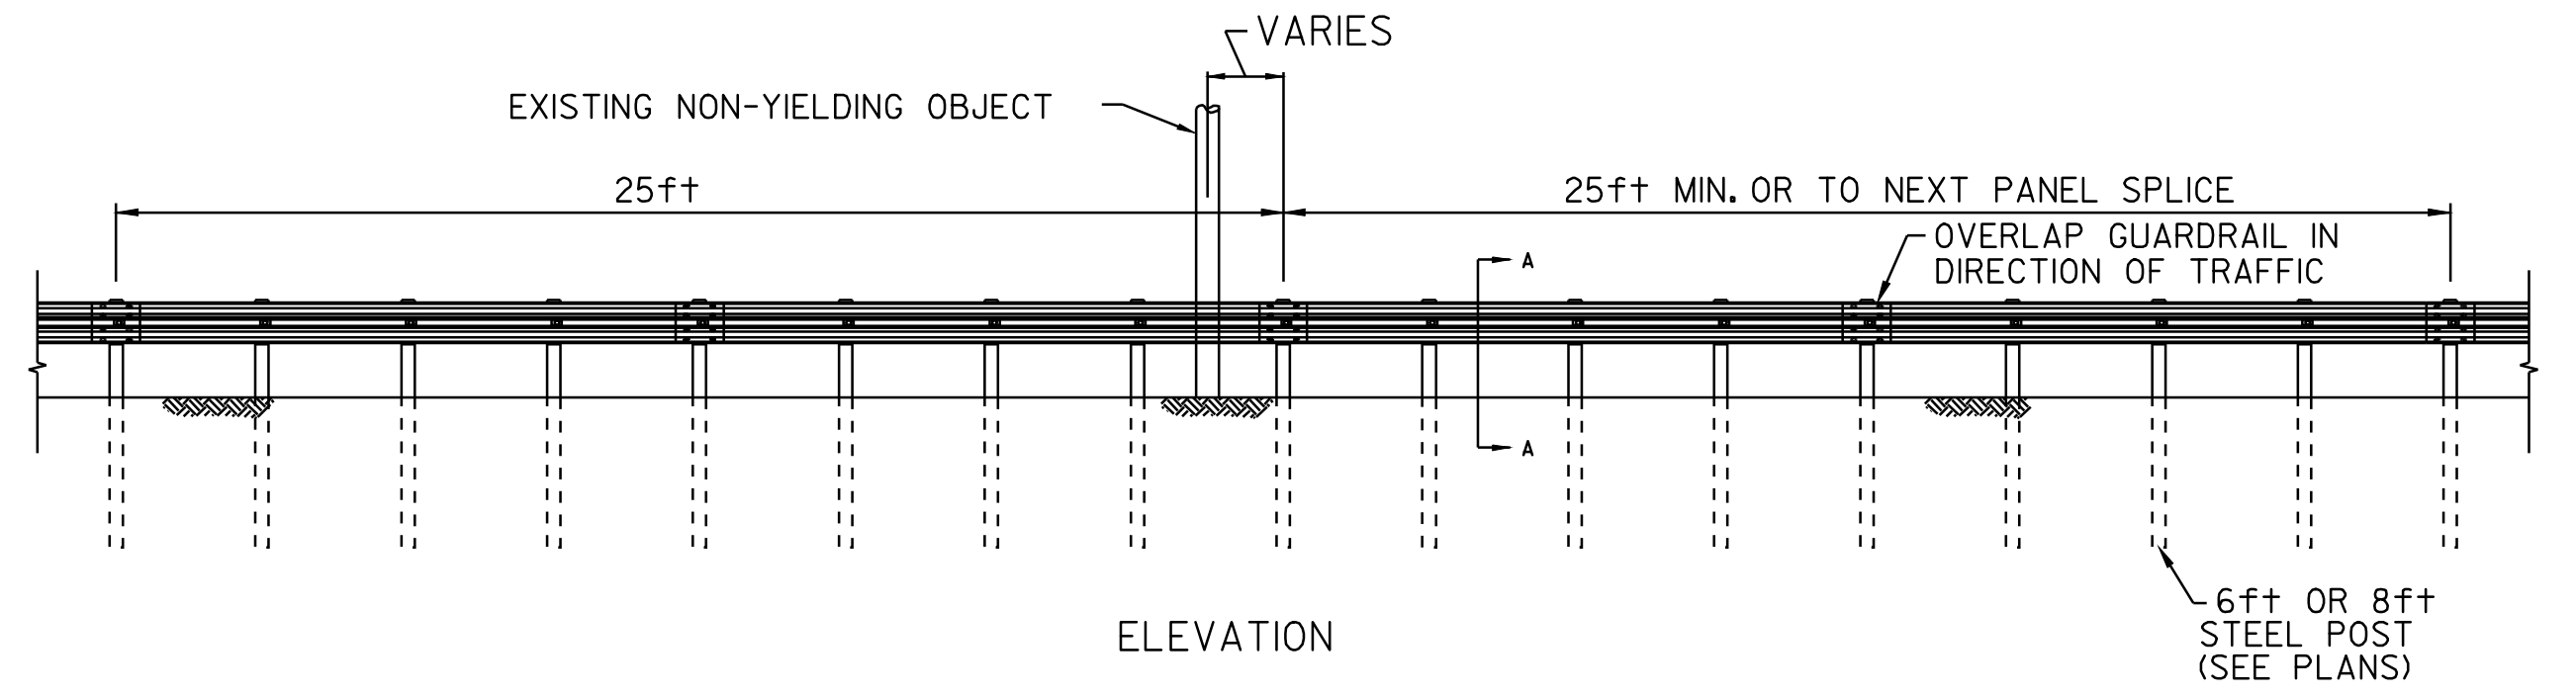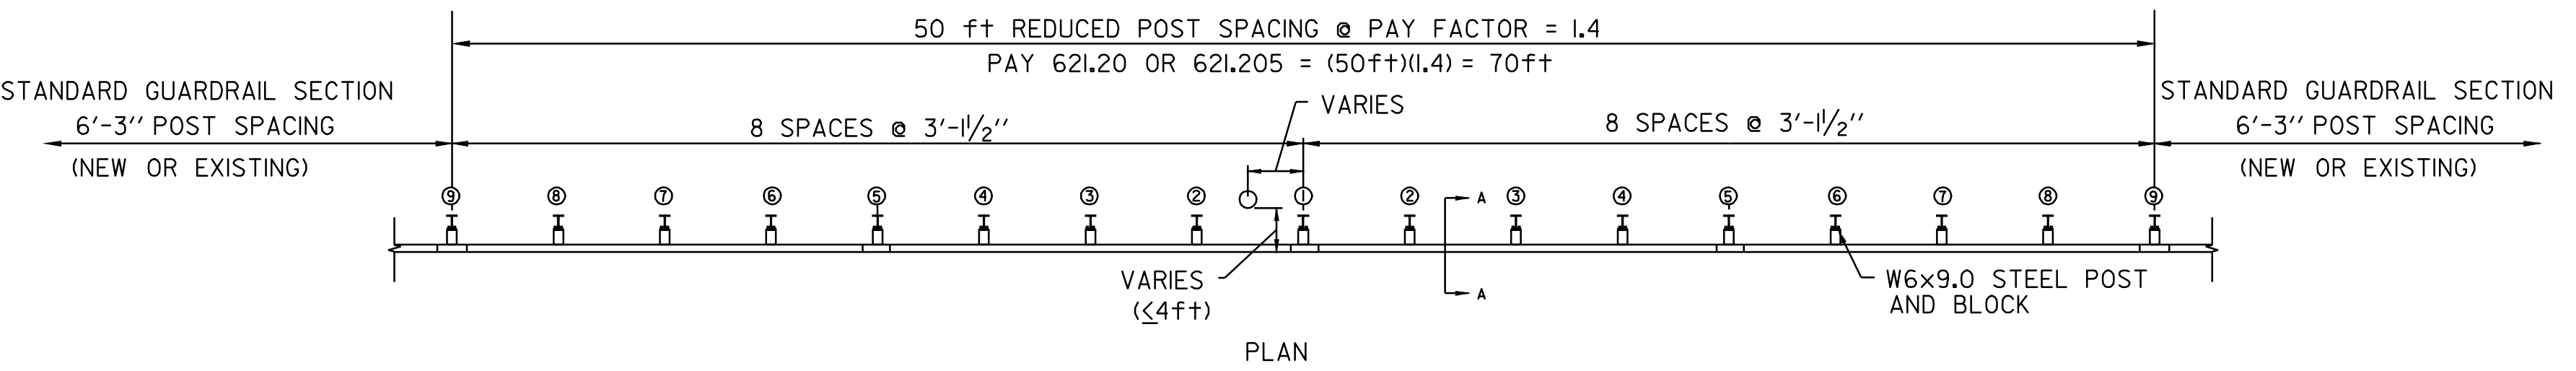


NON-YIELDING OBJECT APPROACH DETAIL


MONTGOMERY
 STA 16+20 LT
 STA 35+25 LT
 STA 211+05 RT

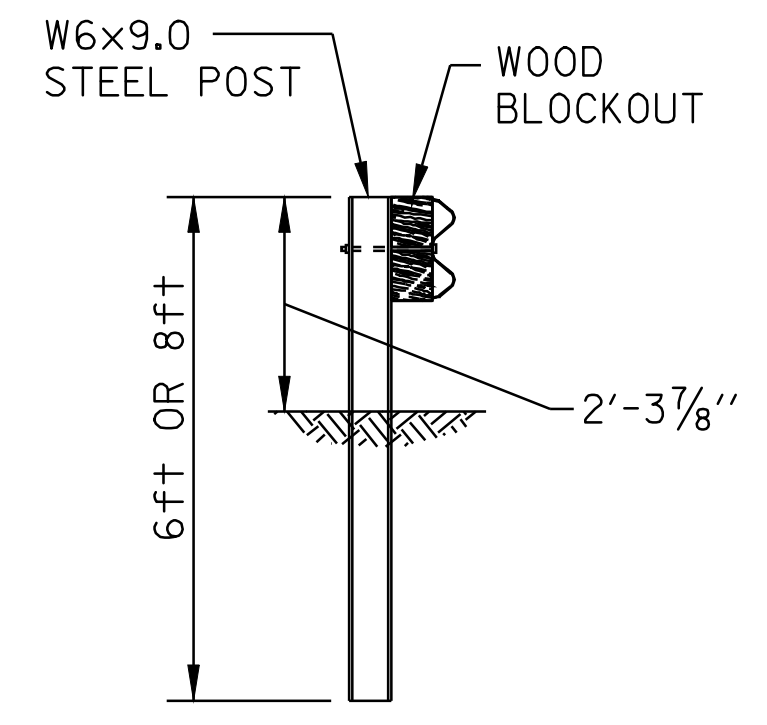

SECTION A-A

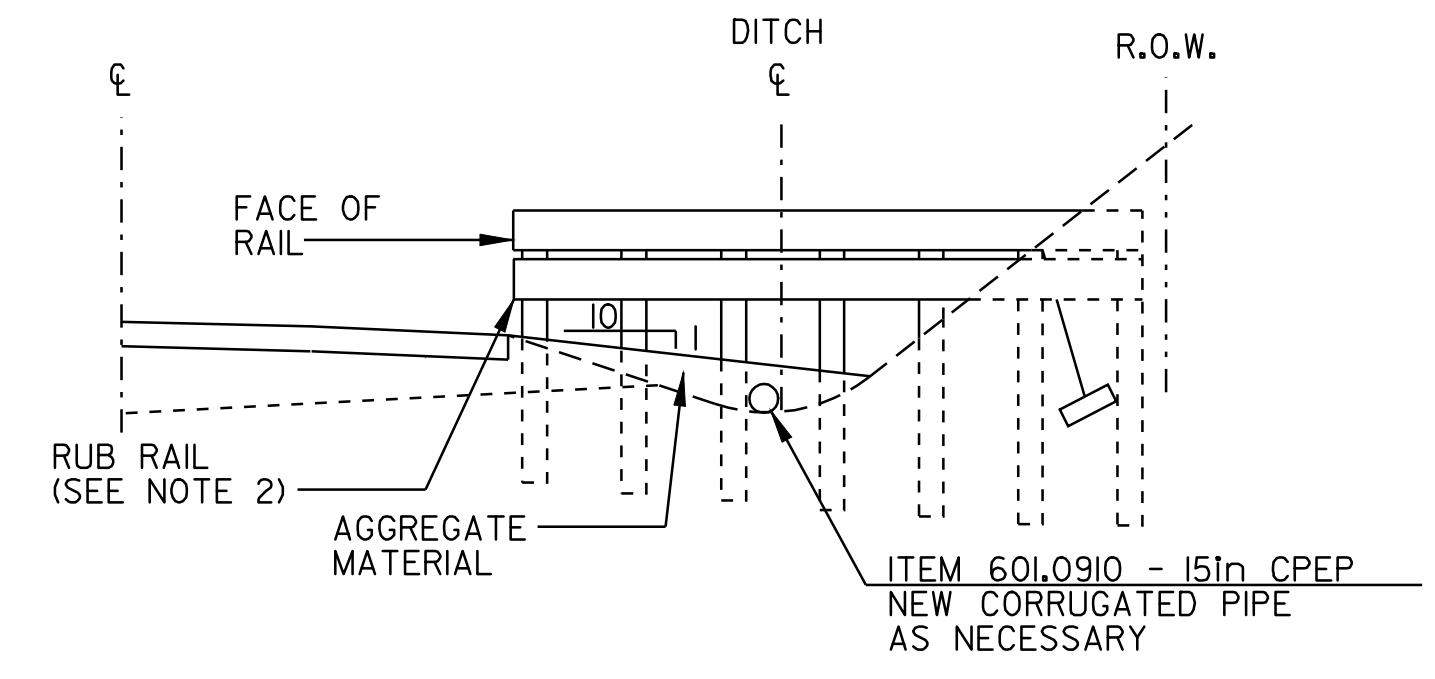

SECTION B-B

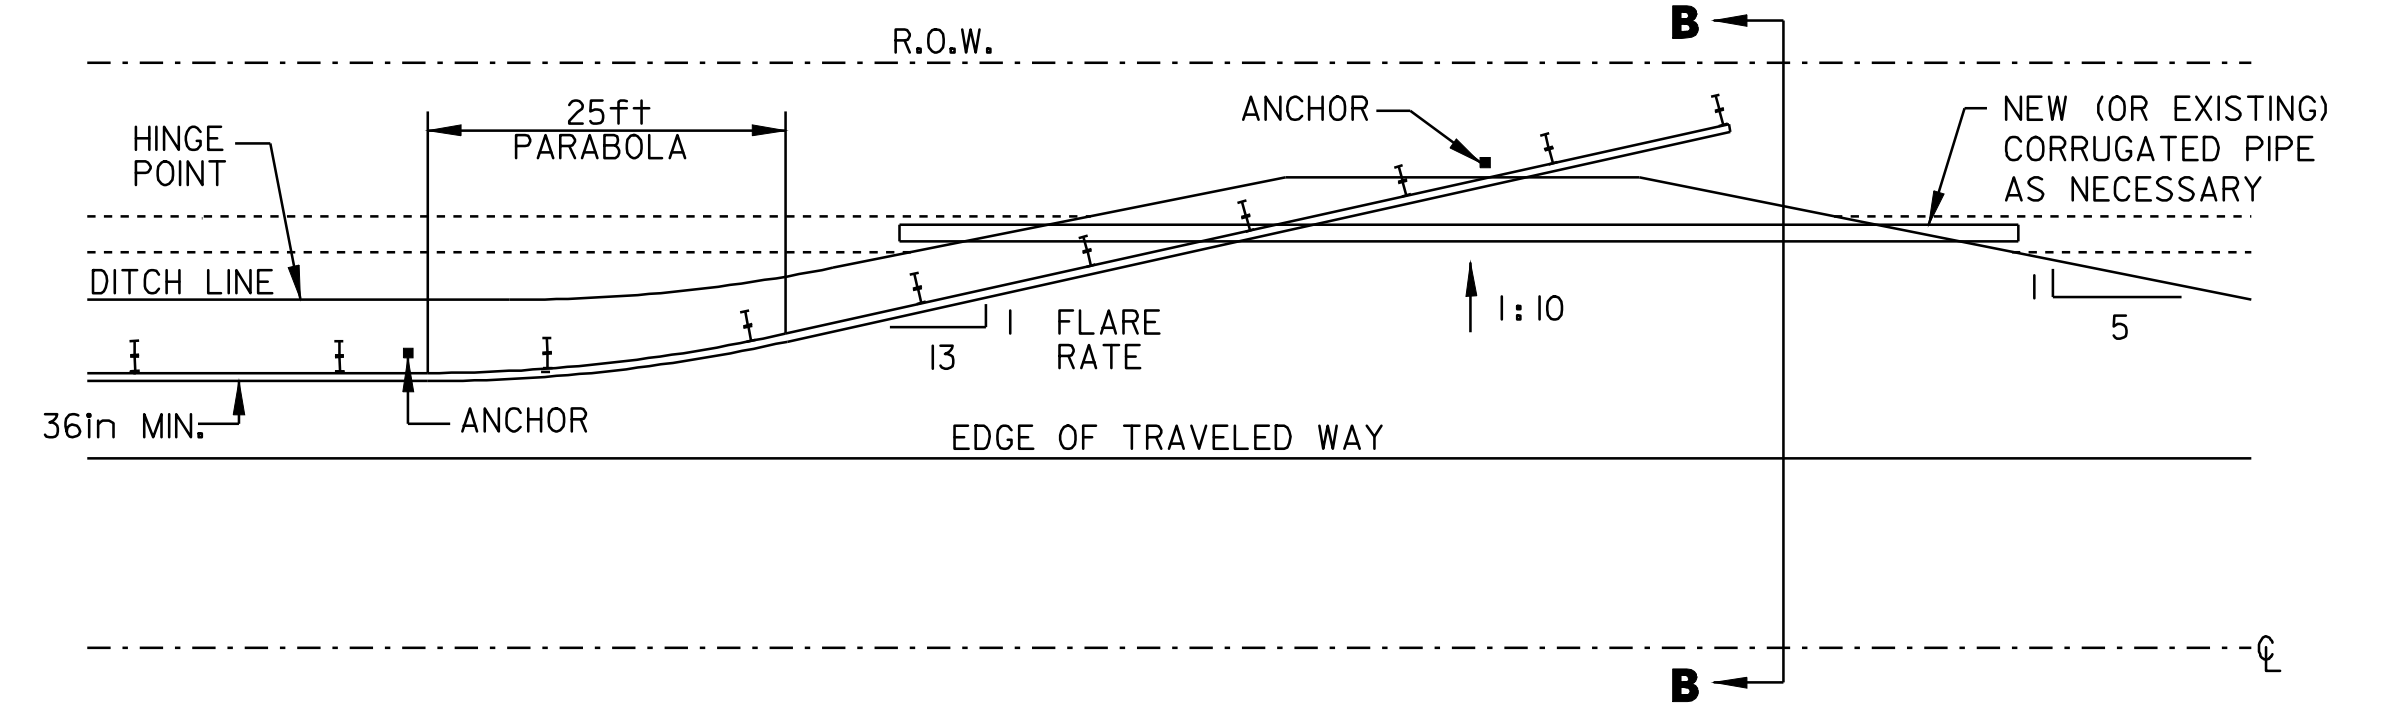

DETAIL FOR BURIED GUARDRAIL ENDS INTO BACKSLOPES

NOT TO SCALE

MONTGOMERY
 STA 20+14 LT STA 83+84 LT
 STA 71+77 RT STA 149+55 RT
 STA 72+03 LT STA 182+27 RT
 STA 79+40 LT STA 214+22 RT
 STA 81+80 RT STA 217+88 LT


NOTES:

1. PRIMARY RAIL SHALL REMAIN AT A CONSTANT HEIGHT (LEVEL) RELATIVE TO THE HEIGHT OF RAIL AT THE EDGE OF SHOULDER.
2. ADDITION OF RUB RAIL IS REQUIRED WHEN OPENING BENEATH PRIMARY RAIL EXCEEDS 18in. RUB RAIL EXTENDS FROM THE EDGE OF SHOULDER TO THE BACK SLOPE.

DATUM	
VERTICAL	N/A
HORIZONTAL	N/A

NON-YIELDING OBJECT APPROACH and BURIED END TERMINAL DETAIL SHEET

DESIGNED BY	BCE/PJM	DATE	6-07
DRAWN BY	C.E.A., INC.	DATE	6-07
DESIGN FILE NO.	p06cl62.dgn		
PRF FILE	p06cl62det.1	DATE PLOTTED	03-NOV-2009 10
PROJ. NAME	BELVIDERE - MONTGOMERY		
PROJ. NO.	STP 2619(1)S		
SHEET	32	OF	33 SHEETS

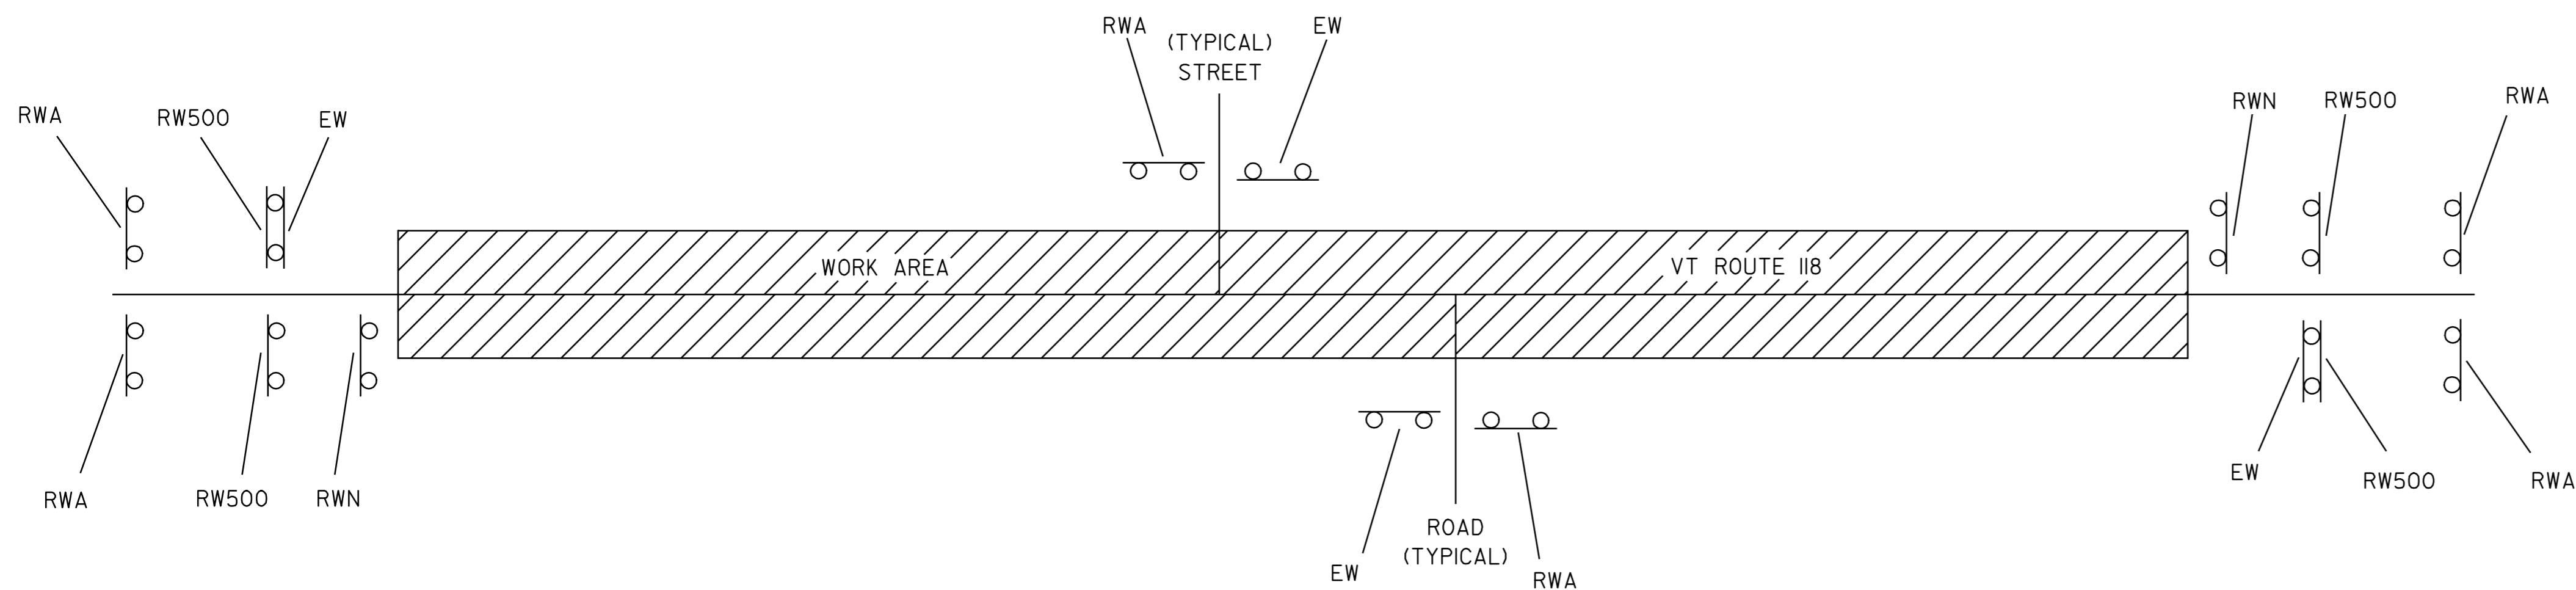

LIST OF CONSTRUCTION SIGNS

TOWN HIGHWAY	RWA	RW500	EW	RWN
BELVIDERE				
BEGIN PROJECT	2	2	1	1
MONTGOMERY				
NUTTING RD	1		1	
S. BRANCH RD	1		1	
REAGAN RD	1		1	
SUNDELL RD	1		1	
GIBOU RD	1		1	
SOUTH BROOK RD	1		1	
SOUTH BROOK RD	1		1	
END PROJECT	2	2	1	1
TOTALS	11	4	9	2

LEGEND

- RWA = ROAD WORK AHEAD
- RW500 = ROAD WORK 500 FEET
- EW = END WORK
- RWN = ROAD WORK NEXT 8 MILES

CONSTRUCTION APPROACH SIGNING


SEE STANDARDS E-100 AND E-100A FOR SIGN PLACEMENT

PAYMENT FOR CONSTRUCTION SIGNING WILL BE MADE UNDER ITEM 641.10, TRAFFIC CONTROL.



RESIDENT ENGINEER, AT HIS OR HER DISCRETION, SHALL ELIMINATE CONSTRUCTION APPROACH SIGNING AT DEAD END LOCATIONS.

NOTES:



1. THE CONTRACTOR SHALL SUBMIT A TRAFFIC CONTROL PLAN FOR APPROVAL PRIOR TO THE START OF CONSTRUCTION. THE COST OF PREPARING THIS PLAN (AND MAKING CHANGES IF NECESSARY) SHALL NOT BE PAID SEPARATELY BUT SHALL BE INCIDENTAL TO ITEM 641.10, "TRAFFIC CONTROL".
2. THE CONTRACTOR SHALL INCLUDE A CONSTRUCTION SIGN APPROACH PACKAGE FOR EXPECTED LANE CLOSURES AND WORK ZONE SPEED REDUCTIONS IN COMPLIANCE WITH VTRANS STANDARD E-103. PAYMENT FOR PROVIDING THIS PACKAGE SHALL BE INCIDENTAL TO ITEM 641.10, "TRAFFIC CONTROL".
3. THE MUTCD 2003 SHALL BE THE STANDARD FOR ALL TRAFFIC CONTROL DEVICES. EXISTING SIGNS, SIGNALS AND MARKINGS SHALL BE VALID UNTIL SUCH TIME AS THEY ARE REPLACED OR RECONSTRUCTED. WHEN NEW TRAFFIC CONTROL DEVICES ARE ERECTED OR PLACED OR EXISTING TRAFFIC CONTROL DEVICES ARE REPLACED OR REPAIRED THE EQUIPMENT, DESIGN, METHOD OF INSTALLATION, PLACEMENT OR REPAIR SHALL CONFORM TO THESE STANDARDS.
4. NO CONSTRUCTION SIGNS SHALL BE INSTALLED AS TO INTERFERE OR OBSTRUCT THE VIEW OF EXISTING TRAFFIC CONTROL DEVICES, STOPPING SIGHT DISTANCE, AND CORNER SIGHT DISTANCE FROM DRIVES AND TOWN HIGHWAYS.
5. ON VTRANS STANDARD E-103, SIGN W4-2 MAY BE REPLACED WITH W9-2:

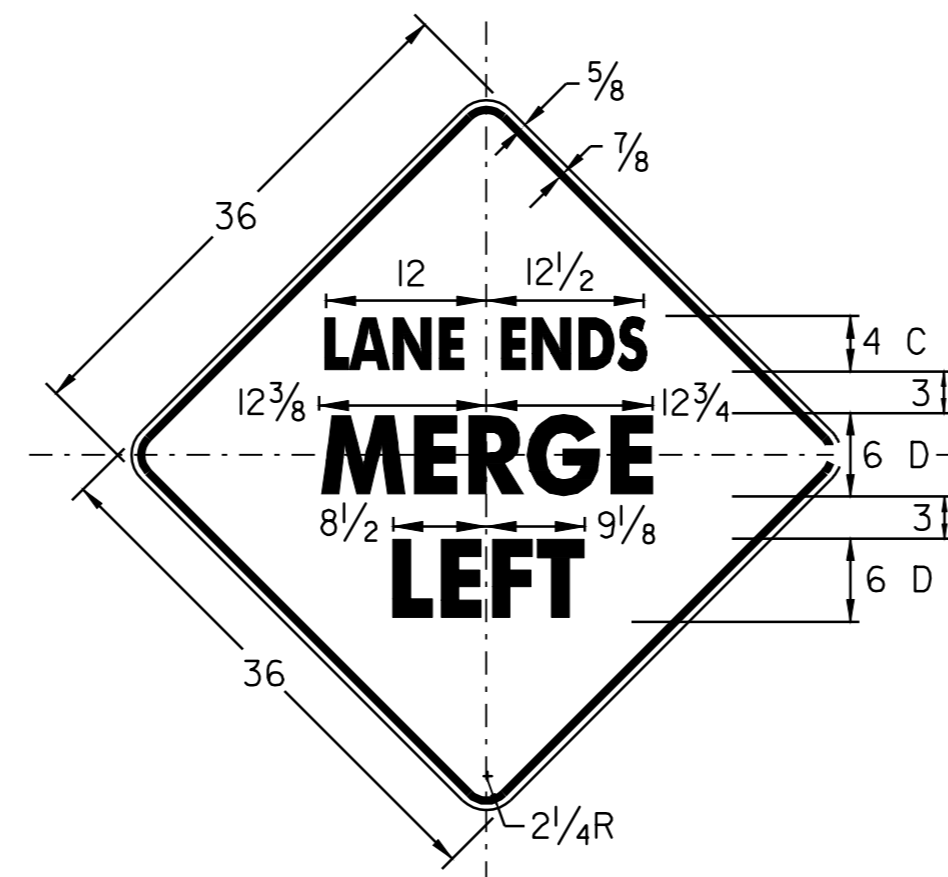


W9-2
MATERIALS & COLORS:
PER VAOT STANDARD E-154

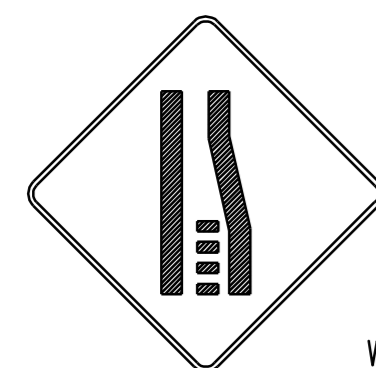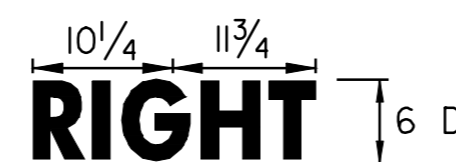

W4-2

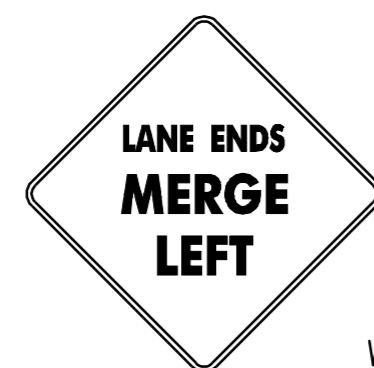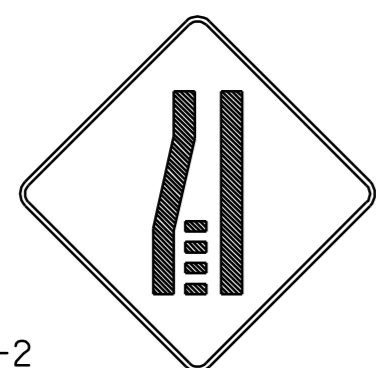

W9-2

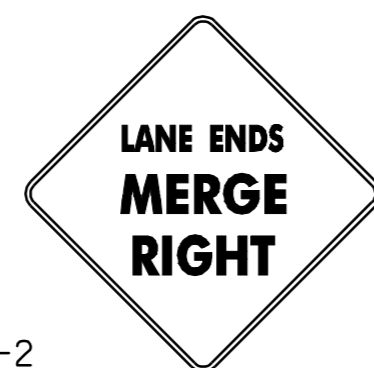

CONSTRUCTION APPROACH SIGNING AND DETAIL SHEET

DATUM
VERTICAL N/A
HORIZONTAL N/A

DESIGNED BY BCE/PJM DATE 6-07

DRAWN BY C.E.A., INC. DATE 6-07

DESIGN FILE NO. p06cl62.dgn

PRF FILE p06cl62cas.i DATE 03-NOV-2009
PLOT FILE p06cl62cas.i PLOTTED 03-NOV-2009

PROJ. NAME **BELVIDERE - MONTGOMERY**

PROJ. NO. **STP 2619(1)S**

SHEET **33** OF **33** SHEETS