

STATE OF VERMONT
AGENCY OF TRANSPORTATION



PROPOSED IMPROVEMENT
TOWNS OF MIDDLEBURY, RIPTON AND HANCOCK
COUNTY OF ADDISON
VT. ROUTE 125

INDEX OF SHEETS
SEE SHEET 2


RECORD PLANS

CONTRACTOR: F.W. WHITCOMB CONSTRUCTION CORP. - WALPOLE, NH
RESIDENT ENGINEER: JOSH HULETT
CONSTRUCTION BEGAN: MAY 10, 2010
CONSTRUCTION COMPLETE: JUNE 6, 2011
RECORD PLANS BY: JOSH HULETT & DARREN CONNOLLY

I HEREBY CERTIFY THAT ALL THE CONSTRUCTION REQUIRED BY THIS SET OF DRAWINGS HAS BEEN ACCOMPLISHED AS INDICATED HEREIN.



BY Josh Hulett RESIDENT ENGINEER
DATE 9/10/2013

NOTE: Any further information concerning final quantities, amounts or other details relative to this project may be found at Central Files in the electronic archives.

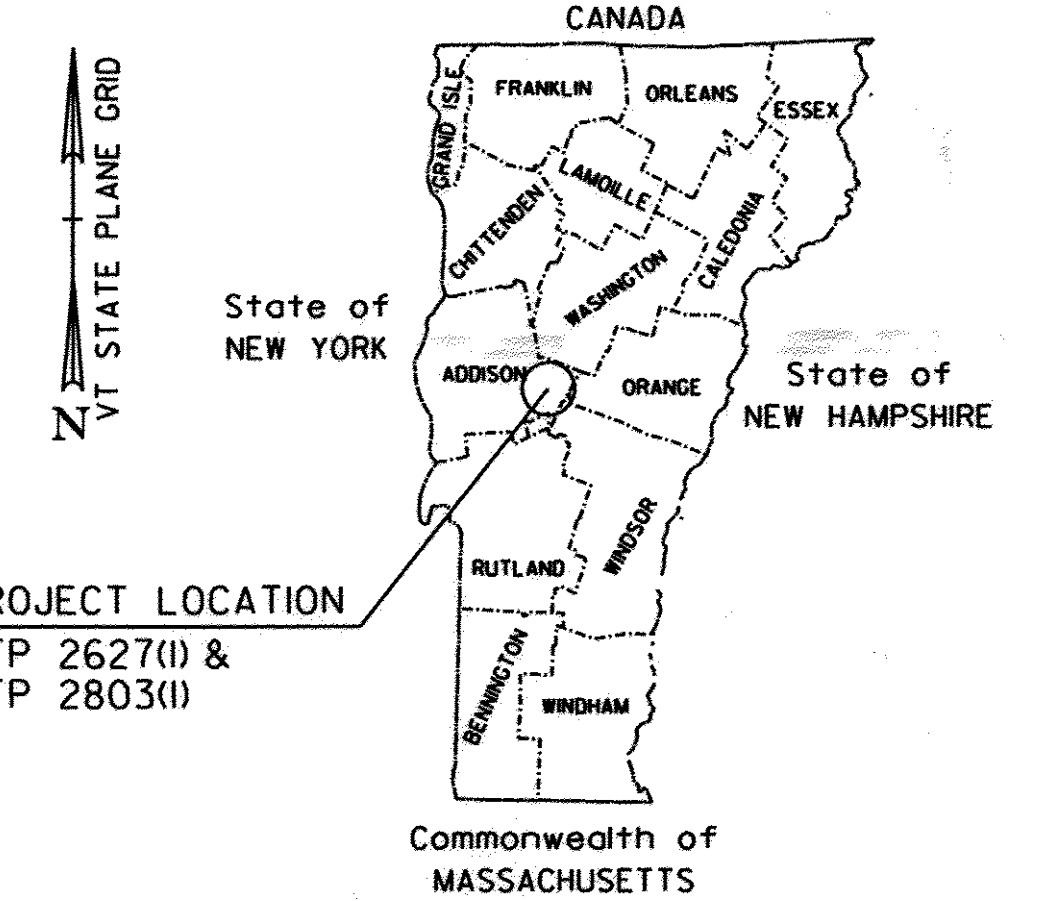

MIDDLEBURY
STP 2627(I)
SEE SHEET 11
FOR ADDITIONAL PROJECT INFORMATION
AND THE SUPERPAVE DESIGN CRITERIA

RIPTON - HANCOCK
STP 2803(I)
SEE SHEET 50
FOR ADDITIONAL PROJECT INFORMATION
AND THE SUPERPAVE DESIGN CRITERIA

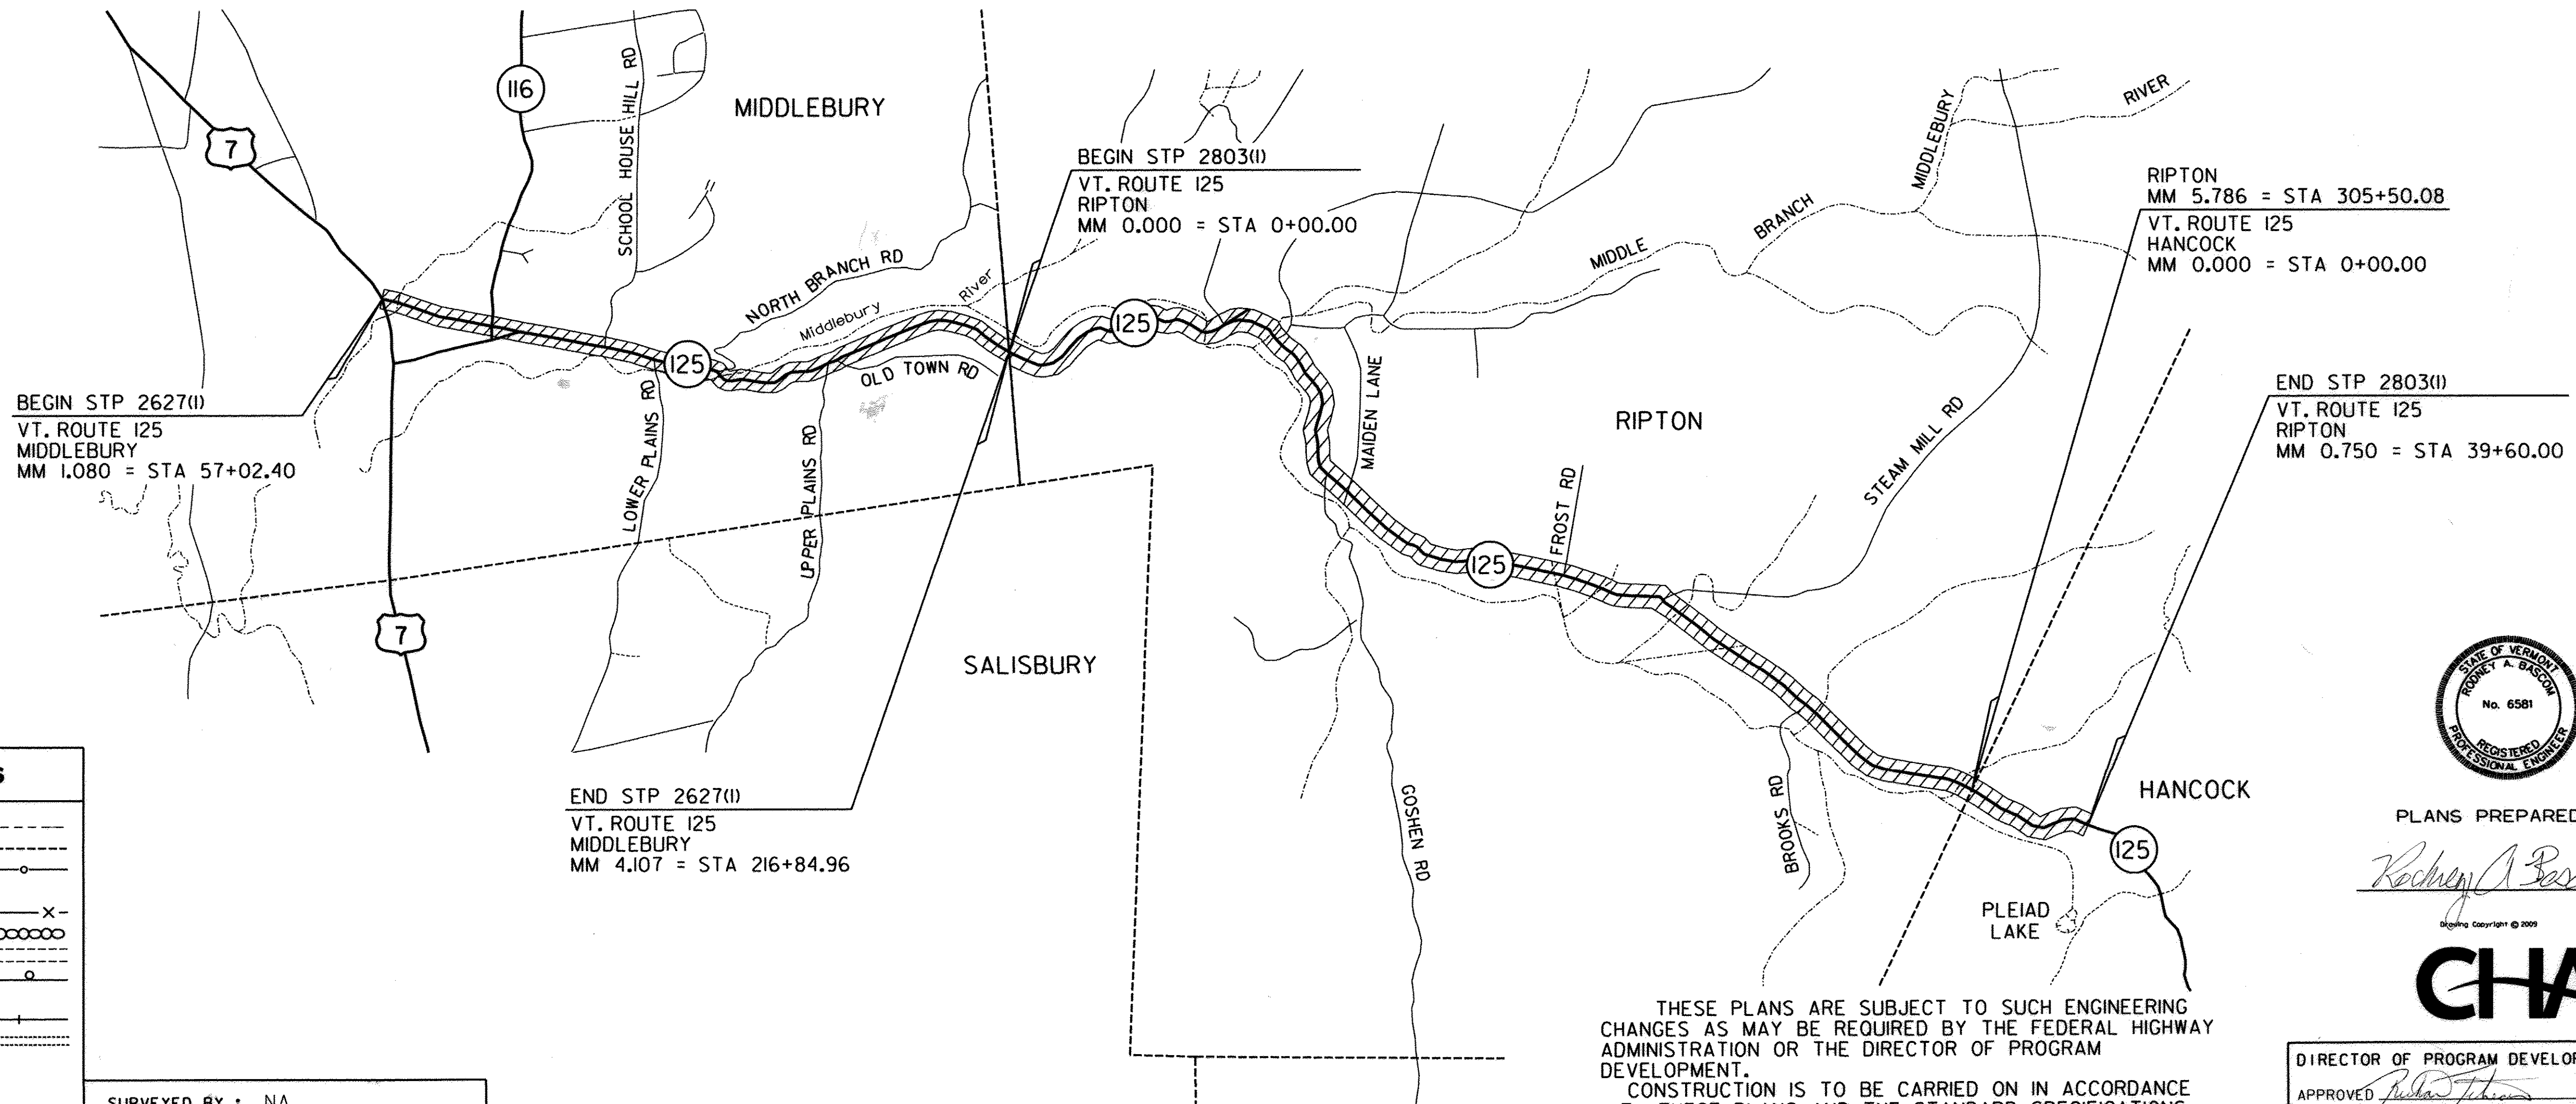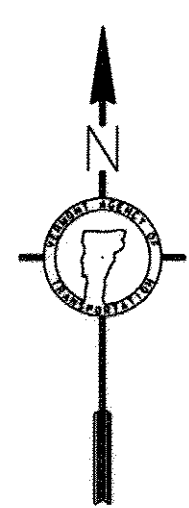


CONVENTIONAL SYMBOLS


COUNTY LINE	---
TOWN LINE	---
LIMITS OF ACCESS	---o---o---
POINT OF ACCESS	X
FENCE LINE	X-X-X-X-X
STONE WALL	o-o-o-o-o-o-o-o-o-o
TRAVELED WAY	---
GUARD RAIL	o-o-o-o-o-o-o-o-o-o
RAILROAD	+
SURVEY LINE	---
CULVERT	---
POWER POLE	⊕
TELEPHONE POLE	⊕
TREES	⊕
CONTROL OF ACCESS	---//---//---
PROPERTY LINE	---
R.O.W. TAKING LINE	SR
SLOPE RIGHTS	SR
TOP OF CUT	△
TOE OF SLOPE	○

SURVEYED BY : NA
SURVEYED DATE : NA
DATUM
VERTICAL NA
HORIZONTAL NA

THESE PLANS ARE SUBJECT TO SUCH ENGINEERING CHANGES AS MAY BE REQUIRED BY THE FEDERAL HIGHWAY ADMINISTRATION OR THE DIRECTOR OF PROGRAM DEVELOPMENT.
CONSTRUCTION IS TO BE CARRIED ON IN ACCORDANCE WITH THESE PLANS AND THE STANDARD SPECIFICATIONS FOR CONSTRUCTION DATED 2006, AS APPROVED BY THE FEDERAL HIGHWAY ADMINISTRATION ON JUNE 15, 2006 FOR USE ON THIS PROJECT, INCLUDING ALL SUBSEQUENT REVISIONS AND SUCH REVISED SPECIFICATIONS AND SPECIAL PROVISIONS AS ARE INCORPORATED IN THESE PLANS.

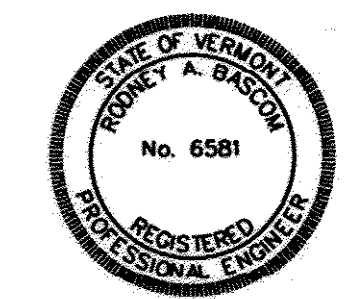

PLANS PREPARED BY
Kevin Marshia

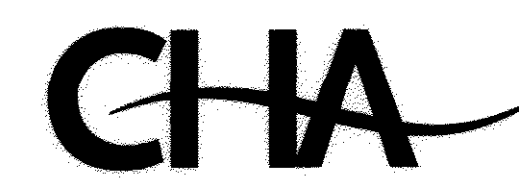

DIRECTOR OF PROGRAM DEVELOPMENT
APPROVED Kevin Marshia DATE 1-11-10
PROJECT MANAGER : KEVIN MARSHIA
PROJECT NAME : MIDDLEBURY & RIPTON - HANCOCK
PROJECT NUMBER : STP 2627(I) & STP 2803(I)
SHEET 1 OF 114 SHEETS

FILE NAME : U:\1762\CADD\NH\STP 2803\p86a160_comp.cov.dgn
DATE/TIME : 12/10/2009 1:15:51