

**646.402 DURABLE 4 INCH WHITE LINE, THERMOPLASTIC**

(ALL LINES WILL INCLUDE EDGE LINE BREAKS AND RADIUS FOR TOWN HIGHWAYS)

MIDDLEBURY:  
STA 173+50.00 - STA 188+00.00 EDGE LINE LT & RT

**646.412 DURABLE 4 INCH YELLOW LINE, THERMOPLASTIC**

(ALL LINES WILL INCLUDE C/L BREAKS FOR TOWN HIGHWAYS) S=SOLID, D=DASHED

MIDDLEBURY: LT CL RT  
STA 173+50.00 - STA 188+00.00 S - S

**646.602 TEMPORARY 4 INCH WHITE LINE, PAINT**


(ALL LINES WILL INCLUDE EDGE LINE BREAKS AND RADIUS FOR TOWN HIGHWAYS)

MIDDLEBURY:  
STA 173+50.00 - STA 188+00.00 EDGE LINE LT & RT

**646.612 TEMPORARY 4 INCH YELLOW LINE, PAINT**

(ALL LINES WILL INCLUDE C/L BREAKS FOR TOWN HIGHWAYS) S=SOLID, D=DASHED

MIDDLEBURY: LT CL RT  
STA 173+50.00 - STA 188+00.00 S - S

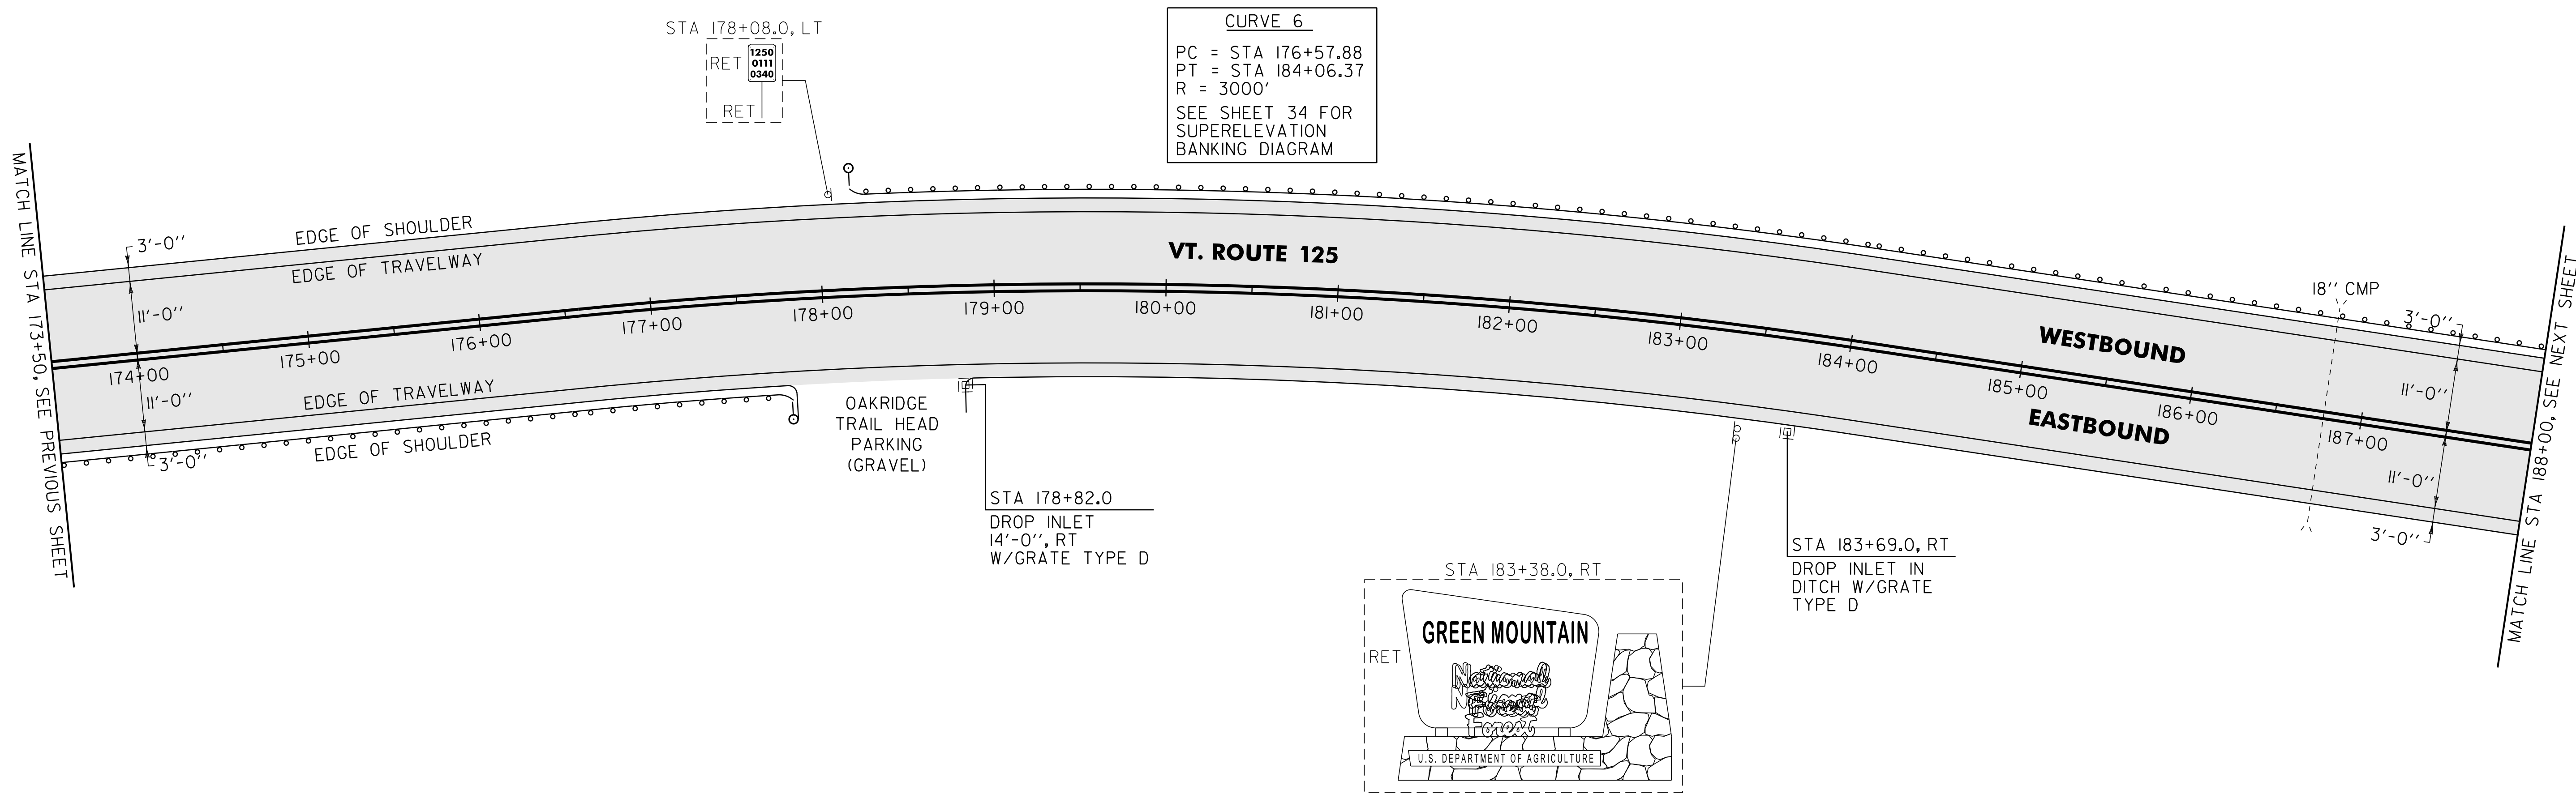

**621.80 REMOVAL AND DISPOSAL OF GUARDRAIL**

MIDDLEBURY:  
STA 173+55.0 - STA 177+70.0 RT (415.0 LF)  
STA 178+19.0 - STA 188+00.0 LT (981.0 LF)

**676.10 DELINEATOR WITH STEEL POST**

MIDDLEBURY:  
STA 177+70.0 RT  
STA 178+13.5 LT

**900.620 SPECIAL PROVISION (MANUFACTURED TERMINAL SECTION, FLARED/WEATHERING)**

MIDDLEBURY:  
STA 178+13.5 - STA 178+51.0 LT

**900.640 SPECIAL PROVISION (STEEL BEAM GUARDRAIL, WEATHERING)**

MIDDLEBURY:  
STA 178+51.0 - STA 188+00.0 (949.0 LF)

**604.412, 604.415, 604.418 REHAB. DROP INLETS, CATCH BASINS, OR MANHOLES, CLASS I, II, III (SEE NOTE 1)**

MIDDLEBURY:  
STA 178+82.0 RT  
STA 183+69.0 RT

**621.20 STEEL BEAM GUARDRAIL, GALVANIZED**

MIDDLEBURY:  
STA 173+82.5 - STA 177+32.5 RT (350.0 LF)

**621.50 MANUFACTURED TERMINAL SECTION, FLARED**

MIDDLEBURY:  
STA 173+50.0 - STA 173+82.5 RT  
STA 177+32.5 - STA 177+70.0 RT

AREA TO BE RECLAIMED

NOTE:  
I. THE CONTRACTOR SHALL REHAB. THE EXISTING DROP INLETS, CATCH BASINS OR MANHOLES TO A DEPTH AS DIRECTED BY THE RESIDENT ENGINEER. ALL REHAB. WORK WILL BE PAID FOR UNDER THE APPLICABLE REHAB. ITEM AS DIRECTED BY THE RESIDENT ENGINEER. ALL EXISTING UTILITIES MARKED "TO REMAIN" SHALL NOT BE ALTERED OR REHABILITATED UNLESS DIRECTED OTHERWISE BY THE RESIDENT ENGINEER.

NOT TO SCALE

<b>PROJECT LAYOUT SHEET #10</b>	PROJECT NAME: MIDDLEBURY	PLOT DATE: 19-SEP-2013 11:14
	PROJECT NUMBER: STP 2627(1)	DRAWN BY: C.A.K.
	FILE NAME: p06c222.dgn	CHECKED BY: D.W.E.
	PROJECT LEADER: D.E.G.	SHEET 29 OF 114
	DESIGNED BY: M.J.L.	
	IPARM FILE: p06c222110.1	

**SIGN LEGEND**  
R = REMOVE  
S = SALVAGE  
N = NEW  
RET = RETAIN  
B-B = BACK TO BACK  
EXISTING = -----  
NEW = \_\_\_\_\_