

646.402 DURABLE 4 INCH WHITE LINE, THERMOPLASTIC
 (ALL LINES WILL INCLUDE EDGE LINE BREAKS AND RADIUS FOR TOWN HIGHWAYS)
 RIPTON:
 STA 0+00.00 - STA 11+00.00 EDGE LINE LT & RT

646.412 DURABLE 4 INCH YELLOW LINE, THERMOPLASTIC
 (ALL LINES WILL INCLUDE C/L BREAKS FOR TOWN HIGHWAYS) S=SOLID, D=DASHED
 RIPTON:
 STA 0+00.00 - STA 11+00.00 LT C RT
 S - S


646.602 TEMPORARY 4 INCH WHITE LINE, PAINT
 (ALL LINES WILL INCLUDE EDGE LINE BREAKS AND RADIUS FOR TOWN HIGHWAYS)
 RIPTON:
 STA 0+00.00 - STA 11+00.00 EDGE LINE LT & RT

646.612 TEMPORARY 4 INCH YELLOW LINE, PAINT
 (ALL LINES WILL INCLUDE C/L BREAKS FOR TOWN HIGHWAYS) S=SOLID, D=DASHED
 RIPTON:
 STA 0+00.00 - STA 11+00.00 LT C RT
 S - S

675.50 REMOVING SIGNS
 AS SHOWN - 11

675.60 ERECTING SALVAGED SIGNS
 AS SHOWN - 4

VT. ROUTE 125
 RIPTON - HANCOCK
 MM 0.000 = STA 0+00.00
 BEGIN STP 2803(1)
 MATCH STP 2627(1)
 SEE SHEET 31

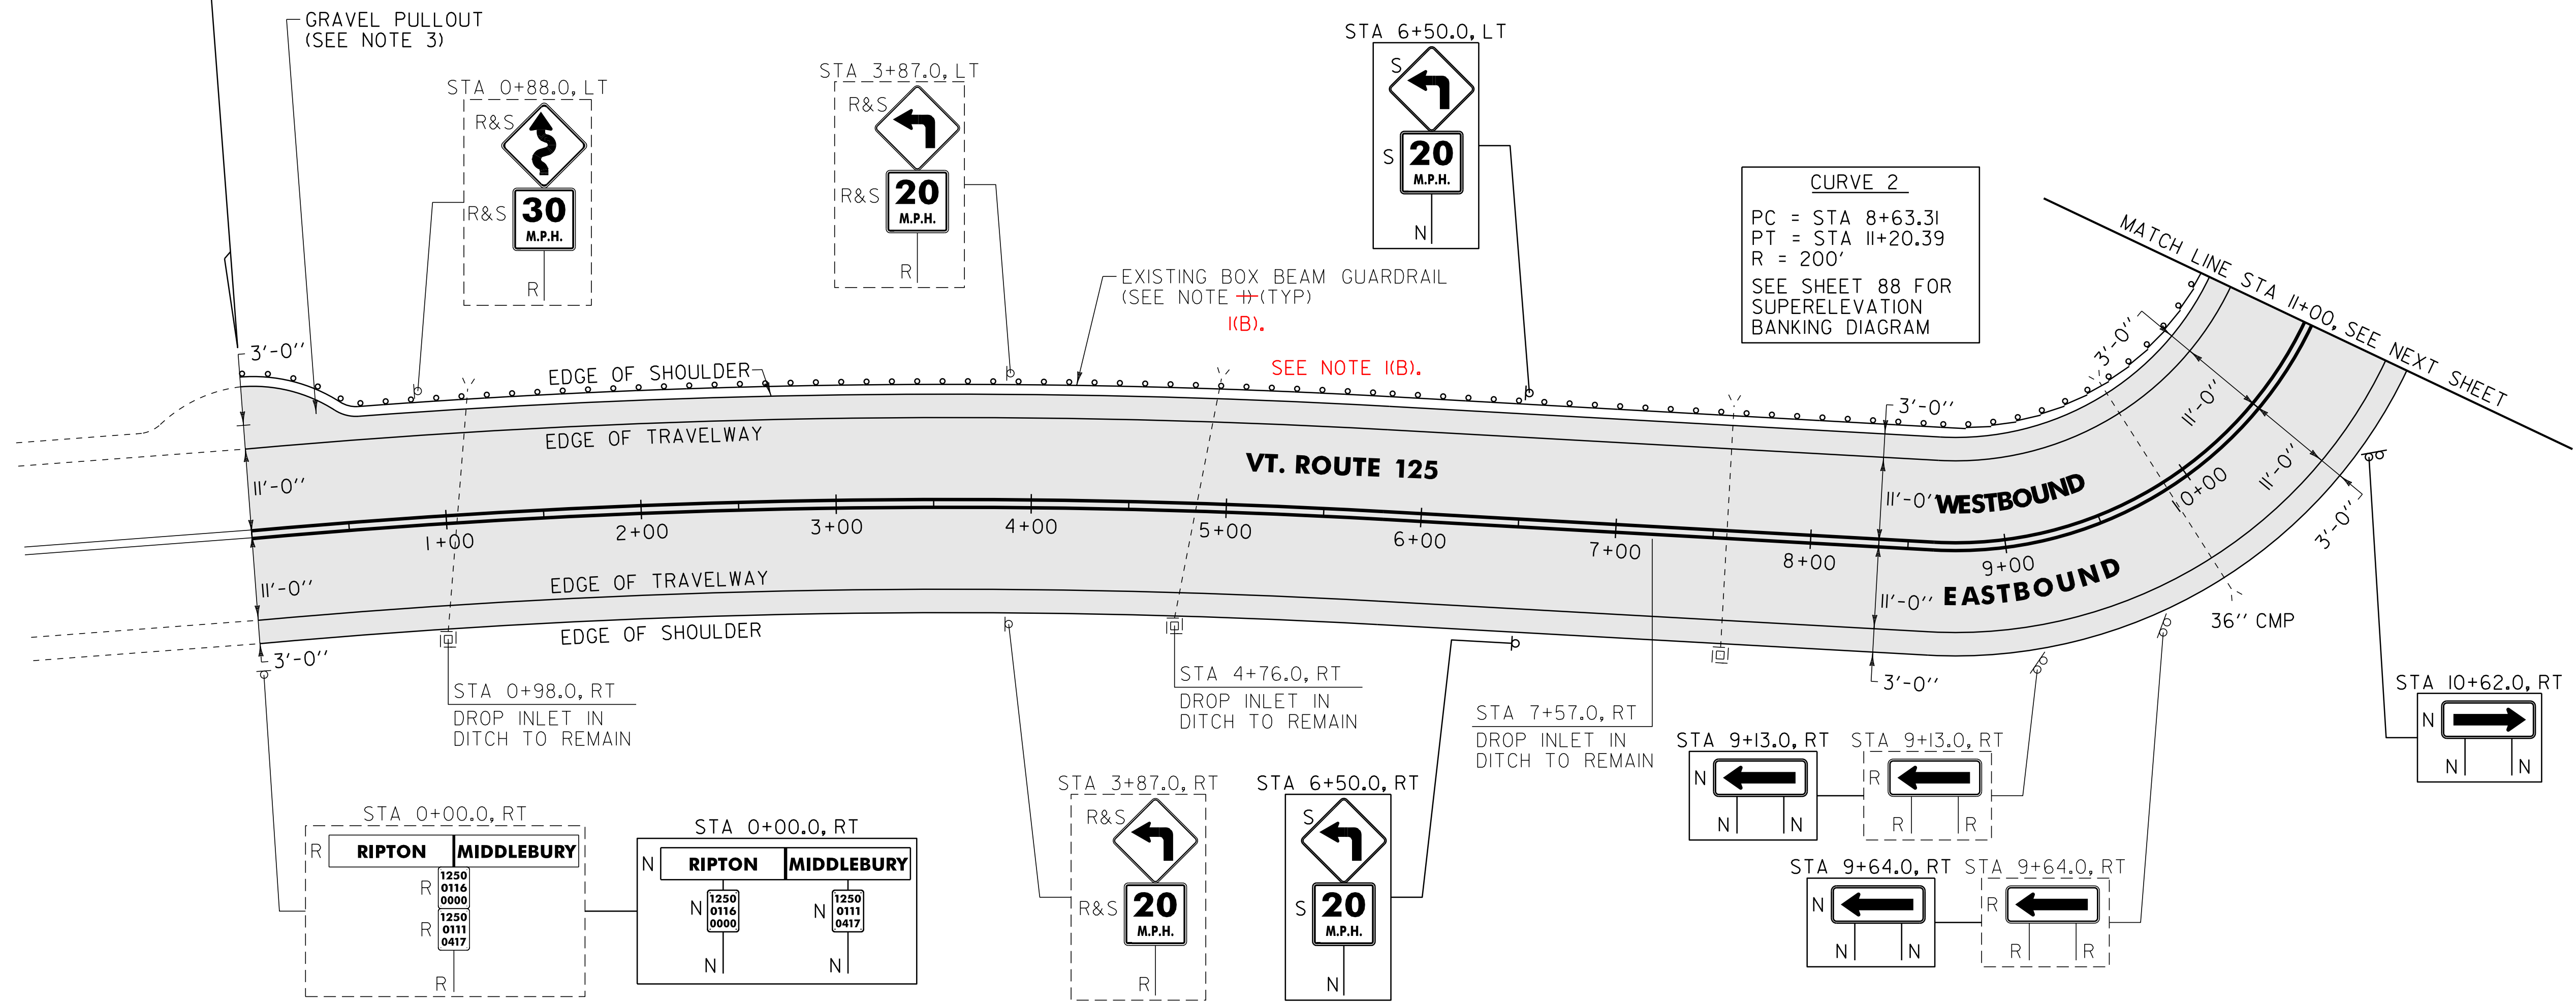

CURVE 1
 PC = STA 0+00.00
 PT = STA 5+80.57
 R = 4000'
 SEE SHEET 88 FOR SUPERELEVATION BANKING DIAGRAM

NOTE (B). REFERENCE SHEET 31 OF 114 FOR THE DESCRIPTION NOTE (B).
 STA 0+00 LT TO 11+00 LT

- NOTES:**
1. THE CONTRACTOR SHALL REPAIR AND/OR MAKE HEIGHT ALTERATIONS PER SUBSECTION 621.13 OF THE STANDARD SPECIFICATIONS AS DIRECTED BY THE RESIDENT ENGINEER BETWEEN RIPTON STA 0+00 AND STA 11+00 LT. ALL WORK SHALL BE PAID FOR UNDER ITEM 900.640 SPECIAL PROVISION (BOX BEAM GUARDRAIL REPAIRS, WEATHERING). AN ESTIMATED QUANTITY FOR THIS ITEM HAS BEEN INCLUDED IN THE PLAN SET. SEE SHEET 9 FOR AVAILABLE BOX BEAM GUARDRAIL INVENTORY.
 2. THE CONTRACTOR SHALL REHAB. THE EXISTING DROP INLETS, CATCH BASINS OR MANHOLES TO A DEPTH AS DIRECTED BY THE RESIDENT ENGINEER. ALL REHAB. WORK WILL BE PAID FOR UNDER THE APPLICABLE REHAB. ITEM AS DIRECTED BY THE RESIDENT ENGINEER. ALL EXISTING UTILITIES MARKED "TO REMAIN" SHALL NOT BE ALTERED OR REHABILITATED UNLESS DIRECTED OTHERWISE BY THE RESIDENT ENGINEER.
 3. PAVE THE ENTIRE EXISTING GRAVEL PULLOUT WITH 1/2" TYPE IVS. ANY REQUIRED EXCAVATION SHALL BE PERFORMED AS DIRECTED BY THE RESIDENT ENGINEER AND PAID FOR UNDER ITEM 608.25 ALL PURPOSE EXCAVATOR RENTAL, TYPE I.

SIGN LEGEND
 R = REMOVE
 S = SALVAGE
 N = NEW
 RET = RETAIN
 B-B = BACK TO BACK
 EXISTING = - - - - -
 NEW = _____

NOT TO SCALE

PROJECT LAYOUT SHEET #1	PROJECT NAME: RIPTON - HANCOCK	PLOT DATE: 19-SEP-2013 11:15
	PROJECT NUMBER: STP 2803(1)	DRAWN BY: C.A.K.
	FILE NAME: p08cl60.dgn	CHECKED BY: D.W.E.
	DESIGNED BY: M.J.M.	SHEET 60 OF 114

AREA TO BE RECLAIMED