


646.402 DURABLE 4 INCH YELLOW LINE, THERMOPLASTIC  
 (ALL LINES WILL INCLUDE EDGE LINE BREAKS AND RADIUS FOR TOWN HIGHWAYS)  
 RIPTON:  
 STA 11+00.00 - STA 24+00.00 EDGE LINE LT & RT

646.412 DURABLE 4 INCH YELLOW LINE, THERMOPLASTIC  
 (ALL LINES WILL INCLUDE C/L BREAKS FOR TOWN HIGHWAYS) S=SOLID, D=DASHED  
 RIPTON:  
 STA 11+00.00 - STA 24+00.00 LT CL RT  
 S - S

646.602 TEMPORARY 4 INCH WHITE LINE, PAINT  
 (ALL LINES WILL INCLUDE EDGE LINE BREAKS AND RADIUS FOR TOWN HIGHWAYS)  
 RIPTON:  
 STA 11+00.00 - STA 24+00.00 EDGE LINE LT & RT

646.612 TEMPORARY 4 INCH YELLOW LINE, PAINT  
 (ALL LINES WILL INCLUDE C/L BREAKS FOR TOWN HIGHWAYS) S=SOLID, D=DASHED  
 RIPTON:  
 STA 11+00.00 - STA 24+00.00 LT CL RT  
 S - S

675.50 REMOVING SIGNS  
 AS SHOWN - 7

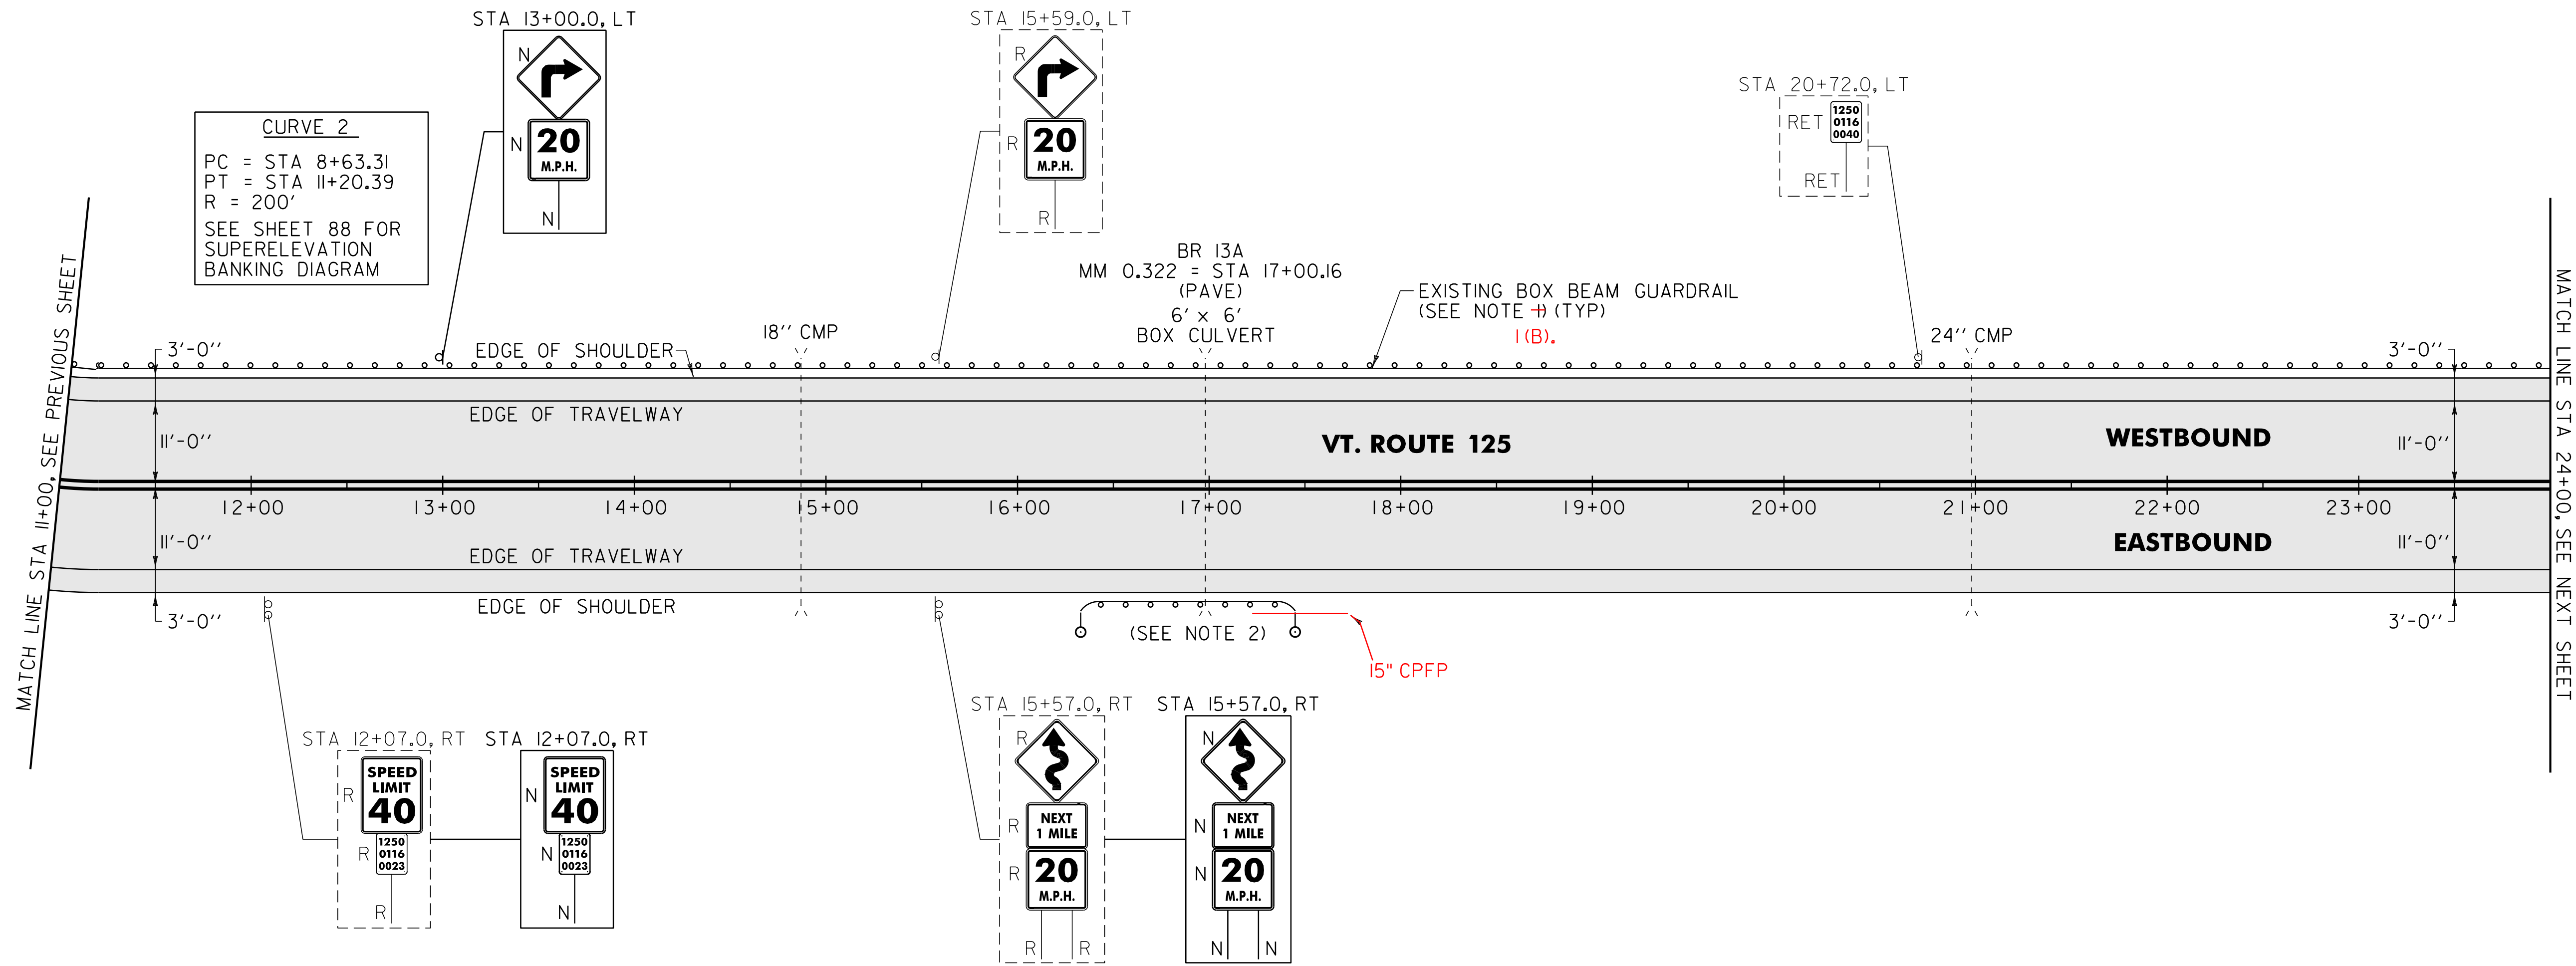

676.10 DELINEATOR WITH STEEL POSTS  
 TYPE I WHITE  
 RIPTON:  
 STA 16+35.5 RT  
 STA 17+48.0 RT

ITEM 621.60 ANCHOR FOR STEEL BEAM RAIL

~~900.620 SPECIAL PROVISION (MANUFACTURED TERMINAL SECTION, FLARED/WEATHERING)~~  
 RIPTON:  
 STA 16+35.5 - STA 16+73.0 RT  
 STA 17+10.5 - STA 17+48.0 RT

~~900.640 SPECIAL PROVISION (STEEL BEAM GUARDRAIL, WEATHERING)~~  
 RIPTON:  
 STA 16+73.0 - STA 16+85.5 RT (12.5 LF)

900.640 SPECIAL PROVISION (HD STEEL BEAM GUARDRAIL, WEATHERING/NESTED)  
 RIPTON:  
 STA 16+85.5 - STA 17+10.5 RT (25.0 LF)

(B). REFERENCE SHEET 31 OF 114 NOTE (B).  
 STA 11+00 TO 24+00 LT

NOTES:

- THE CONTRACTOR SHALL REPAIR AND/OR MAKE HEIGHT ALTERATIONS PER SUBSECTION 621.13 OF THE STANDARD SPECIFICATIONS AS DIRECTED BY THE RESIDENT ENGINEER BETWEEN RIPTON STA 11+00 AND STA 24+00 LT. ALL WORK SHALL BE PAID FOR UNDER ITEM 900.640 SPECIAL PROVISION (BOX BEAM GUARDRAIL REPAIRS, WEATHERING). AN ESTIMATED QUANTITY FOR THIS ITEM HAS BEEN INCLUDED IN THE PLAN SET. SEE SHEET 9 FOR AVAILABLE BOX BEAM GUARDRAIL INVENTORY.
- SEE SHEET 114 FOR NESTED GUARDRAIL DETAIL.

SIGN LEGEND  
 R = REMOVE  
 S = SALVAGE  
 N = NEW  
 RET = RETAIN  
 B-B = BACK TO BACK  
 EXISTING = -----  
 NEW = \_\_\_\_\_

NOT TO SCALE

<b>PROJECT LAYOUT SHEET #2</b>	PROJECT NAME: RIPTON - HANCOCK	FILE NAME: p08c160.dgn	PLOT DATE: 19-SEP-2013 11:15
	PROJECT NUMBER: STP 2803(1)	PROJECT LEADER: D.E.G.	DRAWN BY: C.A.K.
		DESIGNED BY: M.J.M.	CHECKED BY: D.W.E.
		IPARM FILE: p08c160I02.i	SHEET 61 OF 114

AREA TO BE RECLAIMED