


646.402 DURABLE 4 INCH WHITE LINE, THERMOPLASTIC
 (ALL LINES WILL INCLUDE EDGE LINE BREAKS AND RADIUS FOR TOWN HIGHWAYS)
 RIPTON:
 STA 115+00.00 - STA 128+00.00 EDGE LINE LT & RT
 646.412 DURABLE 4 INCH YELLOW LINE, THERMOPLASTIC
 (ALL LINES WILL INCLUDE C/L BREAKS FOR TOWN HIGHWAYS) S=SOLID, D=DASHED
 RIPTON:
 STA 115+00.00 - STA 128+00.00 LT C RT S - S
 STA 116+37.12 DOUBLE SOLID RT, TH-18

646.602 TEMPORARY 4 INCH WHITE LINE, PAINT
 (ALL LINES WILL INCLUDE EDGE LINE BREAKS AND RADIUS FOR TOWN HIGHWAYS)
 RIPTON:
 STA 115+00.00 - STA 128+00.00 EDGE LINE LT & RT
 646.612 TEMPORARY 4 INCH YELLOW LINE, PAINT
 (ALL LINES WILL INCLUDE C/L BREAKS FOR TOWN HIGHWAYS) S=SOLID, D=DASHED
 RIPTON:
 STA 115+00.00 - STA 128+00.00 LT C RT S - S
 STA 116+37.12 DOUBLE SOLID RT, TH-18

646.482 DURABLE 24 INCH STOP BAR, THERMOPLASTIC
 RIPTON:
 STA 116+37.12 RT, TH-18
 646.492 DURABLE LETTER OR SYMBOL, THERMOPLASTIC
 RIPTON:
 STA 116+37.12 RT, TH-18 "S,T,O,P" (4 EA)

646.682 TEMPORARY 24 INCH STOP BAR, PAINT
 RIPTON:
 STA 116+37.12 RT, TH-18
 646.692 TEMPORARY LETTER OR SYMBOL, PAINT
 RIPTON:
 STA 116+37.12 RT, TH-18 "S,T,O,P" (4 EA)

675.50 REMOVING SIGNS AS SHOWN - 16
 675.60 ERECTING SALVAGED SIGNS AS SHOWN - 3

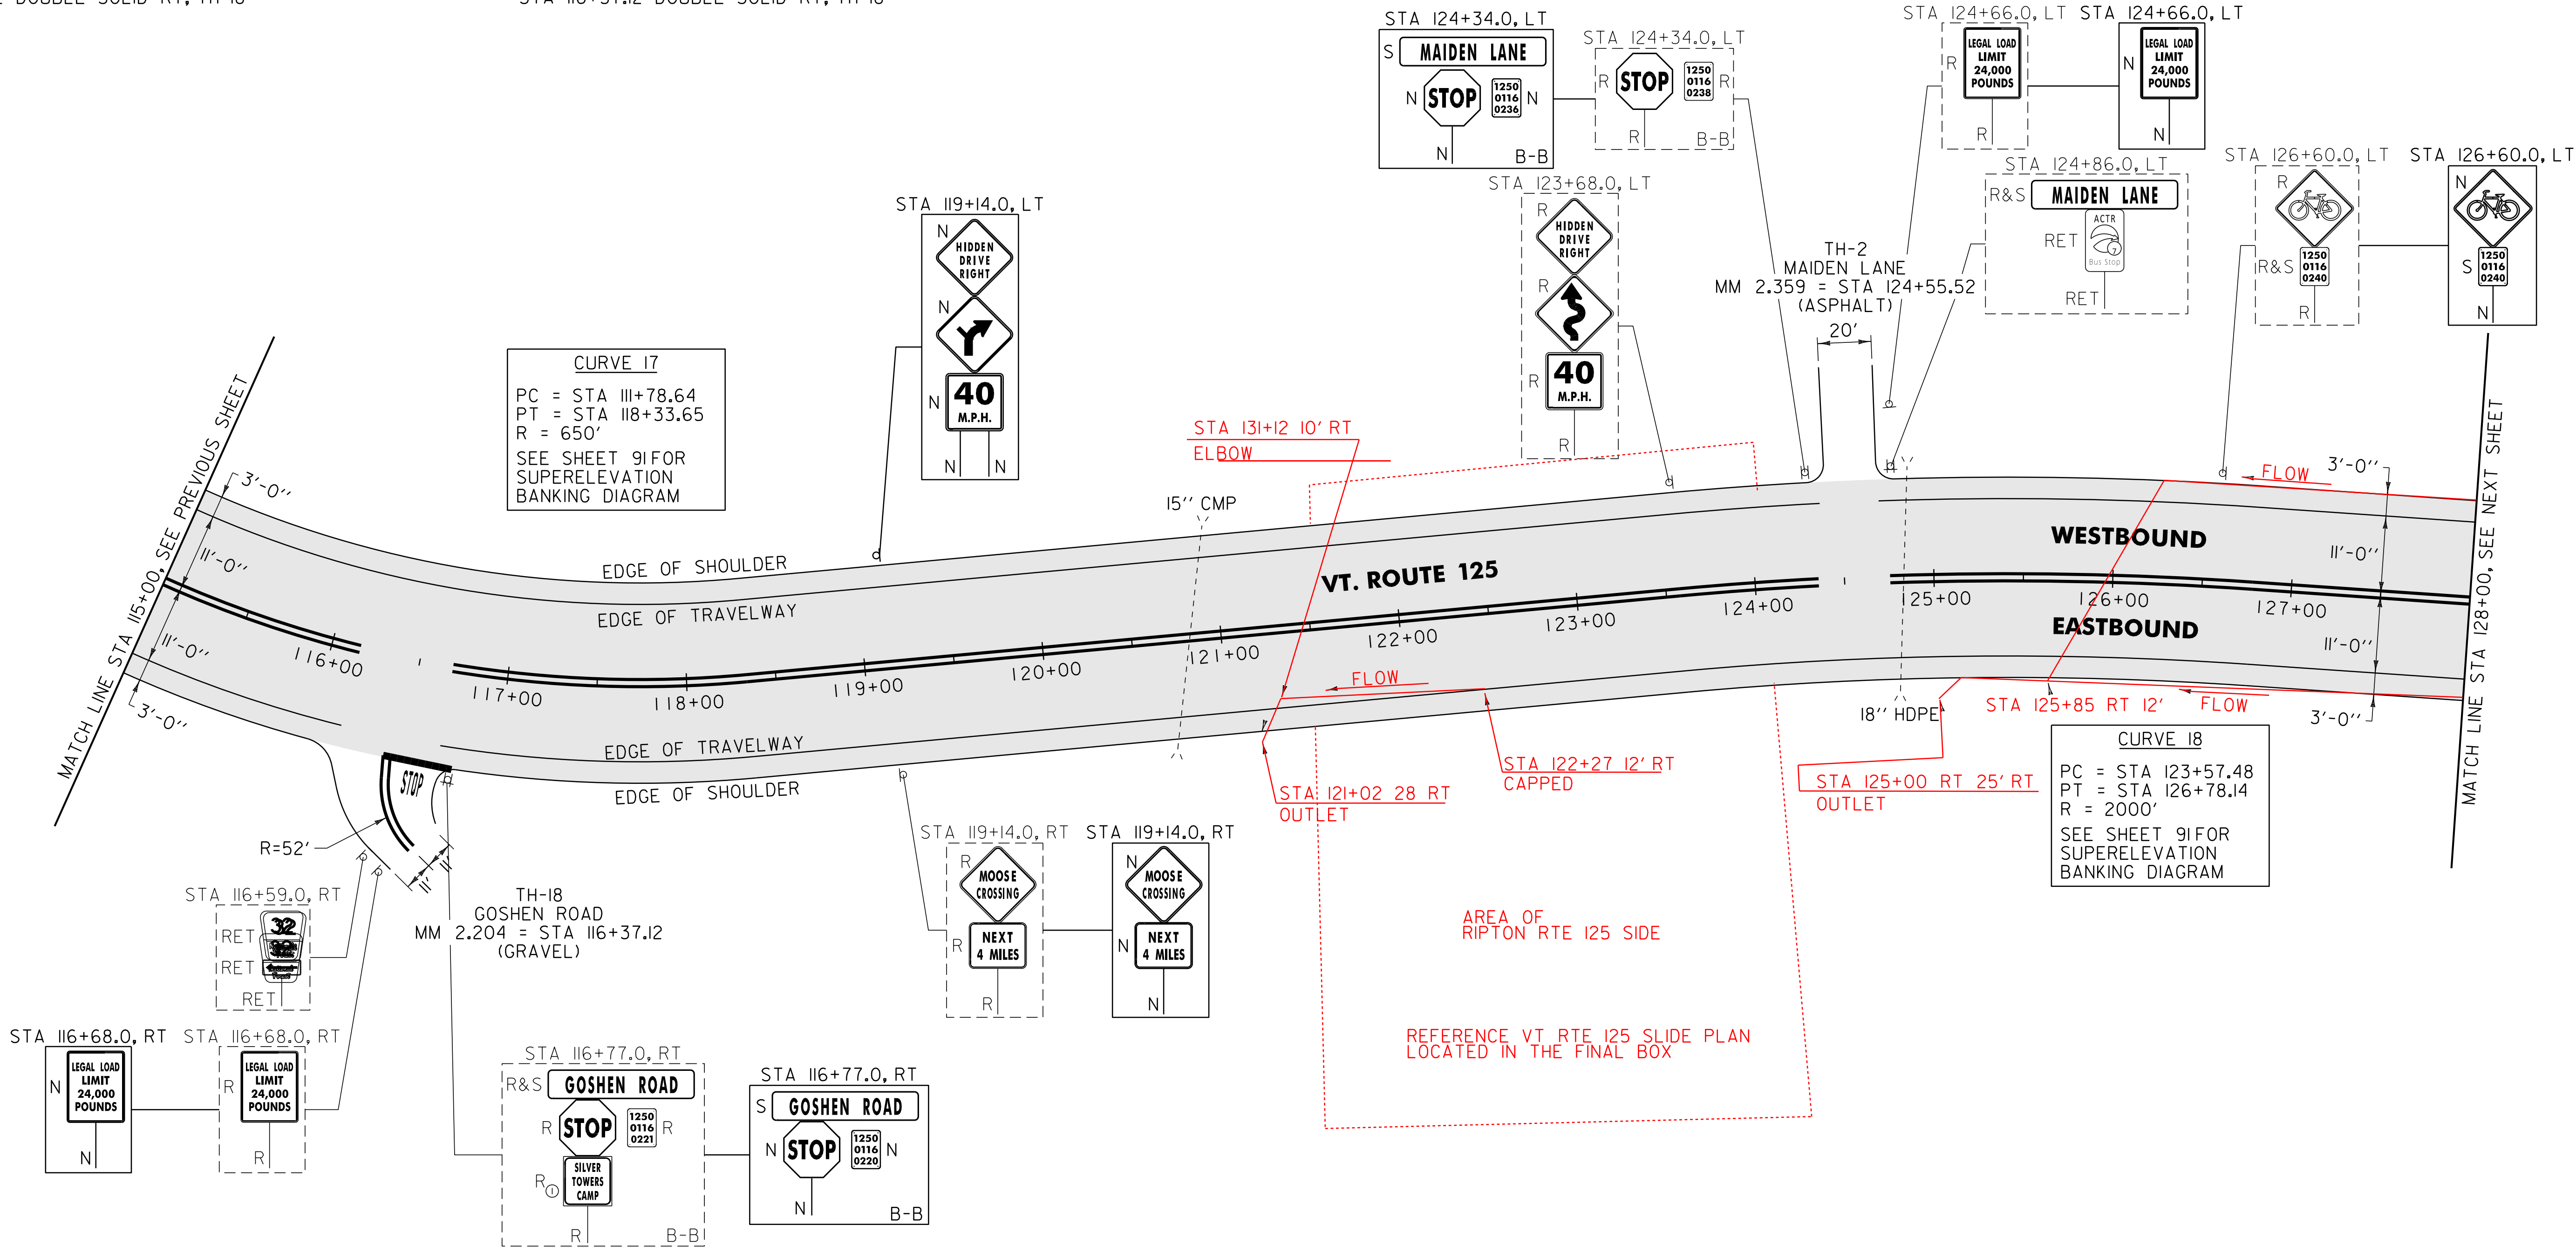

CURVE 17
 PC = STA 111+78.64
 PT = STA 118+33.65
 R = 650'
 SEE SHEET 91 FOR SUPERELEVATION BANKING DIAGRAM

CURVE 18
 PC = STA 123+57.48
 PT = STA 126+78.14
 R = 2000'
 SEE SHEET 91 FOR SUPERELEVATION BANKING DIAGRAM

NOTE:
 1. PAVING LIMIT ON ALL TOWN HIGHWAYS SHALL BE MEASURED 25 FT BACK FROM VT. ROUTE 125 EDGE OF SHOULDER UNLESS DENOTED OTHERWISE ON THE PLANS OR AS DIRECTED BY THE RESIDENT ENGINEER.

SIGN LEGEND
 R = REMOVE
 S = SALVAGE
 N = NEW
 RET = RETAIN
 B-B = BACK TO BACK
 EXISTING = _____
 NEW = _____
 R⊙ = RETURN TO THE TOWN OF RIPTON

NOT TO SCALE

PROJECT LAYOUT SHEET #10

PROJECT NAME: RIPTON - HANCOCK	FILE NAME: p08cl60.dgn	PLOT DATE: 19-SEP-2013 11:15
PROJECT NUMBER: STP 2803(1)	PROJECT LEADER: D.E.G.	DRAWN BY: C.A.K.
	DESIGNED BY: M.J.M.	CHECKED BY: D.W.E.
	IPARM FILE: p08cl60110.i	SHEET 69 OF 114

AREA TO BE RECLAIMED