


646.402 DURABLE 4 INCH WHITE LINE, THERMOPLASTIC
 (ALL LINES WILL INCLUDE EDGE LINE BREAKS AND RADIUS FOR TOWN HIGHWAYS)
 RIPTON:
 STA 128+00.00 - STA 141+00.00 EDGE LINE LT & RT
 646.412 DURABLE 4 INCH YELLOW LINE, THERMOPLASTIC
 (ALL LINES WILL INCLUDE C/L BREAKS FOR TOWN HIGHWAYS) S=SOLID, D=DASHED
 RIPTON: LT C RT
 STA 128+00.00 - STA 141+00.00 S - S

646.602 TEMPORARY 4 INCH WHITE LINE, PAINT
 (ALL LINES WILL INCLUDE EDGE LINE BREAKS AND RADIUS FOR TOWN HIGHWAYS)
 RIPTON:
 STA 128+00.00 - STA 141+00.00 EDGE LINE LT & RT
 646.612 TEMPORARY 4 INCH YELLOW LINE, PAINT
 (ALL LINES WILL INCLUDE C/L BREAKS FOR TOWN HIGHWAYS) S=SOLID, D=DASHED
 RIPTON: LT C RT
 STA 128+00.00 - STA 141+00.00 S - S

675.50 REMOVING SIGNS AS SHOWN - 2

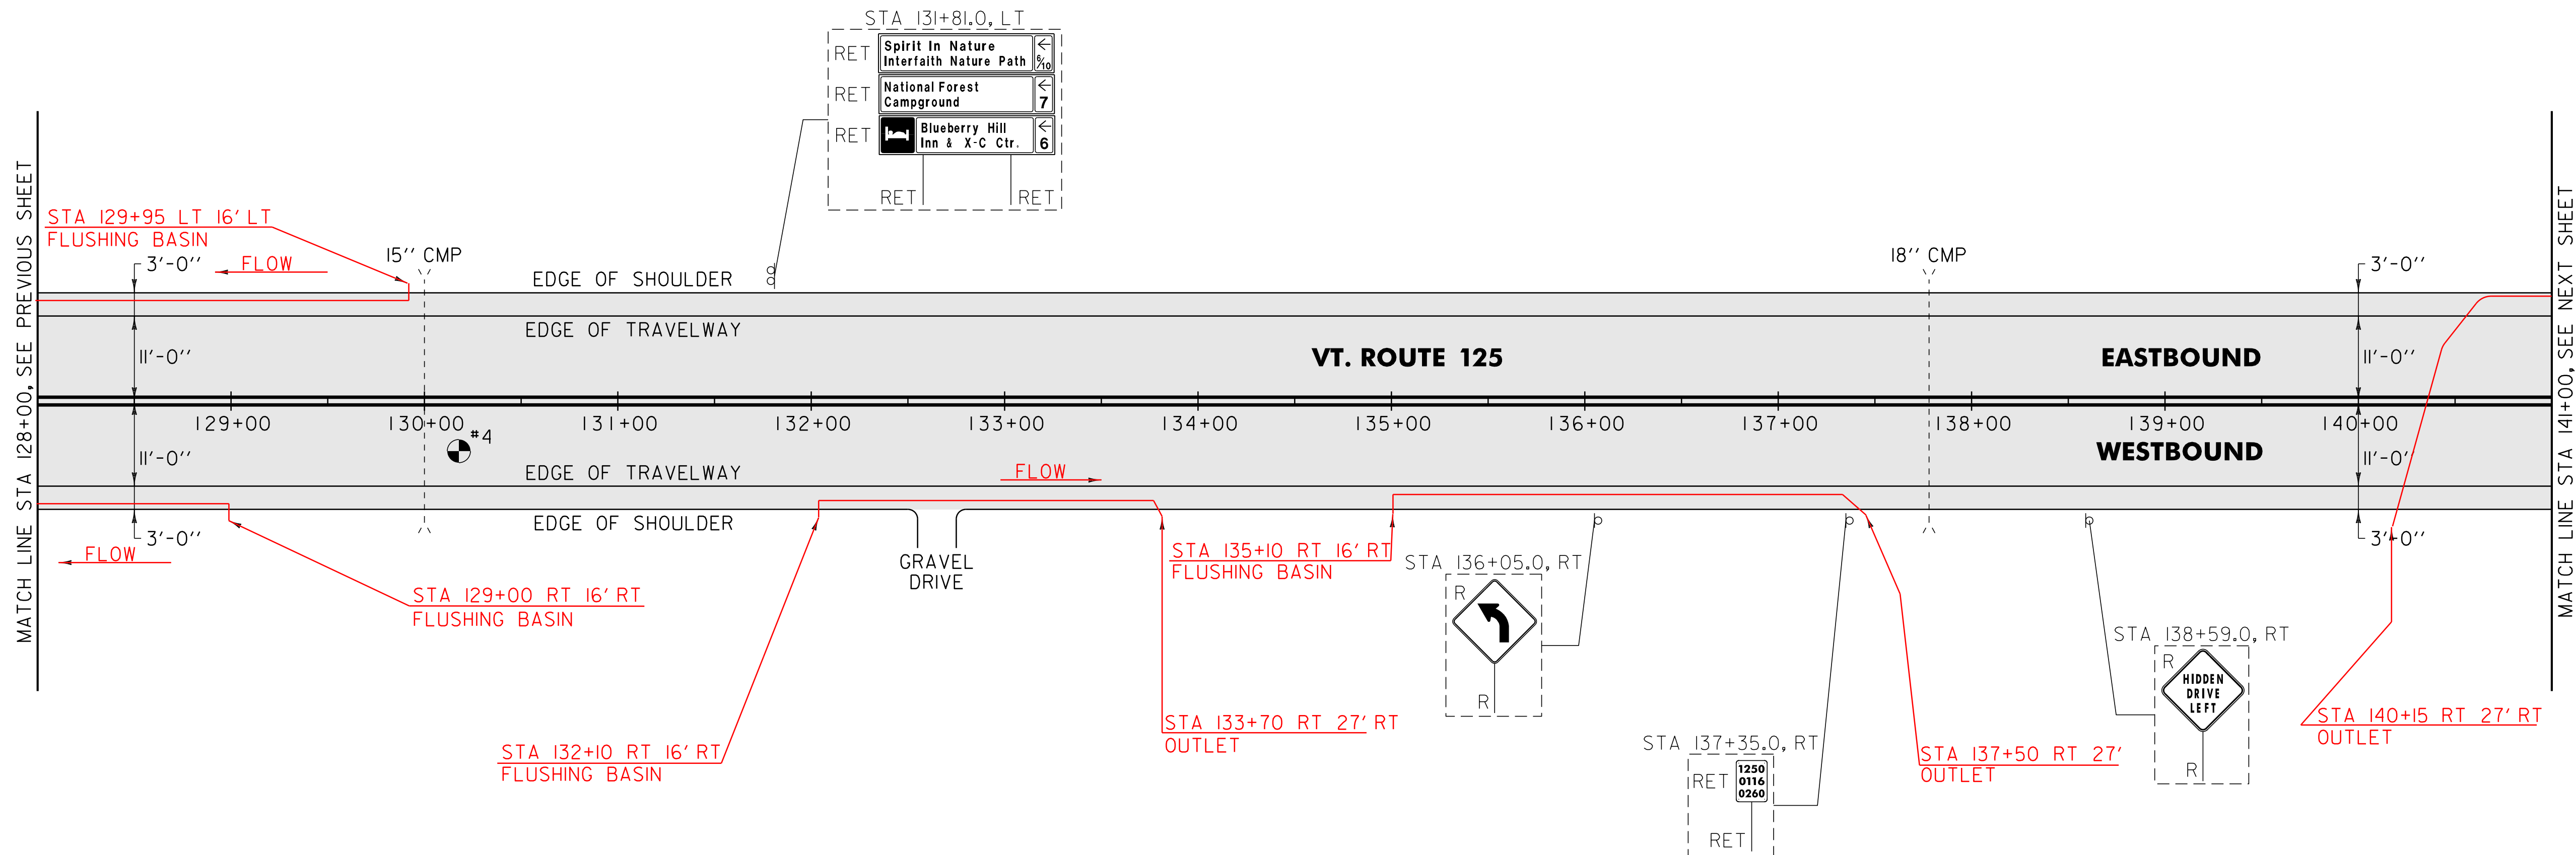

MATCH LINE STA 128+00, SEE PREVIOUS SHEET

MATCH LINE STA 141+00, SEE NEXT SHEET

PAVEMENT CORES = ●

#	TOTAL PCC COMMENTS DEPTH (INCH)
4	9" NO

SIGN LEGEND
 R = REMOVE
 S = SALVAGE
 N = NEW
 RET = RETAIN
 B-B = BACK TO BACK
 EXISTING = - - - - -
 NEW = _____

NOT TO SCALE

PROJECT LAYOUT SHEET #11	PROJECT NAME: RIPTON - HANCOCK	PLOT DATE: 19-SEP-2013 11:15
	PROJECT NUMBER: STP 2803(1)	DRAWN BY: C.A.K.
	FILE NAME: p08c160.dgn	CHECKED BY: D.W.E.
	DESIGNED BY: M.J.M.	SHEET 70 OF 114
	IPARM FILE: p08c160i11.i	

AREA TO BE RECLAIMED