


646.402 DURABLE 4 INCH WHITE LINE, THERMOPLASTIC
 (ALL LINES WILL INCLUDE EDGE LINE BREAKS AND RADIUS FOR TOWN HIGHWAYS)
 RIPTON:
 STA 154+00.00 - STA 167+00.00 EDGE LINE LT & RT

646.412 DURABLE 4 INCH YELLOW LINE, THERMOPLASTIC
 (ALL LINES WILL INCLUDE C/L BREAKS FOR TOWN HIGHWAYS) S=SOLID, D=DASHED
 RIPTON:
 STA 154+00.00 - STA 160+78.00 S - S
 STA 160+78.00 - STA 167+00.00 S - D

646.602 TEMPORARY 4 INCH WHITE LINE, PAINT
 (ALL LINES WILL INCLUDE EDGE LINE BREAKS AND RADIUS FOR TOWN HIGHWAYS)
 RIPTON:
 STA 154+00.00 - STA 167+00.00 EDGE LINE LT & RT

646.612 TEMPORARY 4 INCH YELLOW LINE, PAINT
 (ALL LINES WILL INCLUDE C/L BREAKS FOR TOWN HIGHWAYS) S=SOLID, D=DASHED
 RIPTON:
 STA 154+00.00 - STA 160+78.00 S - S
 STA 160+78.00 - STA 167+00.00 S - D

675.50 REMOVING SIGNS
 AS SHOWN - 1

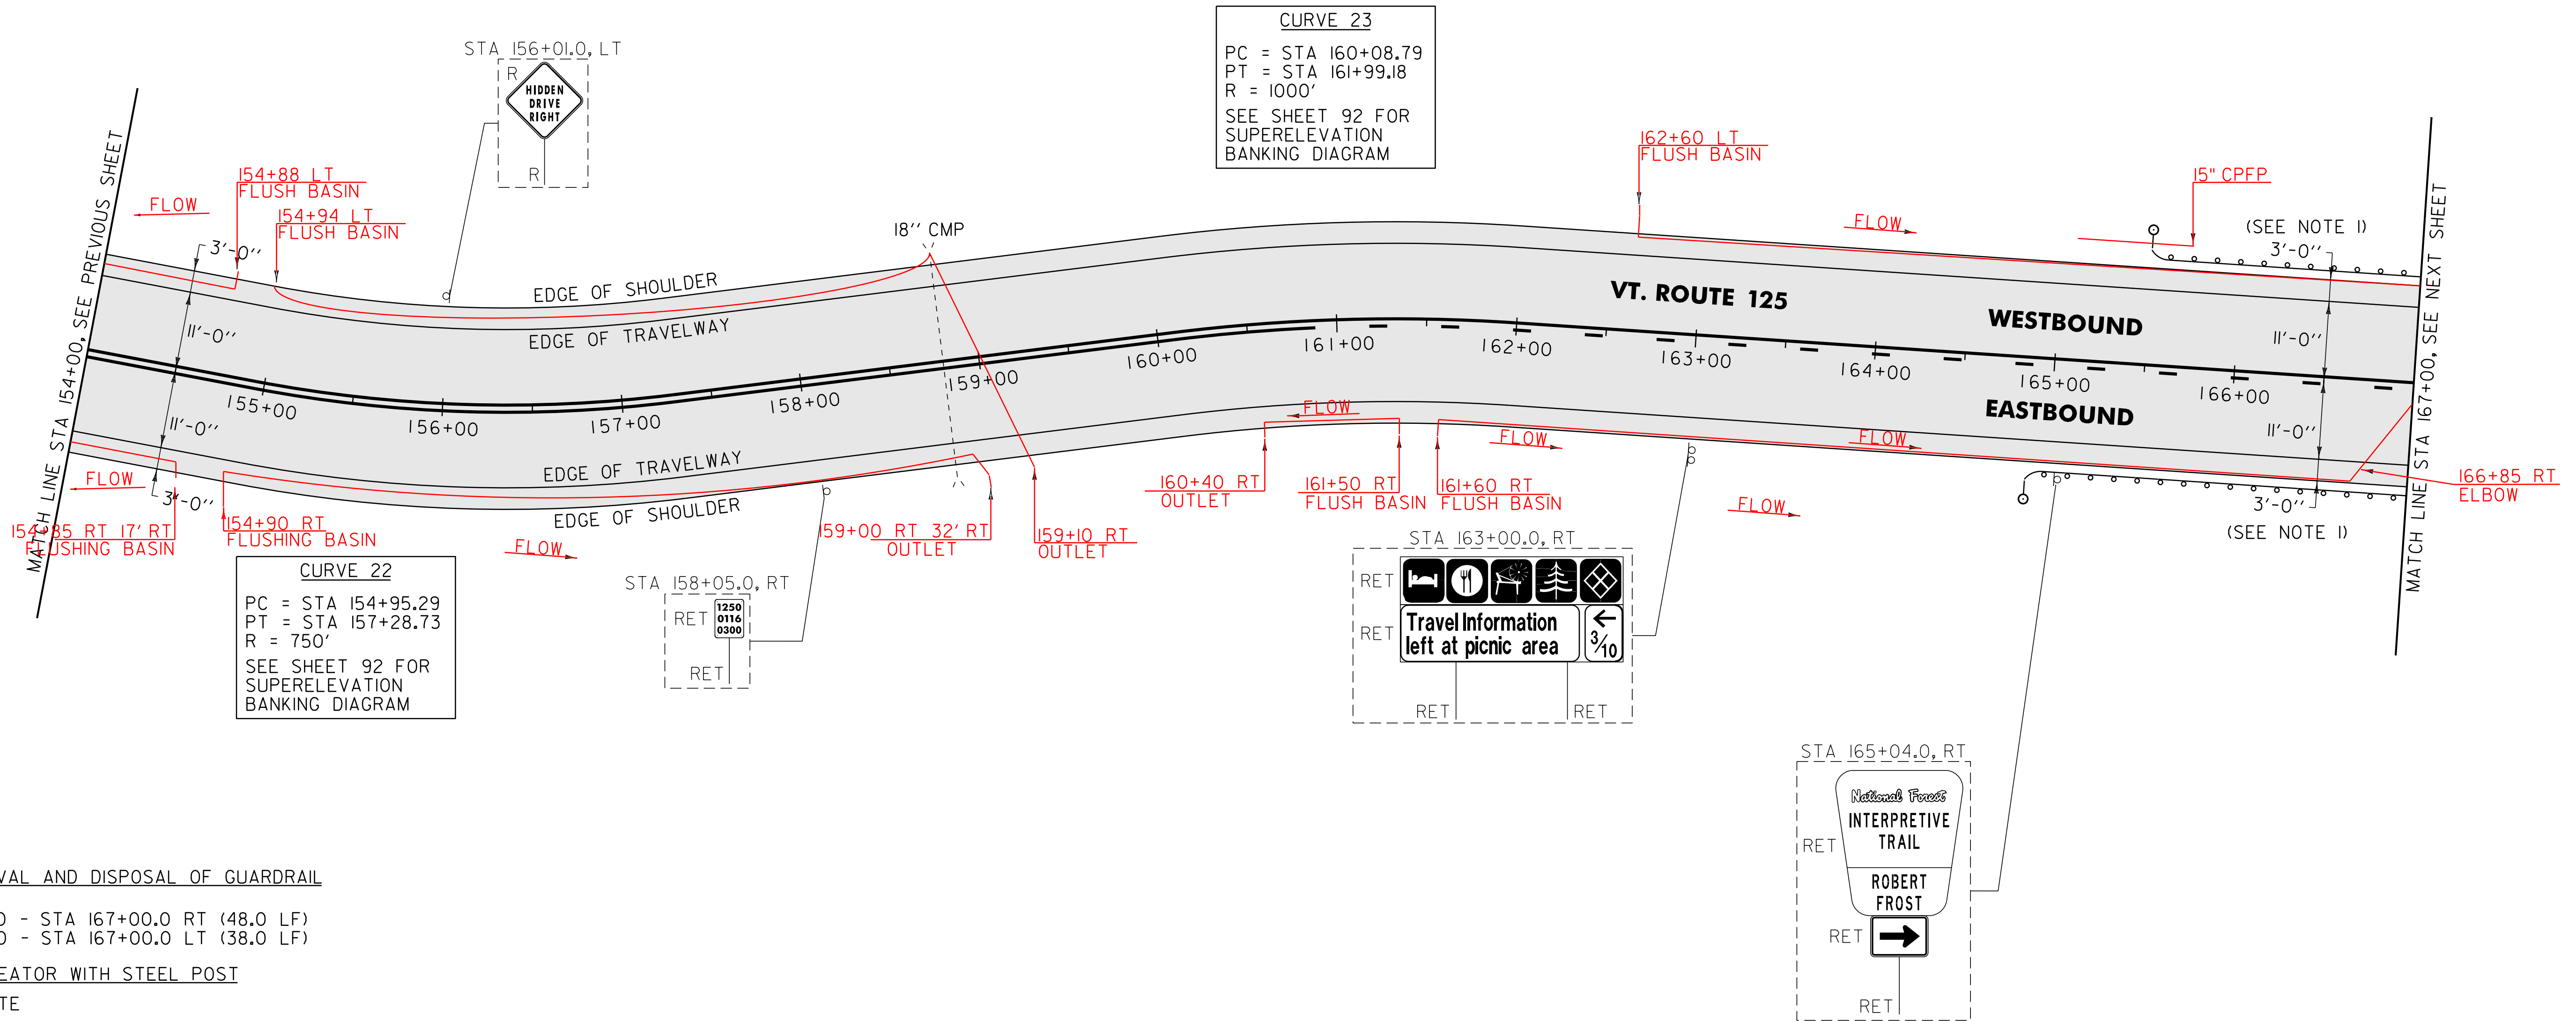

621.80 REMOVAL AND DISPOSAL OF GUARDRAIL
 RIPTON:
 STA 166+52.0 - STA 167+00.0 RT (48.0 LF)
 STA 166+62.0 - STA 167+00.0 LT (38.0 LF)

676.10 DELINEATOR WITH STEEL POST
 TYPE I WHITE
 RIPTON:
 STA 164+75.0 RT
 STA 165+50.0 LT

900.620 SPECIAL PROVISION (MANUFACTURED TERMINAL SECTION, FLARED/WEATHERING)
 RIPTON:
 STA 164+75.0 - STA 165+12.5 RT
 STA 165+50.0 - STA 165+87.5 LT

900.640 SPECIAL PROVISION (HD STEEL BEAM GUARDRAIL, WEATHERING/NESTED)
 RIPTON:
 STA 166+87.5 - STA 167+00.0 LT (12.5 LF)
 STA 166+87.5 - STA 167+00.0 RT (12.5 LF)

900.640 SPECIAL PROVISION (STEEL BEAM GUARDRAIL, WEATHERING)
 RIPTON:
 STA 165+12.5 - STA 166+87.5 RT (175.0 LF)
 STA 165+87.5 - STA 166+87.5 LT (100.0 LF)

NOTE:
 1. SEE SHEET 114 FOR STEEL BEAM GUARDRAIL AT SMALL CULVERT DETAIL.

SIGN LEGEND
 R = REMOVE
 S = SALVAGE
 N = NEW
 RET = RETAIN
 B-B = BACK TO BACK
 EXISTING = - - - - -
 NEW = _____

NOT TO SCALE

PROJECT LAYOUT SHEET #13

PROJECT NAME: RIPTON - HANCOCK
 PROJECT NUMBER: STP 2803(1)
 FILE NAME: p08cl60.dgn
 PROJECT LEADER: D.E.G.
 DESIGNED BY: M.J.M.
 IPARM FILE: p08cl60i13.i

PLOT DATE: 19-SEP-2013 11:15
 DRAWN BY: C.A.K.
 CHECKED BY: D.W.E.
 SHEET 72 OF 114

AREA TO BE RECLAIMED