


**646.402 DURABLE 4 INCH WHITE LINE, THERMOPLASTIC**  
 (ALL LINES WILL INCLUDE EDGE LINE BREAKS AND RADIUS FOR TOWN HIGHWAYS)  
 RIPTON:  
 STA 193+00.00 - STA 206+00.00 EDGE LINE LT & RT

**646.412 DURABLE 4 INCH YELLOW LINE, THERMOPLASTIC**  
 (ALL LINES WILL INCLUDE C/L BREAKS FOR TOWN HIGHWAYS) S=SOLID, D=DASHED  
 RIPTON:  
 STA 193+00.00 - STA 194+83.00 S - D  
 STA 194+83.00 - STA 195+89.00 - D -  
 STA 195+89.00 - STA 202+75.00 D - S  
 STA 202+75.00 - STA 206+00.00 S - S

**646.602 TEMPORARY 4 INCH WHITE LINE, PAINT**  
 (ALL LINES WILL INCLUDE EDGE LINE BREAKS AND RADIUS FOR TOWN HIGHWAYS)  
 RIPTON:  
 STA 193+00.00 - STA 206+00.00 EDGE LINE LT & RT

**646.612 TEMPORARY 4 INCH YELLOW LINE, PAINT**  
 (ALL LINES WILL INCLUDE C/L BREAKS FOR TOWN HIGHWAYS) S=SOLID, D=DASHED  
 RIPTON:  
 STA 193+00.00 - STA 194+83.00 S - D  
 STA 194+83.00 - STA 195+89.00 - D -  
 STA 195+89.00 - STA 202+75.00 D - S  
 STA 202+75.00 - STA 206+00.00 S - S

**675.50 REMOVING SIGNS**  
 AS SHOWN - 4

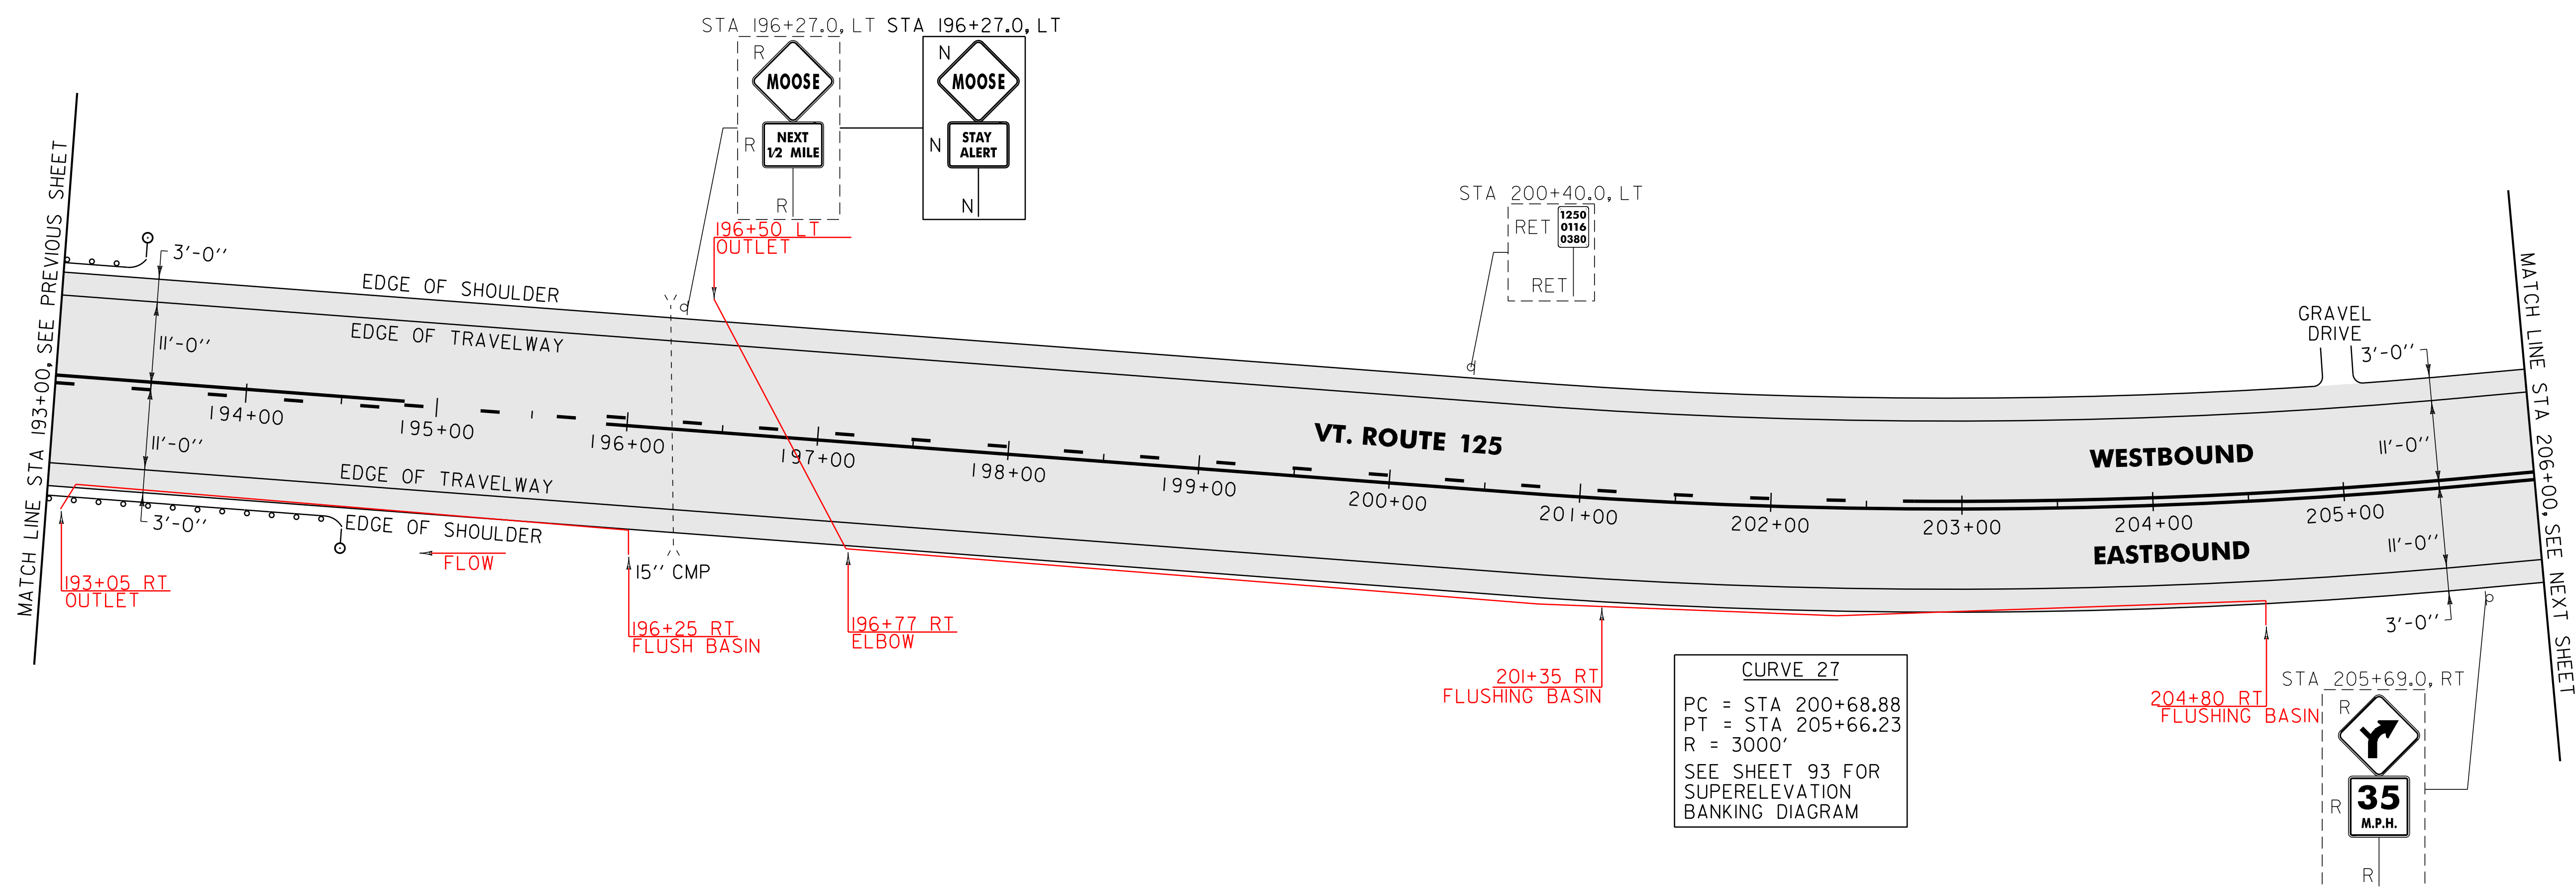

**621.80 REMOVAL AND DISPOSAL OF GUARDRAIL**  
 RIPTON:  
 STA 193+00.0 - STA 193+04.0 LT (4.0 LF)  
 STA 193+00.0 - STA 193+04.0 RT (4.0 LF)

**676.10 DELINEATOR WITH STEEL POST**  
 ♀ TYPE 1 WHITE  
 RIPTON:  
 STA 193+80.0 LT  
 STA 194+55.0 RT

**900.620 SPECIAL PROVISION (MANUFACTURED TERMINAL SECTION, FLARED/WEATHERING)**  
 RIPTON:  
 STA 193+42.5 - STA 193+80.0 LT  
 STA 194+17.5 - STA 194+55.0 RT

**900.640 SPECIAL PROVISION (STEEL BEAM GUARDRAIL, WEATHERING)**  
 RIPTON:  
 STA 193+00.0 - STA 194+17.5 RT (17.5 LF)  
 STA 193+00.0 - STA 193+42.5 LT (42.5 LF)

**SIGN LEGEND**  
 R = REMOVE  
 S = SALVAGE  
 N = NEW  
 RET = RETAIN  
 B-B = BACK TO BACK  
 EXISTING = - - - - -  
 NEW = \_\_\_\_\_

NOT TO SCALE

<b>PROJECT LAYOUT SHEET #16</b>	PROJECT NAME: RIPTON - HANCOCK	PLOT DATE: 19-SEP-2013 11:15 DRAWN BY: C.A.K. CHECKED BY: D.W.E. SHEET 75 OF 114
	PROJECT NUMBER: STP 2803(1)	
	FILE NAME: p08cl60.dgn	
	IPARM FILE: p08cl60i16.i	

AREA TO BE RECLAIMED