


646.402 DURABLE 4 INCH WHITE LINE, THERMOPLASTIC
 (ALL LINES WILL INCLUDE EDGE LINE BREAKS AND RADIUS FOR TOWN HIGHWAYS)
 RIPTON:
 STA 219+00.00 - STA 232+00.00 EDGE LINE LT & RT
 646.412 DURABLE 4 INCH YELLOW LINE, THERMOPLASTIC
 (ALL LINES WILL INCLUDE C/L BREAKS FOR TOWN HIGHWAYS) S=SOLID, D=DASHED
 RIPTON:
 STA 219+00.00 - STA 232+00.00 LT C RT S - S

646.602 TEMPORARY 4 INCH WHITE LINE, PAINT
 (ALL LINES WILL INCLUDE EDGE LINE BREAKS AND RADIUS FOR TOWN HIGHWAYS)
 RIPTON:
 STA 219+00.00 - STA 232+00.00 EDGE LINE LT & RT
 646.612 TEMPORARY 4 INCH YELLOW LINE, PAINT
 (ALL LINES WILL INCLUDE C/L BREAKS FOR TOWN HIGHWAYS) S=SOLID, D=DASHED
 RIPTON:
 STA 219+00.00 - STA 232+00.00 LT C RT S - S
 616.28 CAST-IN PLACE CONCRETE CURB TYPE B
 223+21.00 - 225+71.00 LT 250 LF
 225+93.00 - 229+93 LT 400 LF

646.442 DURABLE 8 INCH WHITE LINE, THERMOPLASTIC
 RIPTON:
 STA 228+54.0 - STA 228+66.0 FIRE HYDRANT, NO PARKING, RT

675.50 REMOVING SIGNS
 AS SHOWN - 3

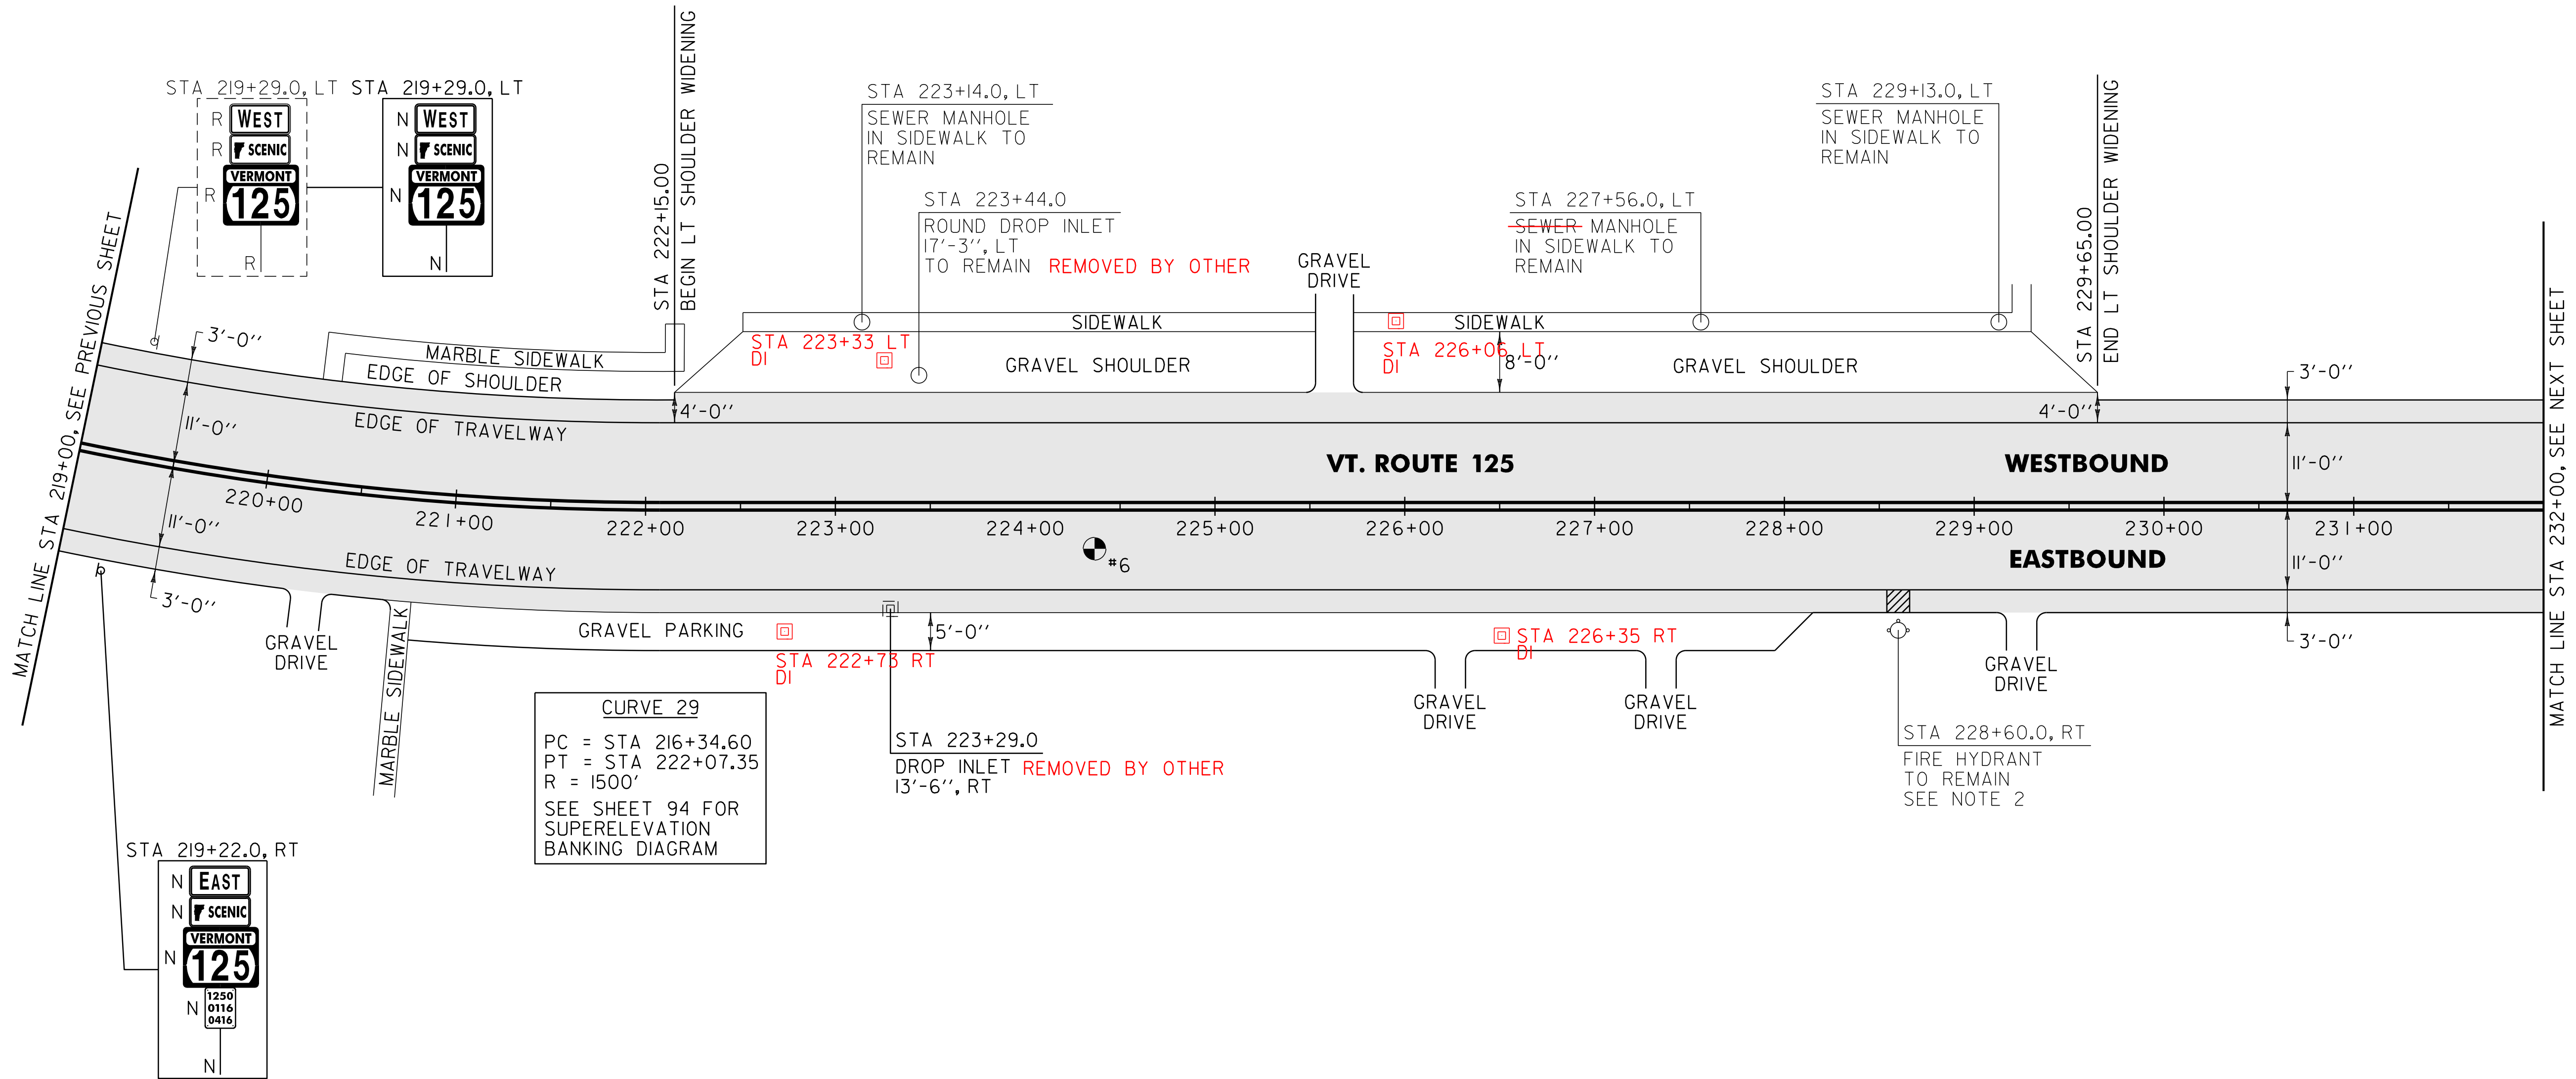

- NOTES:
- SEE SHEET 9 FOR FIRE HYDRANT PAVEMENT MARKING DETAIL.
 - THE CONTRACTOR SHALL REHAB. THE EXISTING DROP INLETS, CATCH BASINS OR MANHOLES TO A DEPTH AS DIRECTED BY THE RESIDENT ENGINEER. ALL REHAB. WORK WILL BE PAID FOR UNDER THE APPLICABLE REHAB. ITEM AS DIRECTED BY THE RESIDENT ENGINEER. ALL EXISTING UTILITIES MARKED "TO REMAIN" SHALL NOT BE ALTERED OR REHABILITATED UNLESS DIRECTED OTHERWISE BY THE RESIDENT ENGINEER.

604.412, 604.415, 604.418 REHAB. DROP INLETS, CATCH BASINS, OR MANHOLES, CLASS I, II, III (SEE NOTE 2)
 RIPTON: STA 222+73 RT
 STA 223+29.0 RT STA 223+33 LT
 STA 226+06 LT

PAVEMENT CORES =
 * TOTAL PCC COMMENTS
 DEPTH (INCH)
 6 3 1/2" NO

AREA TO BE RECLAIMED

SIGN LEGEND
 R = REMOVE
 S = SALVAGE
 N = NEW
 RET = RETAIN
 B-B = BACK TO BACK
 EXISTING = - - - - -
 NEW = _____

NOT TO SCALE

PROJECT LAYOUT SHEET #18

PROJECT NAME: RIPTON - HANCOCK	PLOT DATE: 19-SEP-2013 11:15
PROJECT NUMBER: STP 2803(1)	DRAWN BY: C.A.K.
FILE NAME: p08cl60.dgn	CHECKED BY: D.W.E.
PROJECT LEADER: D.E.G.	SHEET 77 OF 114
DESIGNED BY: M.J.M.	
IPARM FILE: p08cl60i18.i	