


646.402 DURABLE 4 INCH WHITE LINE, THERMOPLASTIC
(ALL LINES WILL INCLUDE EDGE LINE BREAKS AND RADIUS FOR TOWN HIGHWAYS)
RIPTON:
STA 258+00.00 - STA 271+00 EDGE LINE LT & RT

646.412 DURABLE 4 INCH YELLOW LINE, THERMOPLASTIC
(ALL LINES WILL INCLUDE C/L BREAKS FOR TOWN HIGHWAYS) S=SOLID, D=DASHED
RIPTON:
STA 258+00.00 - STA 260+57.00 S - S
STA 260+57.00 - STA 268+22.00 S - D
STA 268+22.00 - STA 269+28.00 - D -
STA 269+28.00 - STA 271+00.00 D - S

646.602 TEMPORARY 4 INCH WHITE LINE, PAINT
(ALL LINES WILL INCLUDE EDGE LINE BREAKS AND RADIUS FOR TOWN HIGHWAYS)
RIPTON:
STA 258+00.00 - STA 271+00 EDGE LINE LT & RT

646.612 TEMPORARY 4 INCH YELLOW LINE, PAINT
(ALL LINES WILL INCLUDE C/L BREAKS FOR TOWN HIGHWAYS) S=SOLID, D=DASHED
RIPTON:
STA 258+00.00 - STA 260+57.00 S - S
STA 260+57.00 - STA 268+22.00 S - D
STA 268+22.00 - STA 269+28.00 - D -
STA 269+28.00 - STA 271+00.00 D - S

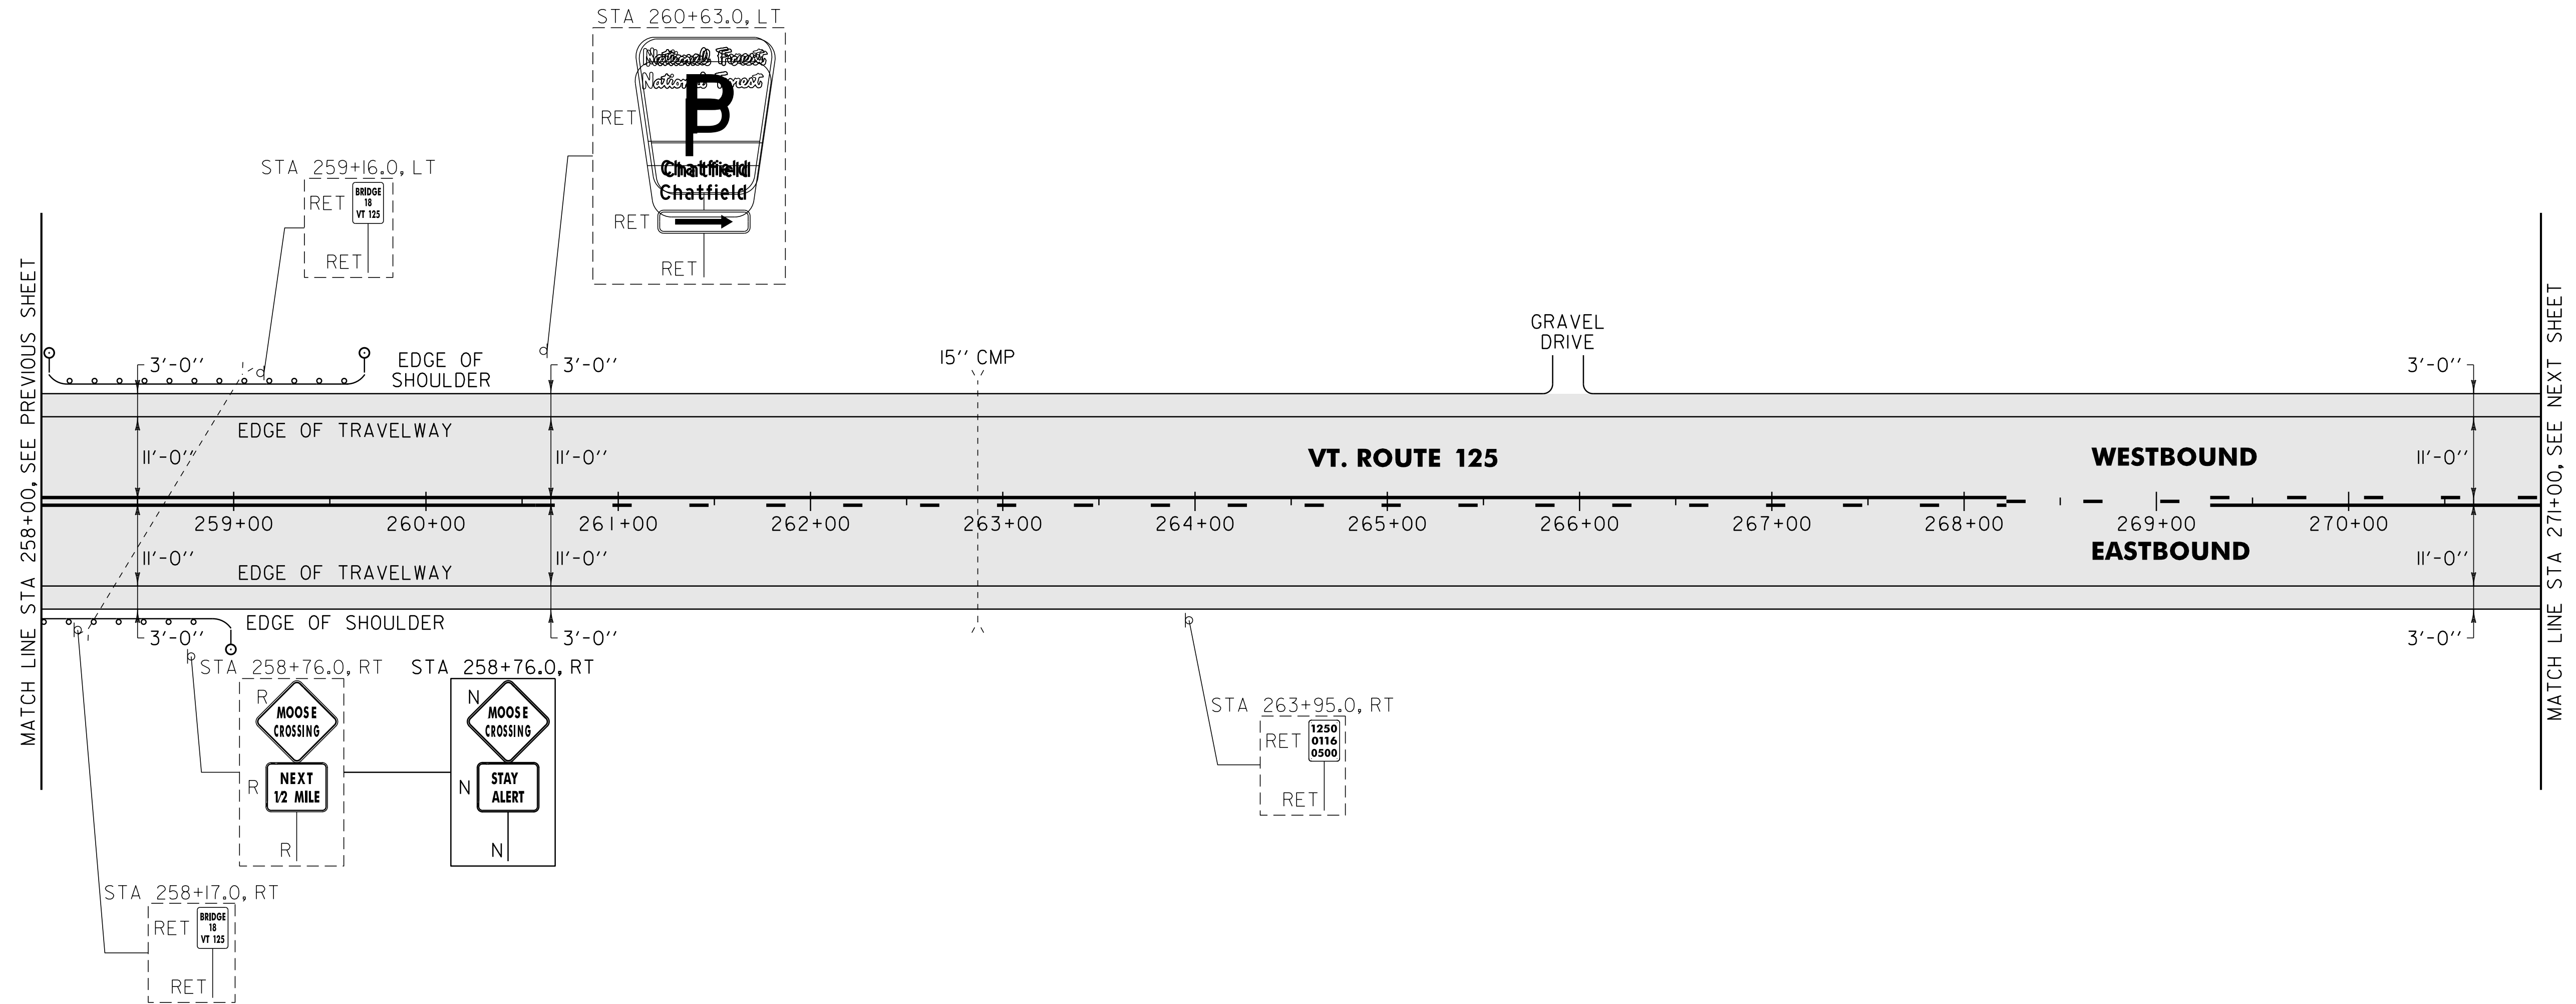

621.80 REMOVAL AND DISPOSAL OF GUARDRAIL
RIPTON:
STA 258+00.0 - STA 258+96.0 RT (96.0 LF)
STA 258+01.0 - STA 259+68.0 LT (167.0 LF)

676.10 DELINEATOR WITH STEEL POST
♀ TYPE 1 WHITE
RIPTON:
STA 258+01.0 LT
STA 258+99.5 RT
STA 259+76.0 LT

900.620 SPECIAL PROVISION (MANUFACTURED TERMINAL SECTION, FLARED/WEATHERING)
RIPTON:
~~STA 258+01.0 - STA 258+38.5 LT~~ TERMINAL SECTION, TANGENT
STA 258+62.0 - STA 258+99.5 RT STA 258+01.0 TO STA 258+38.5 LT
STA 259+38.5 - STA 259+76.0 LT

900.640 SPECIAL PROVISION (STEEL BEAM GUARDRAIL, WEATHERING)
RIPTON:
STA 258+00.0 - STA 258+62.0 RT (62.0 LF)
STA 258+38.5 - STA 259+38.5 LT (100.0 LF)

SIGN LEGEND
R = REMOVE
S = SALVAGE
N = NEW
RET = RETAIN
B-B = BACK TO BACK
EXISTING = - - - - -
NEW = _____

NOT TO SCALE

PROJECT LAYOUT SHEET #21	PROJECT NAME: RIPTON - HANCOCK	PLOT DATE: 19-SEP-2013 11:15
	PROJECT NUMBER: STP 2803(1)	DRAWN BY: C.A.K.
	FILE NAME: p08cl60.dgn	CHECKED BY: D.W.E.
	DESIGNED BY: M.J.M.	SHEET 80 OF 114

AREA TO BE RECLAIMED