


**BEGIN PROJECT
LOCATION TIES
VT. ROUTE 30**

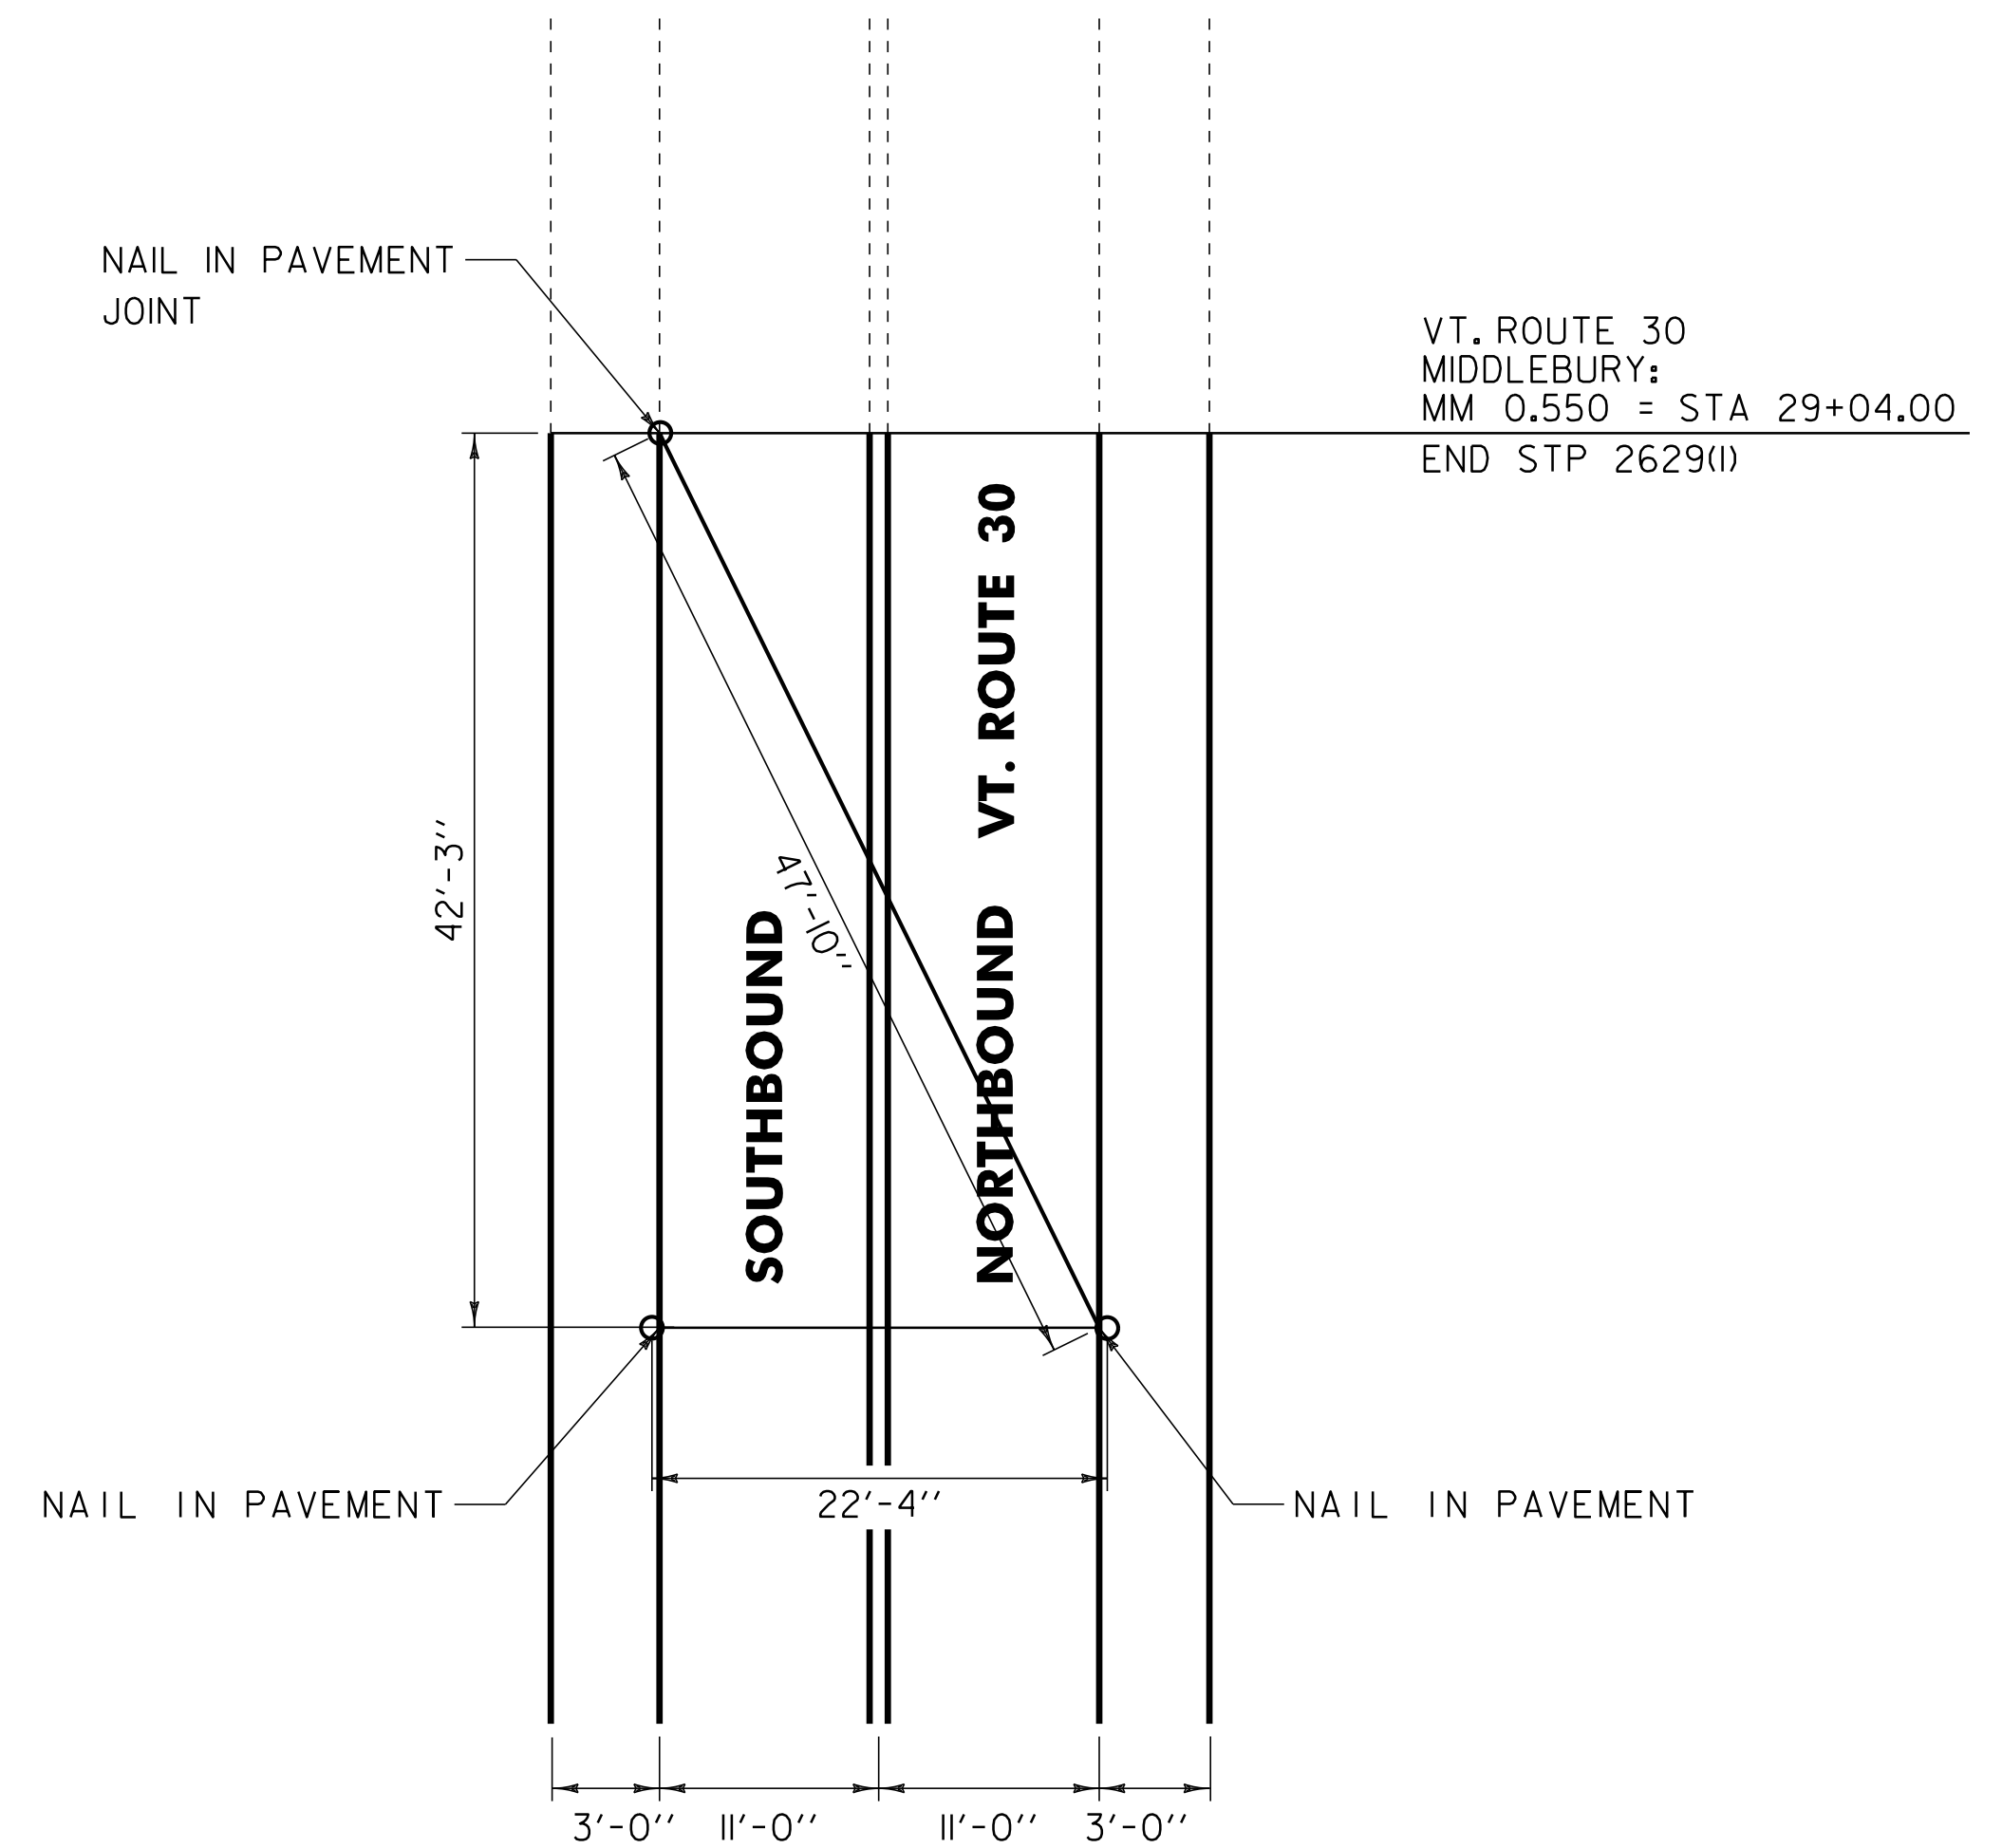

**END PROJECT
LOCATION TIES
VT. ROUTE 30**

NOT TO SCALE

PROJECT TIE SHEET	PROJECT NAME: WHITING - MIDDLEBURY	
	PROJECT NUMBER: STP 2629(1)	
	FILE NAME: p06c226.dgn	PLOT DATE: 30-MAR-2012 14:3
	PROJECT LEADER: D.E.G.	DRAWN BY: C.A.K.
DESIGNED BY: M.J.L.	CHECKED BY: D.E.G.	
DWG. NO. p06c226tie.i	SHEET 11	OF 133