


646.406 DURABLE 4 INCH WHITE LINE, RECESSED POLYUREA  
 (ALL LINES WILL INCLUDE EDGE LINE BREAKS AND  
 RADIUS FOR TOWN HIGHWAYS)  
 WHITING:  
 STA 147+00.00 - STA 177+00.00 EDGE LINE LT & RT

646.416 DURABLE 4 INCH YELLOW LINE, RECESSED POLYUREA  
 (ALL LINES WILL INCLUDE C/L BREAKS FOR  
 TOWN HIGHWAYS) S=SOLID, D=DASHED  
 WHITING:  
 STA 147+00.00 - STA 177+00.00

646.602 TEMPORARY 4 INCH WHITE LINE, PAINT  
 (ALL LINES WILL INCLUDE EDGE LINE BREAKS AND  
 RADIUS FOR TOWN HIGHWAYS)  
 WHITING:  
 STA 147+00.00 - STA 177+00.00 EDGE LINE LT & RT

646.612 TEMPORARY 4 INCH YELLOW LINE, PAINT  
 (ALL LINES WILL INCLUDE C/L BREAKS FOR  
 TOWN HIGHWAYS) S=SOLID, D=DASHED  
 WHITING:  
 STA 147+00.00 - STA 177+00.00

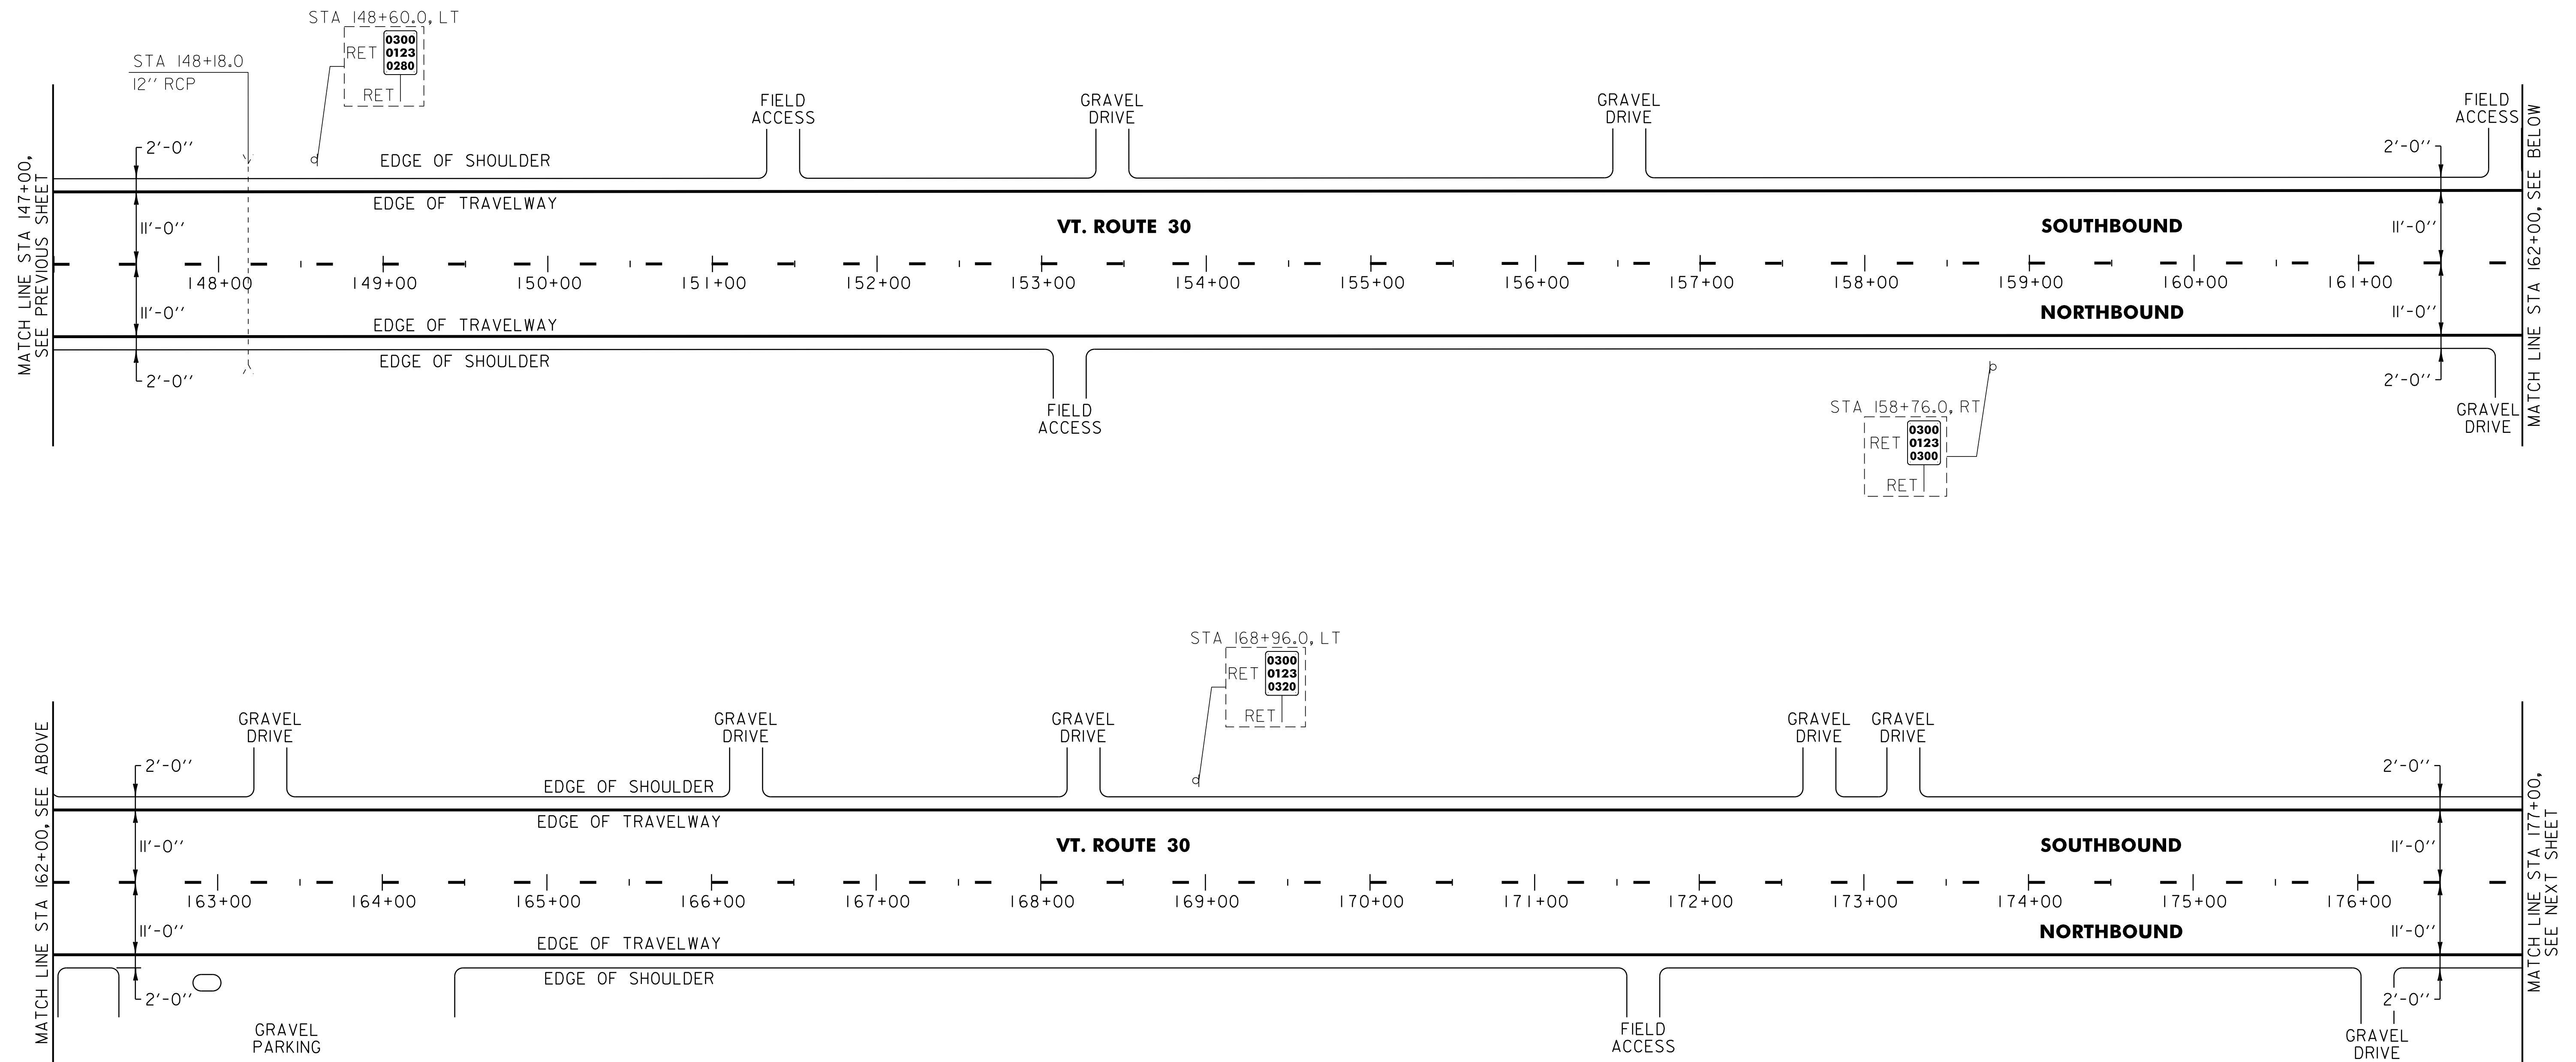

**SIGN LEGEND**  
 R = REMOVE  
 S = SALVAGE  
 N = NEW  
 RET = RETAIN  
 B-B = BACK TO BACK  
 EXISTING = - - - - -  
 NEW = \_\_\_\_\_

<b>PROJECT LAYOUT SHEET #6</b>	<b>NOT TO SCALE</b>	
	PROJECT NAME: WHITING - MIDDLEBURY	
	PROJECT NUMBER: STP 2629(II)	
FILE NAME: p06c226.dgn	PLOT DATE: 30-MAR-2012 14:13	
PROJECT LEADER: D.E.G.	DRAWN BY: C.A.K.	
DESIGNED BY: M.J.L.	CHECKED BY: D.E.G.	
DWG. NO. p06c226106.1	SHEET 22 OF 133	