


646.406 DURABLE 4 INCH WHITE LINE, RECESSED POLYUREA  
 (ALL LINES WILL INCLUDE EDGE LINE BREAKS AND  
 RADIUS FOR TOWN HIGHWAYS)  
 WHITING:  
 STA 207+00.00 - STA 237+00.00 EDGE LINE LT & RT

646.602 TEMPORARY 4 INCH WHITE LINE, PAINT  
 (ALL LINES WILL INCLUDE EDGE LINE BREAKS AND  
 RADIUS FOR TOWN HIGHWAYS)  
 WHITING:  
 STA 207+00.00 - STA 237+00.00 EDGE LINE LT & RT

646.416 DURABLE 4 INCH YELLOW LINE, RECESSED POLYUREA  
 (ALL LINES WILL INCLUDE C/L BREAKS FOR  
 TOWN HIGHWAYS) S=SOLID, D=DASHED  
 WHITING:  
 STA 207+00.00 - STA 208+55.00  
 STA 208+55.00 - STA 215+70.00  
 STA 215+70.00 - STA 221+20.00  
 STA 221+20.00 - STA 221+75.00  
 STA 221+75.00 - STA 229+15.00  
 STA 229+15.00 - STA 236+55.00  
 STA 236+55.00 - STA 237+00.00

646.612 TEMPORARY 4 INCH YELLOW LINE, PAINT  
 (ALL LINES WILL INCLUDE C/L BREAKS FOR  
 TOWN HIGHWAYS) S=SOLID, D=DASHED  
 WHITING:  
 STA 207+00.00 - STA 208+55.00  
 STA 208+55.00 - STA 215+70.00  
 STA 215+70.00 - STA 221+20.00  
 STA 221+20.00 - STA 221+75.00  
 STA 221+75.00 - STA 229+15.00  
 STA 229+15.00 - STA 236+55.00  
 STA 236+55.00 - STA 237+00.00

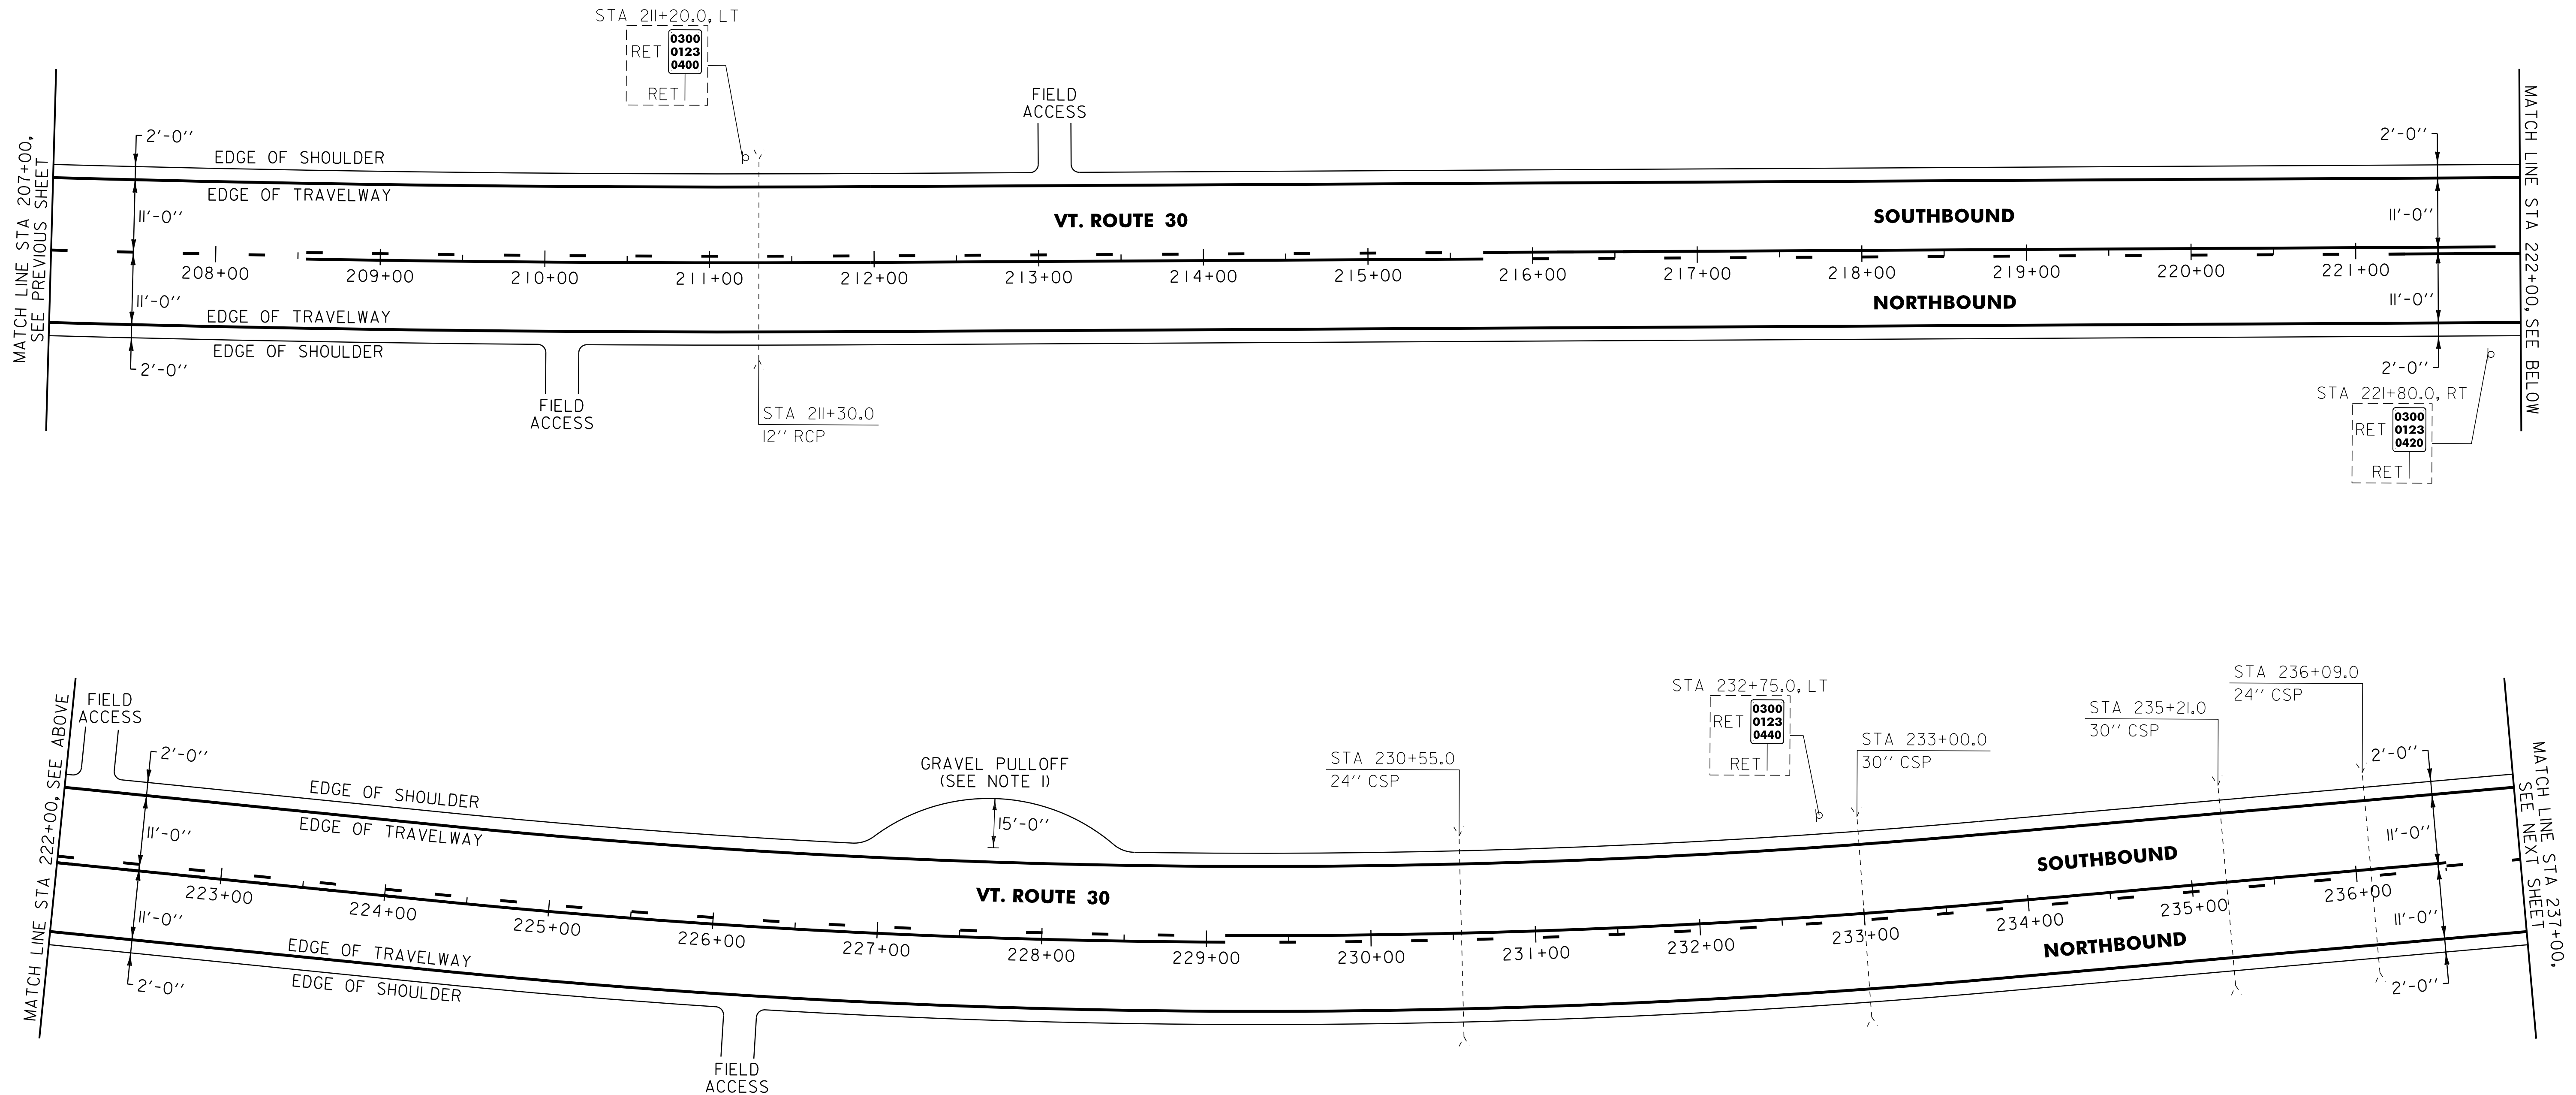

NOTE:

- PROVIDE A 5 FT WIDE, 1/2" TYPE IVS APRON FOR THE EXISTING GRAVEL PULLOUT. ANY REQUIRED EXCAVATION SHALL BE PERFORMED AS DIRECTED BY THE RESIDENT ENGINEER AND PAID FOR UNDER ITEM 608.25 ALL PURPOSE EXCAVATOR RENTAL, TYPE I.

**SIGN LEGEND**  
 R = REMOVE  
 S = SALVAGE  
 N = NEW  
 RET = RETAIN  
 B-B = BACK TO BACK  
 EXISTING = - - - - -  
 NEW = \_\_\_\_\_

NOT TO SCALE

**PROJECT LAYOUT SHEET #8**

PROJECT NAME: WHITING - MIDDLEBURY

PROJECT NUMBER: STP 2629(I)

FILE NAME: p06c226.dgn

PROJECT LEADER: D.E.G.

DESIGNED BY: M.J.L.

DWG. NO. p06c226i08.1

PLOT DATE: 30-MAR-2012 14:13

DRAWN BY: C.A.K.

CHECKED BY: D.E.G.

SHEET 24 OF 133