


646.406 DURABLE 4 INCH WHITE LINE, RECESSED POLYUREA  
 (ALL LINES WILL INCLUDE EDGE LINE BREAKS AND RADIUS FOR TOWN HIGHWAYS)  
 WHITING:  
 STA 237+00.00 - STA 261+04.32 EDGE LINE LT & RT  
 CORNWALL:  
 STA 0+00.00 - STA 5+00.00 EDGE LINE LT & RT

646.602 TEMPORARY 4 INCH WHITE LINE, PAINT  
 (ALL LINES WILL INCLUDE EDGE LINE BREAKS AND RADIUS FOR TOWN HIGHWAYS)  
 WHITING:  
 STA 237+00.00 - STA 261+04.32 EDGE LINE LT & RT  
 CORNWALL:  
 STA 0+00.00 - STA 5+00.00 EDGE LINE LT & RT

646.416 DURABLE 4 INCH YELLOW LINE, RECESSED POLYUREA  
 (ALL LINES WILL INCLUDE C/L BREAKS FOR TOWN HIGHWAYS) S=SOLID, D=DASHED  
 WHITING:  
 STA 237+00.00 - STA 240+50.00 - D - D -  
 STA 240+50.00 - STA 248+15.00 - D - S -  
 STA 248+15.00 - STA 261+04.32 - S - S -  
 CORNWALL:  
 STA 0+00.00 - STA 5+00.00 - S - S -

646.612 TEMPORARY 4 INCH YELLOW LINE, PAINT  
 (ALL LINES WILL INCLUDE C/L BREAKS FOR TOWN HIGHWAYS) S=SOLID, D=DASHED  
 WHITING:  
 STA 237+00.00 - STA 240+50.00 - - D - -  
 STA 240+50.00 - STA 248+15.00 - D - S -  
 STA 248+15.00 - STA 261+04.32 - S - S -  
 CORNWALL:  
 STA 0+00.00 - STA 5+00.00 - S - S -

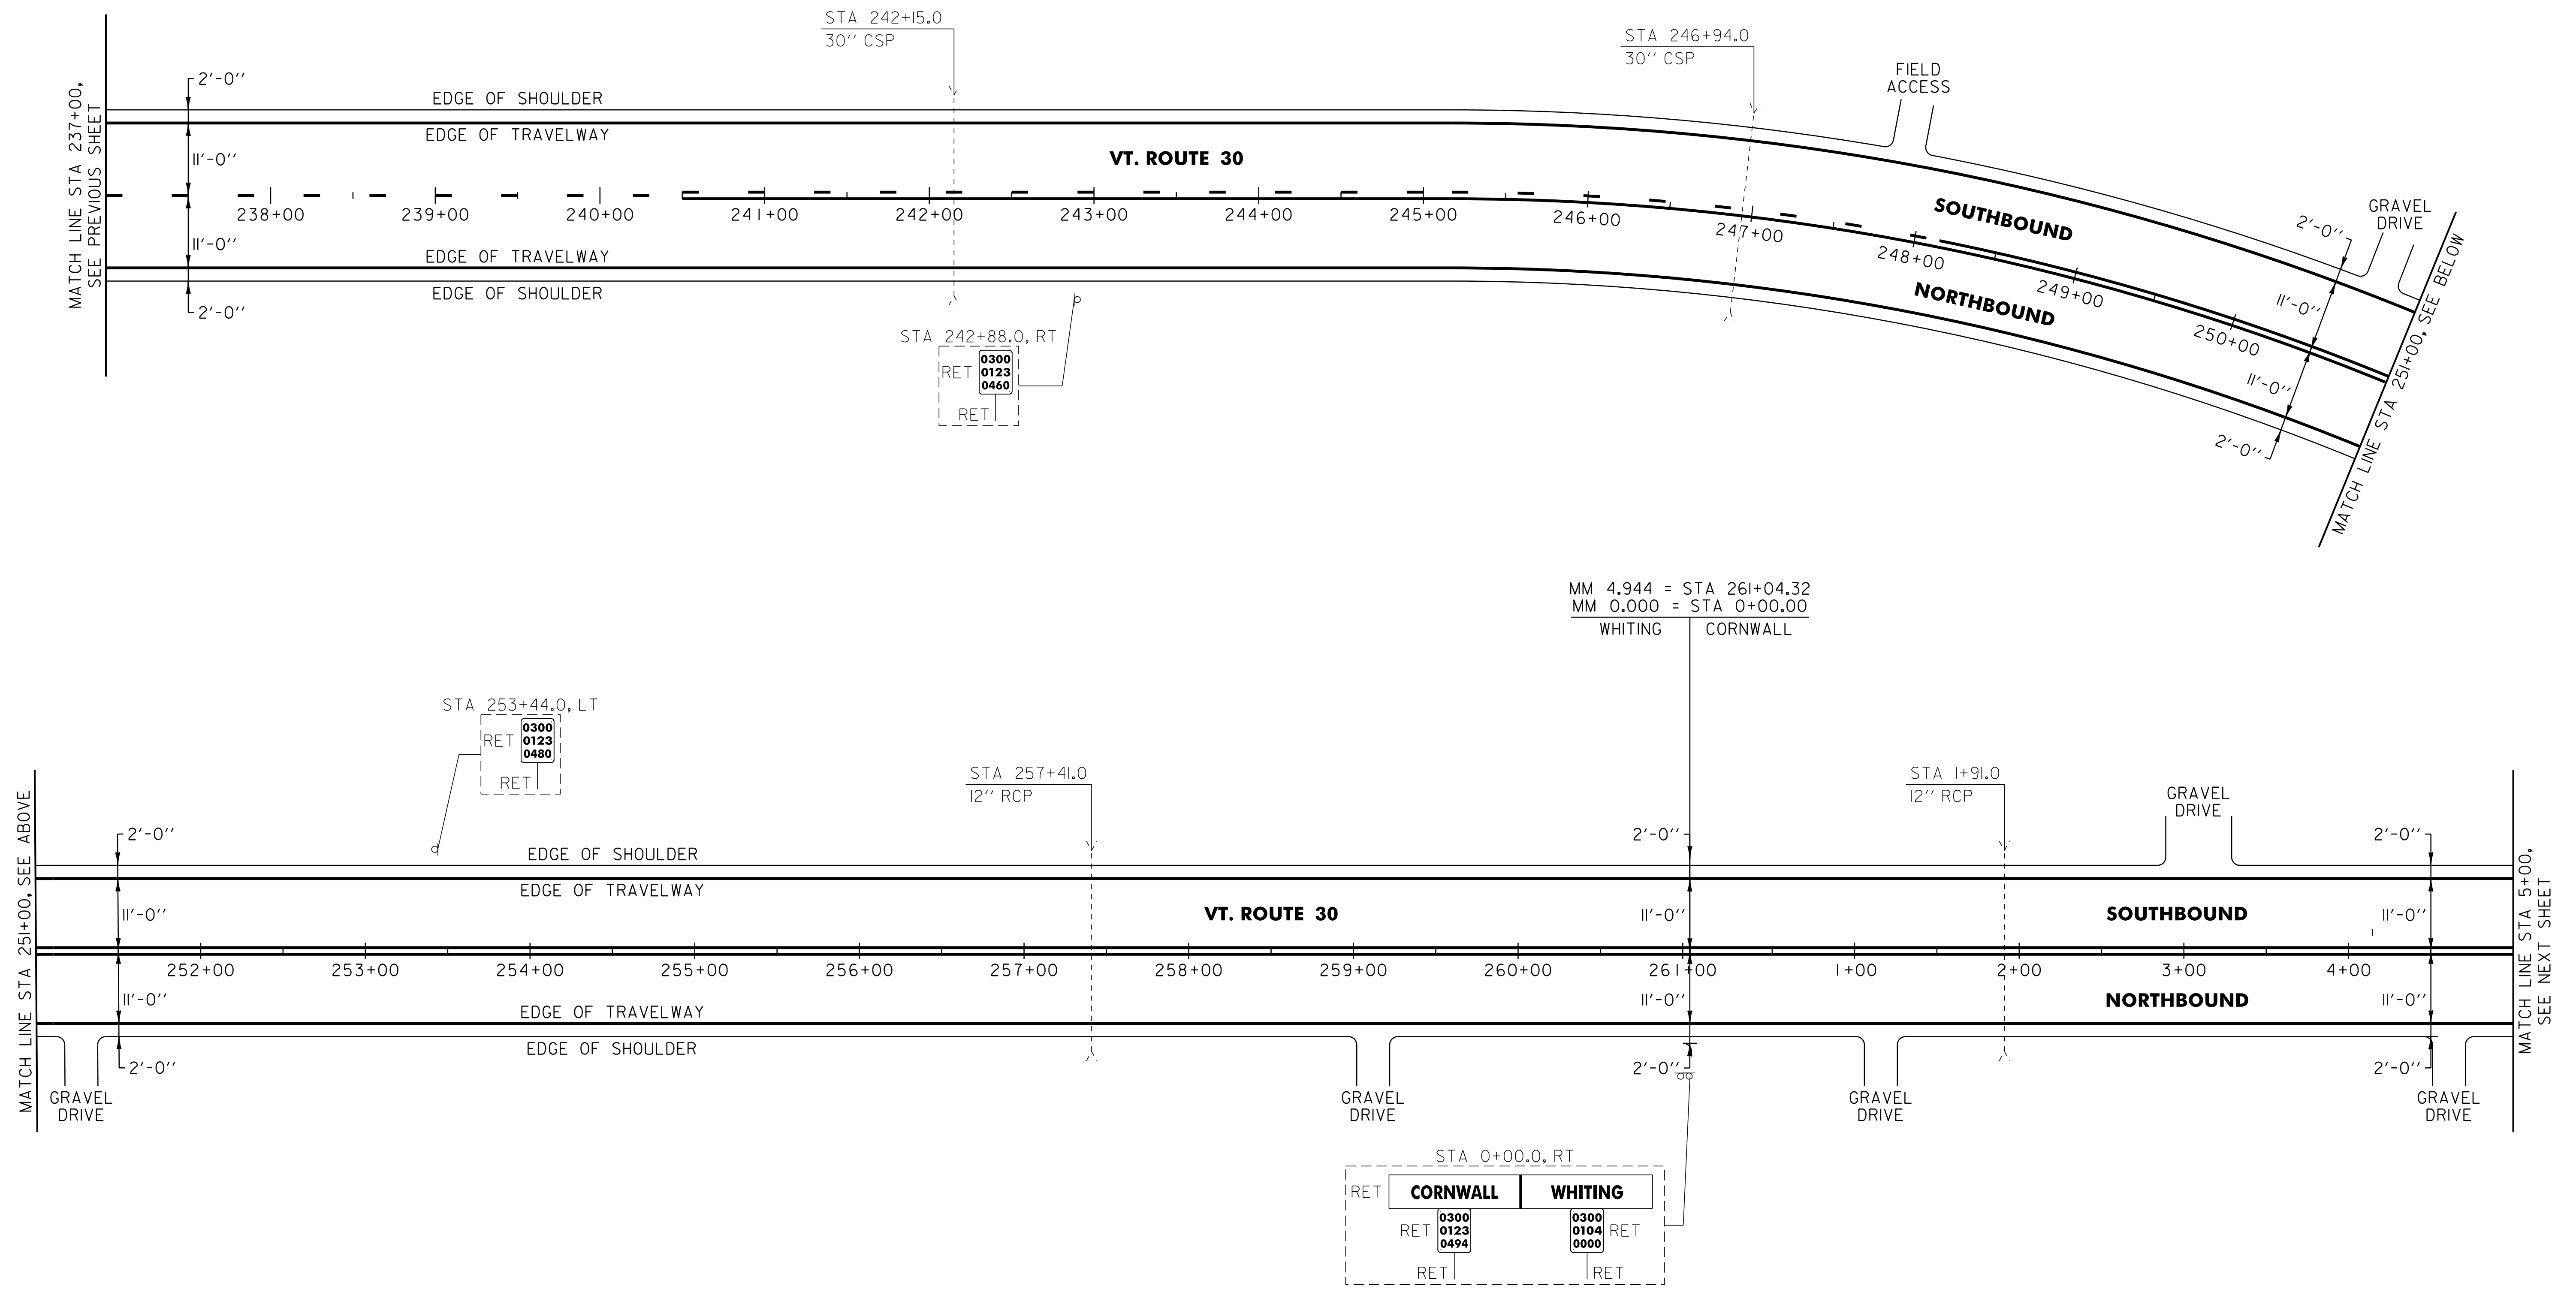

**SIGN LEGEND**  
 R = REMOVE  
 S = SALVAGE  
 N = NEW  
 RET = RETAIN  
 B-B = BACK TO BACK  
 EXISTING = - - - - -  
 NEW = \_\_\_\_\_

**NOT TO SCALE**

<b>PROJECT LAYOUT SHEET #9</b>	PROJECT NAME: WHITING - MIDDLEBURY
	PROJECT NUMBER: STP 2629(I)
	FILE NAME: p06c226.dgn
PROJECT LEADER: D.E.G.	PLOT DATE: 30-MAR-2012 14:13
DESIGNED BY: M.J.L.	DRAWN BY: C.A.K.
DWG. NO. p06c226i09.1	CHECKED BY: D.E.G.
	SHEET 25 OF 133