
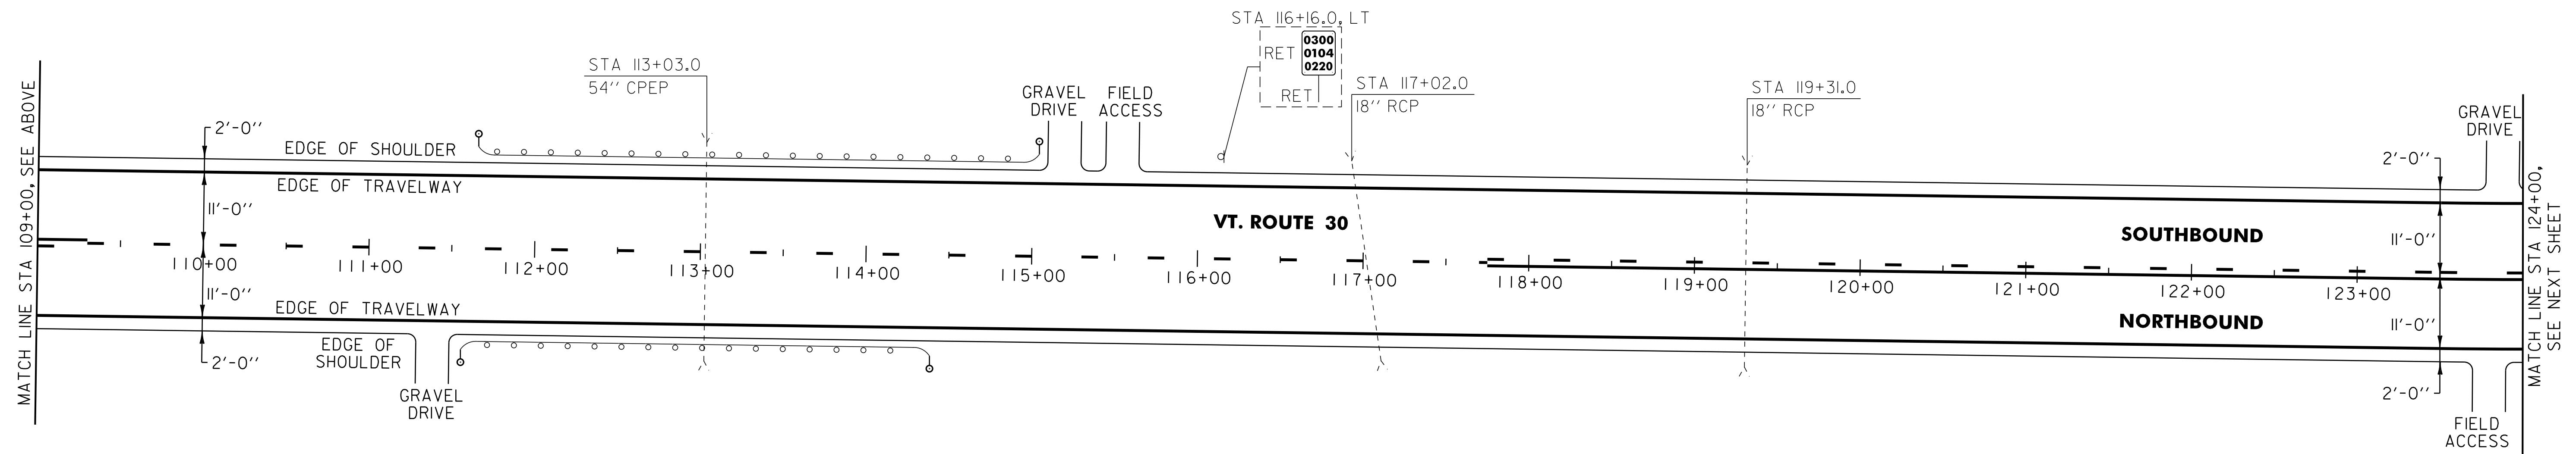


646.406 DURABLE 4 INCH WHITE LINE, RECESSED POLYUREA
 (ALL LINES WILL INCLUDE EDGE LINE BREAKS AND RADIUS FOR TOWN HIGHWAYS)
 CORNWALL:
 STA 94+00.00 - STA 124+00.00 EDGE LINE LT & RT

646.416 DURABLE 4 INCH YELLOW LINE, RECESSED POLYUREA
 (ALL LINES WILL INCLUDE C/L BREAKS FOR TOWN HIGHWAYS) S=SOLID, D=DASHED
 CORNWALL:
 STA 94+00.00 - STA 101+90.00 LT C RT S - S
 STA 101+90.00 - STA 109+30.00 S - D
 STA 109+30.00 - STA 117+75.00 - D -
 STA 117+75.00 - STA 124+00.00 D - S

646.602 TEMPORARY 4 INCH WHITE LINE, PAINT
 (ALL LINES WILL INCLUDE EDGE LINE BREAKS AND RADIUS FOR TOWN HIGHWAYS)
 CORNWALL:
 STA 94+00.00 - STA 124+00.00 EDGE LINE LT & RT

646.612 TEMPORARY 4 INCH YELLOW LINE, PAINT
 (ALL LINES WILL INCLUDE C/L BREAKS FOR TOWN HIGHWAYS) S=SOLID, D=DASHED
 CORNWALL:
 STA 94+00.00 - STA 101+90.00 LT C RT S - S
 STA 101+90.00 - STA 109+30.00 S - D
 STA 109+30.00 - STA 117+75.00 - D -
 STA 117+75.00 - STA 124+00.00 D - S

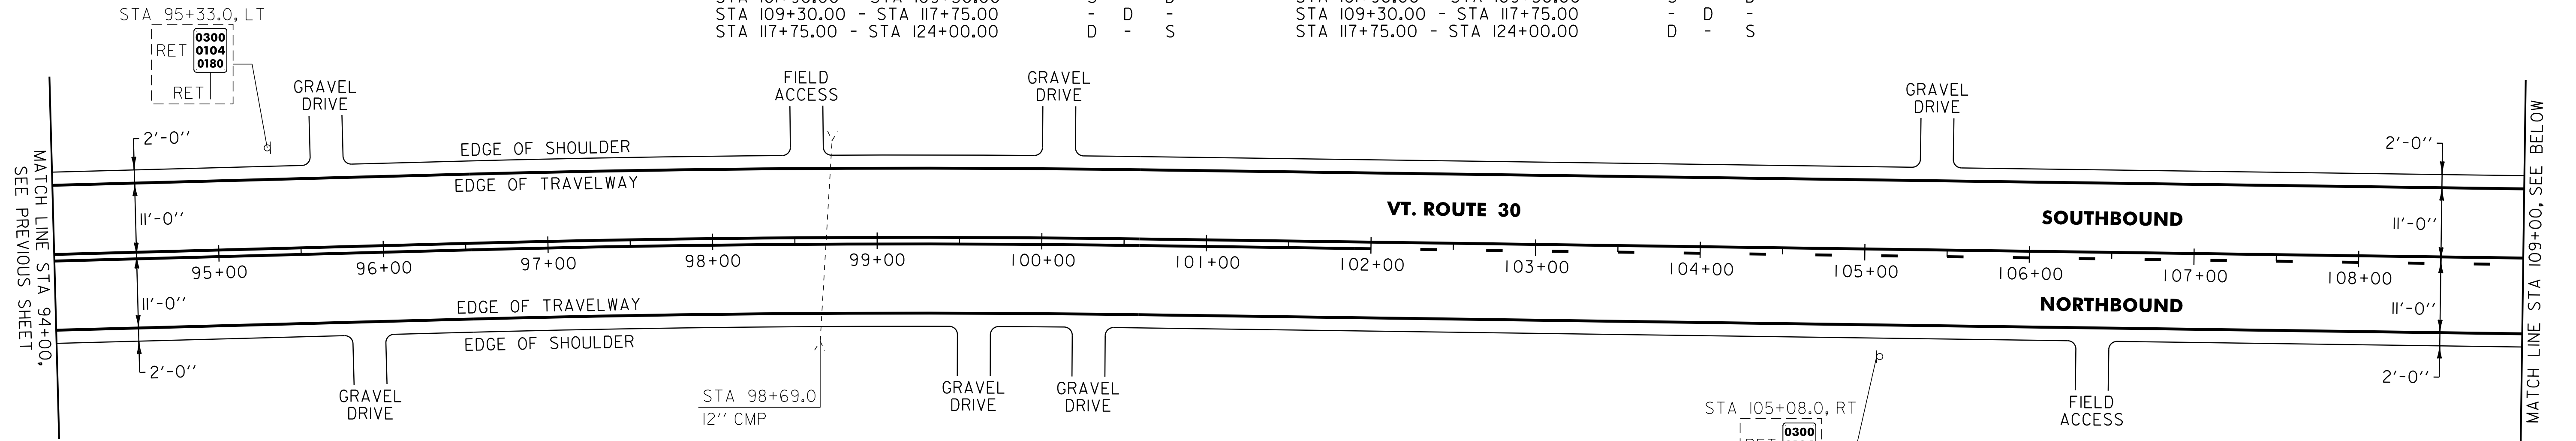

621.20 STEEL BEAM GUARDRAIL, GALVANIZED
 CORNWALL:
 STA 111+90.5 - STA 114+03.0 RT (212.5 LF)
 STA 112+03.0 - STA 114+65.5 LT (262.5 LF)

621.80 REMOVAL AND DISPOSAL OF GUARDRAIL
 CORNWALL:
 STA 111+81.0 - STA 113+97.0 LT (216.0 LF)
 STA 111+86.0 - STA 114+26.0 RT (240.0 LF)

621.50 MANUFACTURED TERMINAL SECTION, FLARED
 CORNWALL:
 STA 111+53.0 - STA 111+90.5 RT
 STA 111+65.5 - STA 112+03.0 LT
 STA 114+03.0 - STA 114+40.5 RT
 STA 114+65.5 - STA 115+03.0 LT

676.10 DELINEATOR WITH STEEL POST
 CORNWALL:
 STA 111+53.0 RT
 STA 111+65.5 LT
 STA 114+40.5 RT
 STA 115+03.0 LT

SIGN LEGEND
 R = REMOVE
 S = SALVAGE
 N = NEW
 RET = RETAIN
 B-B = BACK TO BACK
 EXISTING = - - - - -
 NEW = _____

NOT TO SCALE

PROJECT LAYOUT SHEET #13

PROJECT NAME: WHITING - MIDDLEBURY

PROJECT NUMBER: STP 2629(I)

FILE NAME: p06c226.dgn
 PROJECT LEADER: D.E.G.
 DESIGNED BY: M.J.L.
 DWG. NO. p06c226I13.1

PLOT DATE: 30-MAR-2012 14:13
 DRAWN BY: C.A.K.
 CHECKED BY: D.E.G.
 SHEET 29 OF 133