

646.406 DURABLE 4 INCH WHITE LINE, RECESSED POLYUREA  
 (ALL LINES WILL INCLUDE EDGE LINE BREAKS AND RADIUS FOR TOWN HIGHWAYS)  
 CORNWALL:  
 STA 124+00.00 - STA 153+00.00 EDGE LINE LT & RT

646.416 DURABLE 4 INCH YELLOW LINE, RECESSED POLYUREA  
 (ALL LINES WILL INCLUDE C/L BREAKS FOR TOWN HIGHWAYS) S=SOLID, D=DASHED  
 CORNWALL:  
 STA 124+00.00 - STA 125+65.00 LT @ RT  
 STA 125+65.00 - STA 153+00.00 S - S  
 STA 135+37.92 DOUBLE SOLID LT, TH-21

646.602 TEMPORARY 4 INCH WHITE LINE, PAINT  
 (ALL LINES WILL INCLUDE EDGE LINE BREAKS AND RADIUS FOR TOWN HIGHWAYS)  
 CORNWALL:  
 STA 124+00.00 - STA 153+00.00 EDGE LINE LT & RT

646.612 TEMPORARY 4 INCH YELLOW LINE, PAINT  
 (ALL LINES WILL INCLUDE C/L BREAKS FOR TOWN HIGHWAYS) S=SOLID, D=DASHED  
 CORNWALL:  
 STA 124+00.00 - STA 125+65.00 LT @ RT  
 STA 125+65.00 - STA 153+00.00 S - S  
 STA 135+37.92 DOUBLE SOLID LT, TH-21

646.481 DURABLE 24 INCH STOP BAR, TYPE ITAPE  
 CORNWALL:  
 STA 135+37.92 LT, TH-21


646.682 TEMPORARY 24 INCH STOP BAR, PAINT  
 CORNWALL:  
 STA 135+37.92 LT, TH-21

646.491 DURABLE LETTER OR SYMBOL, TYPE ITAPE  
 CORNWALL:  
 STA 135+37.92 LT, TH-21 "S,T,O,P" (4 EA)

646.692 TEMPORARY LETTER OR SYMBOL, PAINT  
 CORNWALL:  
 STA 135+37.92 LT, TH-21 "S,T,O,P" (4 EA)

675.50 REMOVING SIGNS AS SHOWN - 4

675.60 ERECTING SALVAGED SIGNS AS SHOWN - 3

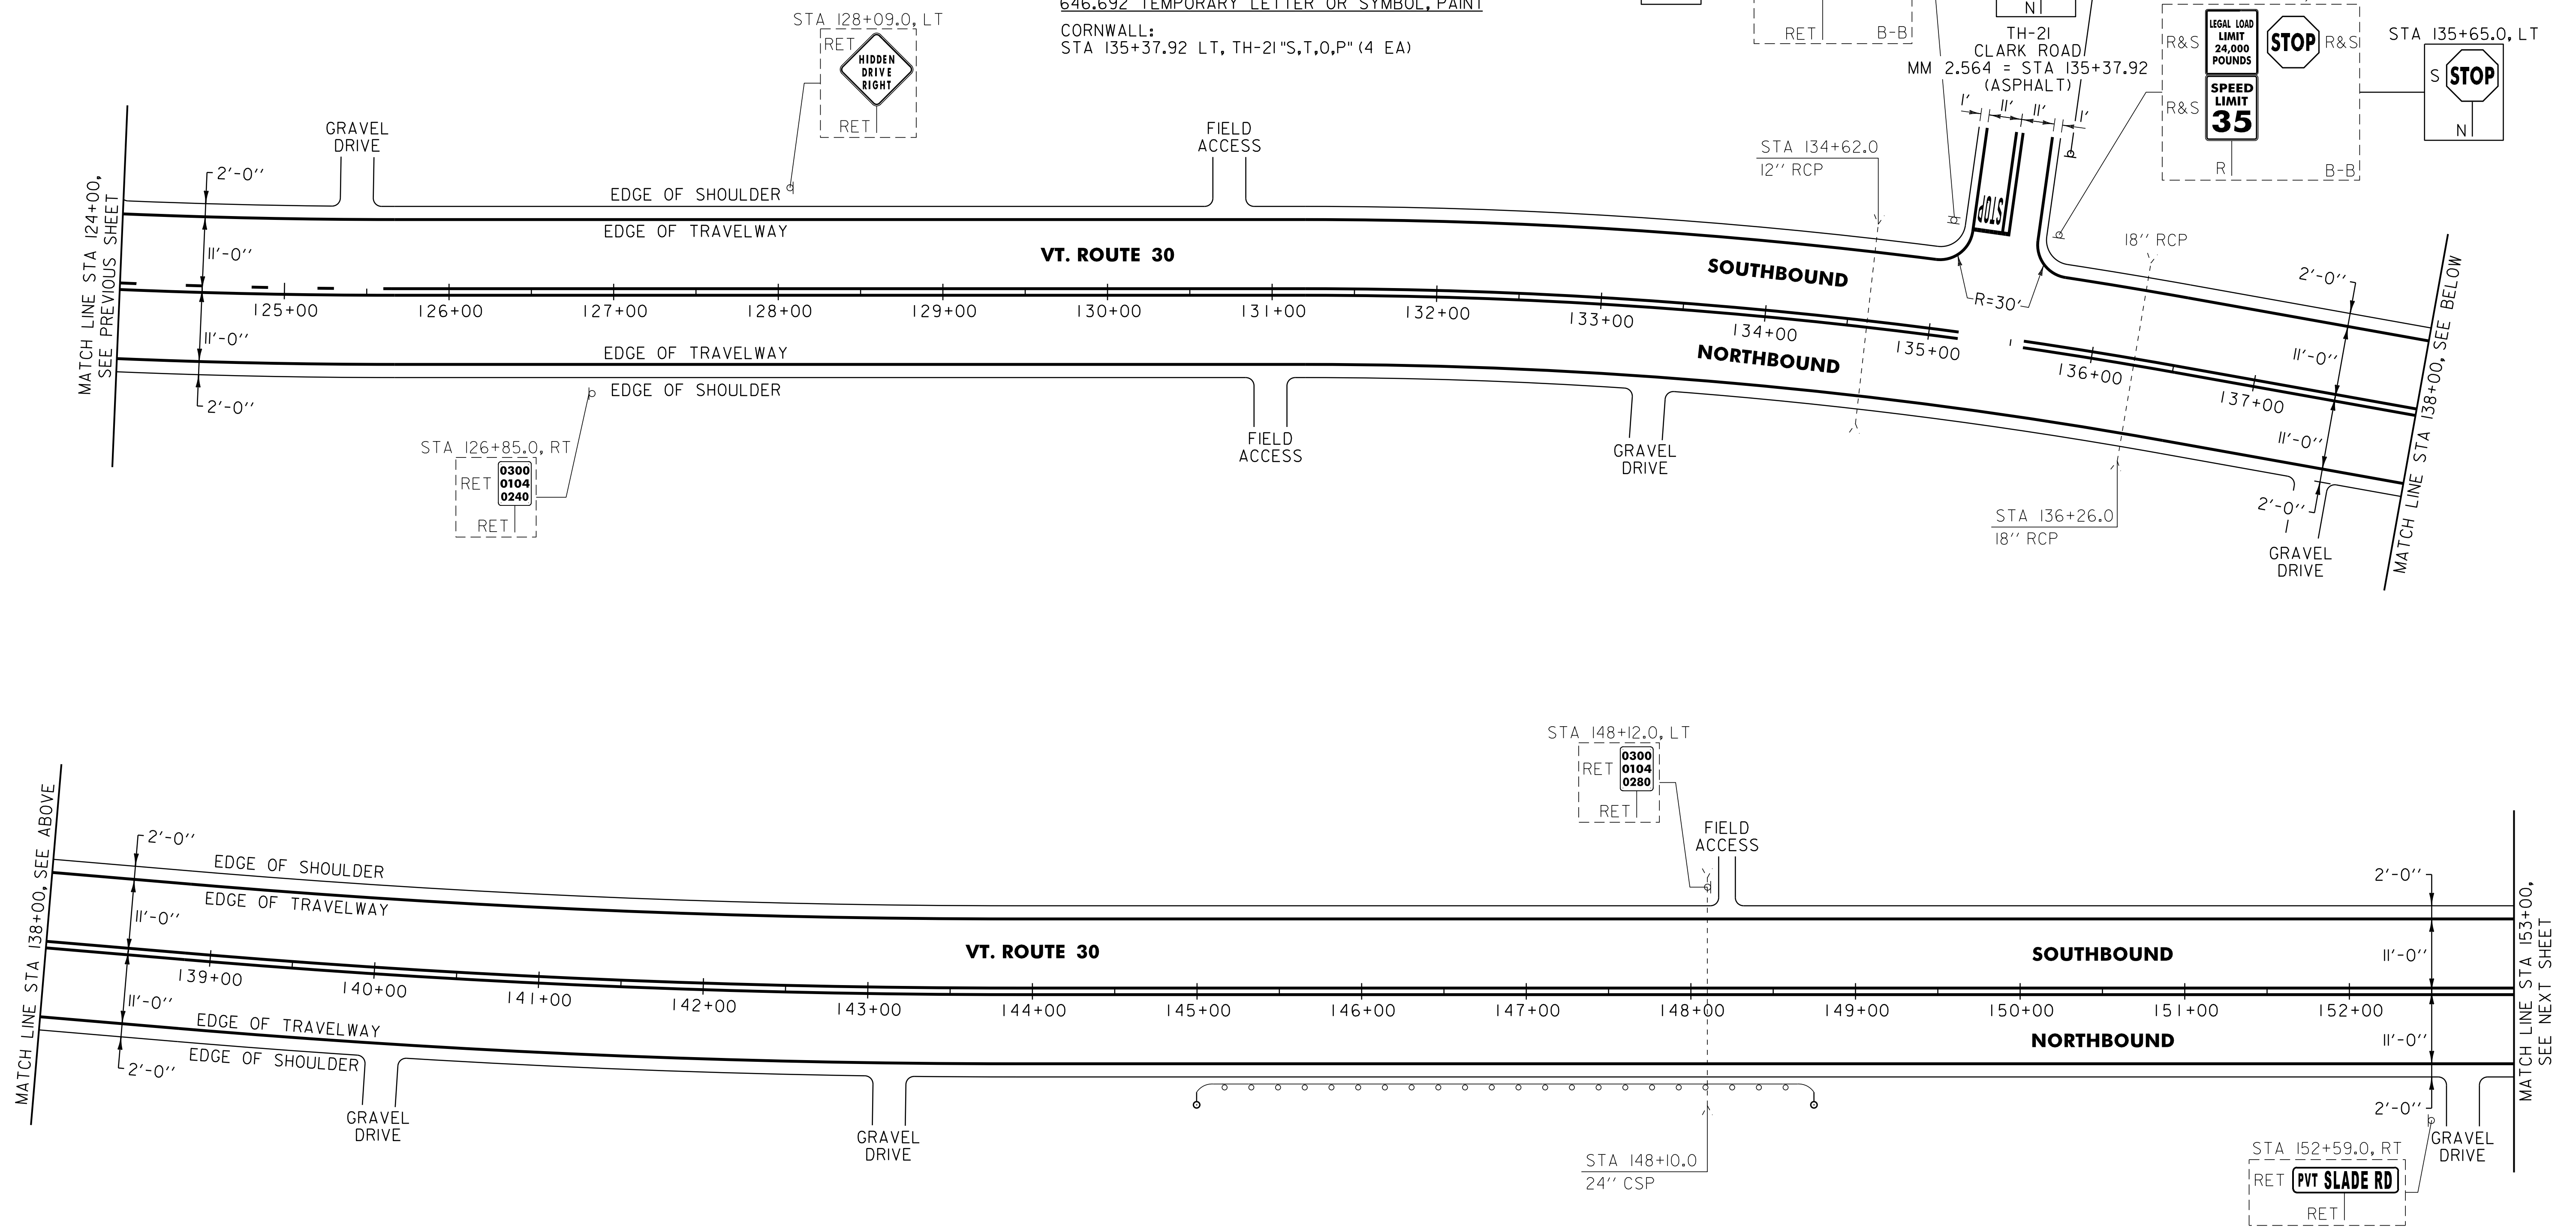

621.20 STEEL BEAM GUARDRAIL, GALVANIZED  
 CORNWALL:  
 STA 145+23.5 - STA 148+48.5 RT (325.0 LF)

621.50 MANUFACTURED TERMINAL SECTION, FLARED  
 CORNWALL:  
 STA 144+86.0 - STA 145+23.5 RT  
 STA 148+48.5 - STA 148+86.0 RT

621.80 REMOVAL AND DISPOSAL OF GUARDRAIL  
 CORNWALL:  
 STA 144+91.0 - STA 148+81.0 RT (390.0 LF)

676.10 DELINEATOR WITH STEEL POST  
 CORNWALL:  
 STA 144+86.0 RT  
 STA 148+86.0 RT

NOTE:  
 1. PAVING LIMIT ON ALL TOWN HIGHWAYS SHALL BE MEASURED 25 FT BACK FROM VT. ROUTE 30 EDGE OF SHOULDER UNLESS DENOTED OTHERWISE ON THE PLANS OR AS DIRECTED BY THE RESIDENT ENGINEER.

**SIGN LEGEND**  
 R = REMOVE  
 S = SALVAGE  
 N = NEW  
 RET = RETAIN  
 B-B = BACK TO BACK  
 EXISTING = - - - - -  
 NEW = \_\_\_\_\_

**NOT TO SCALE**

<b>PROJECT LAYOUT SHEET #14</b>	PROJECT NAME: WHITING - MIDDLEBURY
	PROJECT NUMBER: STP 2629(I)
	FILE NAME: p06c226.dgn PROJECT LEADER: D.E.G. DESIGNED BY: M.J.L. DWG. NO. p06c226I14.1
	PLOT DATE: 30-MAR-2012 14:13 DRAWN BY: C.A.K. CHECKED BY: D.E.G. SHEET 30 OF 133