

646.406 DURABLE 4 INCH WHITE LINE, RECESSED POLYUREA
 (ALL LINES WILL INCLUDE EDGE LINE BREAKS AND RADIUS FOR TOWN HIGHWAYS)
 CORNWALL:
 STA 197+00.00 - STA 212+00.00 EDGE LINE LT & RT

646.416 DURABLE 4 INCH YELLOW LINE, RECESSED POLYUREA
 (ALL LINES WILL INCLUDE C/L BREAKS FOR TOWN HIGHWAYS) S=SOLID, D=DASHED
 CORNWALL:
 STA 197+00.00 - STA 212+00.00 LT S - RT S
 STA 205+60.32 DOUBLE SOLID RT, TH-24

646.602 TEMPORARY 4 INCH WHITE LINE, PAINT
 (ALL LINES WILL INCLUDE EDGE LINE BREAKS AND RADIUS FOR TOWN HIGHWAYS)
 CORNWALL:
 STA 197+00.00 - STA 212+00.00 EDGE LINE LT & RT

646.612 TEMPORARY 4 INCH YELLOW LINE, PAINT
 (ALL LINES WILL INCLUDE C/L BREAKS FOR TOWN HIGHWAYS) S=SOLID, D=DASHED
 CORNWALL:
 STA 197+00.00 - STA 212+00.00 LT S - RT S
 STA 205+60.32 DOUBLE SOLID RT, TH-24


646.481 DURABLE 24 INCH STOP BAR, TYPE I TAPE
 CORNWALL:
 STA 205+60.32 RT, TH-24

646.682 TEMPORARY 24 INCH STOP BAR, PAINT
 CORNWALL:
 STA 205+60.32 RT, TH-24

646.491 DURABLE LETTER OR SYMBOL, TYPE I TAPE
 CORNWALL:
 STA 205+60.32 RT, TH-24 "S,T,O,P" (4 EA)

646.692 TEMPORARY LETTER OR SYMBOL, PAINT
 CORNWALL:
 STA 205+60.32 RT, TH-24 "S,T,O,P" (4 EA)

675.50 REMOVING SIGNS AS SHOWN - I

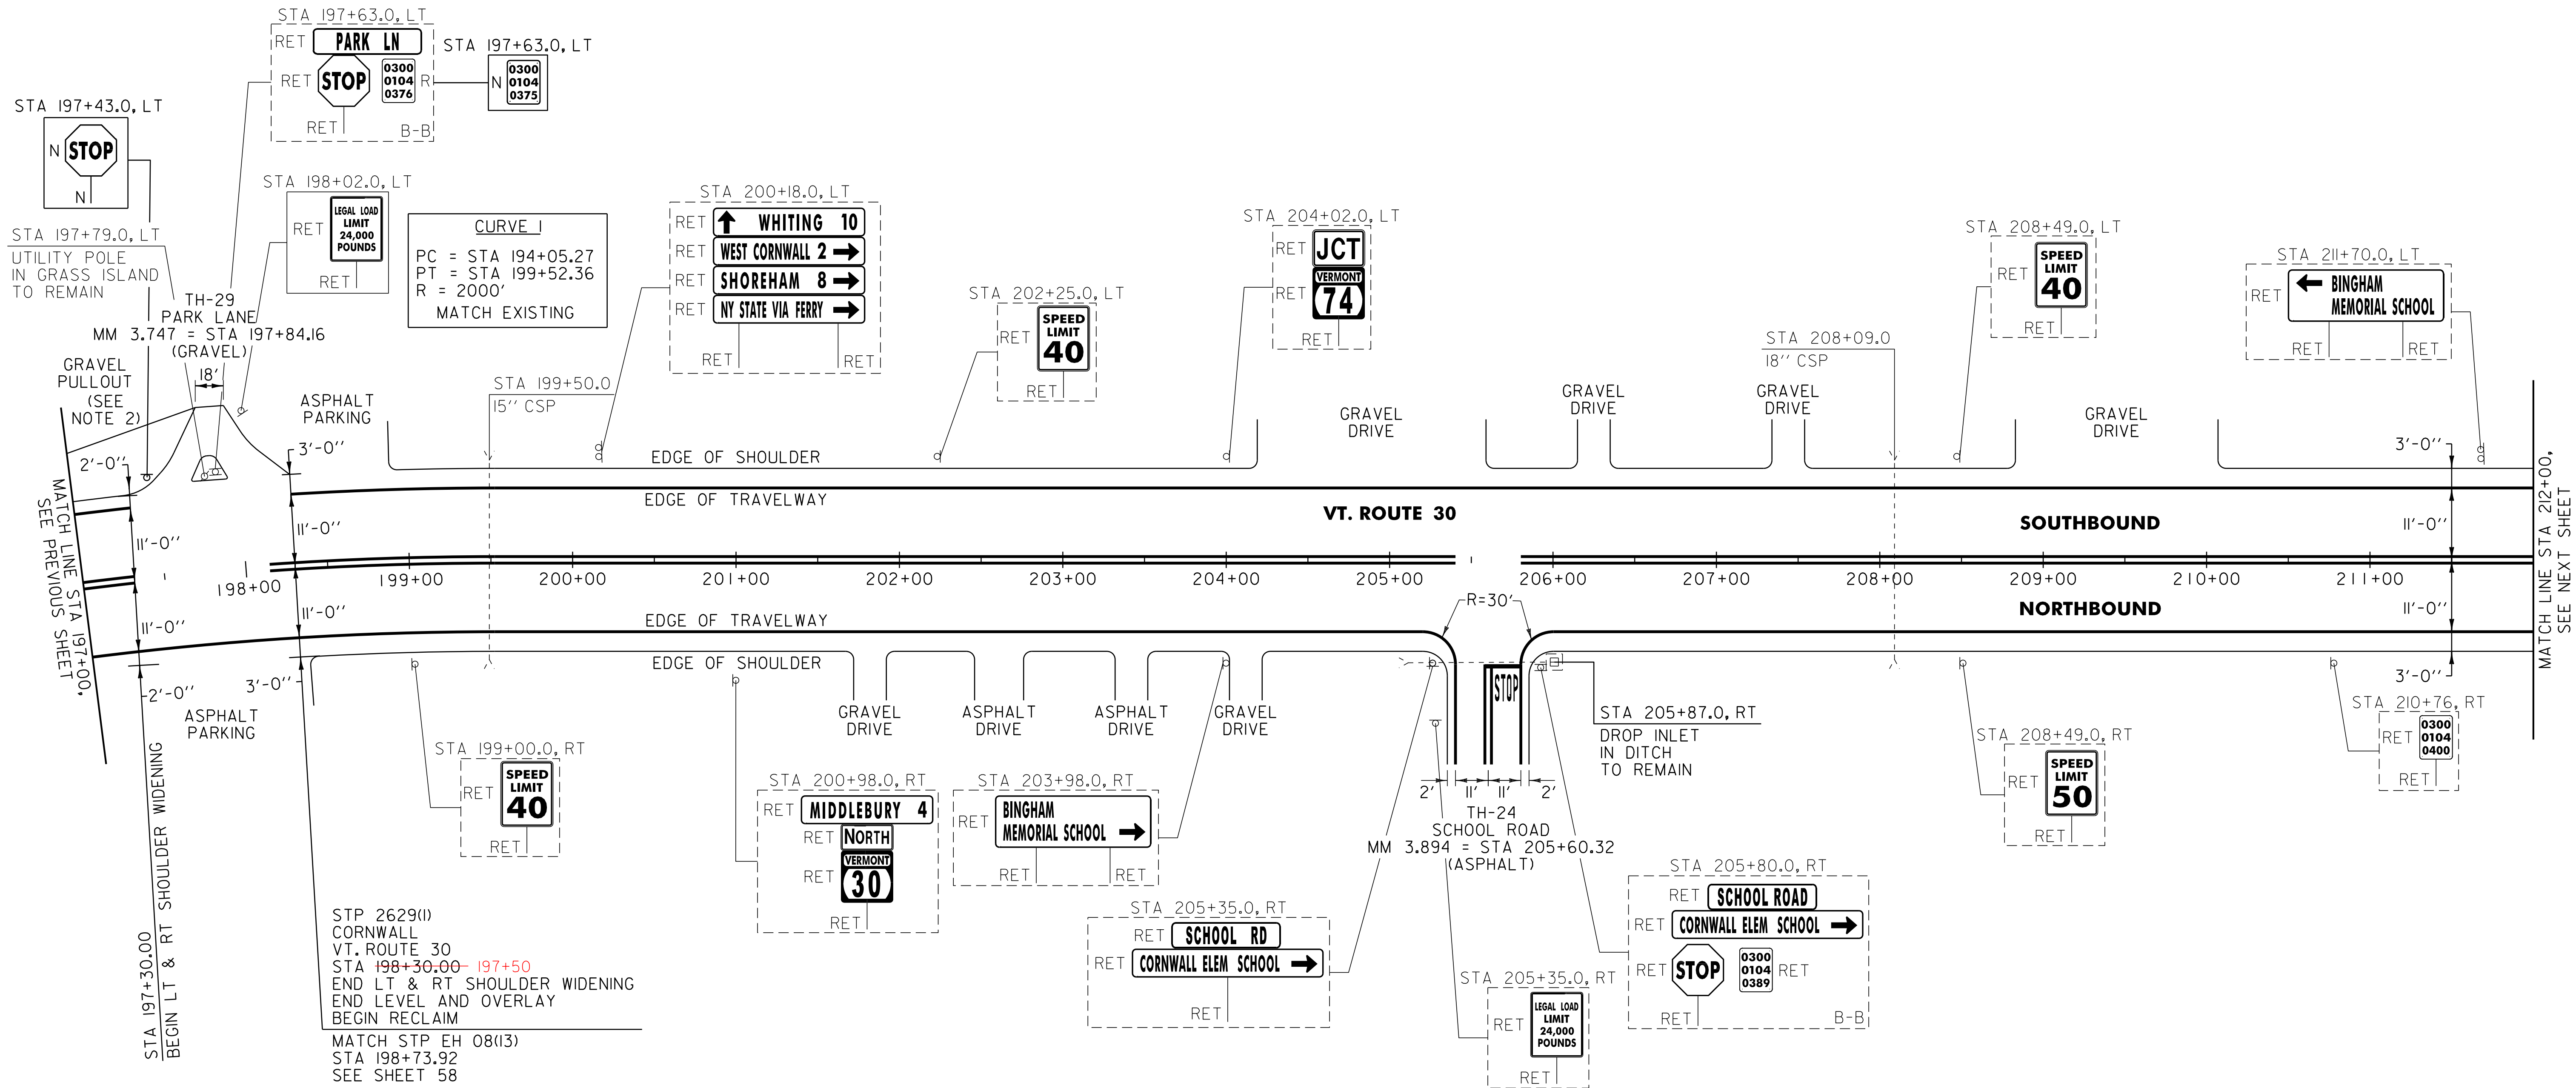

STP 2629(1)
 CORNWALL
 VT. ROUTE 30
 STA 198+30.00 - 197+50
 END LT & RT SHOULDER WIDENING
 END LEVEL AND OVERLAY
 BEGIN RECLAIM
 MATCH STP EH 08(13)
 STA 198+73.92
 SEE SHEET 58

- NOTES:
- PAVING LIMIT ON ALL TOWN HIGHWAYS SHALL BE MEASURED 25 FT BACK FROM VT. ROUTE 30 EDGE OF SHOULDER UNLESS DENOTED OTHERWISE ON THE PLANS OR AS DIRECTED BY THE RESIDENT ENGINEER.
 - PROVIDE A 5 FT WIDE, 1 1/2" TYPE IVS APRON FOR THE EXISTING GRAVEL PULLOUT. ANY REQUIRED EXCAVATION SHALL BE PERFORMED AS DIRECTED BY THE RESIDENT ENGINEER AND PAID FOR UNDER ITEM 608.25 ALL PURPOSE EXCAVATOR RENTAL, TYPE I.
 - UNDERGROUND TELEPHONE UTILITIES TO BE RELOCATED AERIALY BY OTHERS UNDER STP EH 08(13) PRIOR TO ANY RECLAIM OPERATIONS.

SIGN LEGEND
 R = REMOVE
 S = SALVAGE
 N = NEW
 RET = RETAIN
 B-B = BACK TO BACK
 EXISTING = - - - - -
 NEW = _____

NOT TO SCALE

PROJECT LAYOUT SHEET #17	PROJECT NAME: WHITING - MIDDLEBURY	PLOT DATE: 30-MAR-2012 14:13
	PROJECT NUMBER: STP 2629(1)	DRAWN BY: C.A.K.
	FILE NAME: p06c226.dgn	CHECKED BY: D.E.G.
	PROJECT LEADER: D.E.G. DESIGNED BY: M.J.L. DWG. NO. p06c226(17).i	SHEET 33 OF 133

AREA OF RECLAIMED STABILIZED BASE