


646.406 DURABLE 4 INCH WHITE LINE, RECESSED POLYUREA  
 (ALL LINES WILL INCLUDE EDGE LINE BREAKS AND  
 RADIUS FOR TOWN HIGHWAYS)  
 CORNWALL:  
 STA 241+00.00 - STA 270+00.00 EDGE LINE LT & RT

646.602 TEMPORARY 4 INCH WHITE LINE, PAINT  
 (ALL LINES WILL INCLUDE EDGE LINE BREAKS AND  
 RADIUS FOR TOWN HIGHWAYS)  
 CORNWALL:  
 STA 241+00.00 - STA 270+00.00 EDGE LINE LT & RT

675.50 REMOVING SIGNS  
 AS SHOWN - I

646.416 DURABLE 4 INCH YELLOW LINE, RECESSED POLYUREA  
 (ALL LINES WILL INCLUDE C/L BREAKS FOR  
 TOWN HIGHWAYS) S=SOLID, D=DASHED  
 CORNWALL:  
 STA 241+00.00 - STA 270+00.00 LT CL RT  
 S - S

646.612 TEMPORARY 4 INCH YELLOW LINE, PAINT  
 (ALL LINES WILL INCLUDE C/L BREAKS FOR  
 TOWN HIGHWAYS) S=SOLID, D=DASHED  
 CORNWALL:  
 STA 241+00.00 - STA 270+00.00 LT CL RT  
 S - S

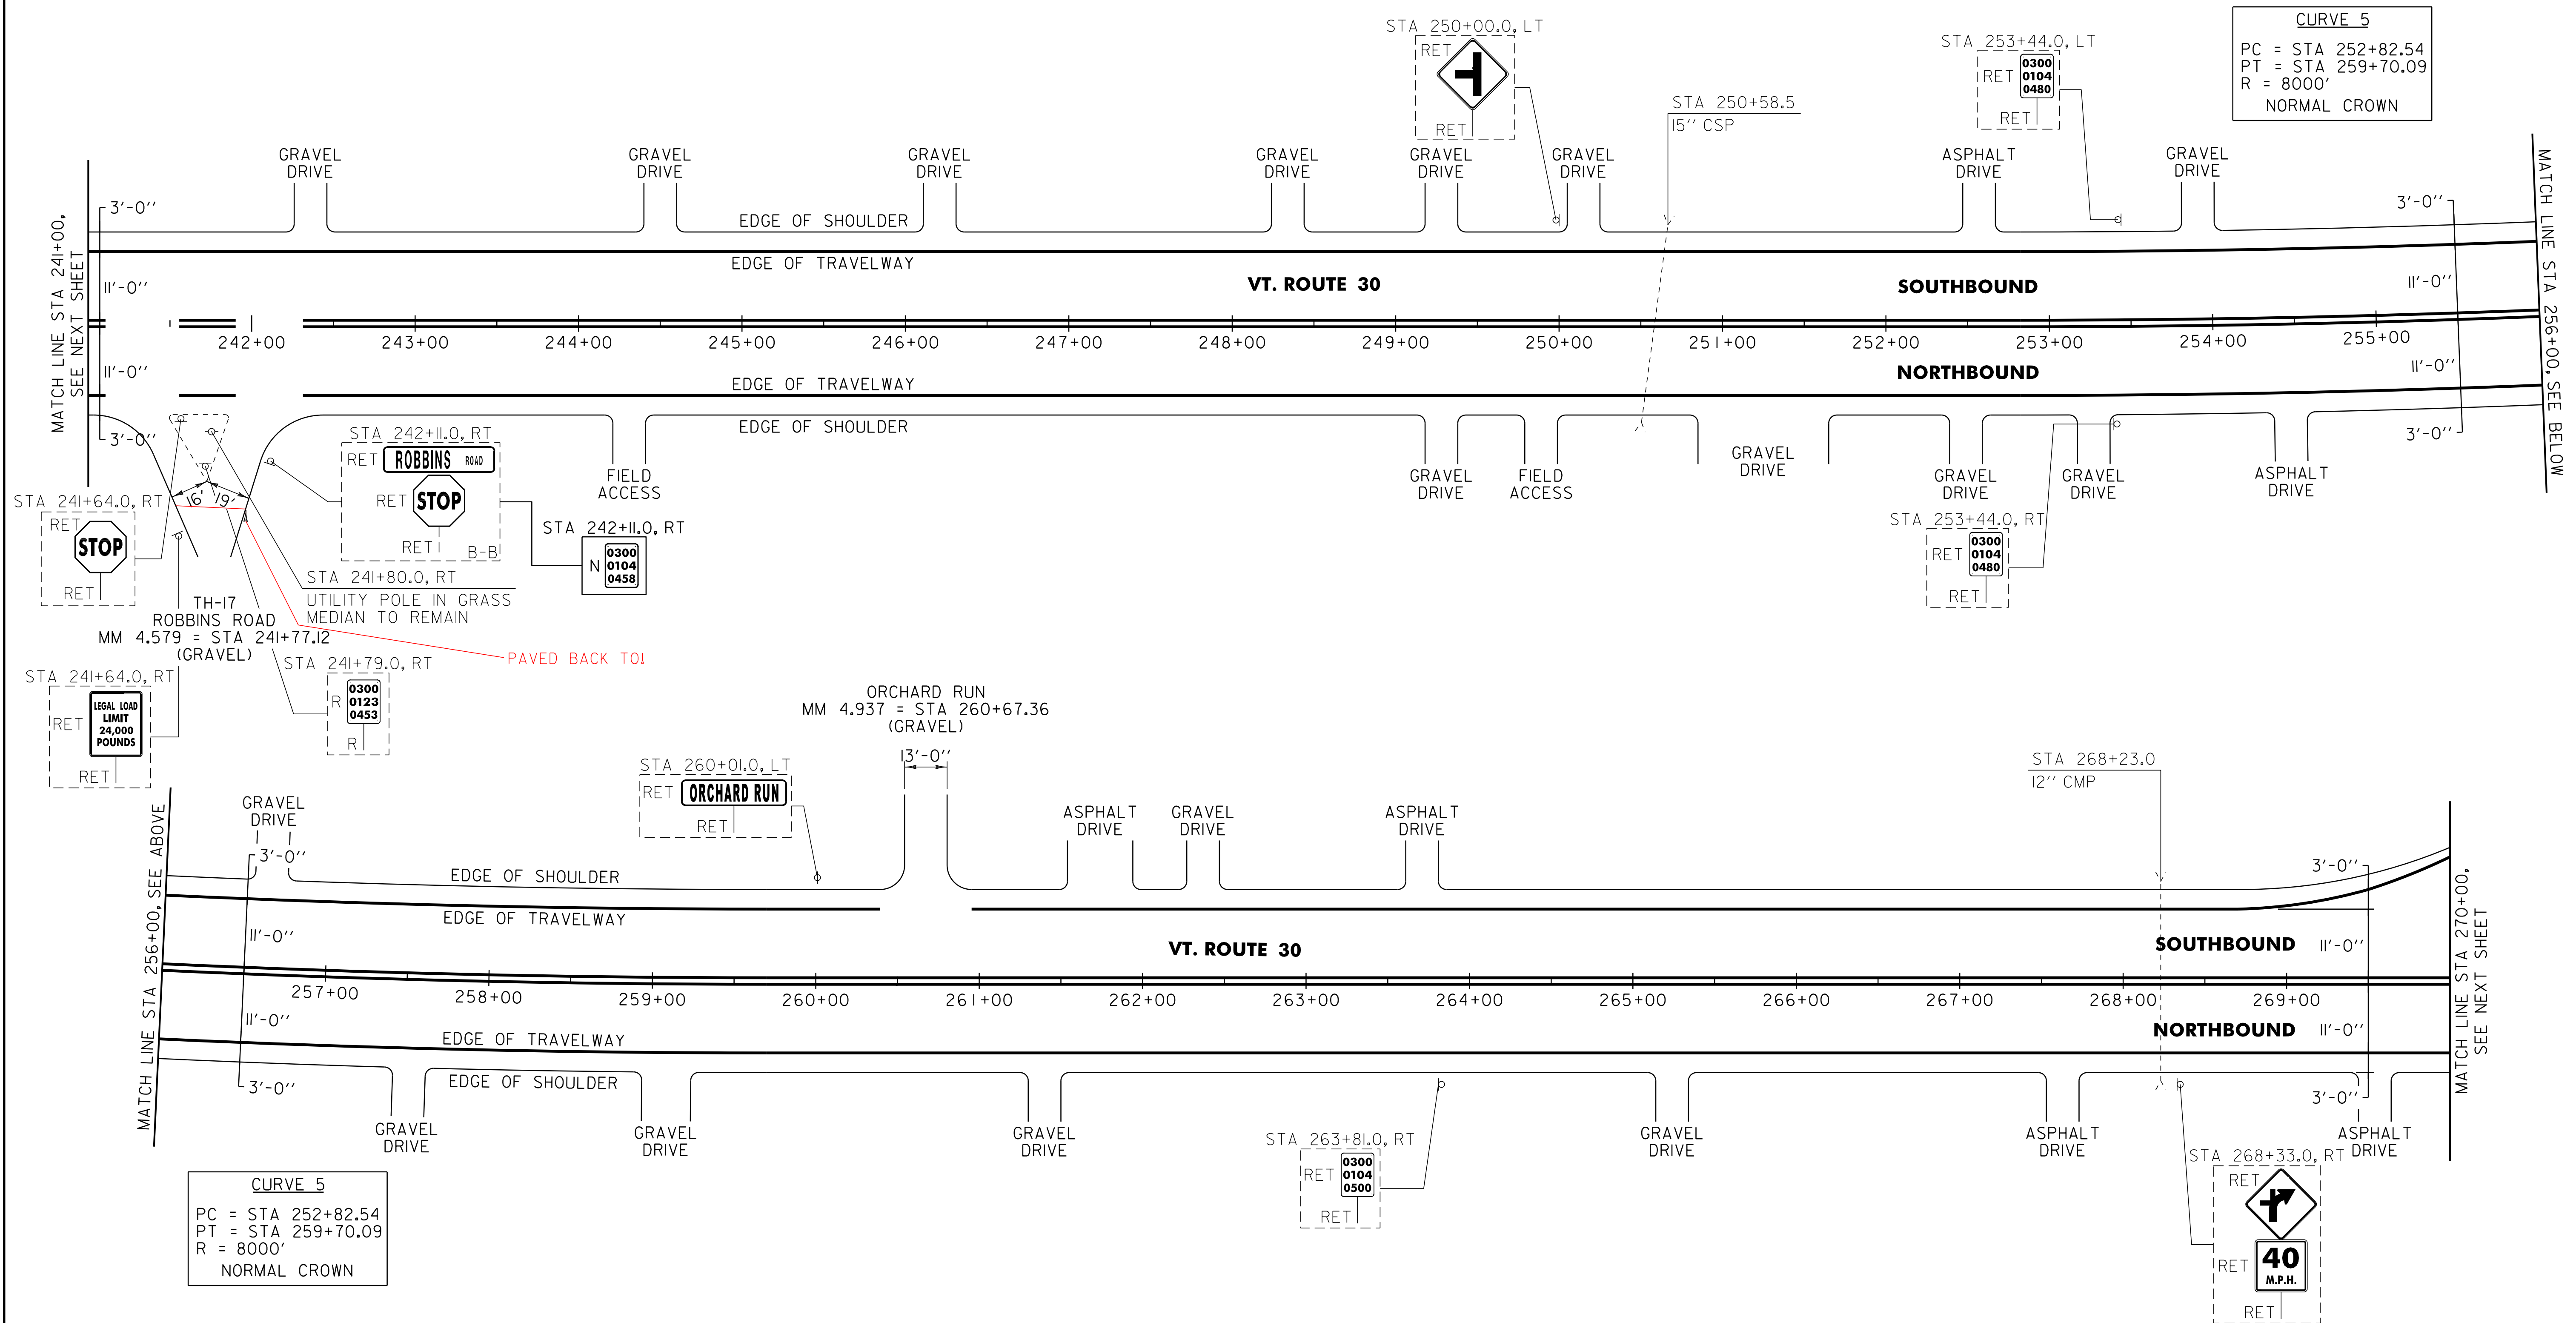

NOTES:

- PAVING LIMIT ON ALL TOWN HIGHWAYS SHALL BE MEASURED 25 FT BACK FROM VT. ROUTE 30 EDGE OF SHOULDER UNLESS DENOTED OTHERWISE ON THE PLANS OR AS DIRECTED BY THE RESIDENT ENGINEER.
- UNDERGROUND TELEPHONE UTILITIES TO BE RELOCATED AERIALY BY OTHERS UNDER STP EH 08(13) PRIOR TO ANY RECLAIM OPERATIONS.

AREA OF RECLAIMED  
 STABILIZED BASE

**SIGN LEGEND**  
 R = REMOVE  
 S = SALVAGE  
 N = NEW  
 RET = RETAIN  
 B-B = BACK TO BACK  
 EXISTING = - - - - -  
 NEW = \_\_\_\_\_

NOT TO SCALE

**PROJECT LAYOUT SHEET #19**

PROJECT NAME:	WHITING - MIDDLEBURY
PROJECT NUMBER:	STP 2629(I)
FILE NAME:	p06c226.dgn
PROJECT LEADER:	D.E.G.
DESIGNED BY:	M.J.L.
DWG. NO.	p06c226i19.i
PLOT DATE:	30-MAR-2012 14:13
DRAWN BY:	C.A.K.
CHECKED BY:	D.E.G.
SHEET	35 OF 133