

646.406 DURABLE 4 INCH WHITE LINE, RECESSED POLYUREA
 (ALL LINES WILL INCLUDE EDGE LINE BREAKS AND
 RADIUS FOR TOWN HIGHWAYS)
 CORNWALL:
 STA 270+00.00 - STA 284+00.00 EDGE LINE LT & RT

646.416 DURABLE 4 INCH YELLOW LINE, RECESSED POLYUREA
 (ALL LINES WILL INCLUDE C/L BREAKS FOR
 TOWN HIGHWAYS) S=SOLID, D=DASHED
 CORNWALL:
 STA 270+00.00 - STA 284+00.00 LT CL RT
 S - S
 STA 271+23.36 DOUBLE SOLID LT, TH-9
 STA 271+23.36 DOUBLE SOLID LT, TH-9
 STA 272+60.64 DOUBLE SOLID LT, TH-2

646.602 TEMPORARY 4 INCH WHITE LINE, PAINT
 (ALL LINES WILL INCLUDE EDGE LINE BREAKS AND
 RADIUS FOR TOWN HIGHWAYS)
 CORNWALL:
 STA 270+00.00 - STA 284+00.00 EDGE LINE LT & RT

646.612 TEMPORARY 4 INCH YELLOW LINE, PAINT
 (ALL LINES WILL INCLUDE C/L BREAKS FOR
 TOWN HIGHWAYS) S=SOLID, D=DASHED
 CORNWALL:
 STA 270+00.00 - STA 284+00.00 LT CL RT
 S - S
 STA 271+23.36 DOUBLE SOLID LT, TH-9
 STA 271+23.36 DOUBLE SOLID LT, TH-9
 STA 272+60.64 DOUBLE SOLID LT, TH-2

646.481 DURABLE 24 INCH STOP BAR, TYPE I TAPE
 CORNWALL:
 STA 271+23.36 LT, TH-9
 STA 271+23.36 LT, TH-9
 STA 272+60.64 LT, TH-2


646.682 TEMPORARY 24 INCH STOP BAR, PAINT
 CORNWALL:
 STA 271+23.36 LT, TH-9
 STA 271+23.36 LT, TH-9
 STA 272+60.64 LT, TH-2

646.491 DURABLE LETTER OR SYMBOL, TYPE I TAPE
 CORNWALL:
 STA 271+23.36 LT, TH-9 "S,T,O,P" (4 EA)
 STA 271+23.36 LT, TH-9 "S,T,O,P" (4 EA)
 STA 272+60.64 LT, TH-2 "S,T,O,P" (4 EA)

646.692 TEMPORARY LETTER OR SYMBOL, PAINT
 CORNWALL:
 STA 271+23.36 LT, TH-9 "S,T,O,P" (4 EA)
 STA 271+23.36 LT, TH-9 "S,T,O,P" (4 EA)
 STA 272+60.64 LT, TH-2 "S,T,O,P" (4 EA)

675.50 REMOVING SIGNS
 AS SHOWN - 2

675.60 ERECTING SALVAGED SIGNS
 AS SHOWN - 1

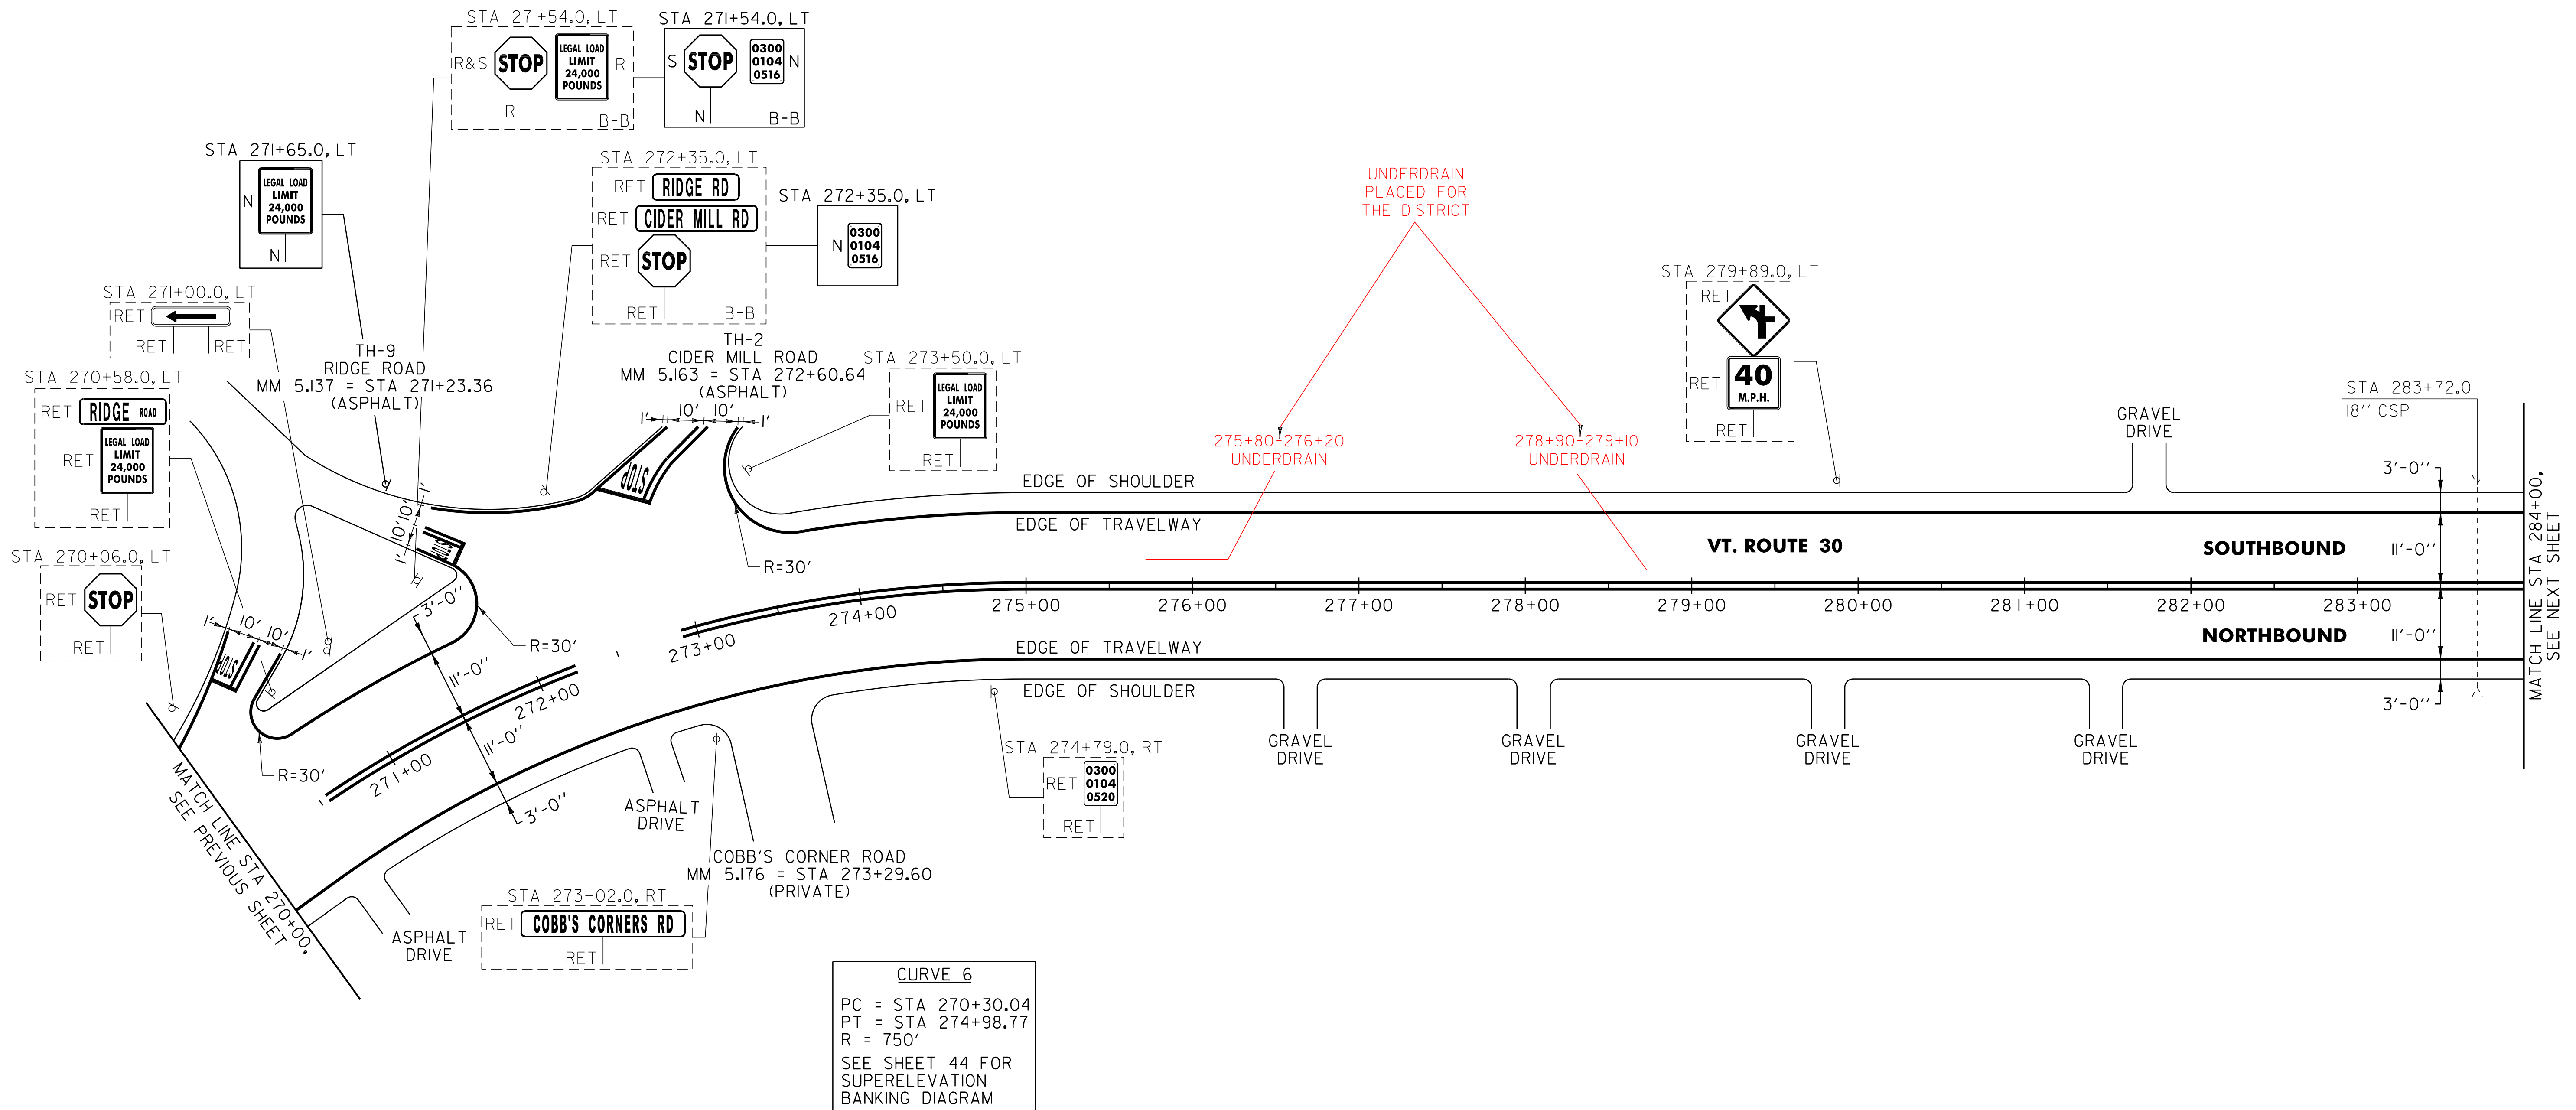

NOTES:

- PAVING LIMIT ON ALL TOWN HIGHWAYS SHALL BE MEASURED 25 FT BACK FROM VT. ROUTE 30 EDGE OF SHOULDER UNLESS DENOTED OTHERWISE ON THE PLANS OR AS DIRECTED BY THE RESIDENT ENGINEER.
- UNDERGROUND TELEPHONE UTILITIES TO BE RELOCATED AERIALLY BY OTHERS UNDER STP EH 08(13) PRIOR TO ANY RECLAIM OPERATIONS.

SIGN LEGEND
 R = REMOVE
 S = SALVAGE
 N = NEW
 RET = RETAIN
 B-B = BACK TO BACK
 EXISTING = - - - - -
 NEW = _____

NOT TO SCALE

PROJECT LAYOUT SHEET #20

PROJECT NAME:	WHITING - MIDDLEBURY
PROJECT NUMBER:	STP 2629(1)
FILE NAME:	p06c226.dgn
PROJECT LEADER:	D.E.G.
DESIGNED BY:	M.J.L.
DWG. NO.	p06c226(20.1)
PLOT DATE:	30-MAR-2012 14:13
DRAWN BY:	C.A.K.
CHECKED BY:	D.E.G.
SHEET	36 OF 133

AREA OF RECLAIMED STABILIZED BASE