


646.406 DURABLE 4 INCH WHITE LINE, RECESSED POLYUREA  
 (ALL LINES WILL INCLUDE EDGE LINE BREAKS AND  
 RADIUS FOR TOWN HIGHWAYS)  
 CORNWALL:  
 STA 284+00.00 - STA 298+00.00 EDGE LINE LT & RT

646.602 TEMPORARY 4 INCH WHITE LINE, PAINT  
 (ALL LINES WILL INCLUDE EDGE LINE BREAKS AND  
 RADIUS FOR TOWN HIGHWAYS)  
 CORNWALL:  
 STA 284+00.00 - STA 298+00.00 EDGE LINE LT & RT

646.416 DURABLE 4 INCH YELLOW LINE, RECESSED POLYUREA  
 (ALL LINES WILL INCLUDE C/L BREAKS FOR  
 TOWN HIGHWAYS) S=SOLID, D=DASHED  
 CORNWALL:  
 STA 284+00.00 - STA 298+00.00 LT C RT  
 S - S

646.612 TEMPORARY 4 INCH YELLOW LINE, PAINT  
 (ALL LINES WILL INCLUDE C/L BREAKS FOR  
 TOWN HIGHWAYS) S=SOLID, D=DASHED  
 CORNWALL:  
 STA 284+00.00 - STA 298+00.00 LT C RT  
 S - S

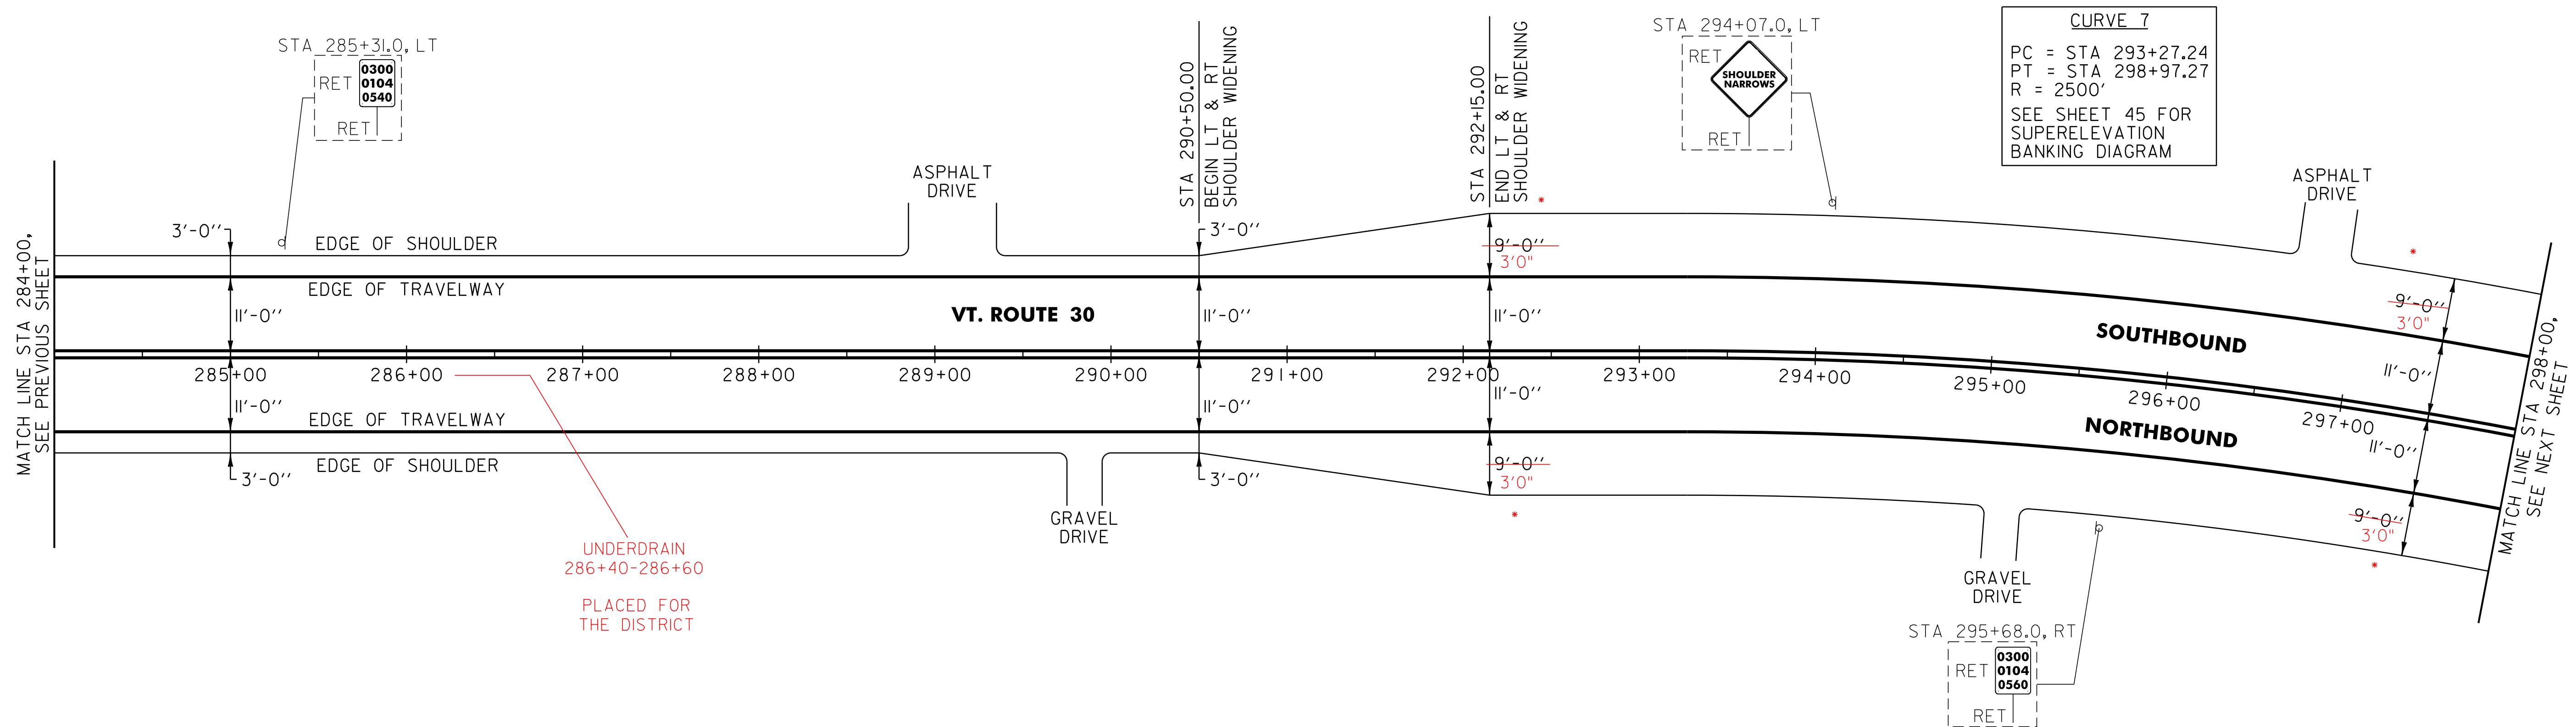

AREA OF RECLAIMED  
 STABILIZED BASE

**SIGN LEGEND**  
 R = REMOVE  
 S = SALVAGE  
 N = NEW  
 RET = RETAIN  
 B-B = BACK TO BACK  
 EXISTING = - - - - -  
 NEW = \_\_\_\_\_

|                                 |                                    |  |
|---------------------------------|------------------------------------|--|
| <b>PROJECT LAYOUT SHEET #21</b> | <b>NOT TO SCALE</b>                |  |
|                                 | PROJECT NAME: WHITING - MIDDLEBURY |  |
|                                 | PROJECT NUMBER: STP 2629(I)        |  |
| FILE NAME: p06c226.dgn          | PLOT DATE: 30-MAR-2012 14:13       |  |
| PROJECT LEADER: D.E.G.          | DRAWN BY: C.A.K.                   |  |
| DESIGNED BY: M.J.L.             | CHECKED BY: D.E.G.                 |  |
| DWG. NO. p06c226i21.i           | SHEET 37 OF 133                    |  |