


646.406 DURABLE 4 INCH WHITE LINE, RECESSED POLYUREA
 (ALL LINES WILL INCLUDE EDGE LINE BREAKS AND
 RADIUS FOR TOWN HIGHWAYS)
 CORNWALL:
 STA 298+00.00 - STA 327+00.00 EDGE LINE LT & RT

646.416 DURABLE 4 INCH YELLOW LINE, RECESSED POLYUREA
 (ALL LINES WILL INCLUDE C/L BREAKS FOR
 TOWN HIGHWAYS) S=SOLID, D=DASHED
 CORNWALL:
 STA 298+00.00 - STA 325+25.00 LT @ RT
 STA 325+25.00 - STA 327+00.00 S - S
 S - D

646.602 TEMPORARY 4 INCH WHITE LINE, PAINT
 (ALL LINES WILL INCLUDE EDGE LINE BREAKS AND
 RADIUS FOR TOWN HIGHWAYS)
 CORNWALL:
 STA 298+00.00 - STA 327+00.00 EDGE LINE LT & RT

646.612 TEMPORARY 4 INCH YELLOW LINE, PAINT
 (ALL LINES WILL INCLUDE C/L BREAKS FOR
 TOWN HIGHWAYS) S=SOLID, D=DASHED
 CORNWALL:
 STA 298+00.00 - STA 325+25.00 LT @ RT
 STA 325+25.00 - STA 327+00.00 S - S
 S - D

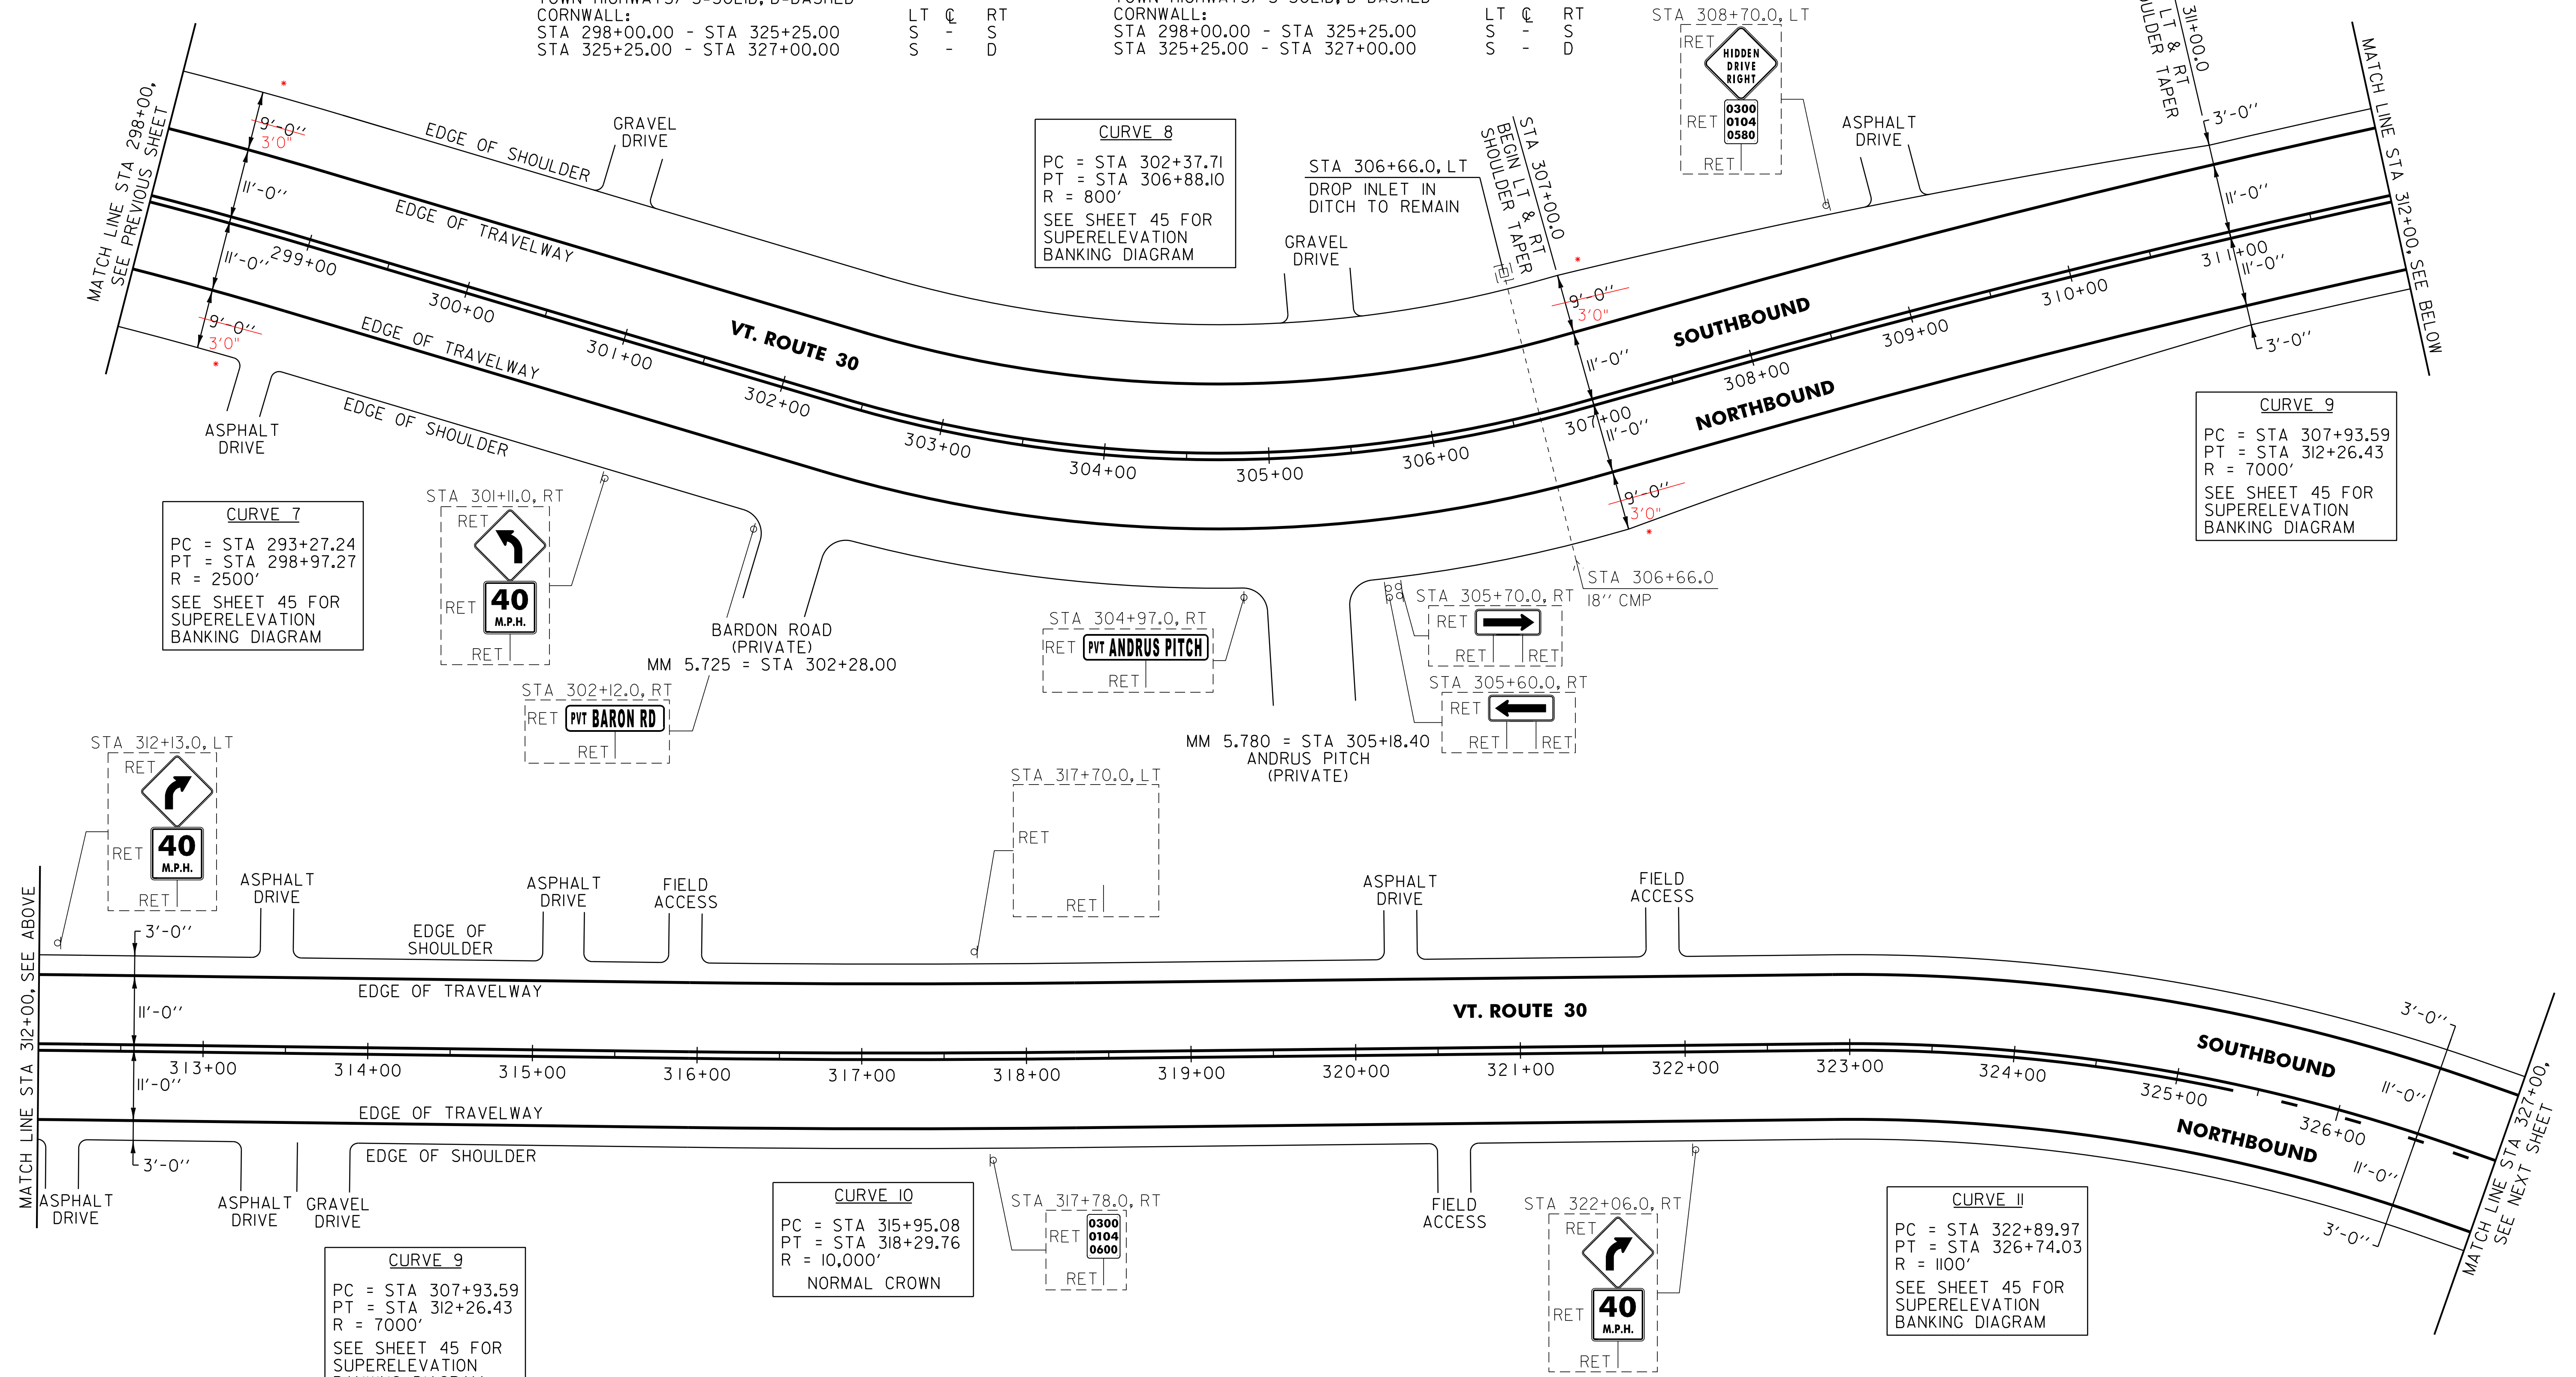

AREA OF RECLAIMED
 STABILIZED BASE

SIGN LEGEND
 R = REMOVE
 S = SALVAGE
 N = NEW
 RET = RETAIN
 B-B = BACK TO BACK
 EXISTING = - - - - -
 NEW = _____

NOT TO SCALE

PROJECT LAYOUT SHEET #22

PROJECT NAME:	WHITING - MIDDLEBURY
PROJECT NUMBER:	STP 2629(I)
FILE NAME:	p06c226.dgn
PROJECT LEADER:	D.E.G.
DESIGNED BY:	M.J.L.
DWG. NO.	p06c226i22.1
PLOT DATE:	30-MAR-2012 14:13
DRAWN BY:	C.A.K.
CHECKED BY:	D.E.G.
SHEET	38 OF 133