

646.416 DURABLE 4 INCH YELLOW LINE, RECESSED POLYUREA
 (ALL LINES WILL INCLUDE C/L BREAKS FOR TOWN HIGHWAYS) S=SOLID, D=DASHED
 CORNWALL:
 STA 194+72.64 DOUBLE SOLID LT, VT. ROUTE 74

646.612 TEMPORARY 4 INCH YELLOW LINE, PAINT
 (ALL LINES WILL INCLUDE C/L BREAKS FOR TOWN HIGHWAYS) S=SOLID, D=DASHED
 CORNWALL:
 STA 194+72.64 DOUBLE SOLID LT, VT. ROUTE 74

646.481 DURABLE 24 INCH STOP BAR, TYPE 1 TAPE
 CORNWALL:
 STA 194+72.64 LT, VT. ROUTE 74


646.682 TEMPORARY 24 INCH STOP BAR, PAINT
 CORNWALL:
 STA 194+72.64 LT, VT. ROUTE 74

646.491 DURABLE LETTER OR SYMBOL, TYPE 1 TAPE
 CORNWALL:
 STA 194+72.64 LT, VT. ROUTE 74 "S,T,O,P" (4 EA)

646.692 TEMPORARY LETTER OR SYMBOL, PAINT
 CORNWALL:
 STA 194+72.64 LT, VT. ROUTE 74 "S,T,O,P" (8 EA)


675.50 REMOVING SIGNS
 AS SHOWN - 3

675.60 ERECTING SALVAGED SIGNS
 AS SHOWN - 2

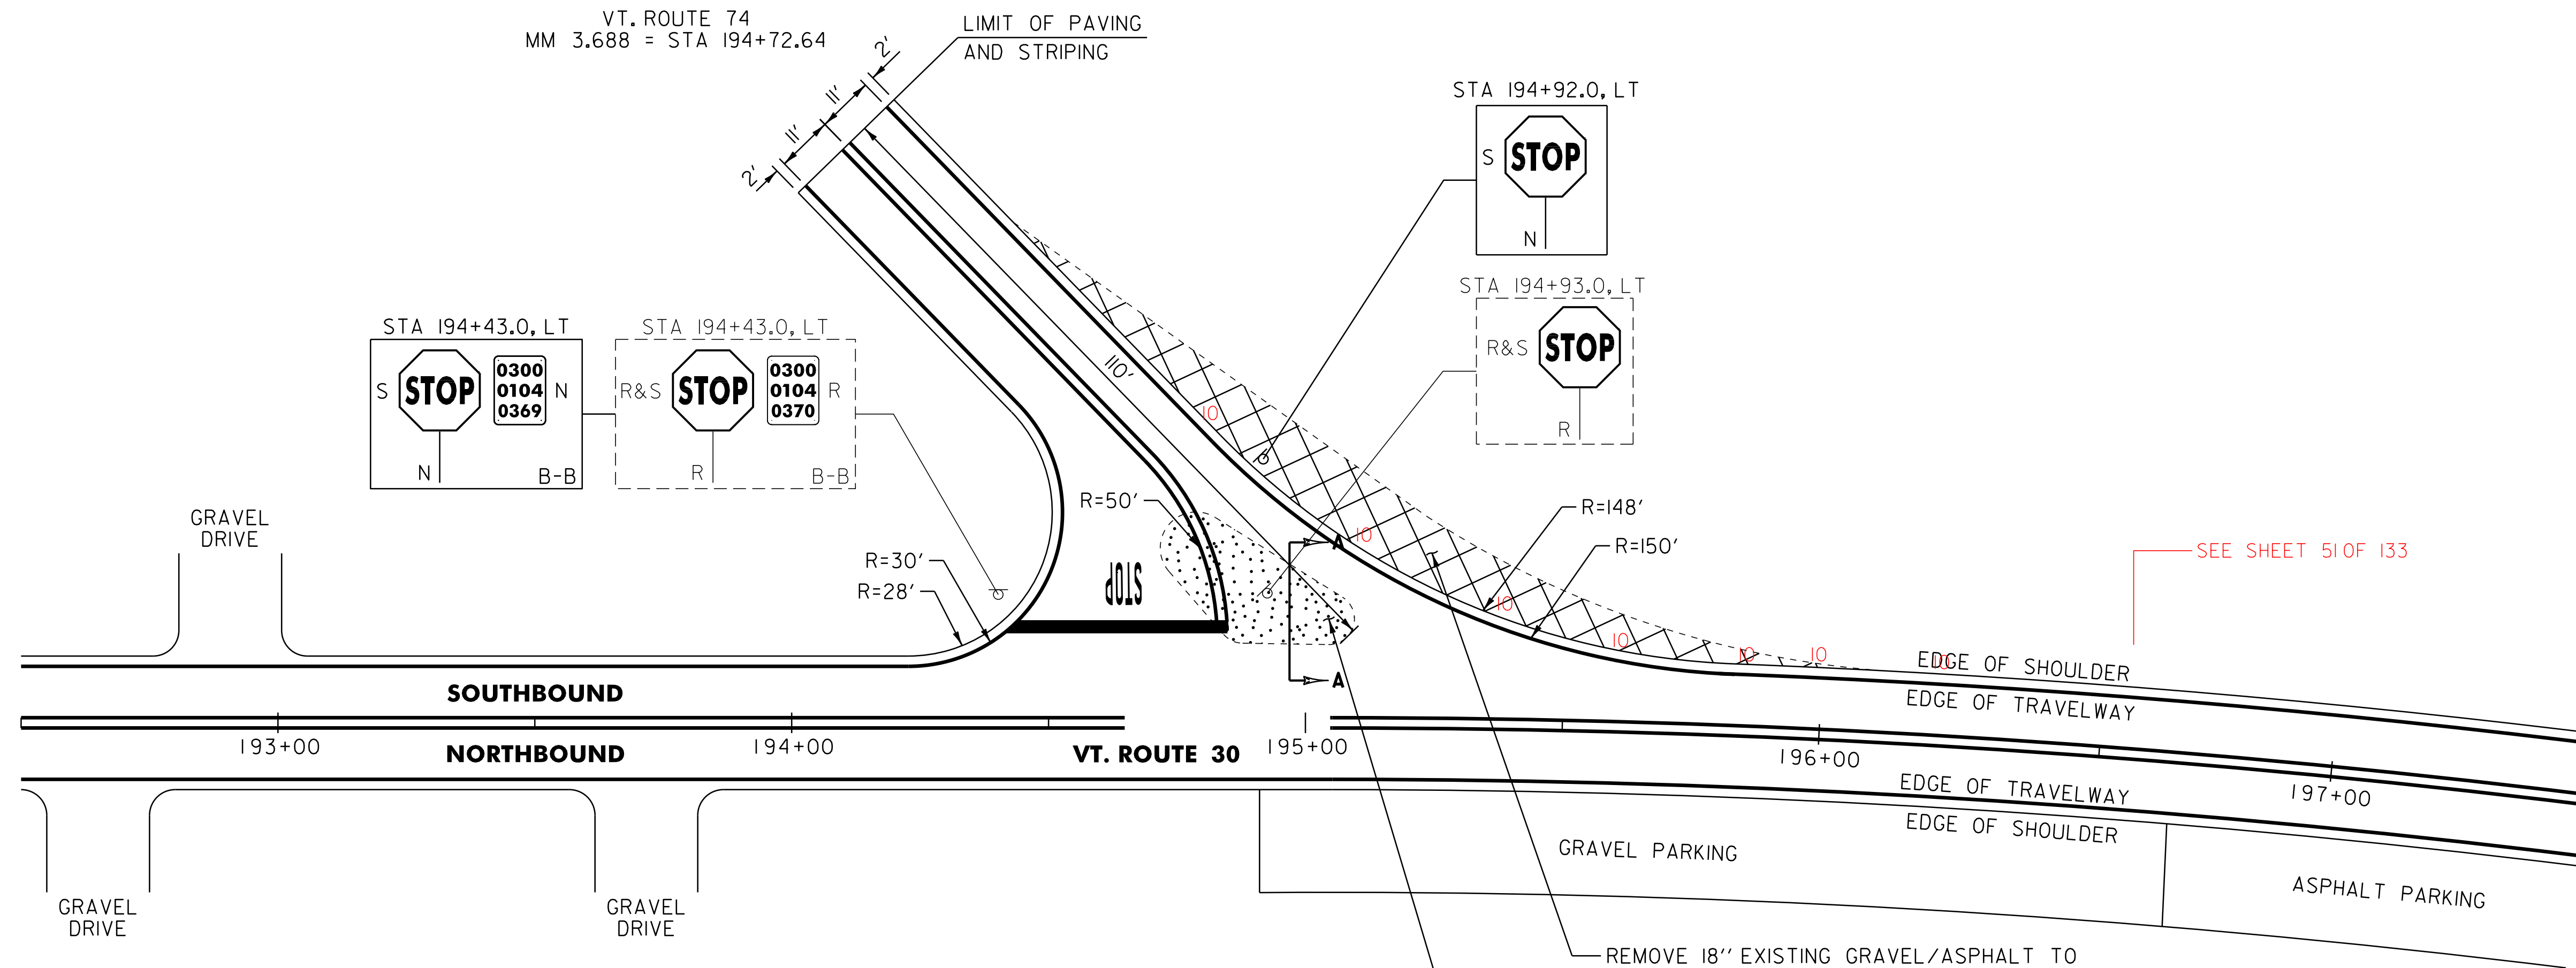

REMOVE 18" EXISTING GRAVEL/ASPHALT TO BE PAID FOR UNDER ITEM 203.15 COMMON EXCAVATION AND REPLACE WITH EARTH- DITCHING MATERIAL USED
 BORROW, 4" TOPSOIL, SEED AND TEMPORARY EROSION MATTING AS DIRECTED BY THE RESIDENT ENGINEER, GRADE TO DRAIN.

EXCAVATE UNDER ITEM 203.15 COMMON EXCAVATION AND PAVE AS DIRECTED BY THE RESIDENT ENGINEER. SEE SECTION A-A.

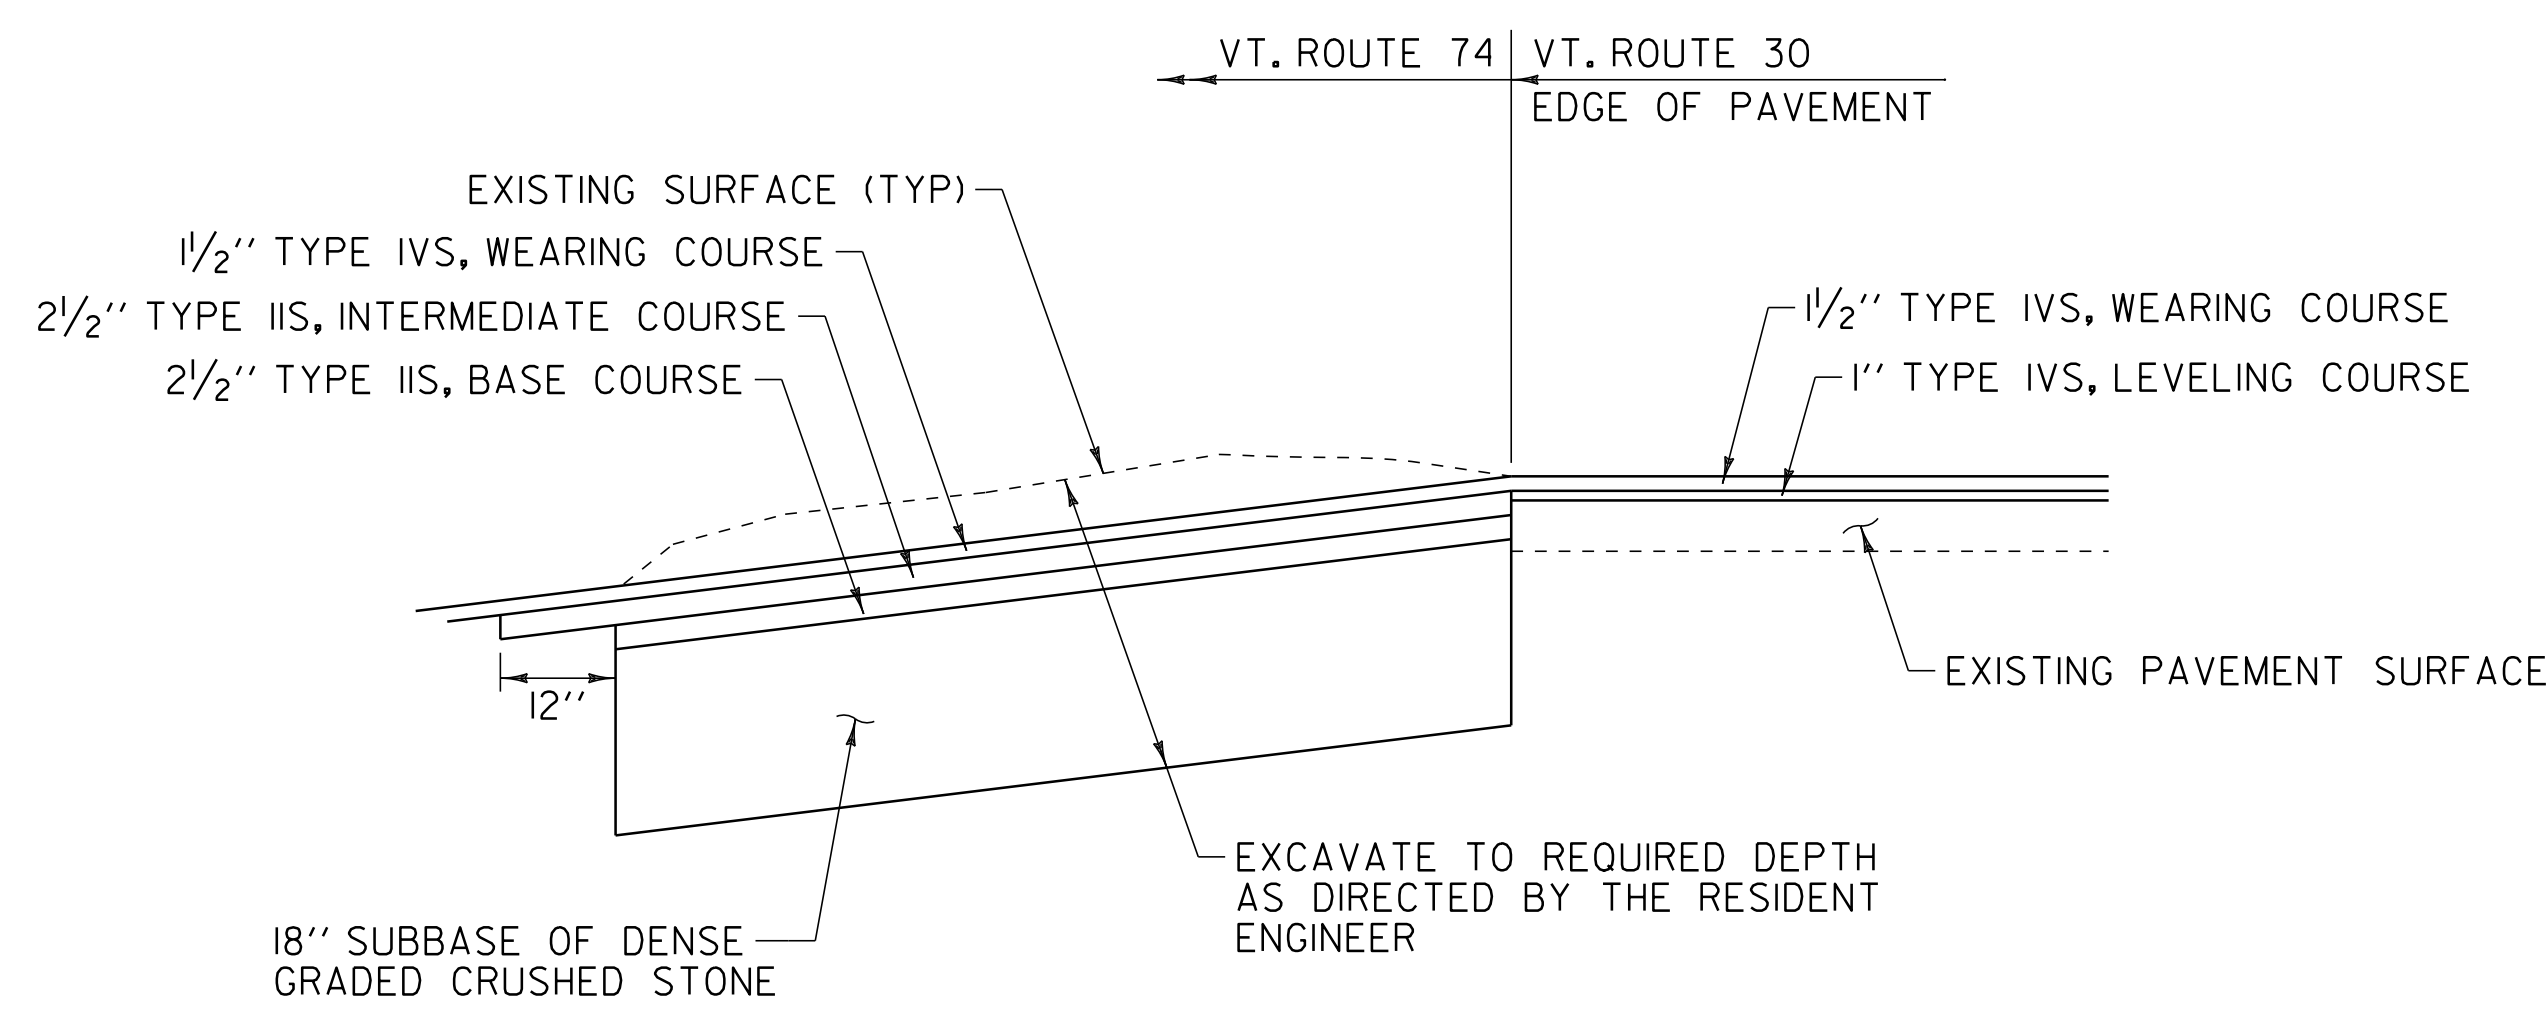

SECTION A-A

653.20 TEMPORARY EROSION MATTING
 STA 194+40.0 - STA 196+10.0, LT (119 SY)

SIGN LEGEND
 R = REMOVE
 S = SALVAGE
 N = NEW
 RET = RETAIN
 B-B = BACK TO BACK
 EXISTING = - - - - -
 NEW = _____

NOT TO SCALE	
VT. ROUTE 74 INTERSECTION DETAIL SHEET	PROJECT NAME: WHITING - MIDDLEBURY
	PROJECT NUMBER: STP 2629(1)
	FILE NAME: p06c226.dgn
	PROJECT LEADER: D.E.G.
	DESIGNED BY: M.J.L.
	DWG. NO. p06c2261n+2.1
	PLOT DATE: 30-MAR-2012 14:14
	DRAWN BY: C.A.K.
	CHECKED BY: D.E.G.
	SHEET 42 OF 133