
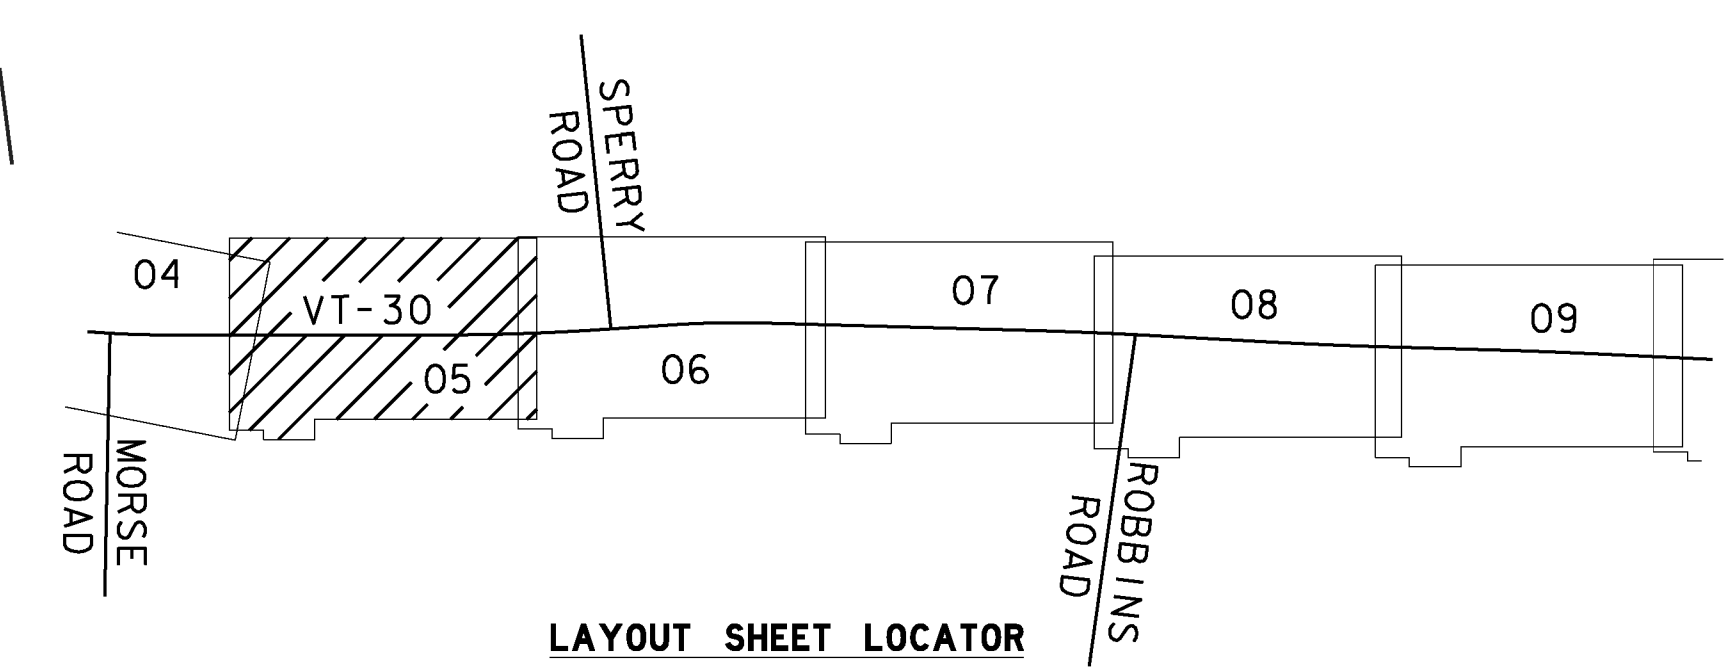
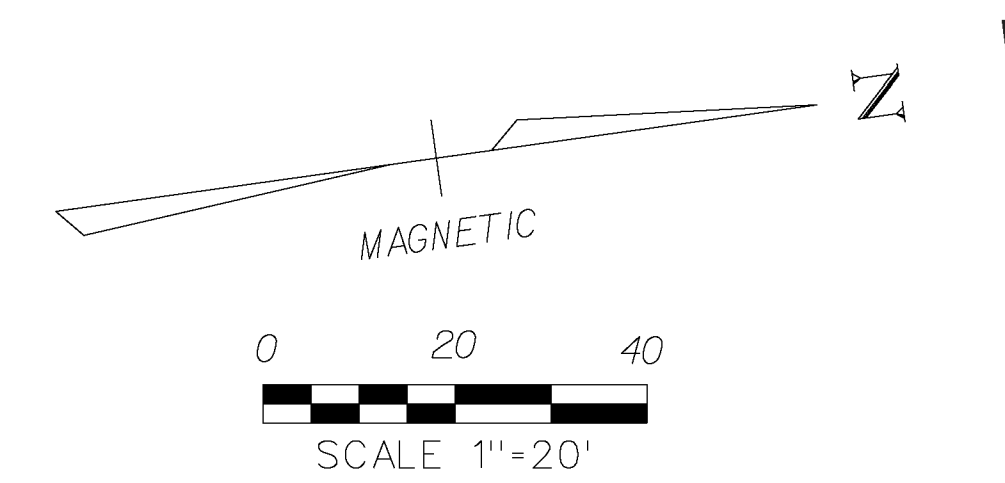


LIMITS OF WORK		
STA 223+03 - 223+93	LT	
STA 223+03 - 225+41	RT	
STA 227+83 - 228+38	RT	

LEGEND	
EXISTING EDGE OF PAVEMENT	-----
EXISTING CULVERT	=====
EXISTING STONE WALL	-----
EXISTING FENCE	x-x-x
EXISTING TREE LINE	~*~*~*~
EXISTING TREES	⊗
WETLAND BOUNDARY	~*~*~*~
TOE OF SLOPE	-----
TOE OF CUT	-----
EXISTING RIGHT OF WAY	-----
EXISTING SIDELINES	-----
PROJECT DEMARCATION FENCE	PDF-PDF
EROSION LOG	*-*-*
TEMPORARY INLET PROTECTION	⊕
EROSION MATTING	▨
STONE FILL	▩
CULVERT FLOW DIRECTION	→

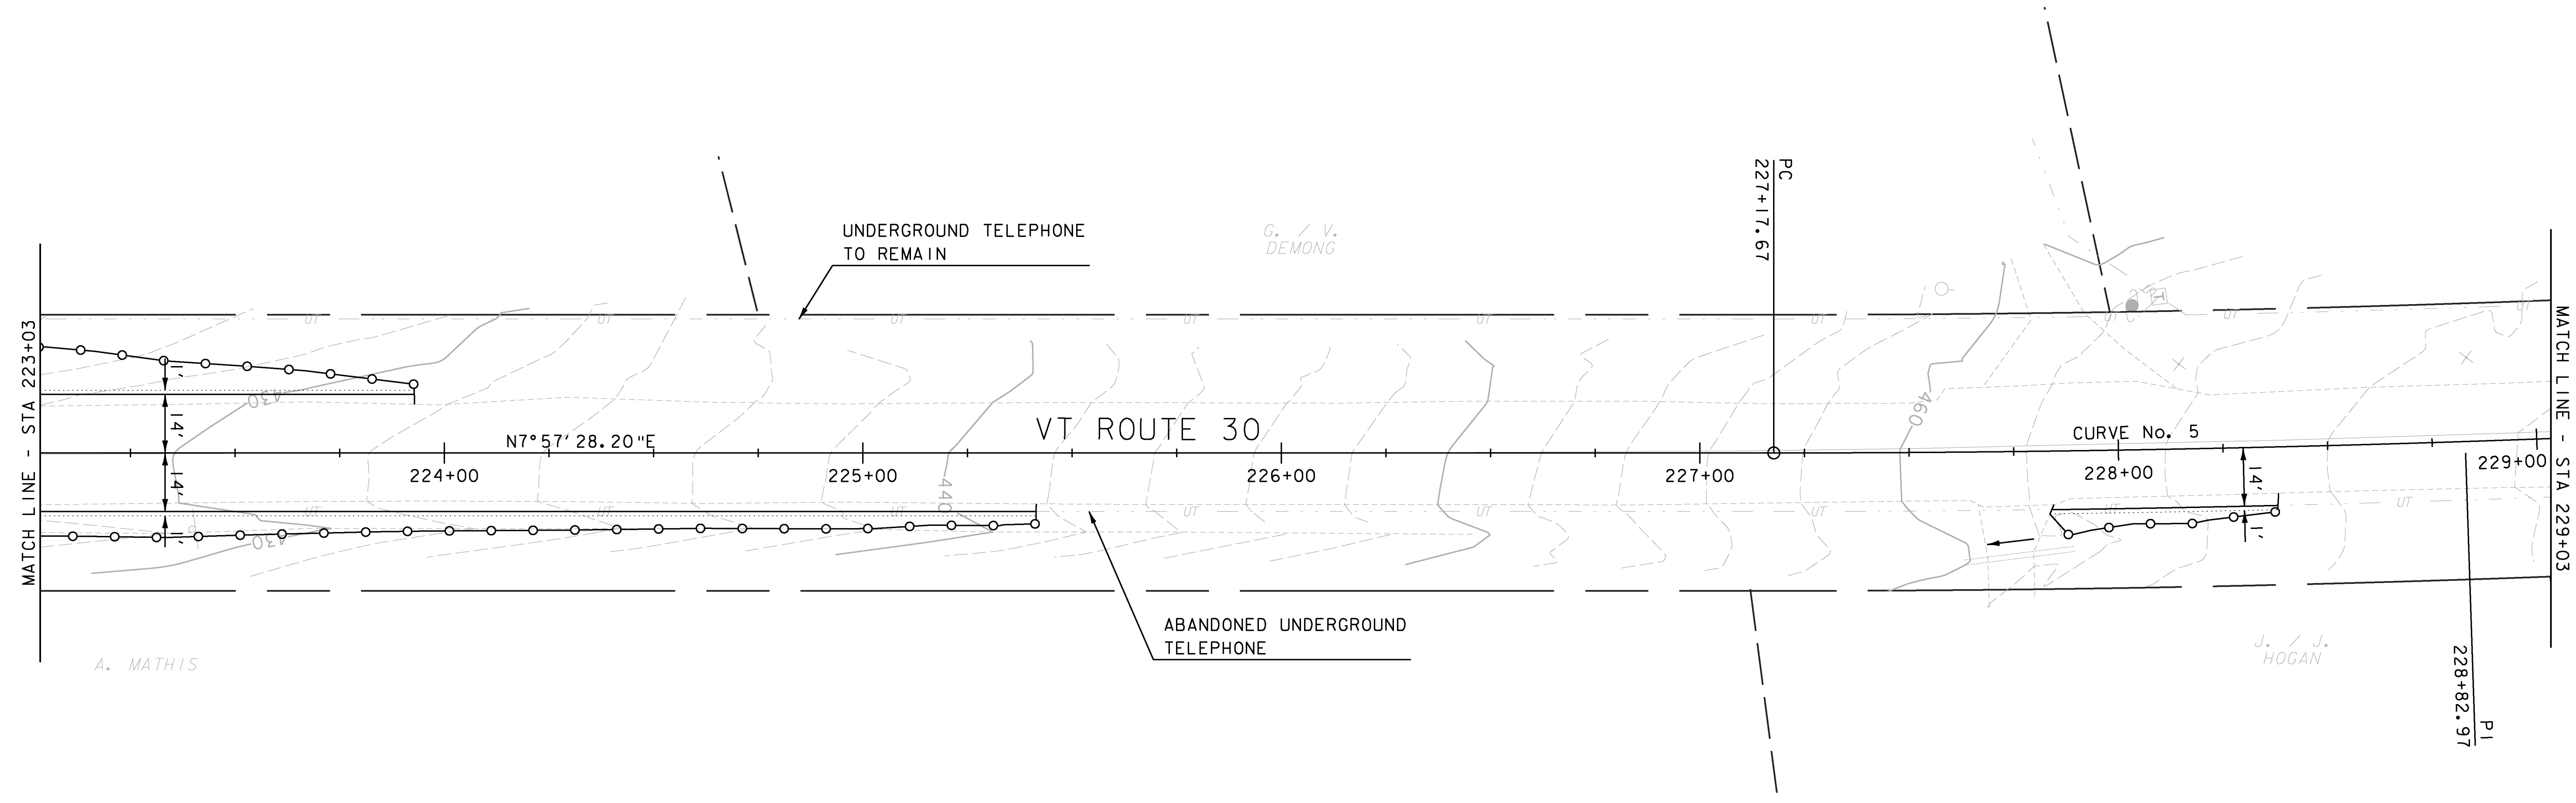


CURVE No. 5 DATA
 $\Delta = 3^\circ 47' 14''$ LT
 $R = 5000.00$ FT
 $T = 165.30$ FT
 $L = 330.49$ FT
 $E = 2.73$ FT
 $D = 1^\circ 08' 45''$

NO.	DATE	REVISIONS	BY	CK'D

DATUM
 VERTICAL NAVD 88
 HORIZONTAL NAD 83

R S G INC.
 RESOURCE SYSTEMS GROUP, INC.
 60 Lake Street, Unit 1E • Burlington, Vermont 05401
 TEL 802.383.0118 • FAX 802.383.0122 • www.rsginc.com

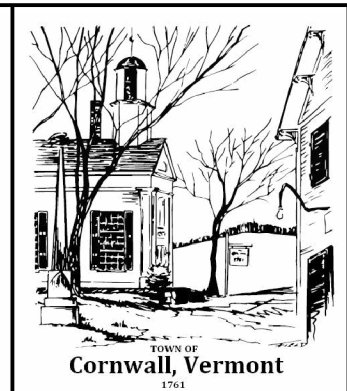

PROJECT NAME: CORNWALL - MIDDLEBURY
 PROJECT NUMBER: STP EH08(13)
 FILE NAME: Z08F122BDR NU.DGN
 PROJECT LEADER: MS
 DESIGNED BY: CM
 LAYOUT SHEET 5

PLOT DATE: 06/09/2010
 DRAWN BY: CM
 CHECKED BY: MS
 SHEET 62 OF 133