



LIMITS OF WORK		
STA 229+32 - 229+78	LT	
STA 231+53 - 232+10	RT	
STA 232+72 - 234+34	LT	
STA 232+79 - 235+03	RT	

ITEM 601.0010 - 15" CSP (0.064, 2-2/3 X 1/2)
STA. 233+91 LT & RT


ITEM 613.11 - STONE FILL, TYPE I
STA 233+91 27.0 RT

ITEM 653.40 - INLET PROTECTION DEVICE, TYPE I
STA 233+91 23.3 LT

LEGEND	
EXISTING EDGE OF PAVEMENT	-----
EXISTING CULVERT	=====
EXISTING STONE WALL	o-o-o-o-o-o-o-o
EXISTING FENCE	x-x-x-x-x-x-x-x
EXISTING TREE LINE	o-o-o-o-o-o-o-o
EXISTING TREES	o-o-o-o-o-o-o-o
WETLAND BOUNDARY	o-o-o-o-o-o-o-o
TOE OF SLOPE	o-o-o-o-o-o-o-o
TOE OF CUT	o-o-o-o-o-o-o-o
EXISTING RIGHT OF WAY	-----
EXISTING SIDELINES	-----
PROJECT DEMARCATION FENCE	PDF-PDF-PDF
EROSION LOG	*-*-*-*
TEMPORARY INLET PROTECTION	o-o-o-o-o-o-o-o
EROSION MATTING	o-o-o-o-o-o-o-o
STONE FILL	o-o-o-o-o-o-o-o
CULVERT FLOW DIRECTION	→

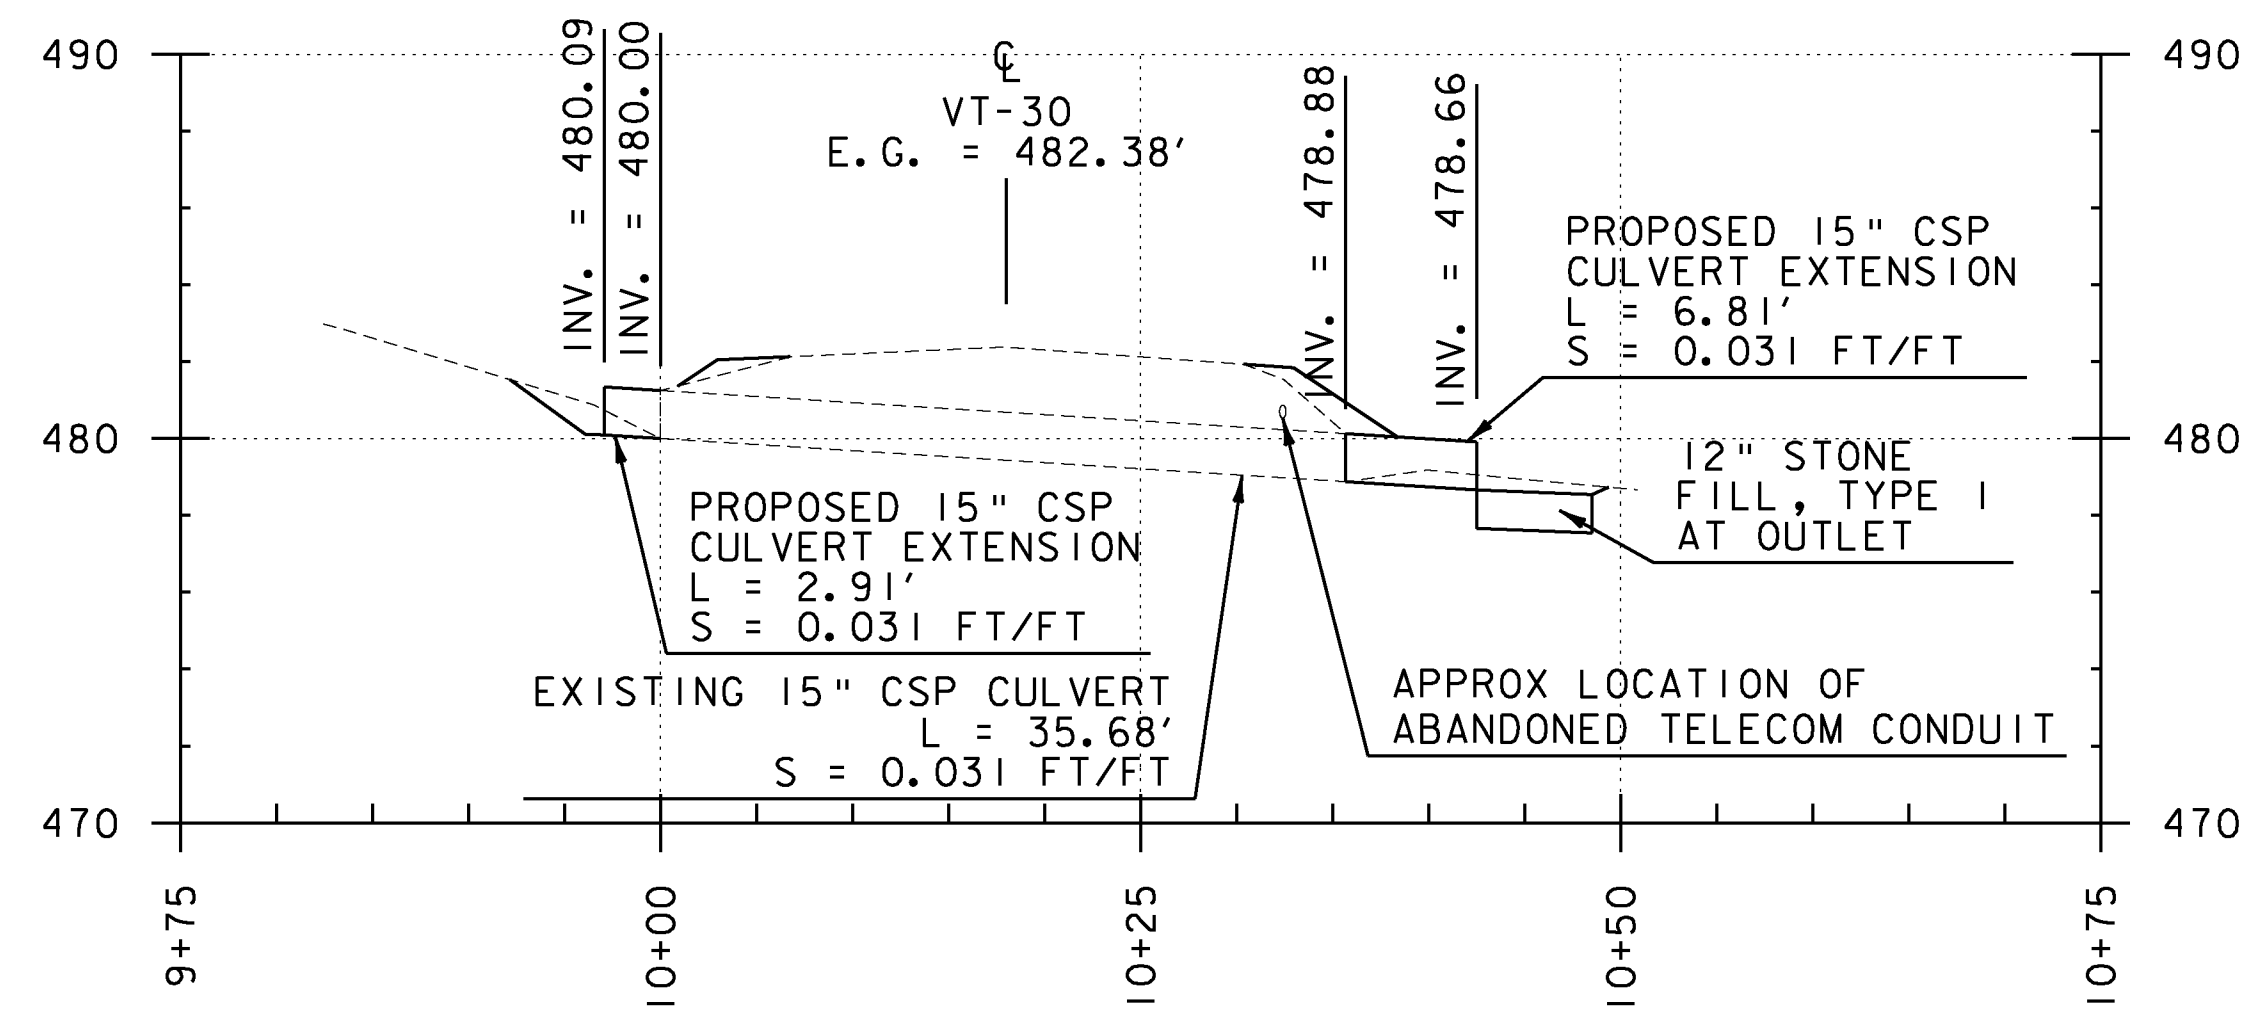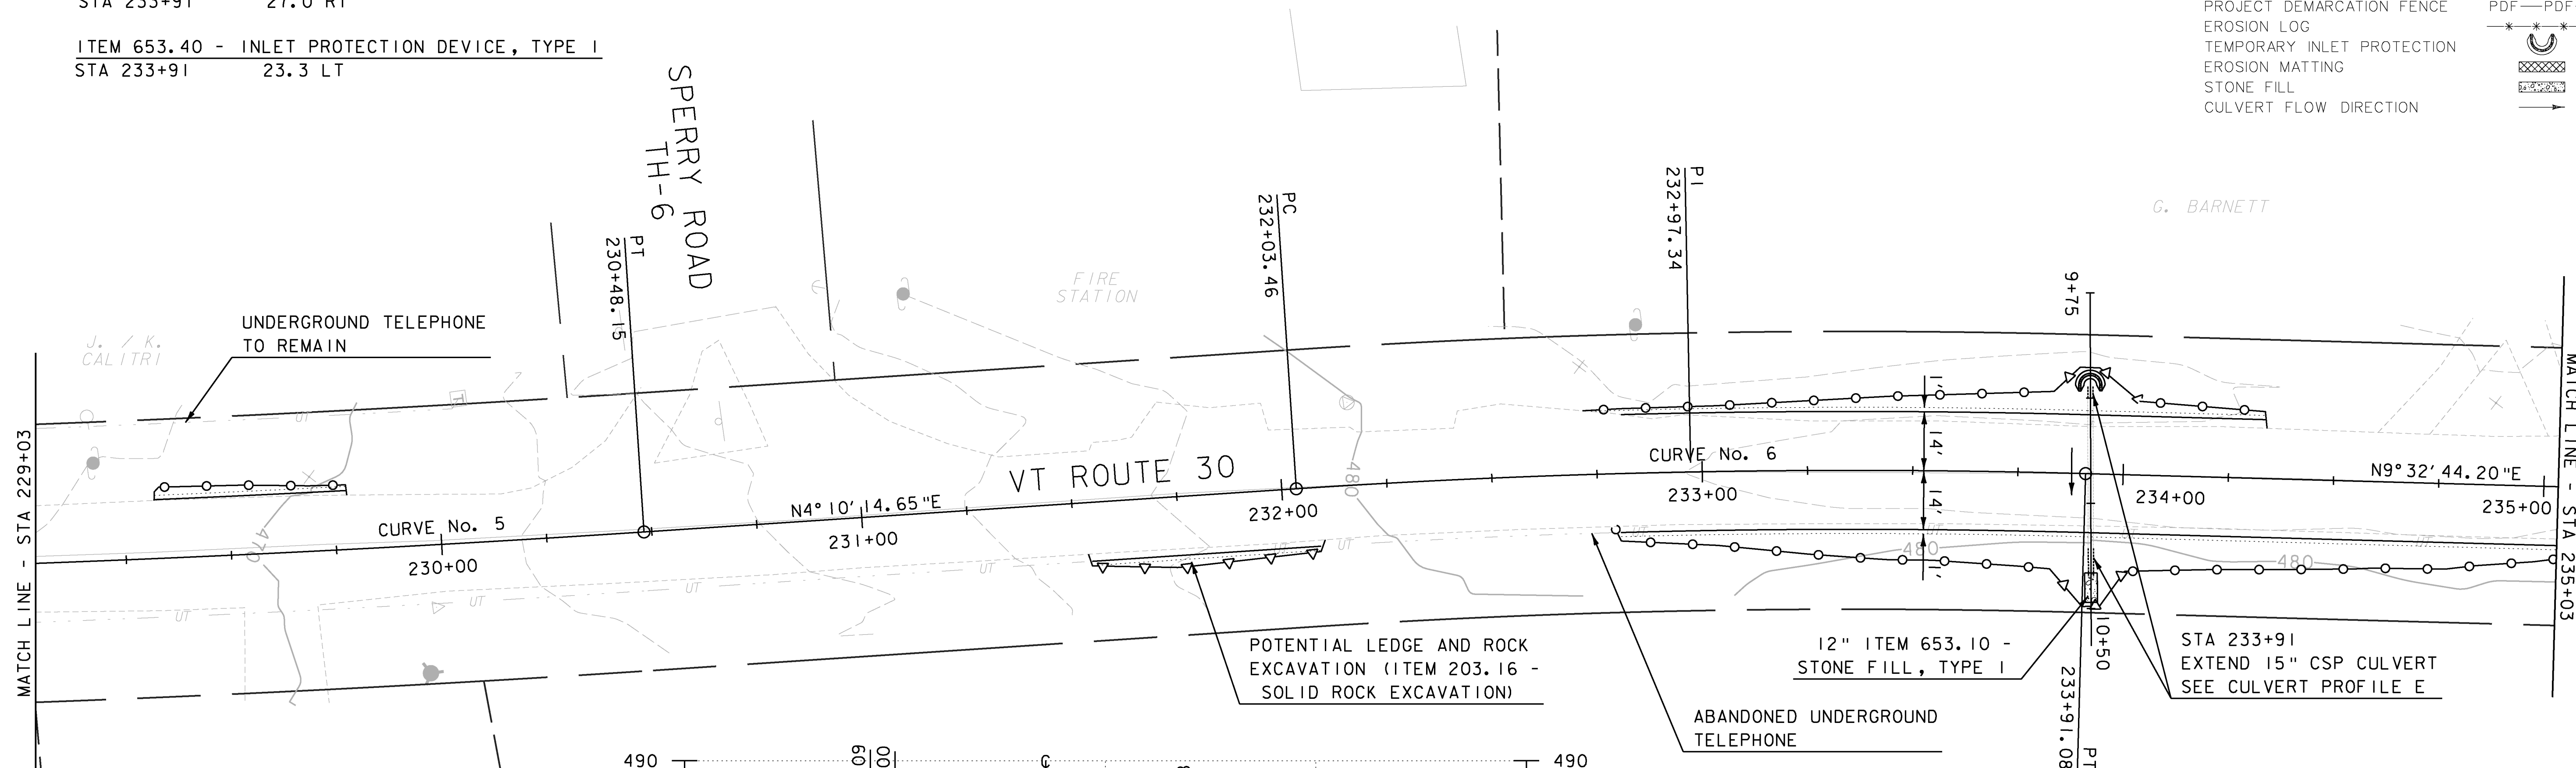

STA 233+91
CULVERT PROFILE E
SCALE:
1"=10' H
1"=5' V

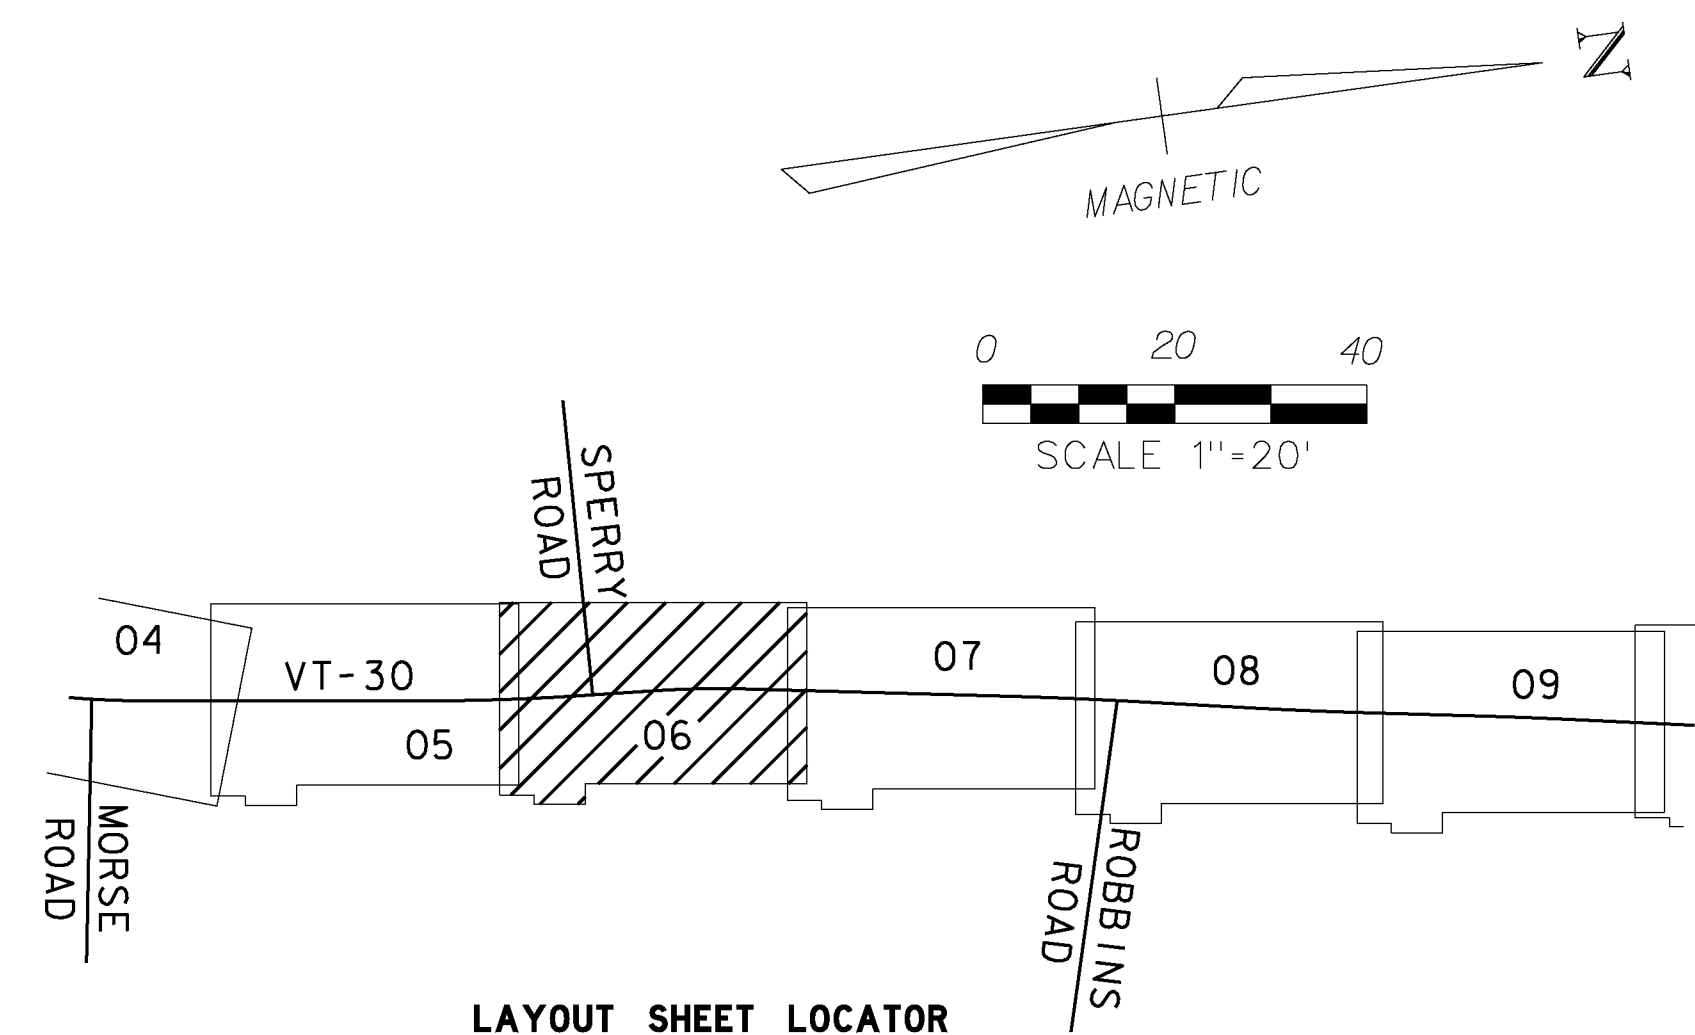


LAYOUT SHEET LOCATOR

CURVE No. 5 DATA	CURVE No. 6 DATA
$\Delta = 3^{\circ}47'14''$ LT	$\Delta = 5^{\circ}22'30''$ RT
R = 5000.00 FT	R = 2000.00 FT
T = 165.30 FT	T = 93.88 FT
L = 330.49 FT	L = 187.62 FT
E = 2.73 FT	E = 2.20 FT
D = $1^{\circ}08'45''$	D = $2^{\circ}51'53''$

DATUM	
VERTICAL	NAVD 88
HORIZONTAL	NAD 83

NO.	DATE	REVISIONS	BY	CK'D

R S G INC.
RESOURCE SYSTEMS GROUP, INC.
60 Lake Street, Unit 1E • Burlington, Vermont 05401
TEL 802.383.0118 • FAX 802.383.0122 • www.rsginc.com

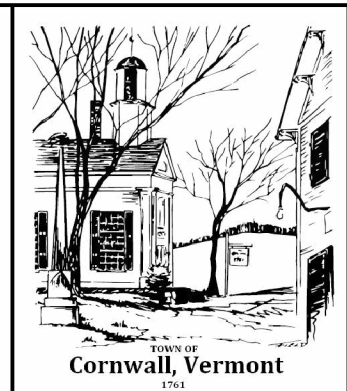

PROJECT NAME:	CORNWALL - MIDDLEBURY	FILE NAME:	Z08F122BDR NU.DGN	PLOT DATE:	06/09/2010
PROJECT NUMBER:	STP EH08(13)	PROJECT LEADER:	MS	DRAWN BY:	CM
DESIGNED BY:	CM	CHECKED BY:	MS	LAYOUT SHEET	6
					SHEET 63 OF 133