
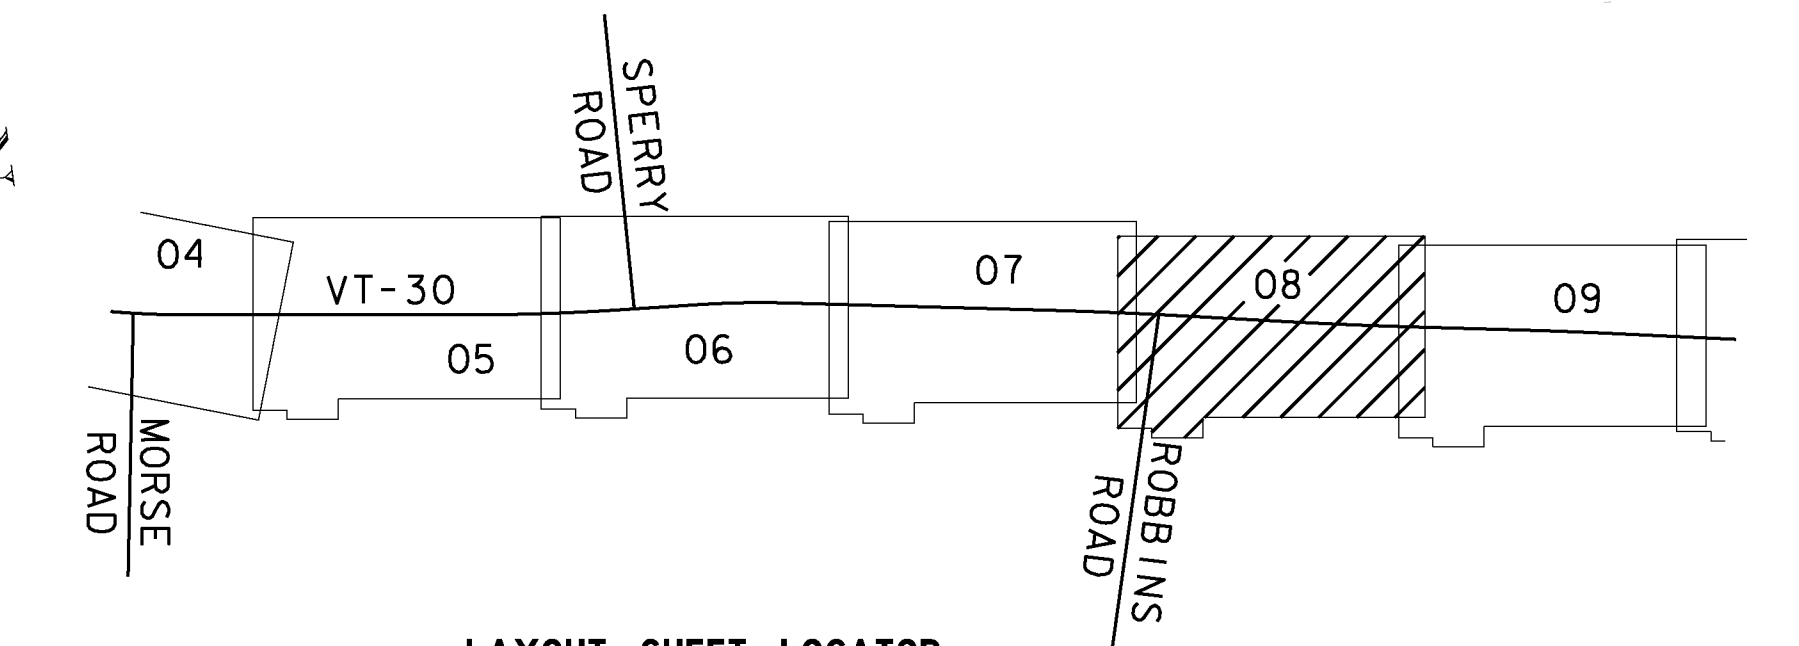
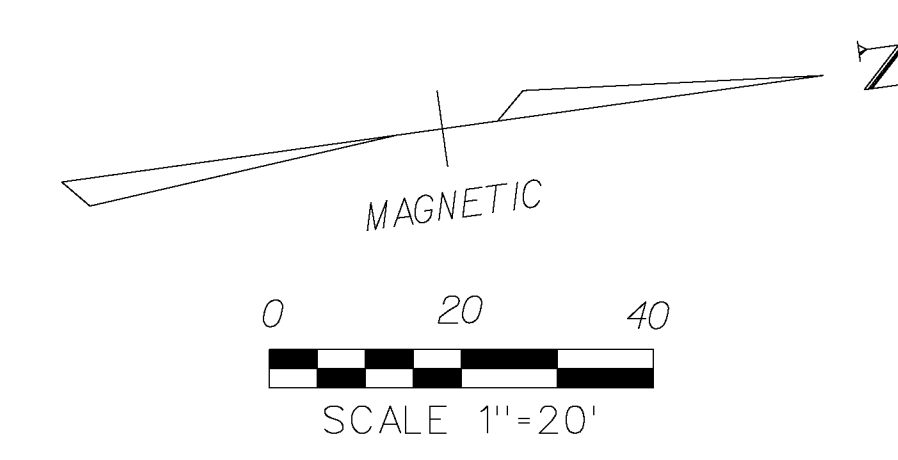


LIMITS OF WORK		
STA 242+34 - 244+16	LT	
STA 243+12 - 247+03	RT	
STA 244+52 - 246+02	LT	
STA 246+23 - 247+03	LT	

ITEM 613.10 - STONE FILL, TYPE I
 STA 246+30 - 247+03 17.0 LT


LEGEND	
EXISTING EDGE OF PAVEMENT	-----
EXISTING CULVERT	=====
EXISTING STONE WALL	-----x-----
EXISTING FENCE	-----x-----
EXISTING TREE LINE	-----x-----
EXISTING TREES	-----x-----
WETLAND BOUNDARY	-----x-----
TOE OF SLOPE	-----x-----
TOE OF CUT	-----x-----
EXISTING RIGHT OF WAY	-----x-----
EXISTING SIDELINES	-----x-----
PROJECT DEMARCATION FENCE	PDF---PDF---
EROSION LOG	-----x-----
TEMPORARY INLET PROTECTION	-----x-----
EROSION MATTING	-----x-----
STONE FILL	-----x-----
CULVERT FLOW DIRECTION	-----x-----

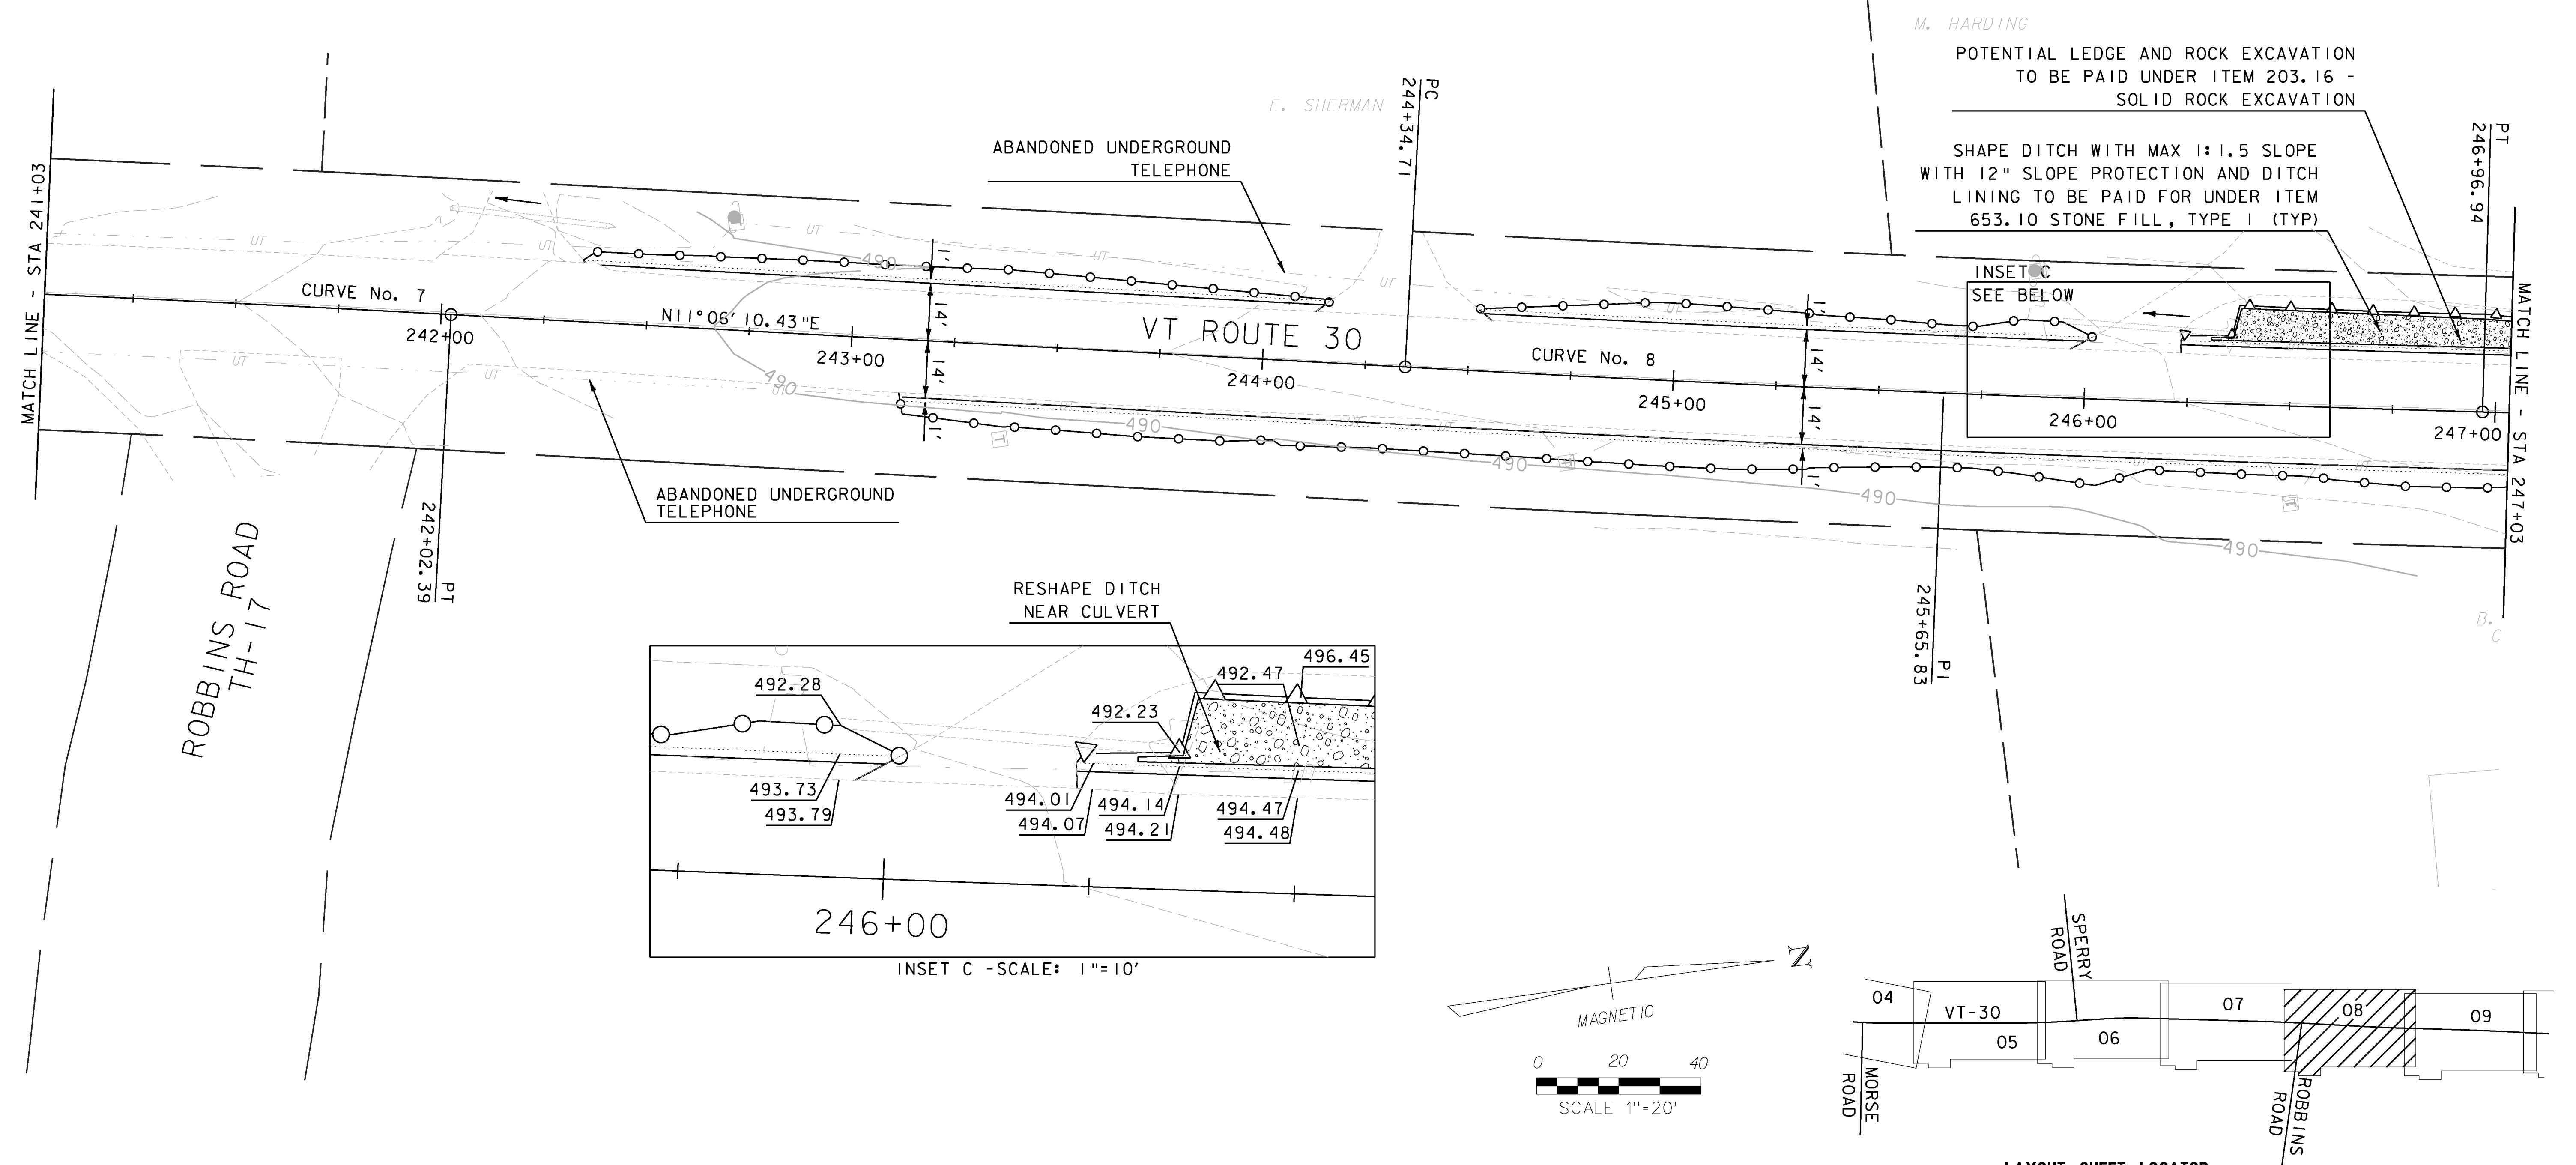

CURVE No. 7 DATA		CURVE No. 8 DATA	
$\Delta = 1^{\circ}33'26''$ RT	$\Delta = 1^{\circ}30'09''$ LT	$R = 10000.00$ FT	$R = 10000.00$ FT
$T = 135.91$ FT	$T = 131.12$ FT	$L = 271.80$ FT	$L = 262.23$ FT
$E = 0.92$ FT	$E = 0.86$ FT	$D = 0^{\circ}34'23''$	$D = 0^{\circ}34'23''$

NO.	DATE	REVISIONS	BY	CK'D

DATUM
 VERTICAL NAVD 88
 HORIZONTAL NAD 83

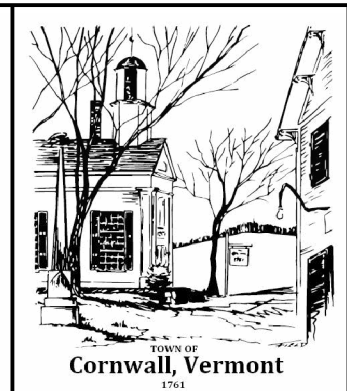

PROJECT NAME: CORNWALL - MIDDLEBURY
 PROJECT NUMBER: STP EH08(13)
 FILE NAME: Z08F122BDR NU.DGN
 PROJECT LEADER: MS
 DESIGNED BY: CM
 LAYOUT SHEET 8
 PLOT DATE: 06/09/2010
 DRAWN BY: CM
 CHECKED BY: MS
 SHEET 65 OF 133