

LIMITS OF WORK		
STA 247+03 - 248+12	LT	
STA 247+03 - 247+10	RT	
STA 249+24 - 252+36	LT	
STA 250+05 - 250+66	RT	
STA 251+53 - 252+25	RT	
STA 252+53 - 252+78	LT	





ITEM 601.0915 - 18" CPEP  
STA 250+34

ITEM 613.10 - STONE FILL, TYPE I  
STA 247+03 - 247+63 17.0 LT  
STA 250+28 24.3 RT

ITEM 653.40 - INLET PROTECTION DEVICE, TYPE I  
STA 250+39 23.7 LT

ITEM 653.60 - EROSION LOG  
STA 251+69 - 252+22 RT

LEGEND	
EXISTING EDGE OF PAVEMENT	-----
EXISTING CULVERT	=====
EXISTING STONE WALL	-----
EXISTING FENCE	x-x-x-x
EXISTING TREE LINE	-----
EXISTING TREES	-----
WETLAND BOUNDARY	-----
TOE OF SLOPE	-----
TOE OF CUT	-----
EXISTING RIGHT OF WAY	-----
EXISTING SIDELINES	-----
PROJECT DEMARCATION FENCE	PDF-PDF
EROSION LOG	-----
TEMPORARY INLET PROTECTION	-----
EROSION MATTING	-----
STONE FILL	-----
CULVERT FLOW DIRECTION	-----

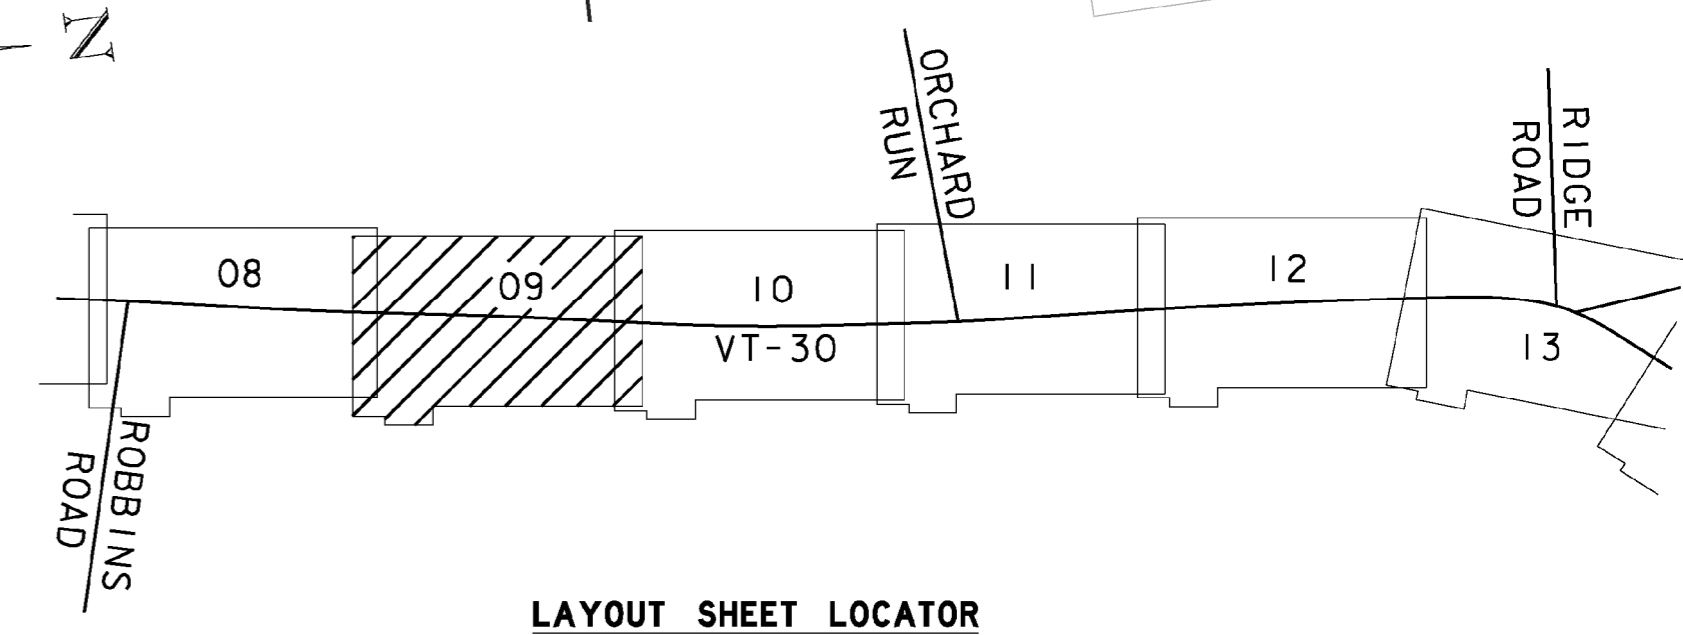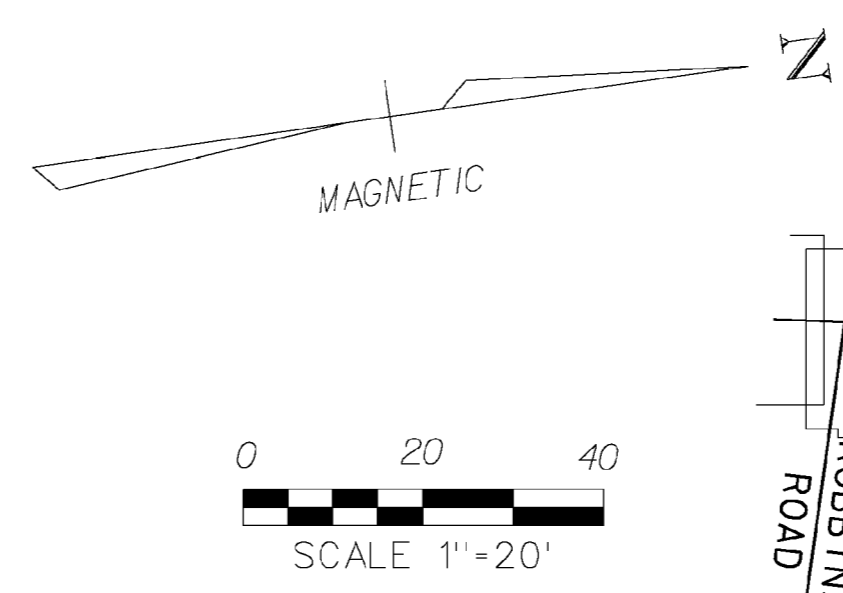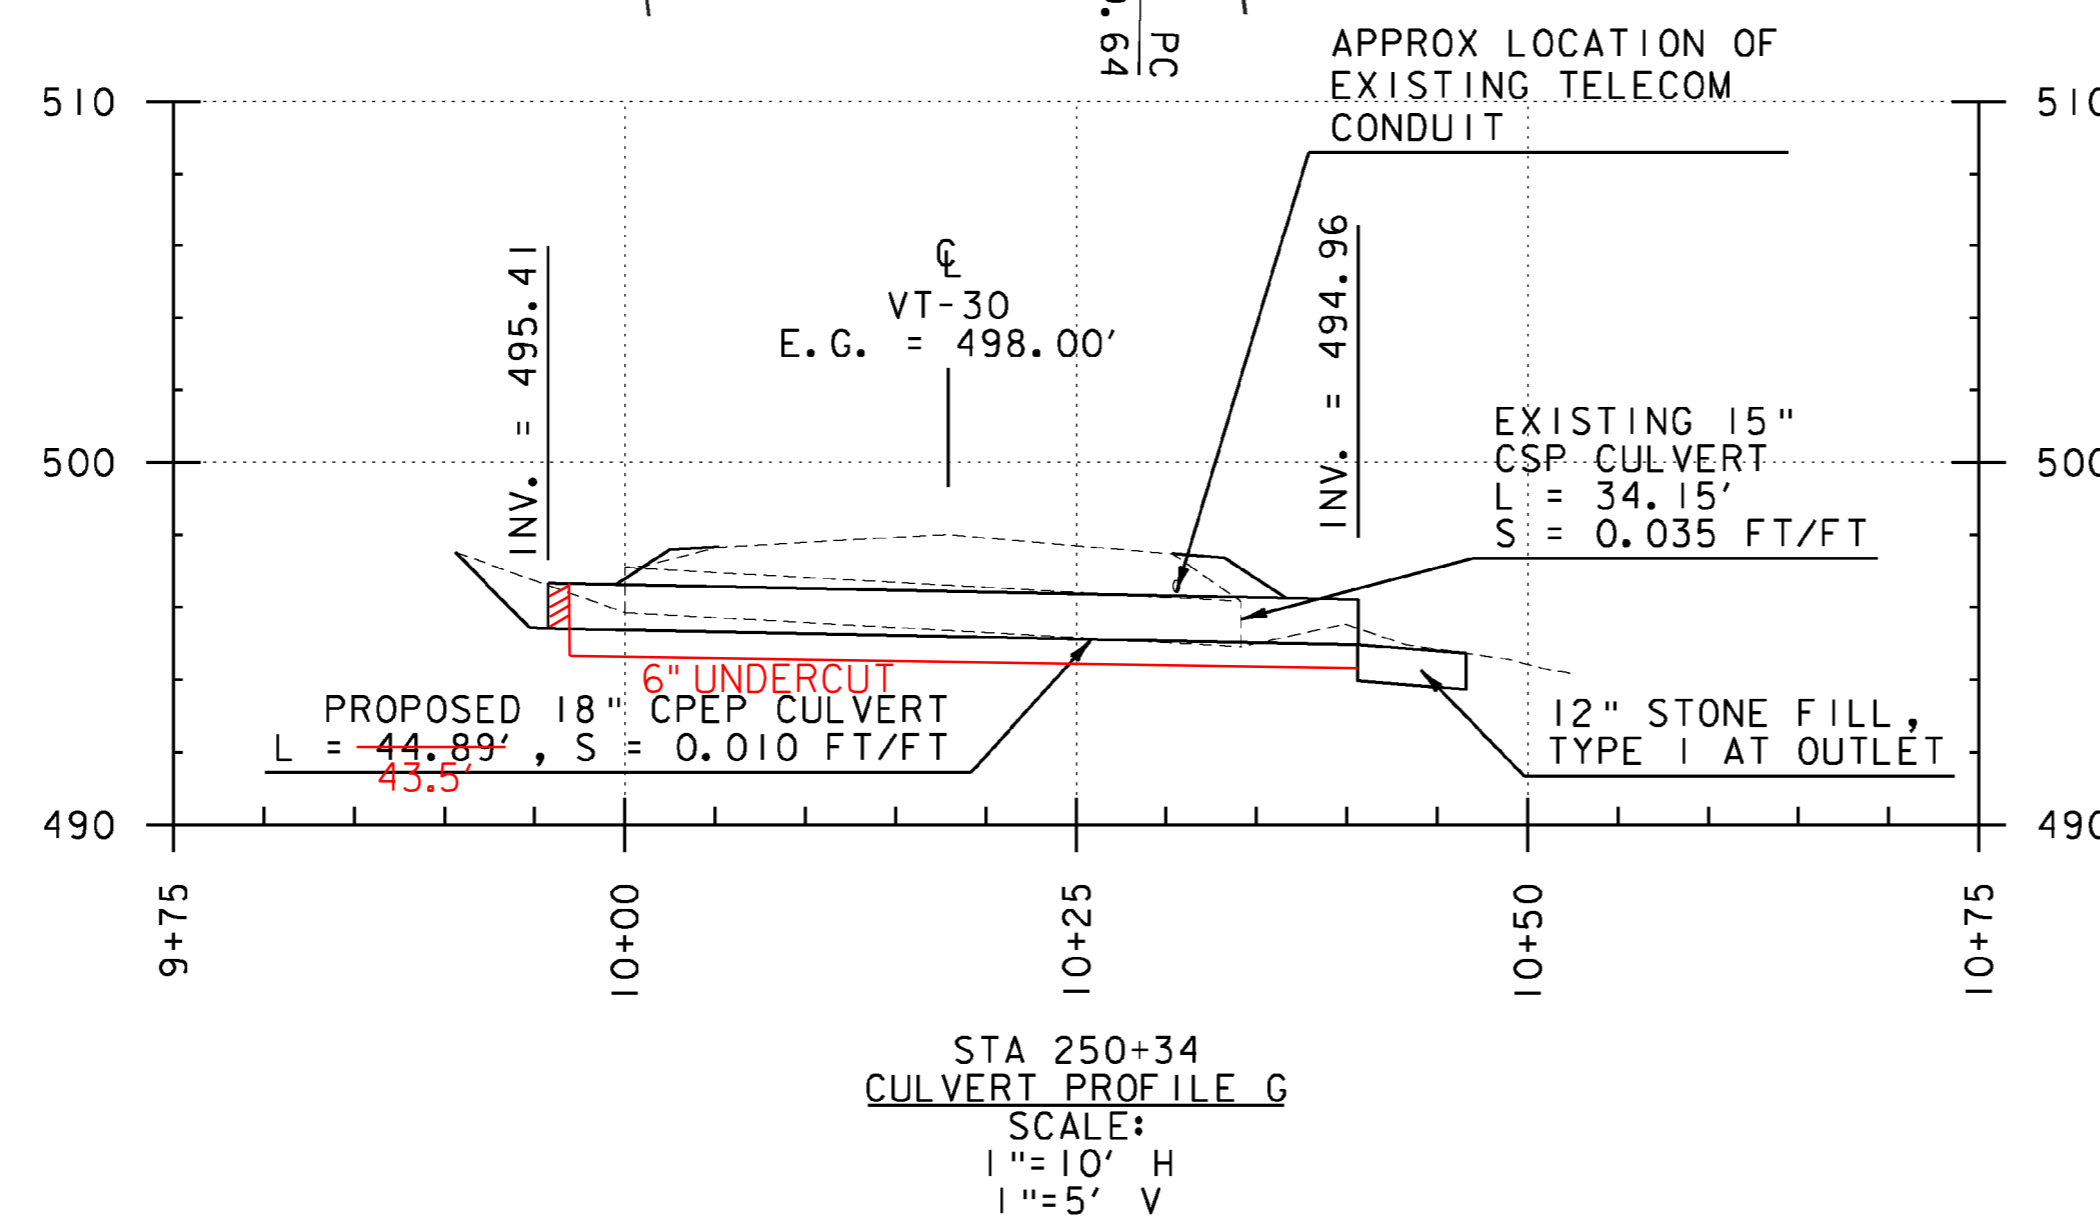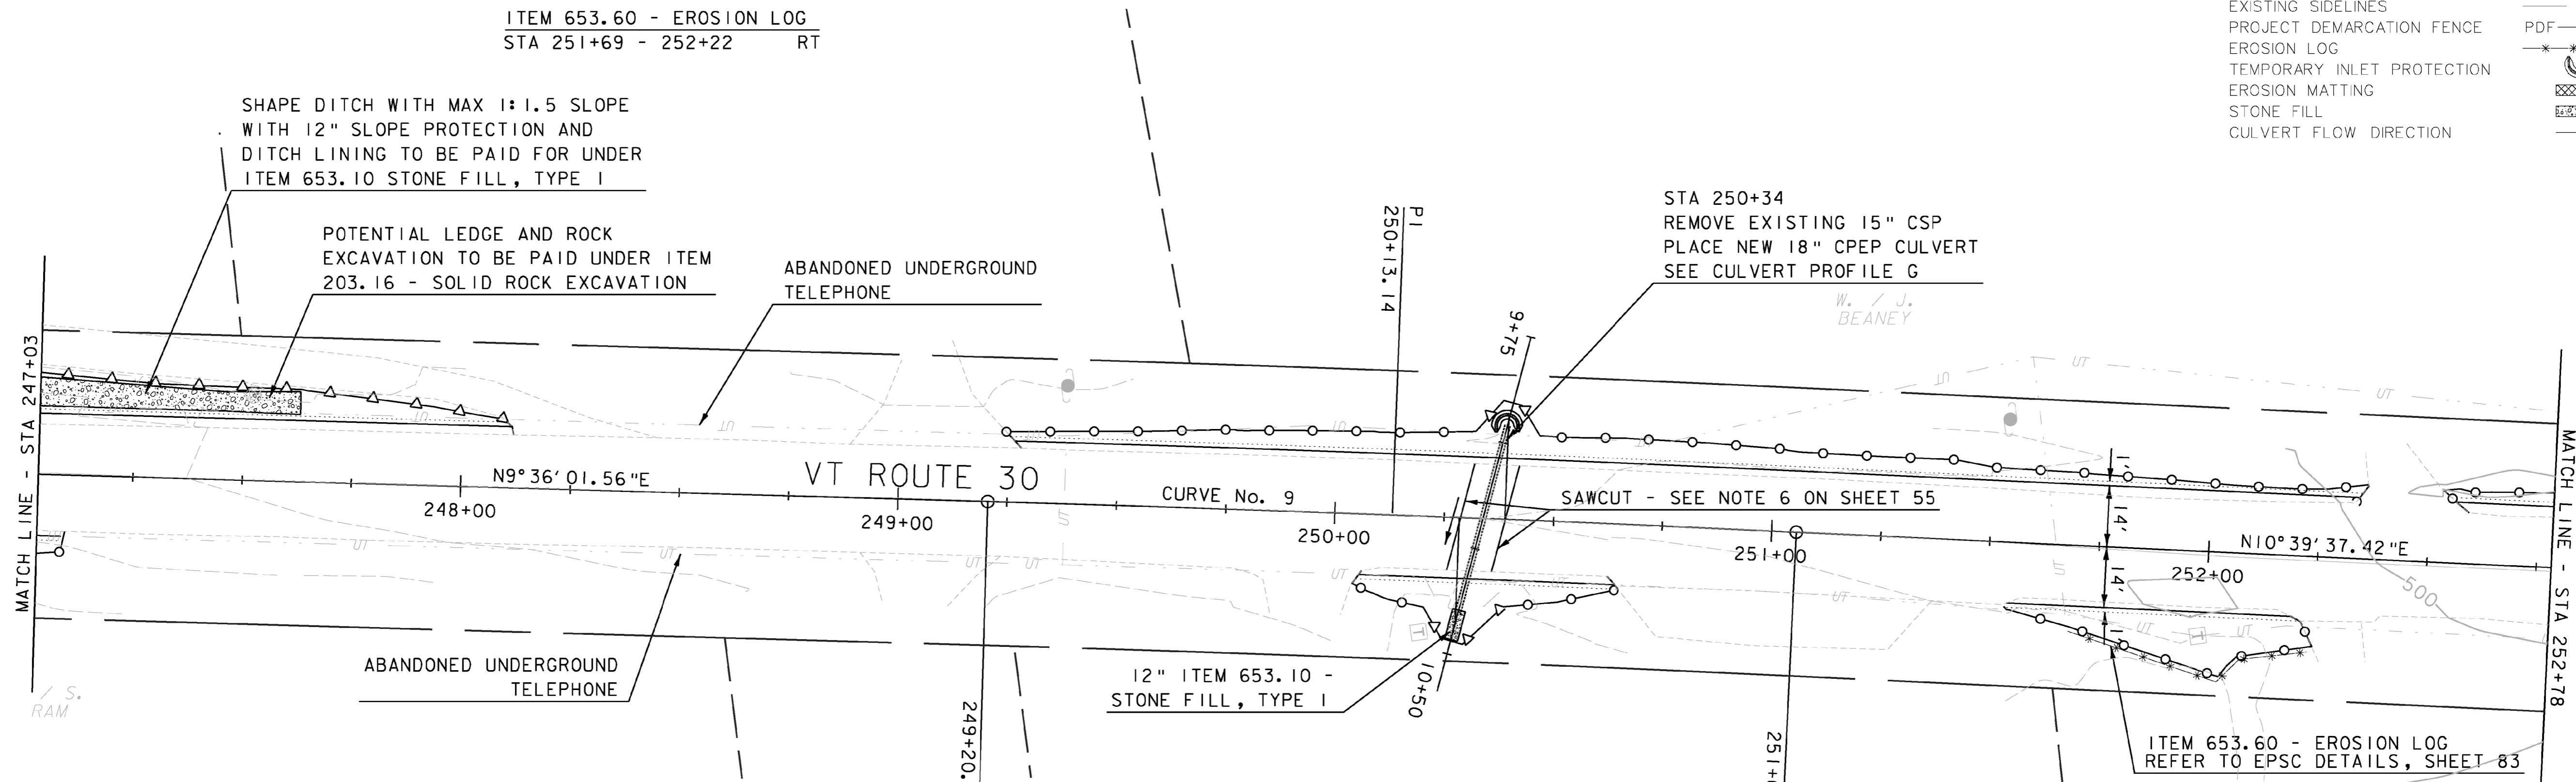

CURVE No. 9 DATA  
 $\Delta = 1^{\circ}03'36''$  RT  
 $R = 10000.00$  FT  
 $T = 92.50$  FT  
 $L = 185.00$  FT  
 $E = 0.43$  FT  
 $D = 0^{\circ}34'23''$

DATUM  
 VERTICAL NAVD 88  
 HORIZONTAL NAD 83

NO.	DATE	REVISIONS	BY	CK'D

**R | S | G** INC.  
 RESOURCE SYSTEMS GROUP, INC.  
 60 Lake Street, Unit 1E • Burlington, Vermont 05401  
 TEL 802.383.0118 • FAX 802.383.0122 • www.rsginc.com



PROJECT NAME: CORNWALL - MIDDLEBURY  
 PROJECT NUMBER: STP EH08(13)  
 FILE NAME: Z08F122BDR NU.DGN  
 PROJECT LEADER: MS  
 DESIGNED BY: CM  
 LAYOUT SHEET 9

PLOT DATE: 06/09/2010  
 DRAWN BY: CM  
 CHECKED BY: MS  
 SHEET 66 OF 133