
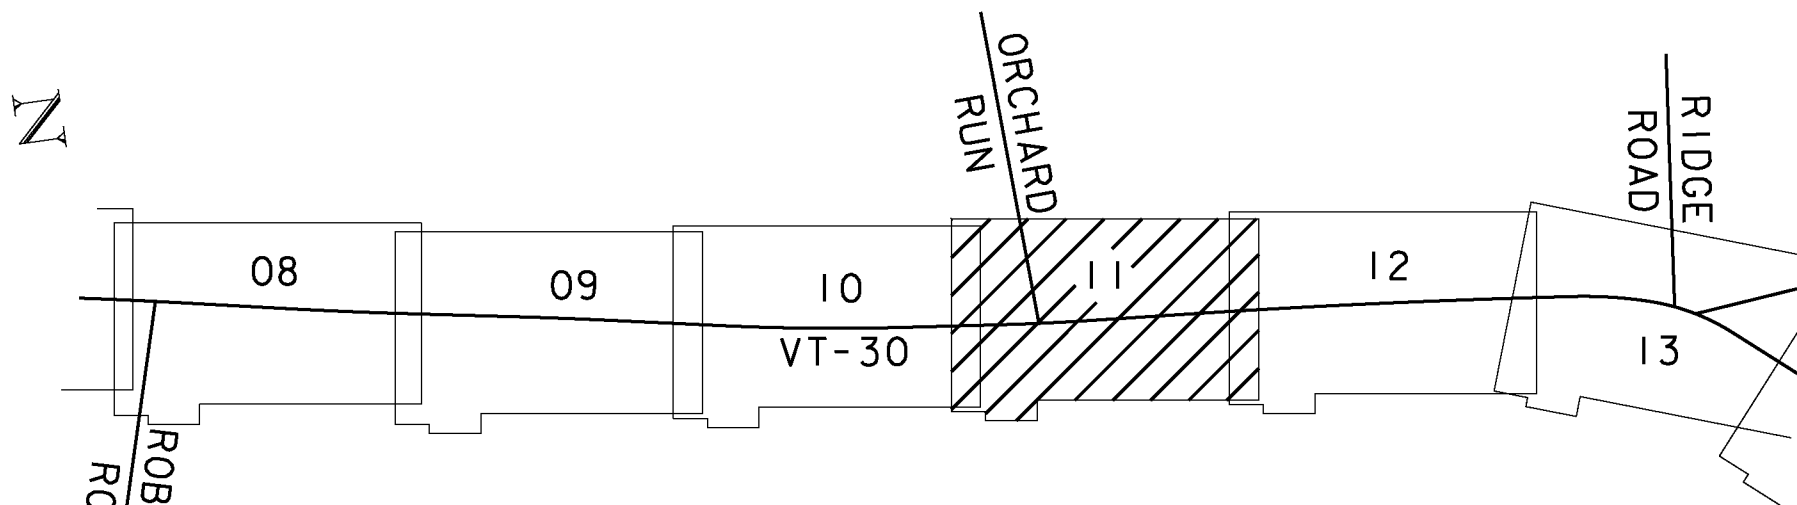
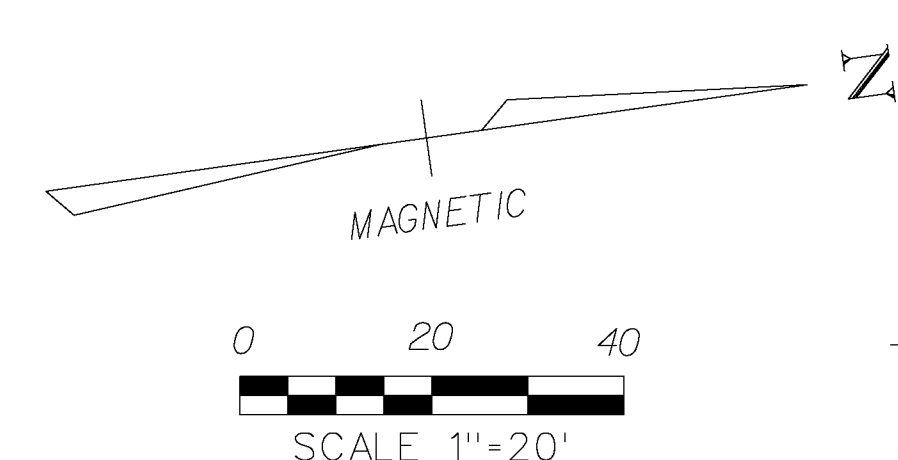


LIMITS OF WORK
 STA 259+62 - 260+79 RT
 STA 263+13 - 263+75 RT

LEGEND

- EXISTING EDGE OF PAVEMENT
- EXISTING CULVERT
- EXISTING STONE WALL
- EXISTING FENCE
- EXISTING TREE LINE
- EXISTING TREES
- WETLAND BOUNDARY
- TOE OF SLOPE
- TOE OF CUT
- EXISTING RIGHT OF WAY
- EXISTING SIDELINES
- PROJECT DEMARCATION FENCE
- EROSION LOG
- TEMPORARY INLET PROTECTION
- EROSION MATTING
- STONE FILL
- CULVERT FLOW DIRECTION

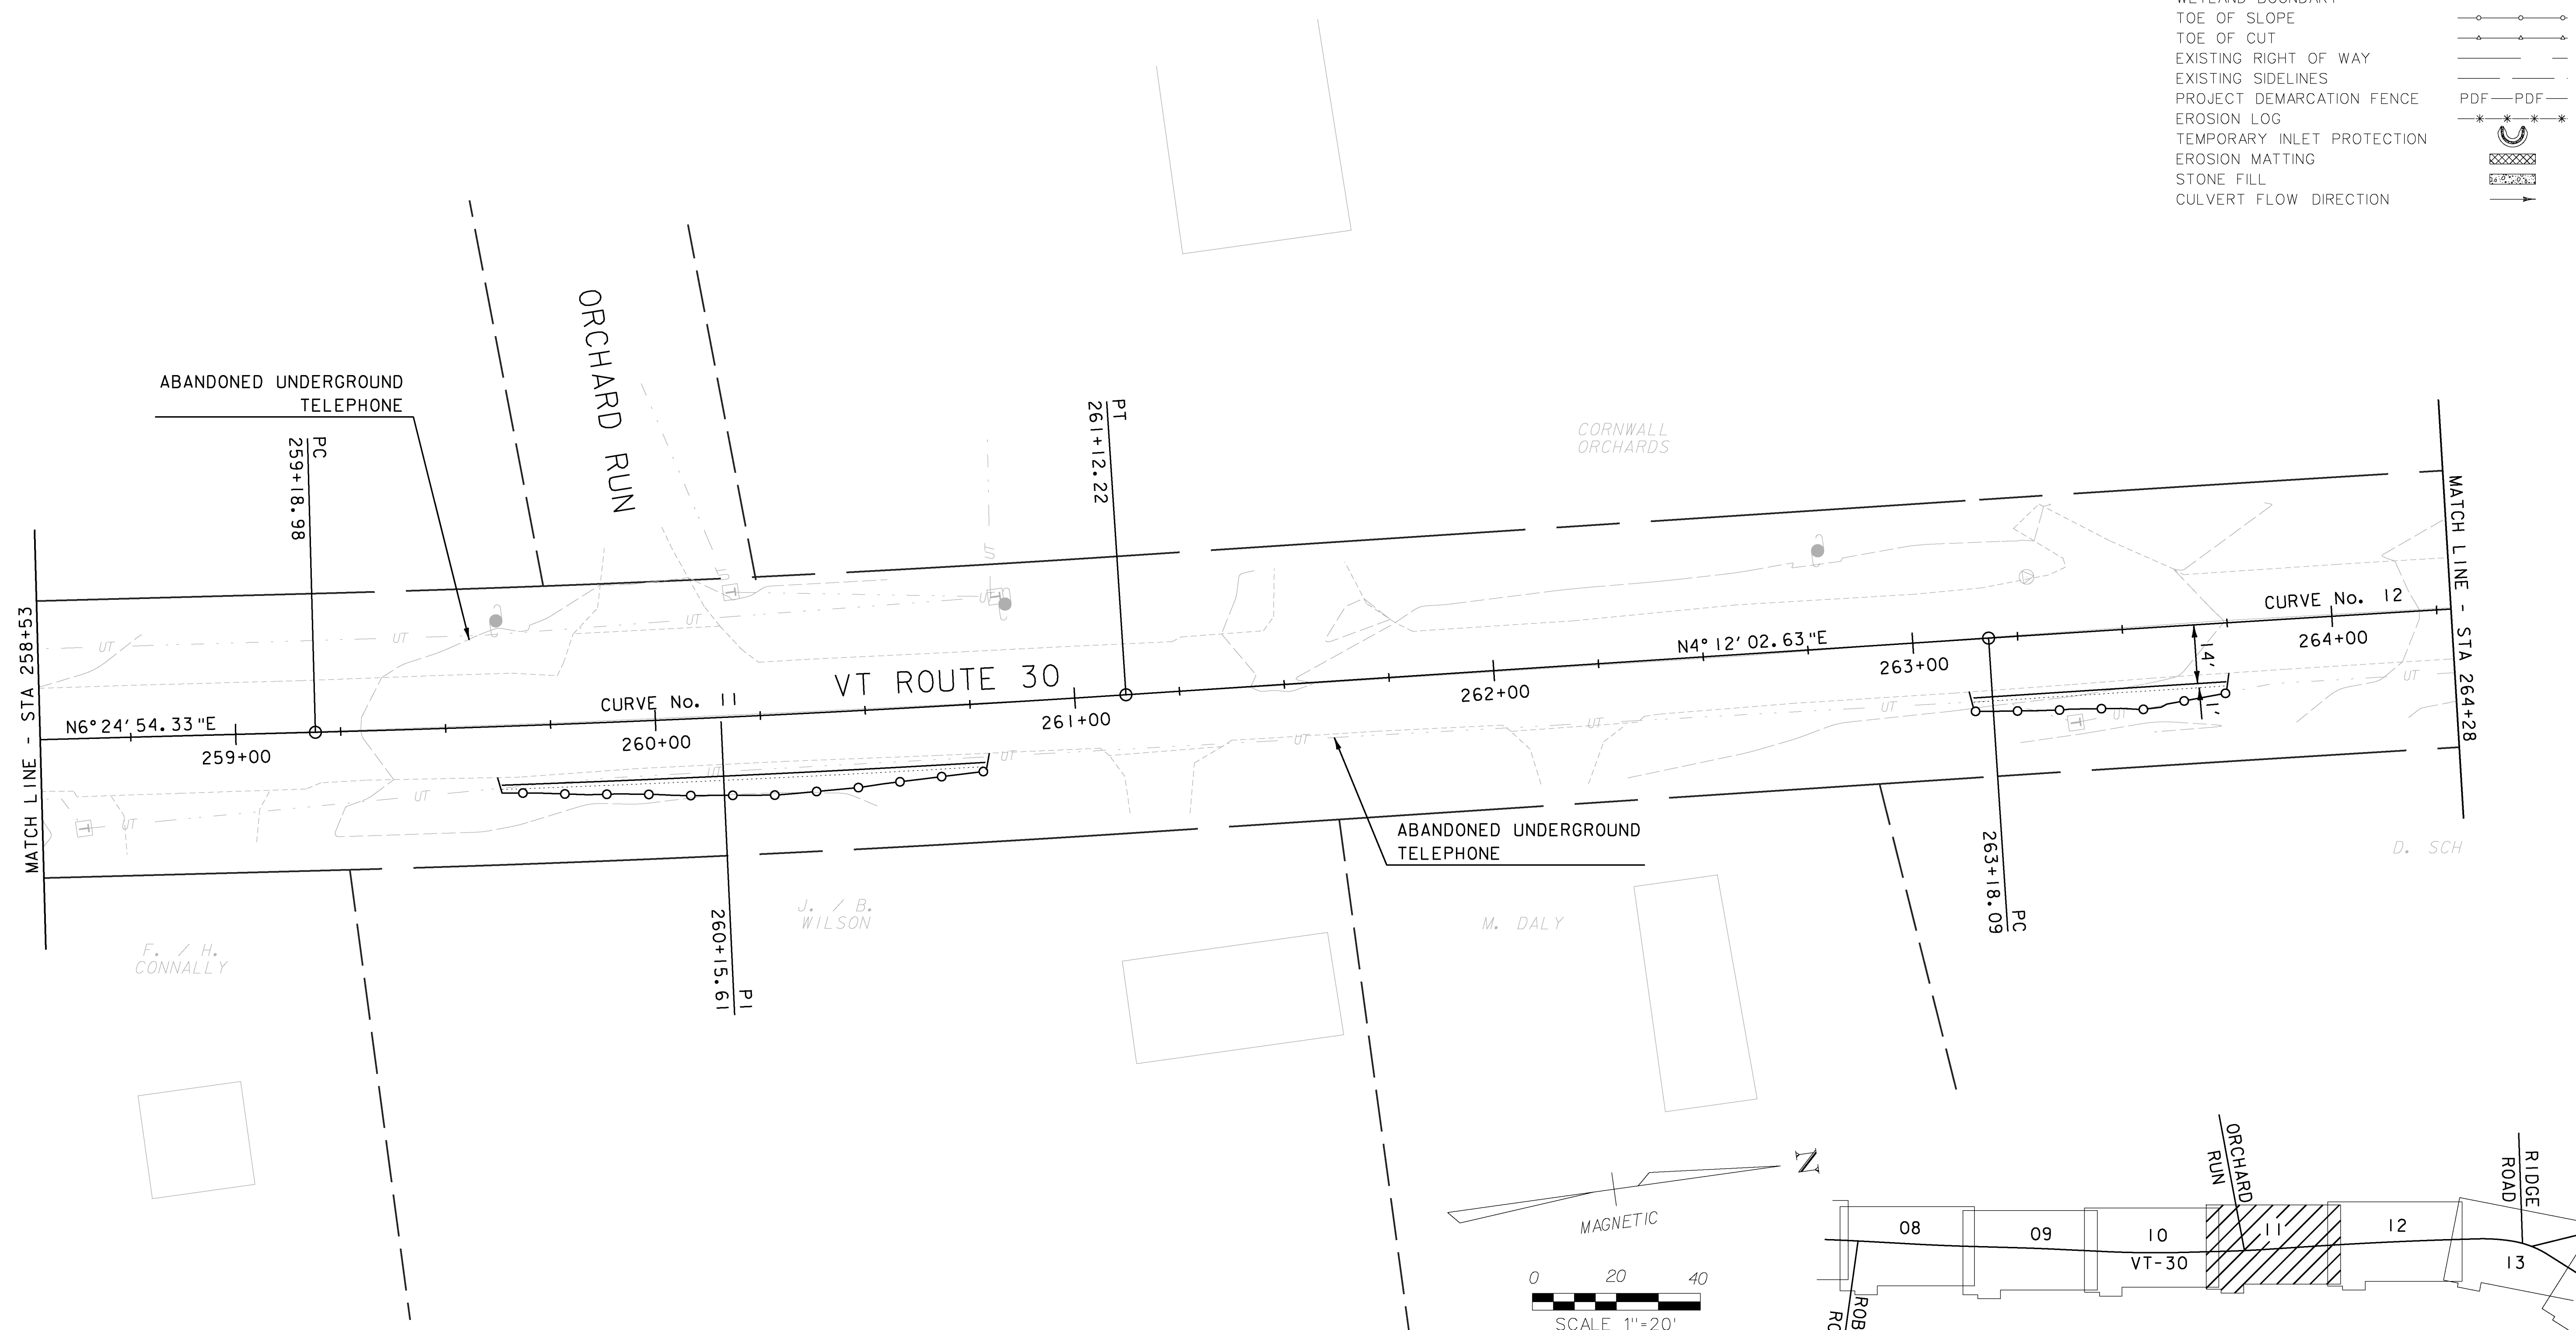


CURVE No. 11 DATA	CURVE No. 12 DATA
$\Delta = 2^{\circ}12'52''$ LT	$\Delta = 2^{\circ}04'17''$ RT
R = 5000.00 FT	R = 20000.00 FT
T = 96.63 FT	T = 361.58 FT
L = 193.24 FT	L = 723.03 FT
E = 0.93 FT	E = 3.27 FT
D = 1^{\circ}08'45''	D = 0^{\circ}17'11''

NO.	DATE	REVISIONS	BY	CK'D

DATUM
 VERTICAL NAVD 88
 HORIZONTAL NAD 83

R S G INC.
 RESOURCE SYSTEMS GROUP, INC.
60 Lake Street, Unit 1E • Burlington, Vermont 05401
 TEL 802.383.0118 • FAX 802.383.0122 • www.rsginc.com

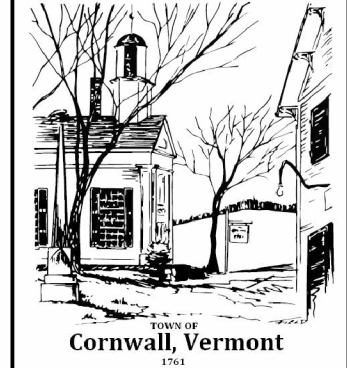

PROJECT NAME: CORNWALL - MIDDLEBURY
 PROJECT NUMBER: STP EH08(13)
 FILE NAME: Z08F122BDR NU.DGN
 PROJECT LEADER: MS
 DESIGNED BY: CM
 LAYOUT SHEET 11
 PLOT DATE: 06/09/2010
 DRAWN BY: CM
 CHECKED BY: MS
 SHEET 68 OF 133