




E.G. = 373.29
199+50

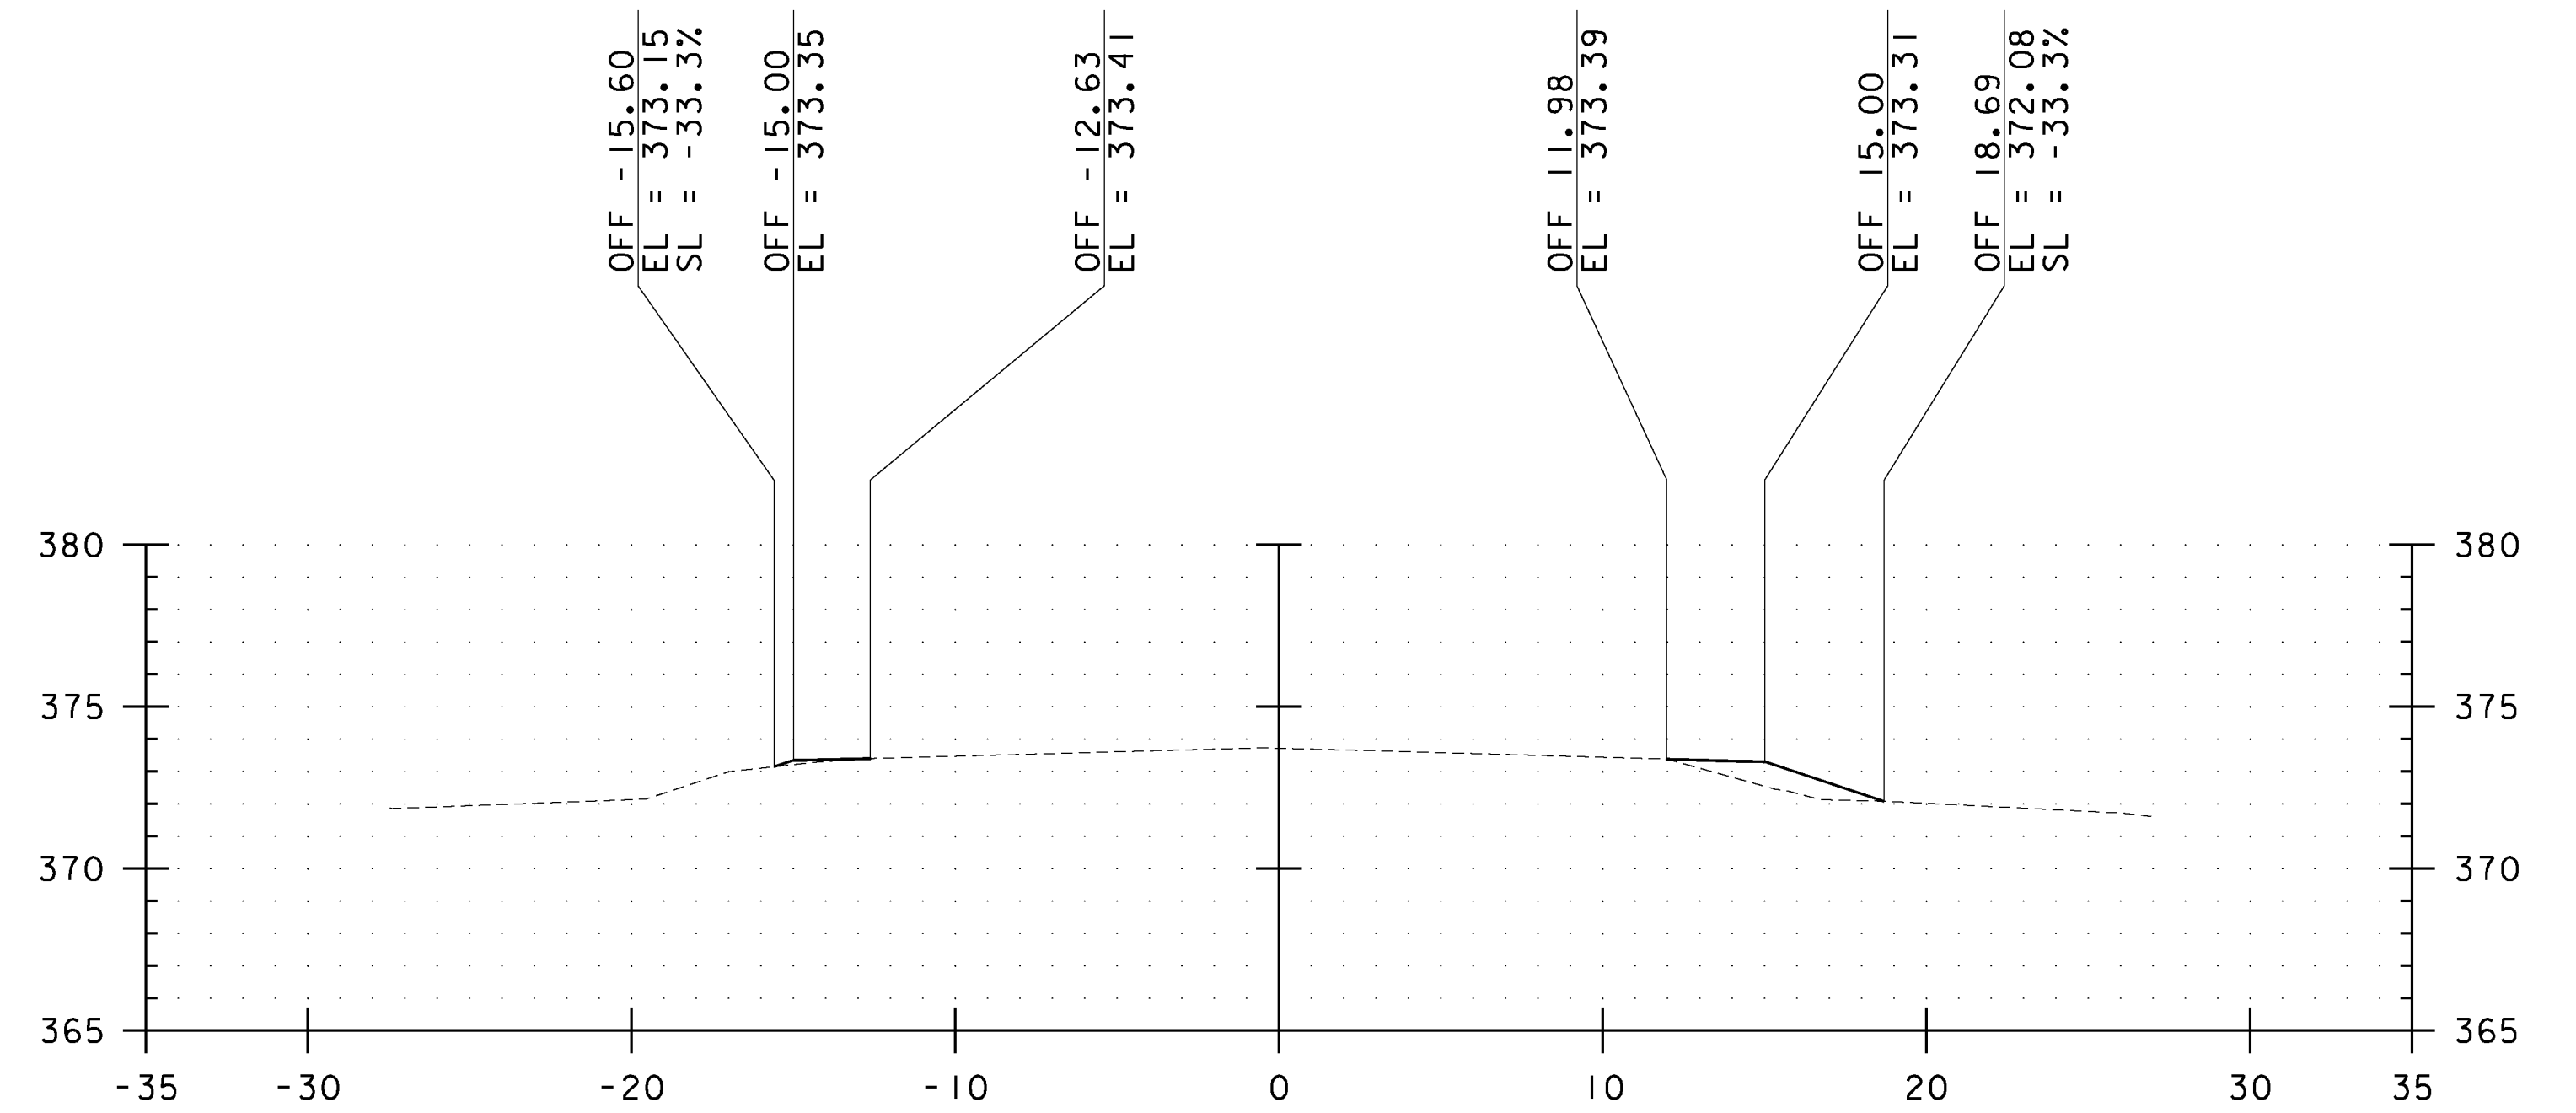

E.G. = 373.72
200+50

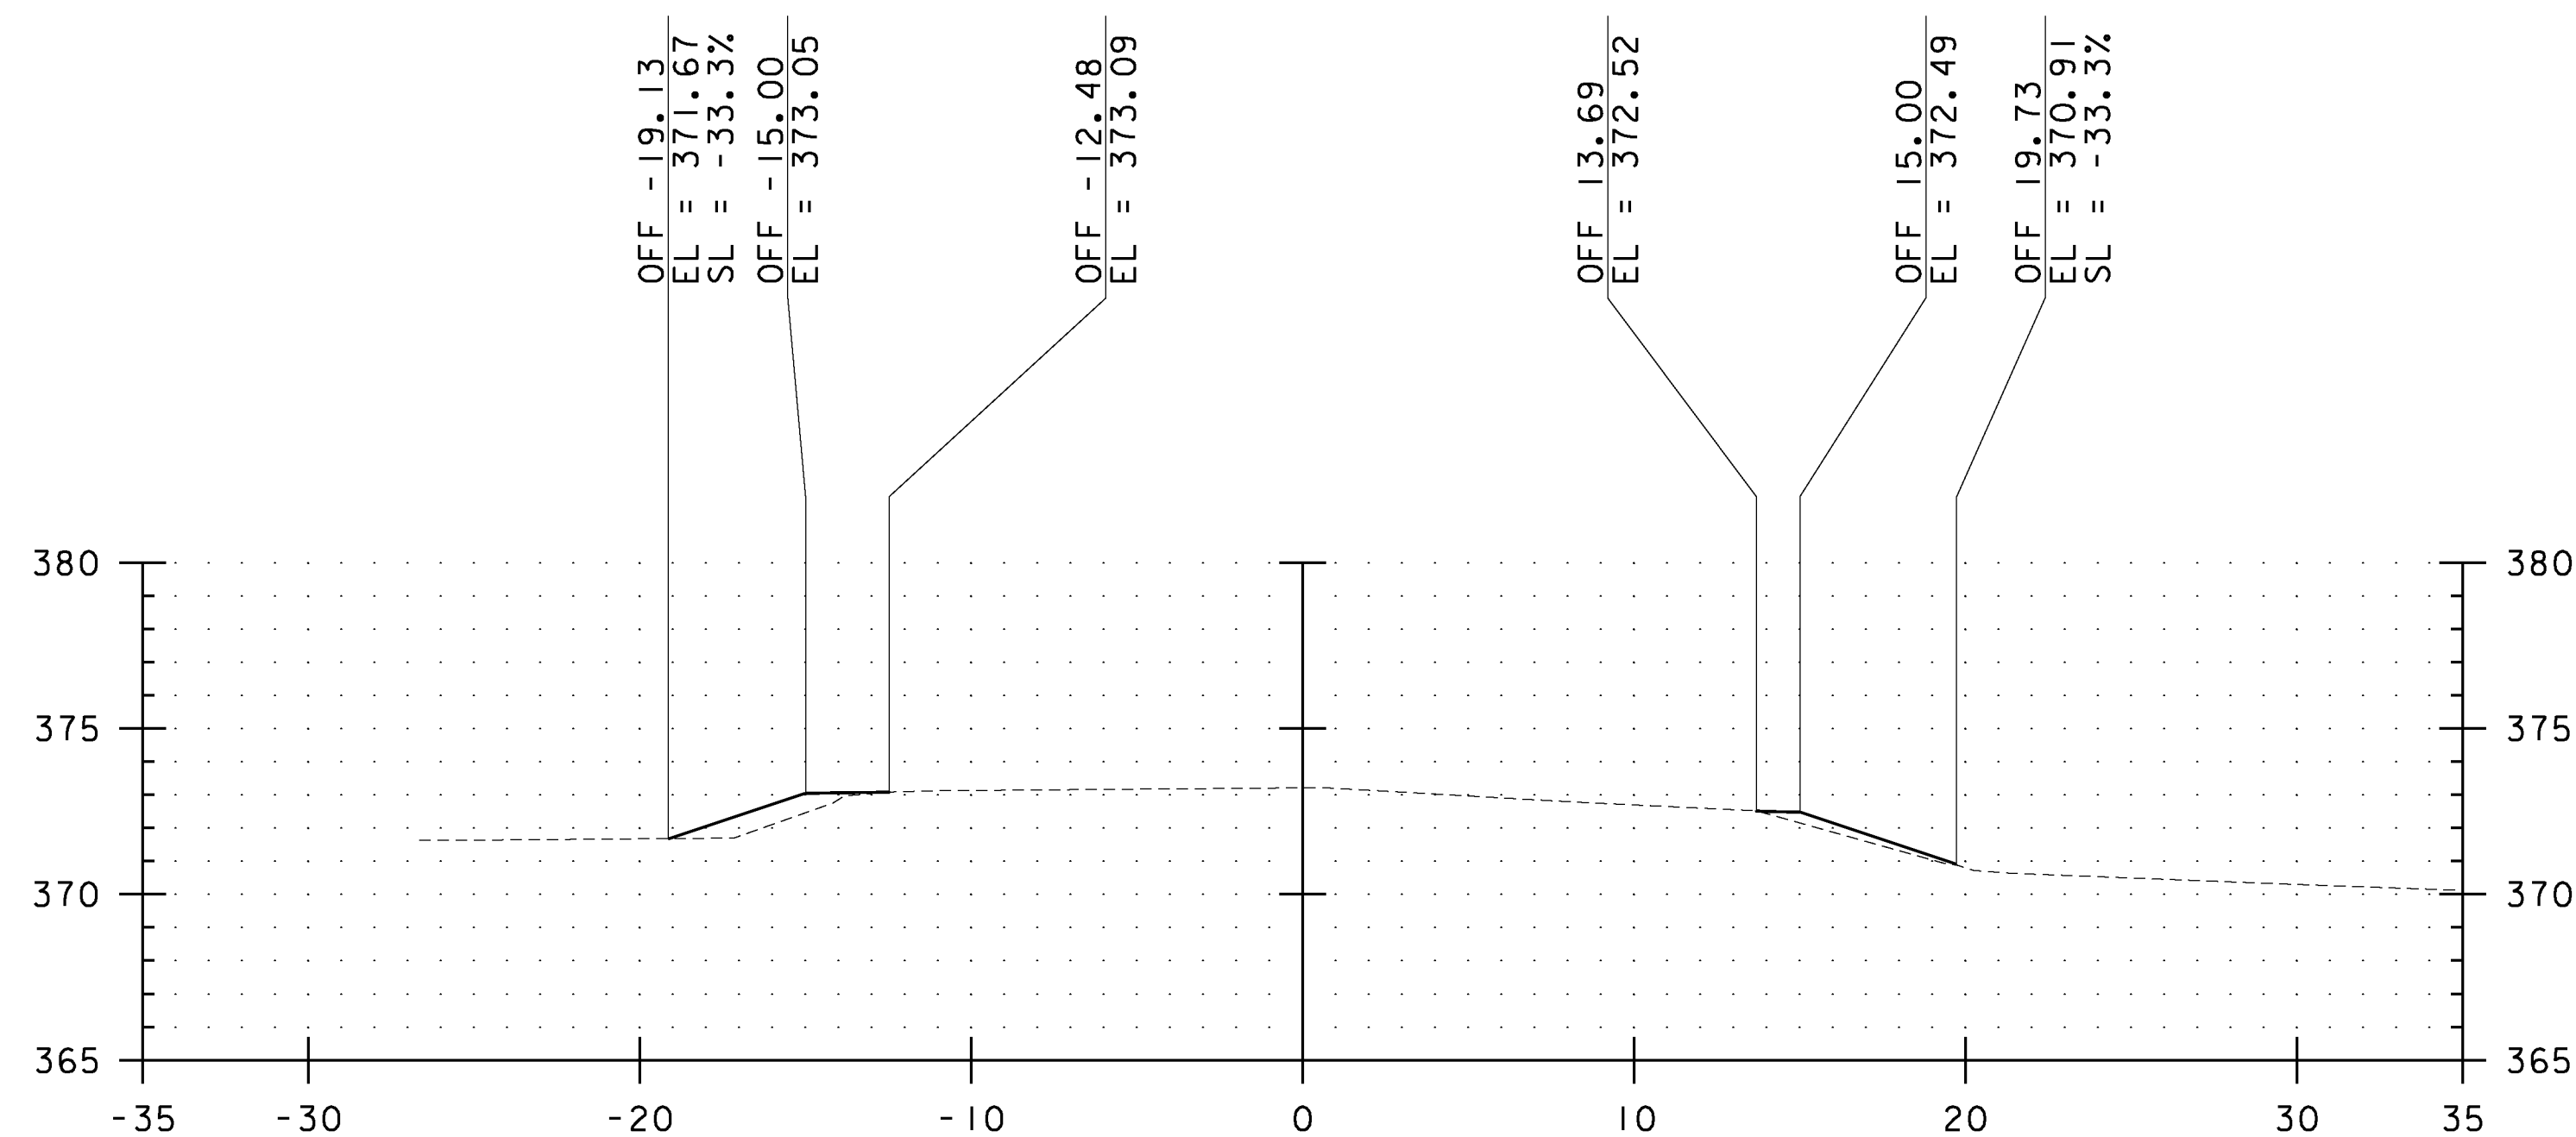

E.G. = 373.21
199+00

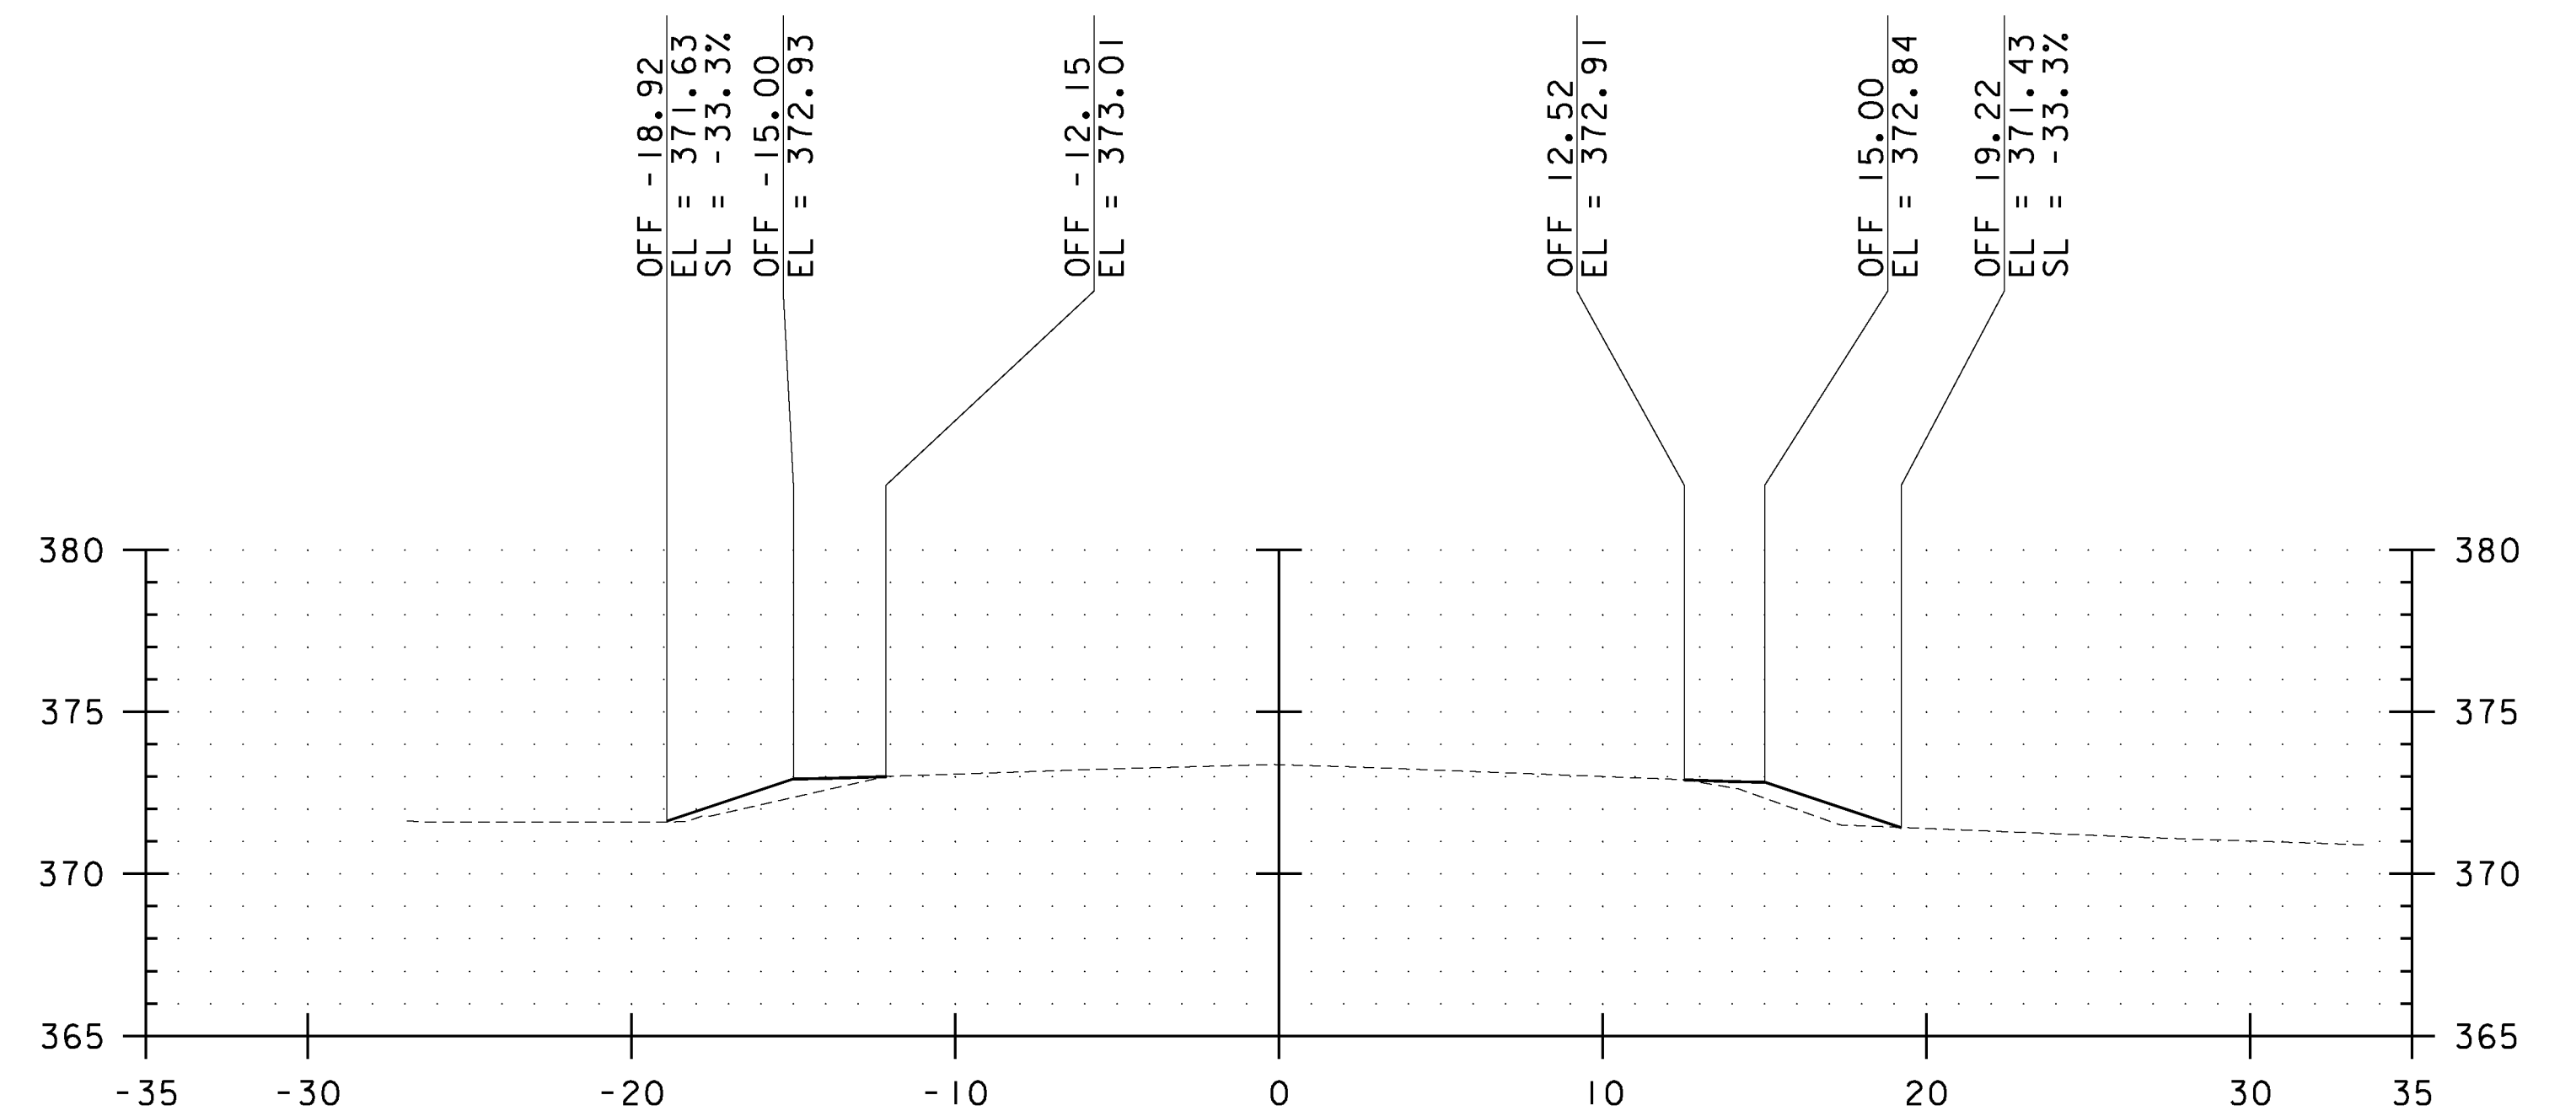

E.G. = 373.37
200+00

OFF = OFFSET FROM CENTERLINE
 EL = ELEVATION
 SL = SLOPE FROM INSIDE POINT


SCALE:
 1" = 10' HORIZONTAL
 1" = 10' VERTICAL

CROSS SLOPE SHALL MATCH EXISTING

DATUM
 VERTICAL NAVD 88
 HORIZONTAL NAD 83

ALL SIDESLOPES SHALL BE
 CONSTRUCTED TO A 1:3 MAXIMUM GRADE
 UNLESS SPECIFICALLY NOTED OTHERWISE

NO.	DATE	REVISIONS	BY	CK'D

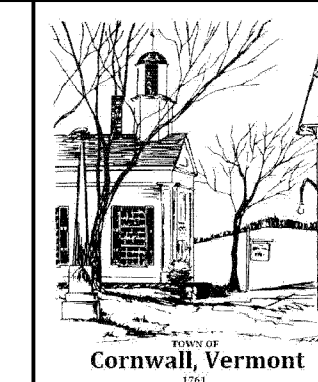

PROJECT NAME: CORNWALL - MIDDLEBURY

PROJECT NUMBER: STP EH08(13)

FILE NAME: Z08F122BDR XS.DGN

PROJECT LEADER: MS

DESIGNED BY: CM

CROSS SECTION SHEET 1

PLOT DATE: 06/09/2010

DRAWN BY: CM

CHECKED BY: MS

SHEET 84 OF 133