




E. G. = 410.38
214+00

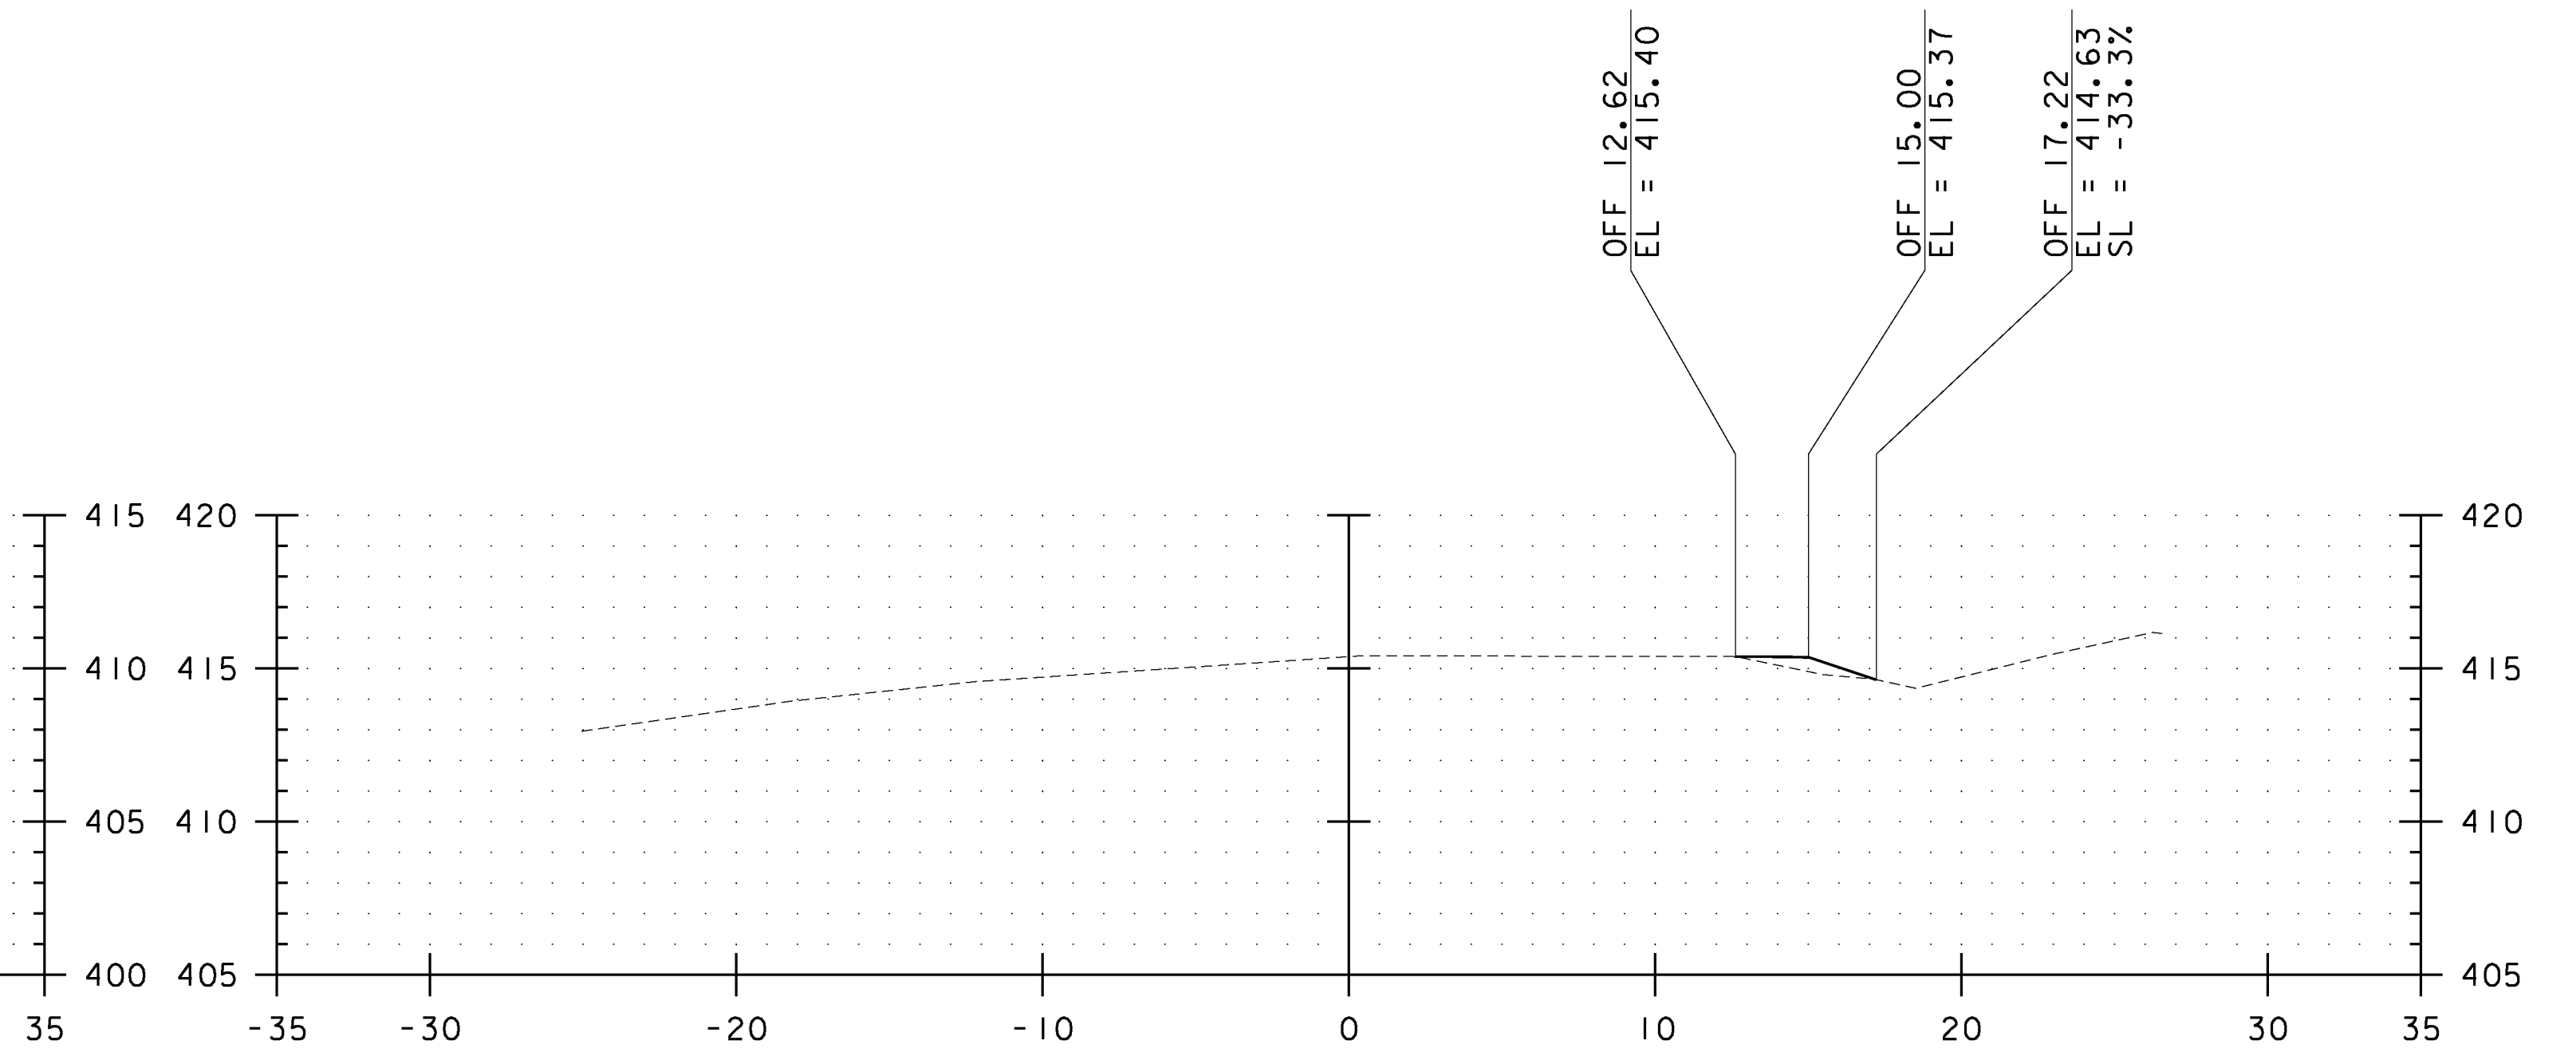

E. G. = 415.39
215+00

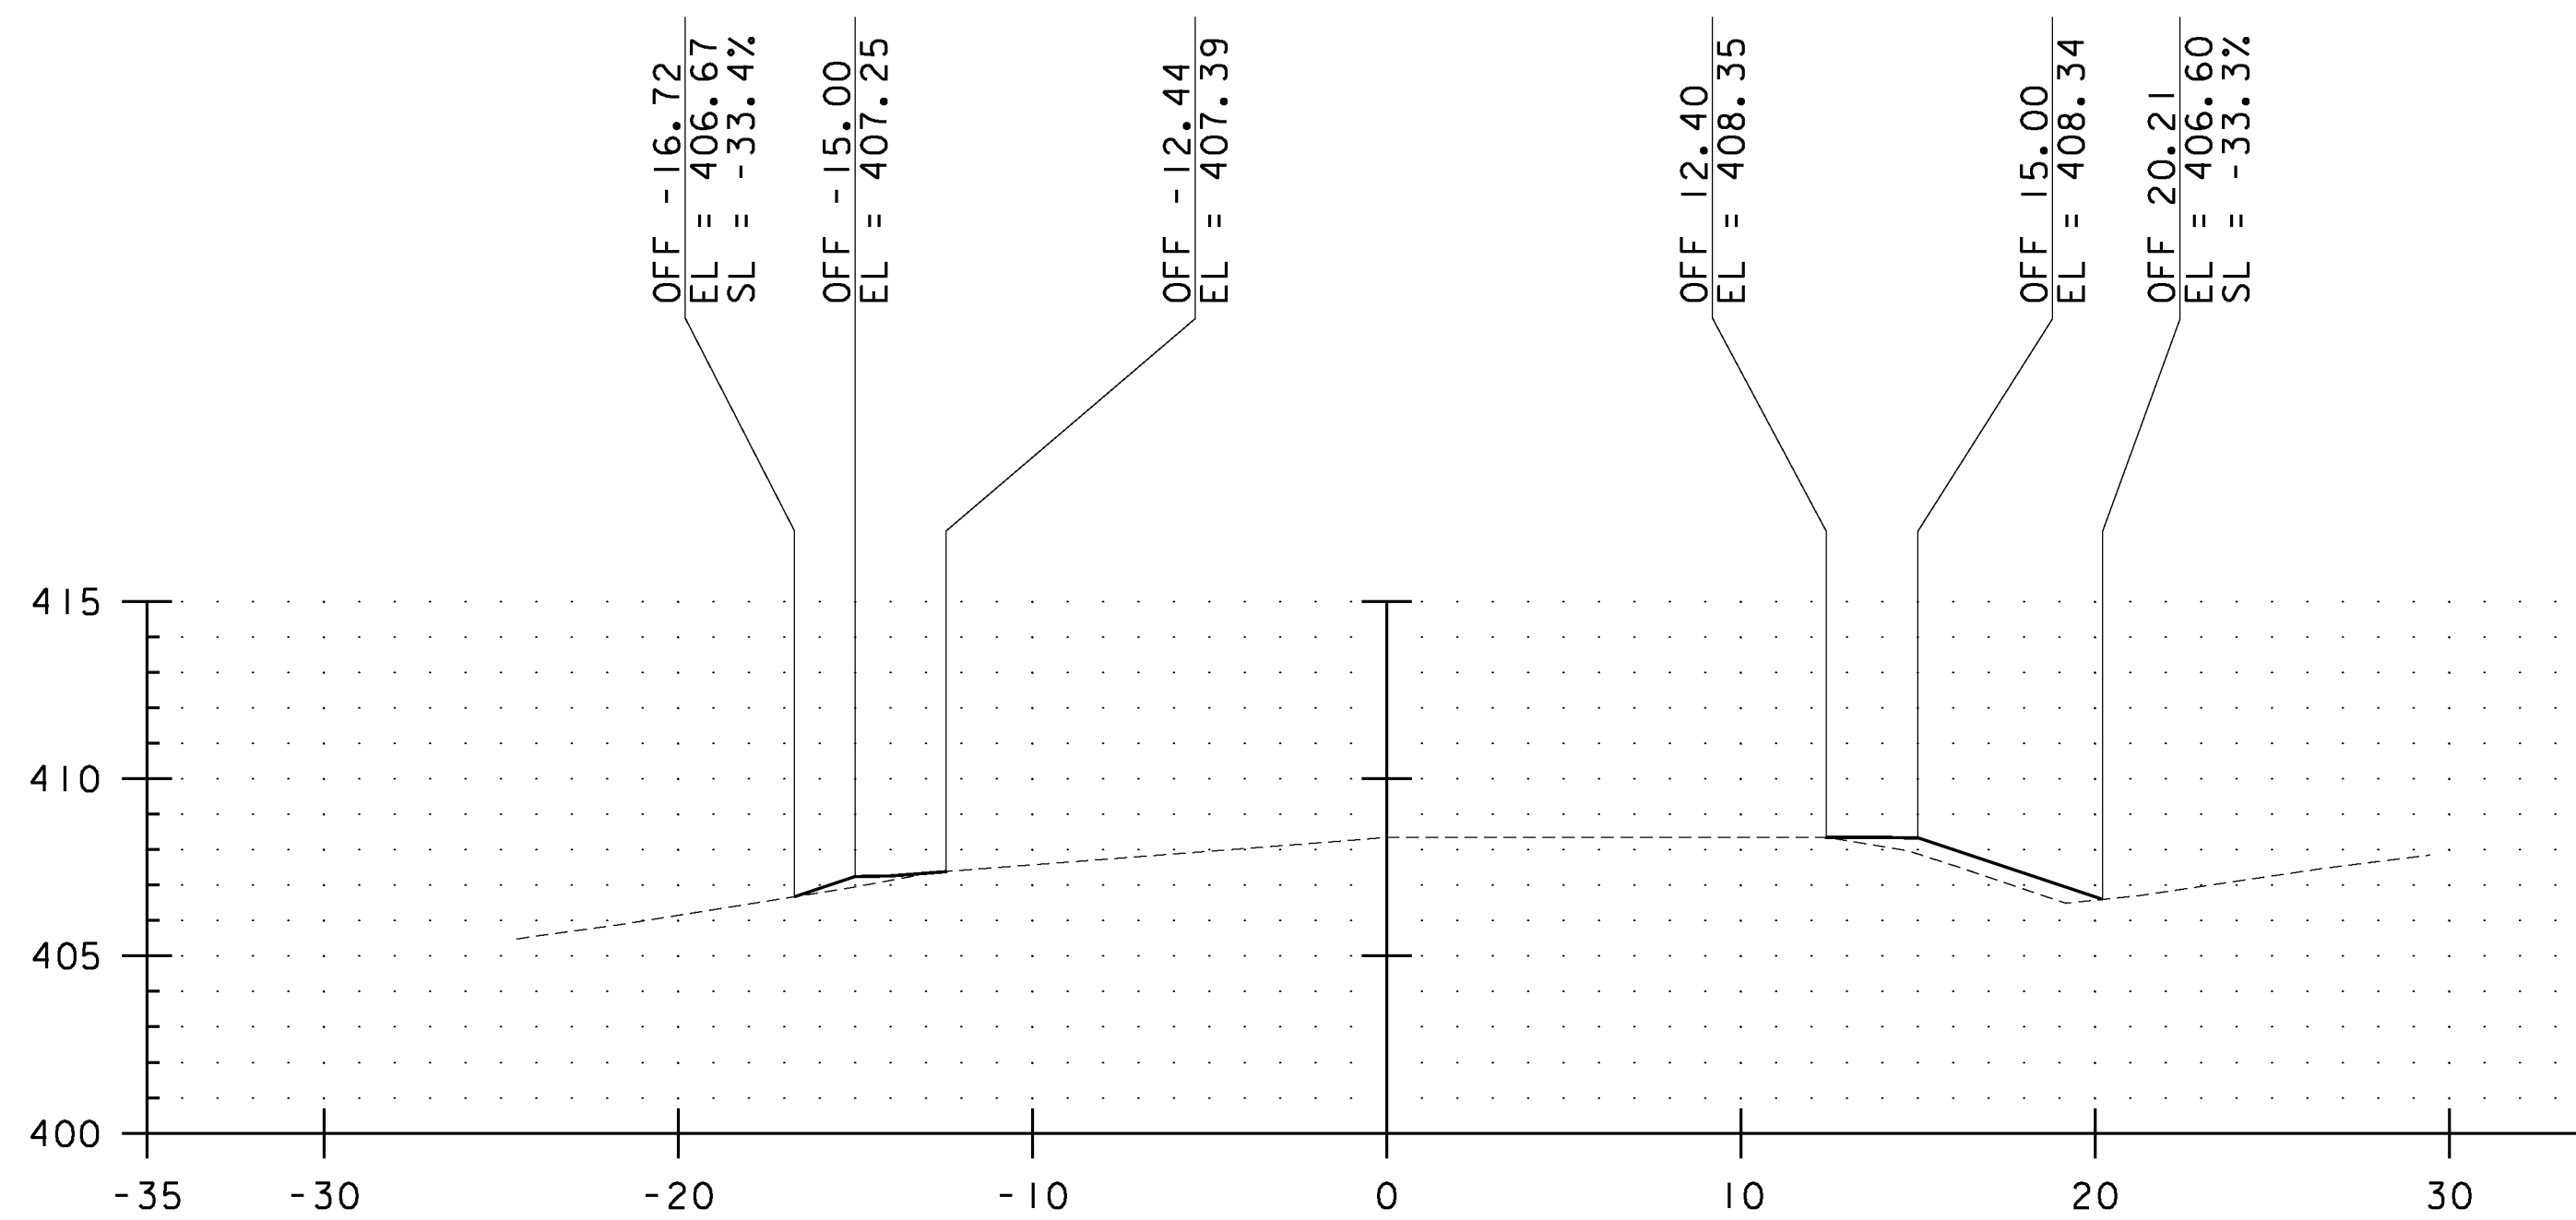

E. G. = 408.35
213+50

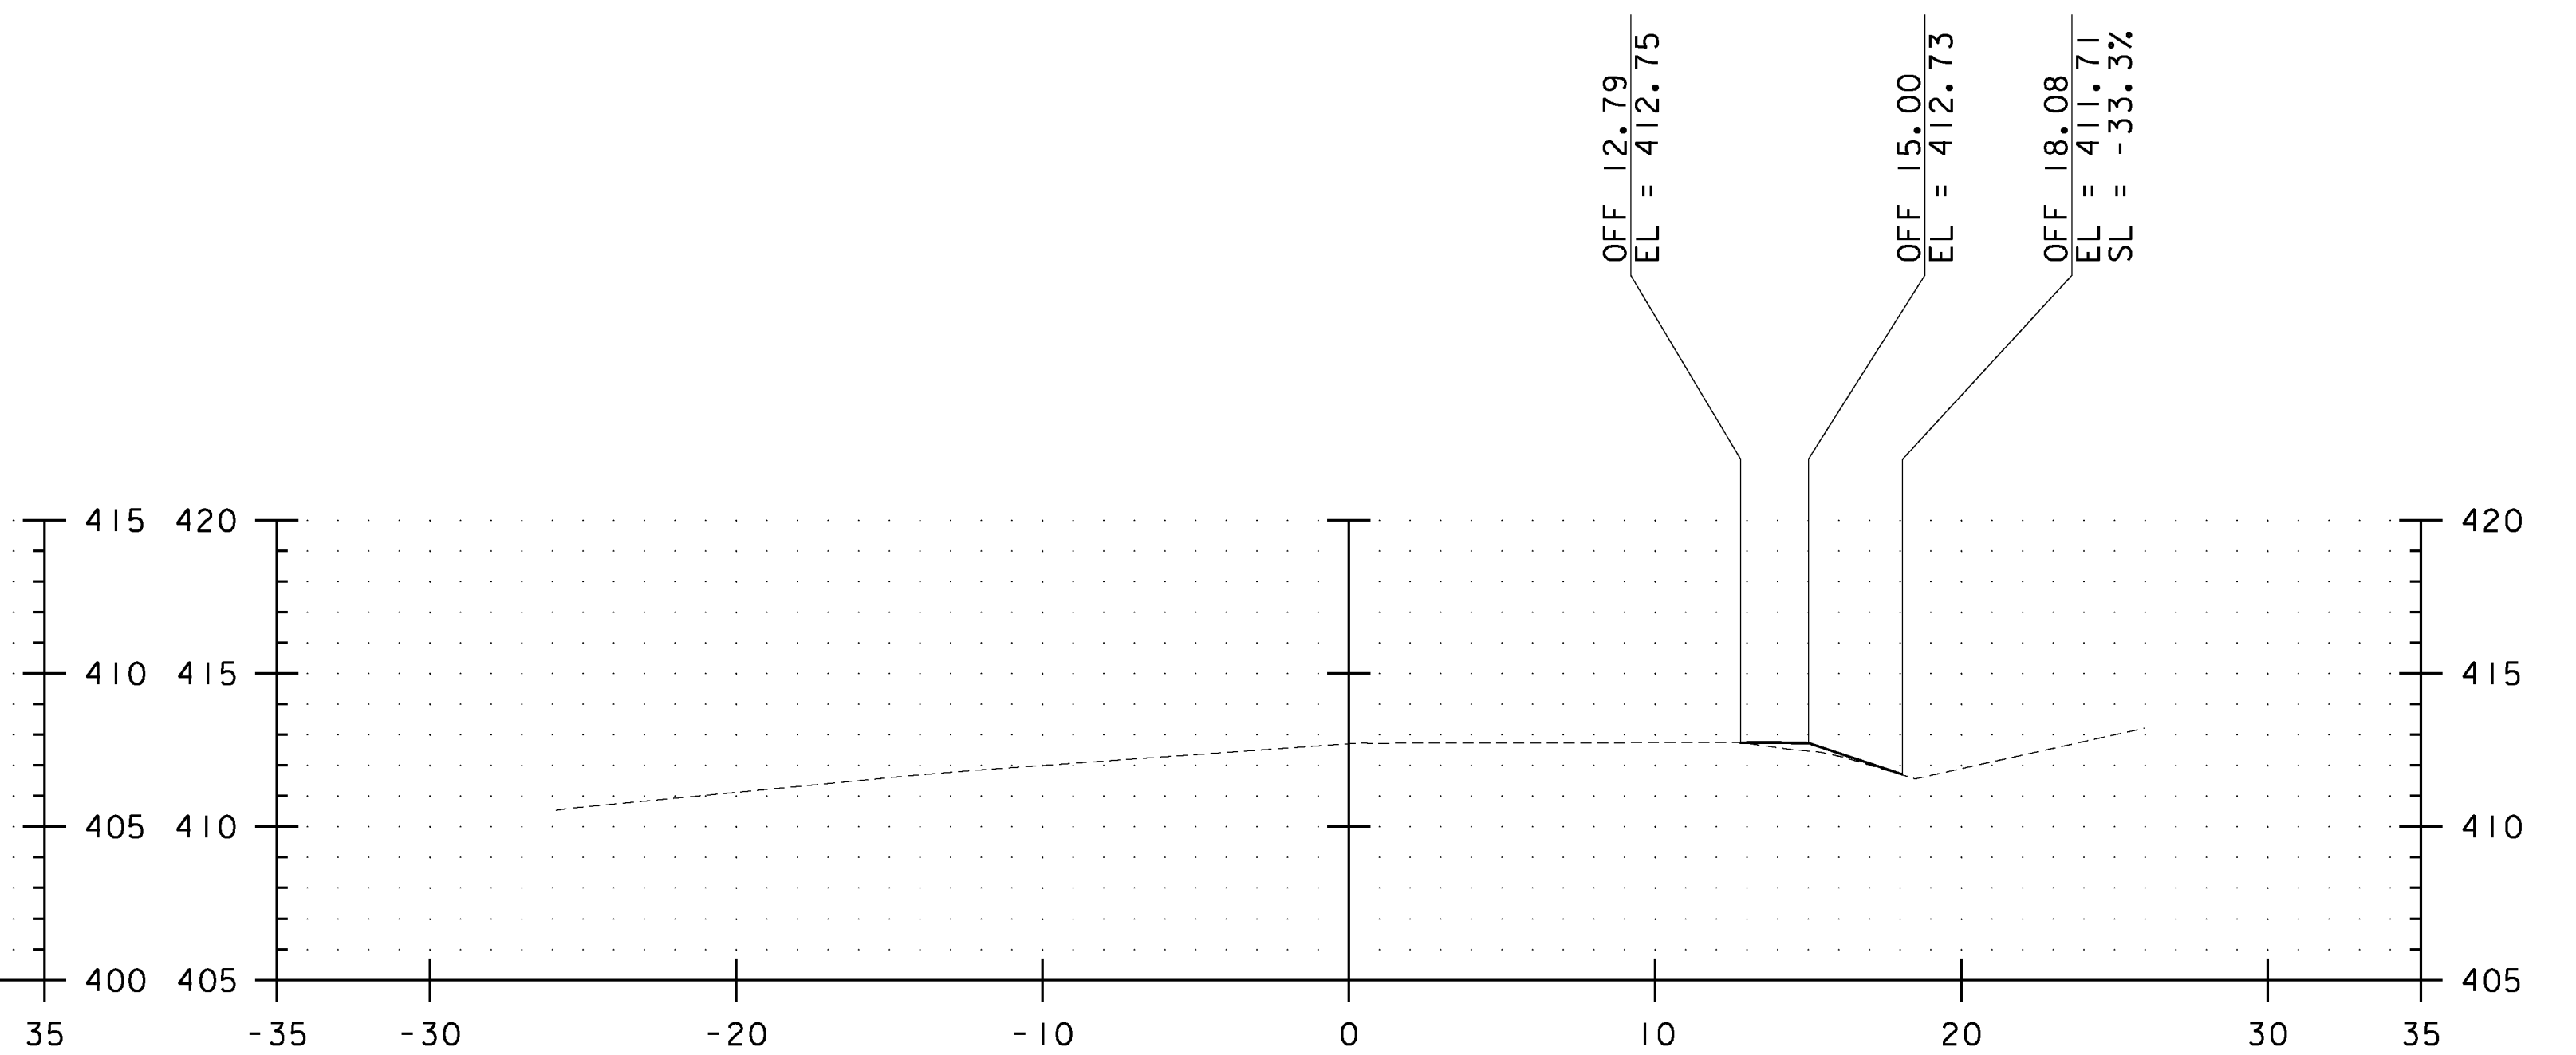

E. G. = 412.71
214+50


SCALE:
1" = 10' HORIZONTAL
1" = 10' VERTICAL

CROSS SLOPE SHALL MATCH EXISTING

ALL SIDESLOPES SHALL BE
CONSTRUCTED TO A 1:3 MAXIMUM GRADE
UNLESS SPECIFICALLY NOTED OTHERWISE

DATUM
VERTICAL NAVD 88
HORIZONTAL NAD 83

| NO. | DATE | REVISIONS | BY | CK'D |
|-----|------|-----------|----|------|
| | | | | |
| | | | | |
| | | | | |
| | | | | |

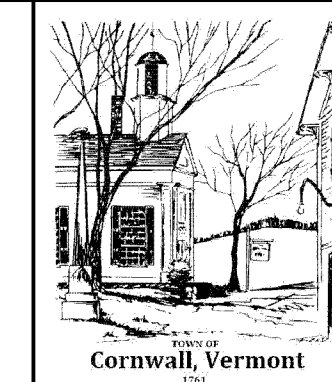

PROJECT NAME: CORNWALL - MIDDLEBURY
PROJECT NUMBER: STP EH08(13)
FILE NAME: Z08F122BDR XS.DGN
PROJECT LEADER: MS
DESIGNED BY: CM
CROSS SECTION SHEET 6

PLOT DATE: 06/09/2010
DRAWN BY: CM
CHECKED BY: MS
SHEET 89 OF 133