


SCALE:
 1" = 10' HORIZONTAL
 1" = 10' VERTICAL

CROSS SLOPE SHALL MATCH EXISTING

ALL SIDESLOPES SHALL BE CONSTRUCTED TO A 1:3 MAXIMUM GRADE UNLESS SPECIFICALLY NOTED OTHERWISE

DATUM
 VERTICAL NAVD 88
 HORIZONTAL NAD 83

NO.	DATE	REVISIONS	BY	CK'D

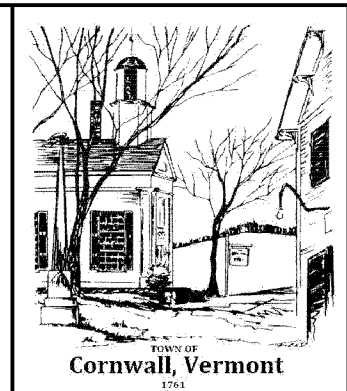

PROJECT NAME: CORNWALL - MIDDLEBURY
 PROJECT NUMBER: STP EH08(13)
 FILE NAME: Z08F122BDR XS.DGN
 PROJECT LEADER: MS
 DESIGNED BY: CM
 CROSS SECTION SHEET 8

PLOT DATE: 06/09/2010
 DRAWN BY: CM
 CHECKED BY: MS
 SHEET 91 OF 133