




E.G. = 479.34
232+00

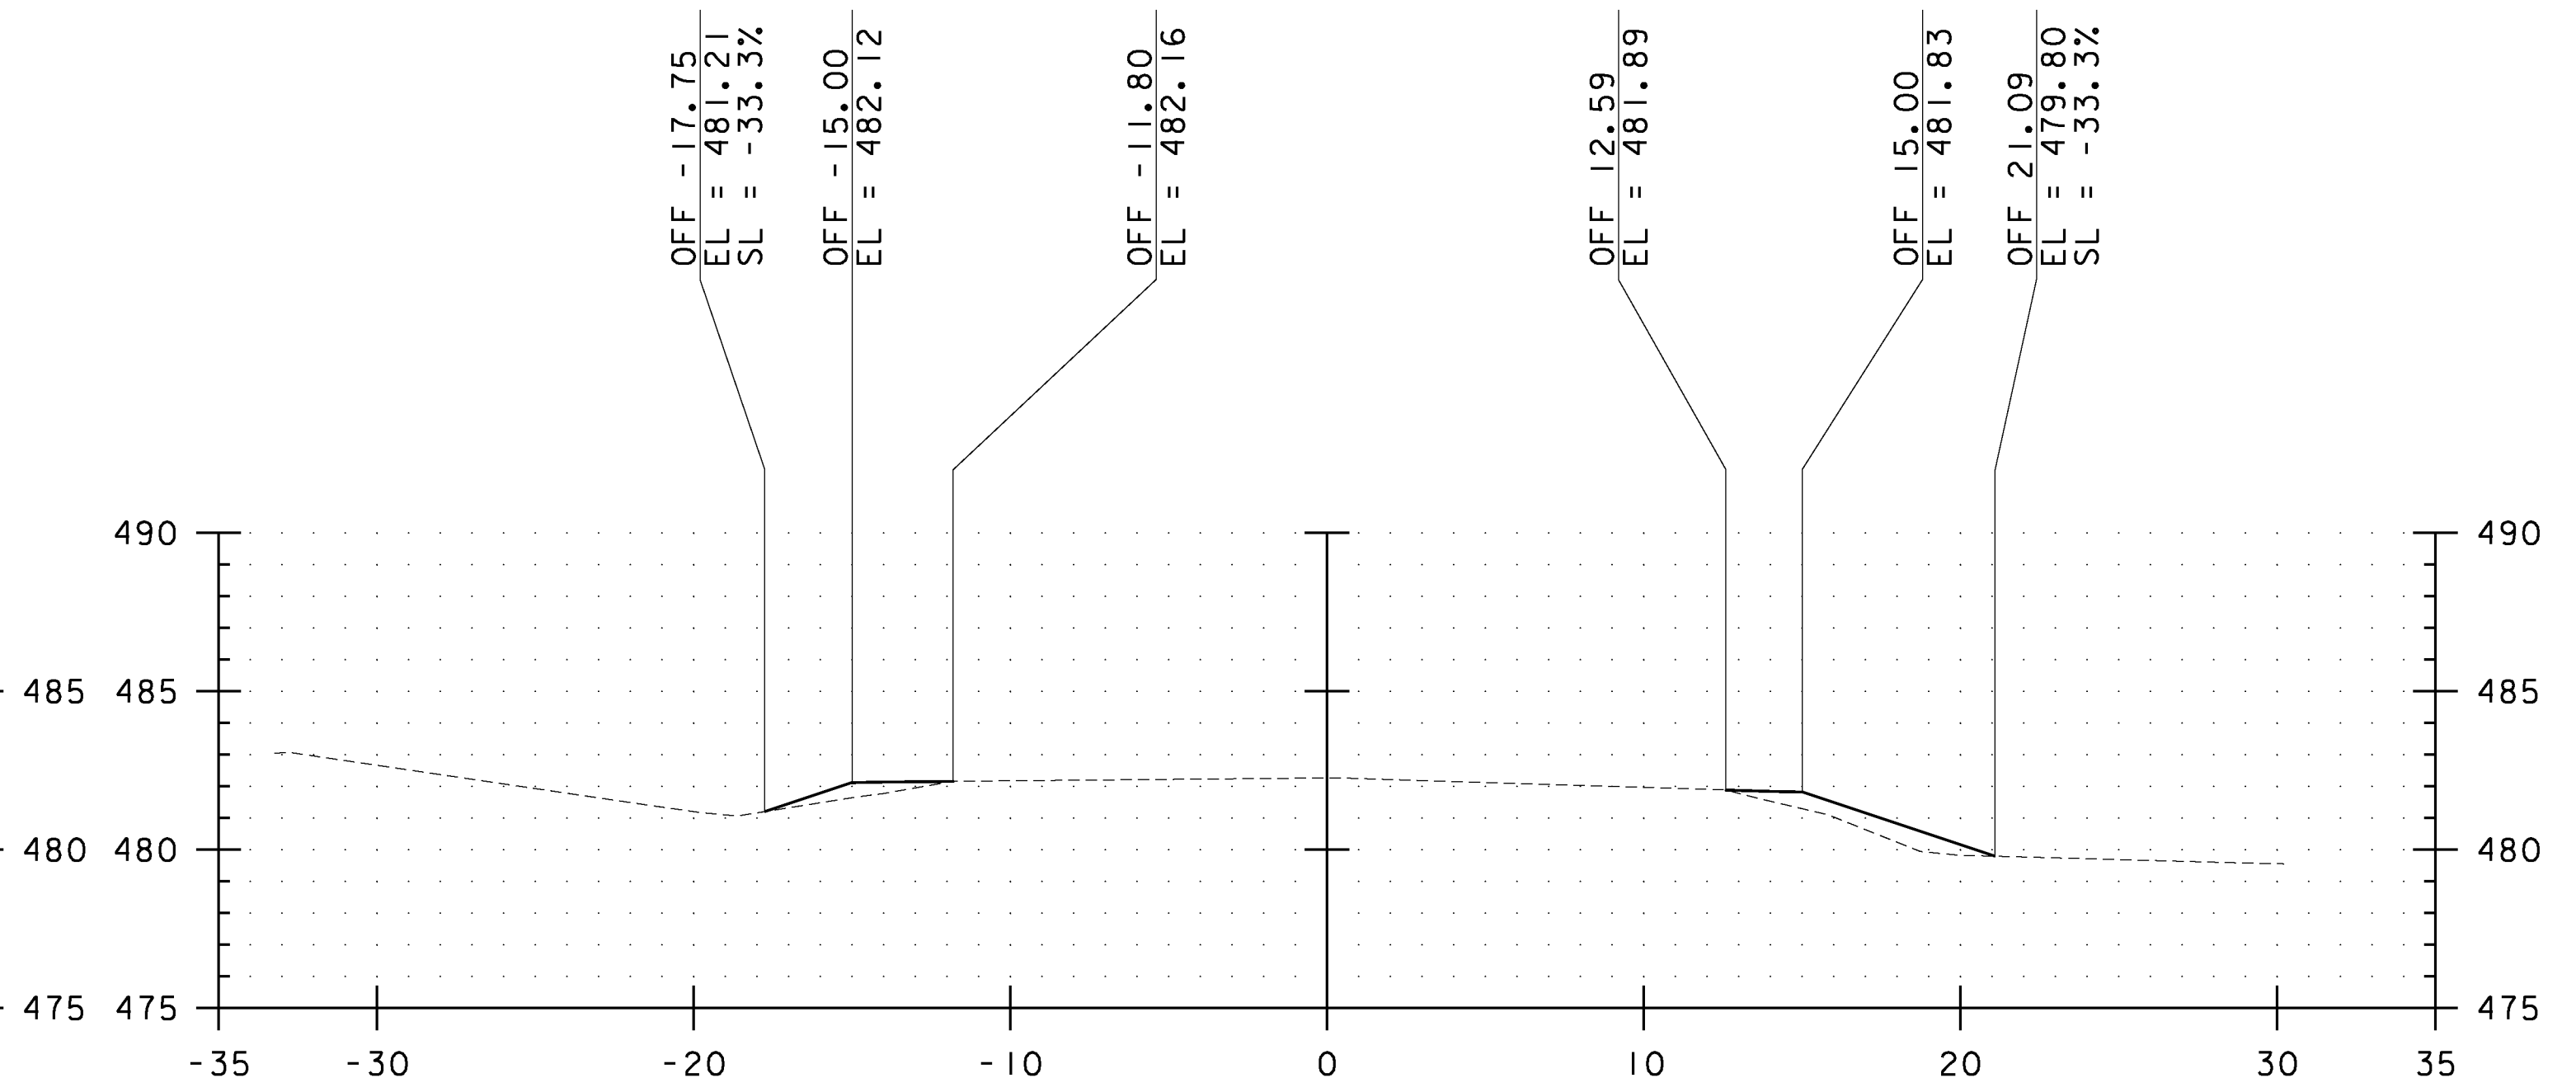

E.G. = 482.26
233+50

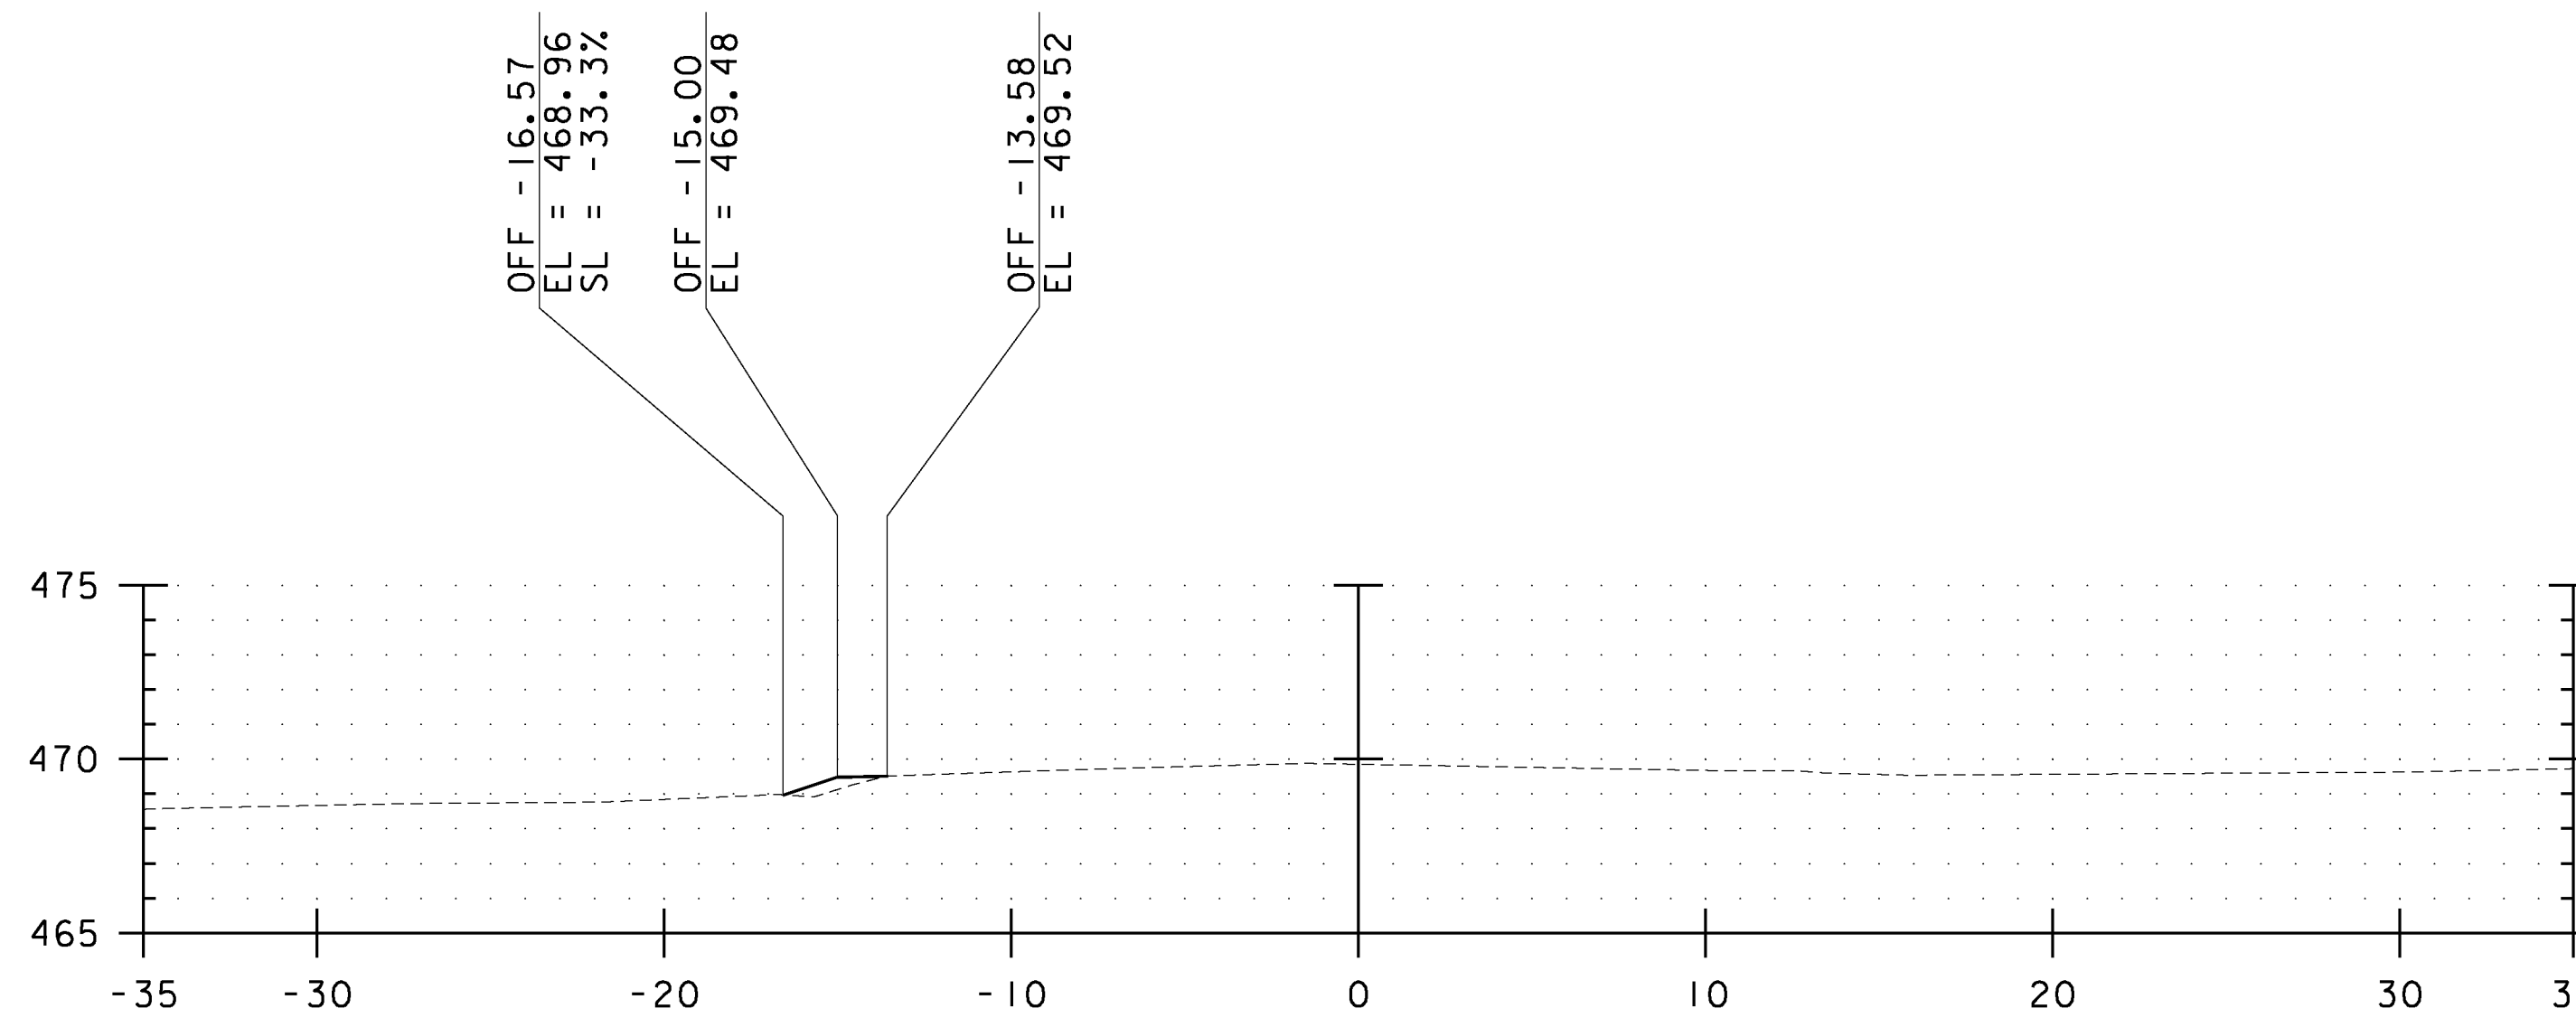

E.G. = 469.85
229+50

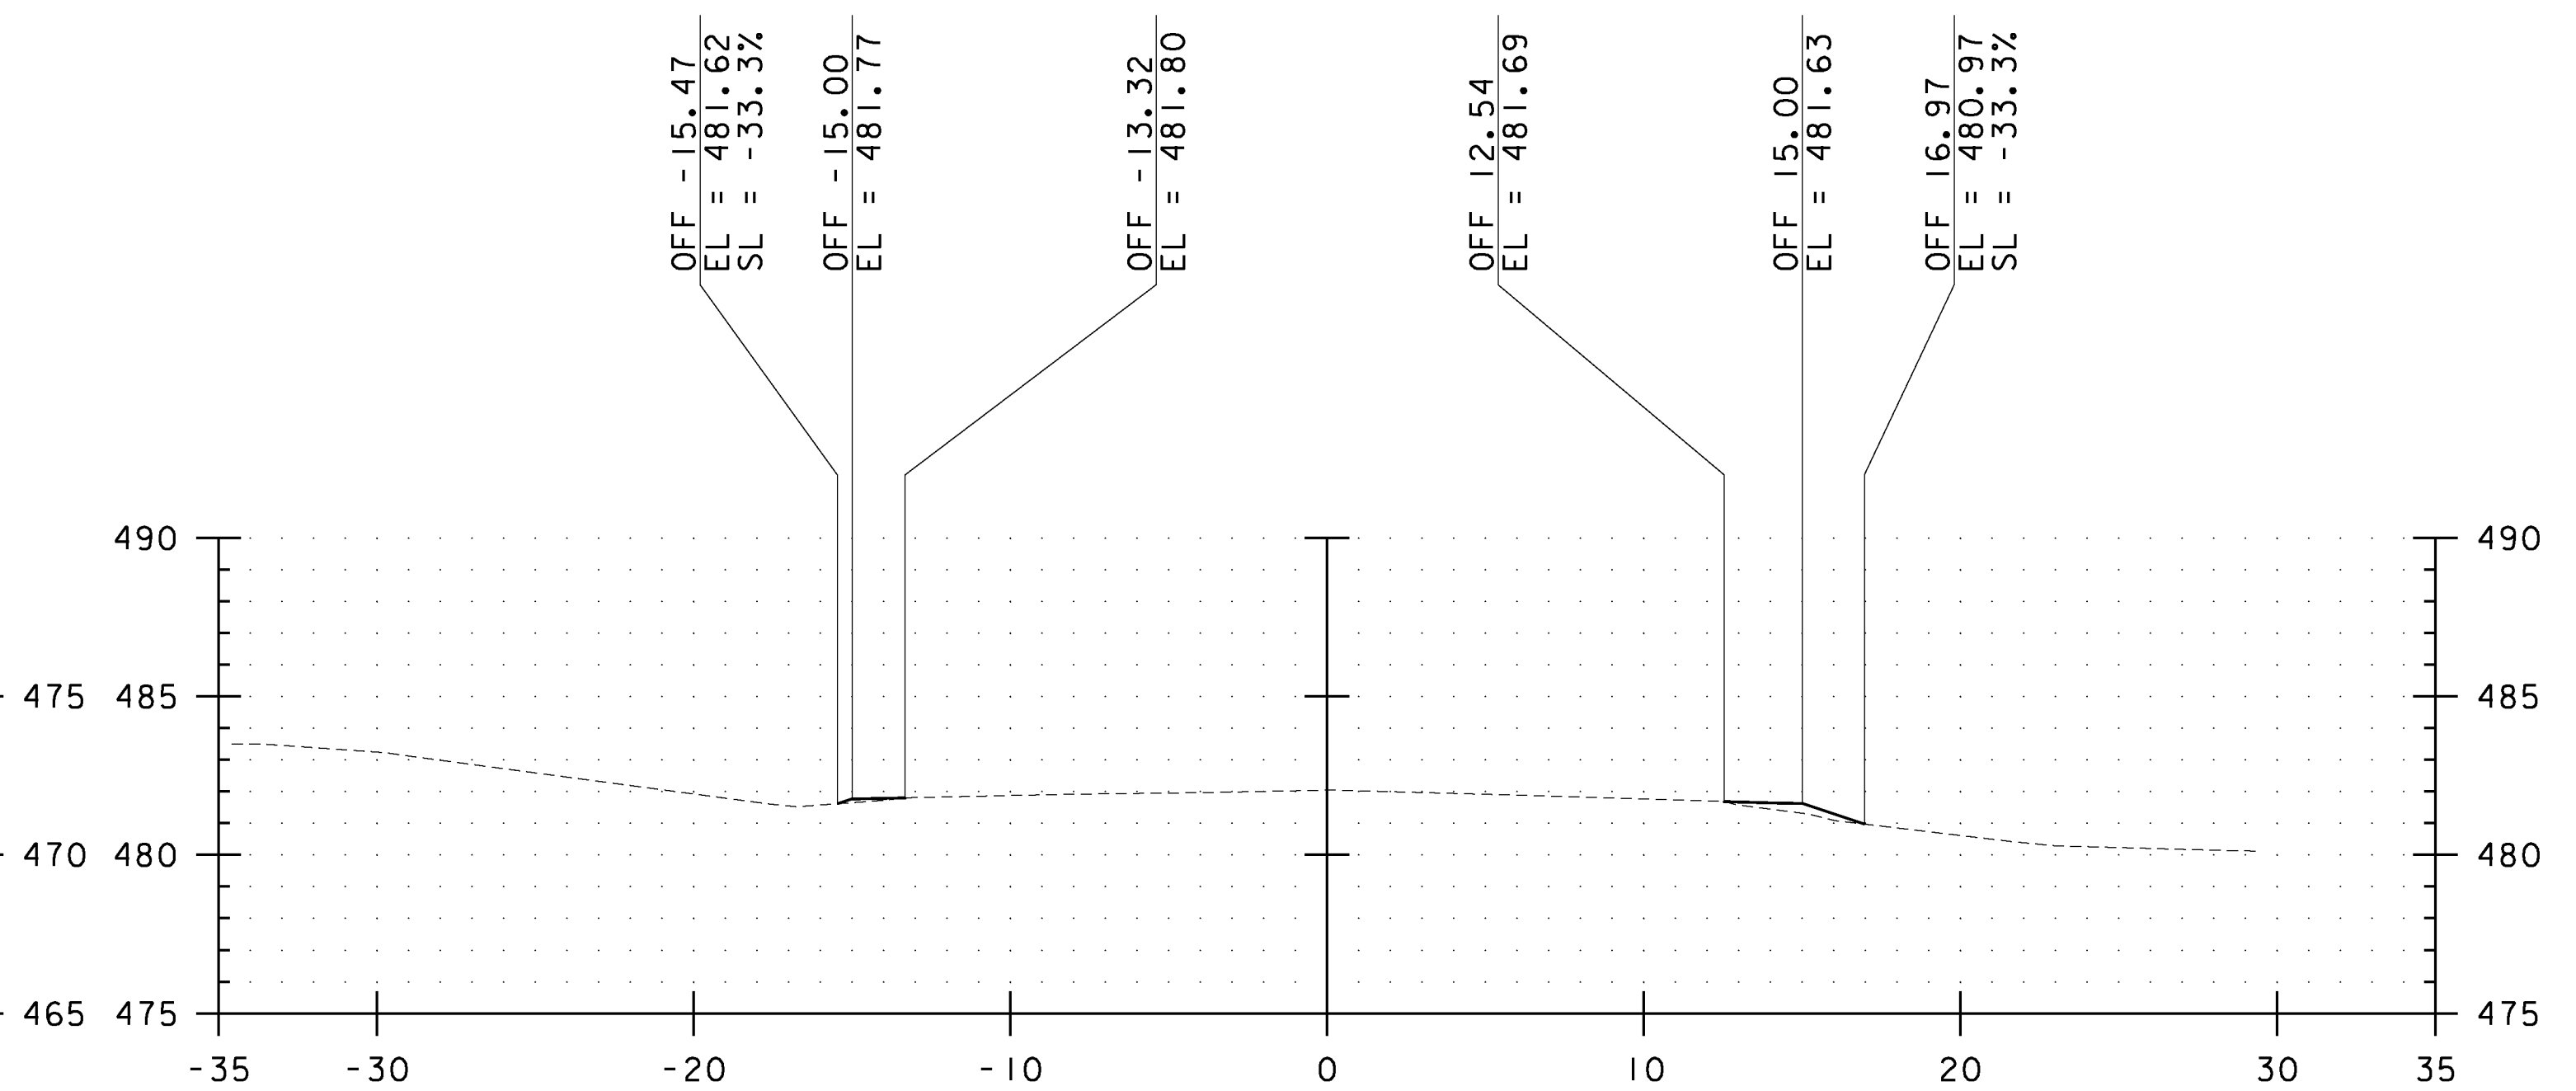

E.G. = 482.04
233+00


SCALE:
1" = 10' HORIZONTAL
1" = 10' VERTICAL

CROSS SLOPE SHALL MATCH EXISTING

ALL SIDESLOPES SHALL BE
CONSTRUCTED TO A 1:3 MAXIMUM GRADE
UNLESS SPECIFICALLY NOTED OTHERWISE

DATUM
VERTICAL NAVD 88
HORIZONTAL NAD 83

NO.	DATE	REVISIONS	BY	CK'D

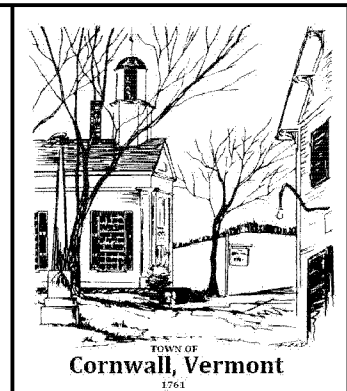

PROJECT NAME: CORNWALL - MIDDLEBURY
PROJECT NUMBER: STP EH08(13)
FILE NAME: Z08F122BDR XS.DGN
PROJECT LEADER: MS
DESIGNED BY: CM
CROSS SECTION SHEET 11
PLOT DATE: 06/09/2010
DRAWN BY: CM
CHECKED BY: MS
SHEET 94 OF 133