


SCALE:
 1" = 10' HORIZONTAL
 1" = 10' VERTICAL

CROSS SLOPE SHALL MATCH EXISTING

ALL SIDESLOPES SHALL BE
 CONSTRUCTED TO A 1:3 MAXIMUM GRADE
 UNLESS SPECIFICALLY NOTED OTHERWISE

DATUM
 VERTICAL NAVD 88
 HORIZONTAL NAD 83

NO.	DATE	REVISIONS	BY	CK'D

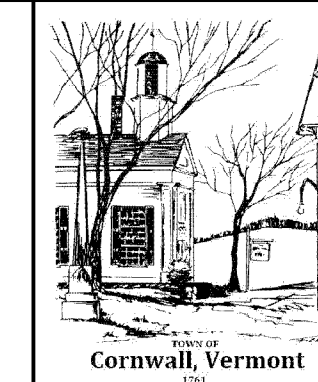

PROJECT NAME: CORNWALL - MIDDLEBURY

PROJECT NUMBER: STP EH08(13)

FILE NAME: Z08F122BDR XS.DGN

PROJECT LEADER: MS

DESIGNED BY: CM

CROSS SECTION SHEET 27

PLOT DATE: 06/09/2010

DRAWN BY: CM

CHECKED BY: MS

SHEET 110 OF 133