

SLOPE STEEPER THAN 1:3. REFER TO LAYOUT SHEETS FOR PLACEMENT OF SOIL MATTING OR TYPE 1 STONE.

SCALE:
1" = 10' HORIZONTAL
1" = 10' VERTICAL


CROSS SLOPE SHALL MATCH EXISTING

ALL SIDESLOPES SHALL BE CONSTRUCTED TO A 1:3 MAXIMUM GRADE UNLESS SPECIFICALLY NOTED OTHERWISE

DATUM
VERTICAL NAVD 88
HORIZONTAL NAD 83

NO.	DATE	REVISIONS	BY	CK'D

R | S | G INC.
RESOURCE SYSTEMS GROUP, INC.
60 Lake Street, Unit 1E • Burlington, Vermont 05401
TEL 802.393.0118 • FAX 802.393.0122 • www.rsginc.com

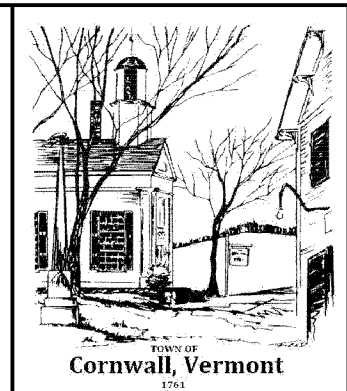

PROJECT NAME: CORNWALL - MIDDLEBURY
PROJECT NUMBER: STP EH08(13)
FILE NAME: Z08F122BDR XS.DGN
PROJECT LEADER: MS
DESIGNED BY: CM
CROSS SECTION SHEET 33
PLOT DATE: 06/09/2010
DRAWN BY: CM
CHECKED BY: MS
SHEET 116 OF 133