


SCALE:
1" = 10' HORIZONTAL
1" = 10' VERTICAL

CROSS SLOPE SHALL MATCH EXISTING


ALL SIDESLOPES SHALL BE
CONSTRUCTED TO A 1:3 MAXIMUM GRADE
UNLESS SPECIFICALLY NOTED OTHERWISE

NO.	DATE	REVISIONS	BY	CK'D

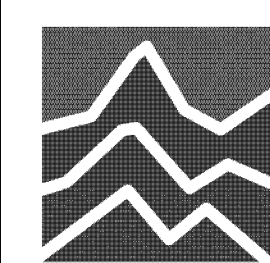

RS&G INC.
RESOURCE SYSTEMS GROUP, INC.

60 Lake Street, Unit 1E • Burlington, Vermont 05401
TEL 802.383.0118 • FAX 802.383.0122 • www.rsandg.com

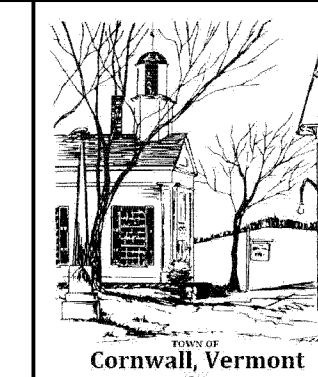

PROJECT NAME: CORNWALL - MIDDLEBURY

PROJECT NUMBER: STP EH08(13)

FILE NAME: Z08F122BDR XS.DGN

PROJECT LEADER: MS

DESIGNED BY: CM

CROSS SECTION SHEET 40

PLOT DATE: 06/09/2010

DRAWN BY: CM

CHECKED BY: MS

SHEET 123 OF 133

DATUM
VERTICAL NAVD 88
HORIZONTAL NAD 83