




E.G. = 377.96
2+50

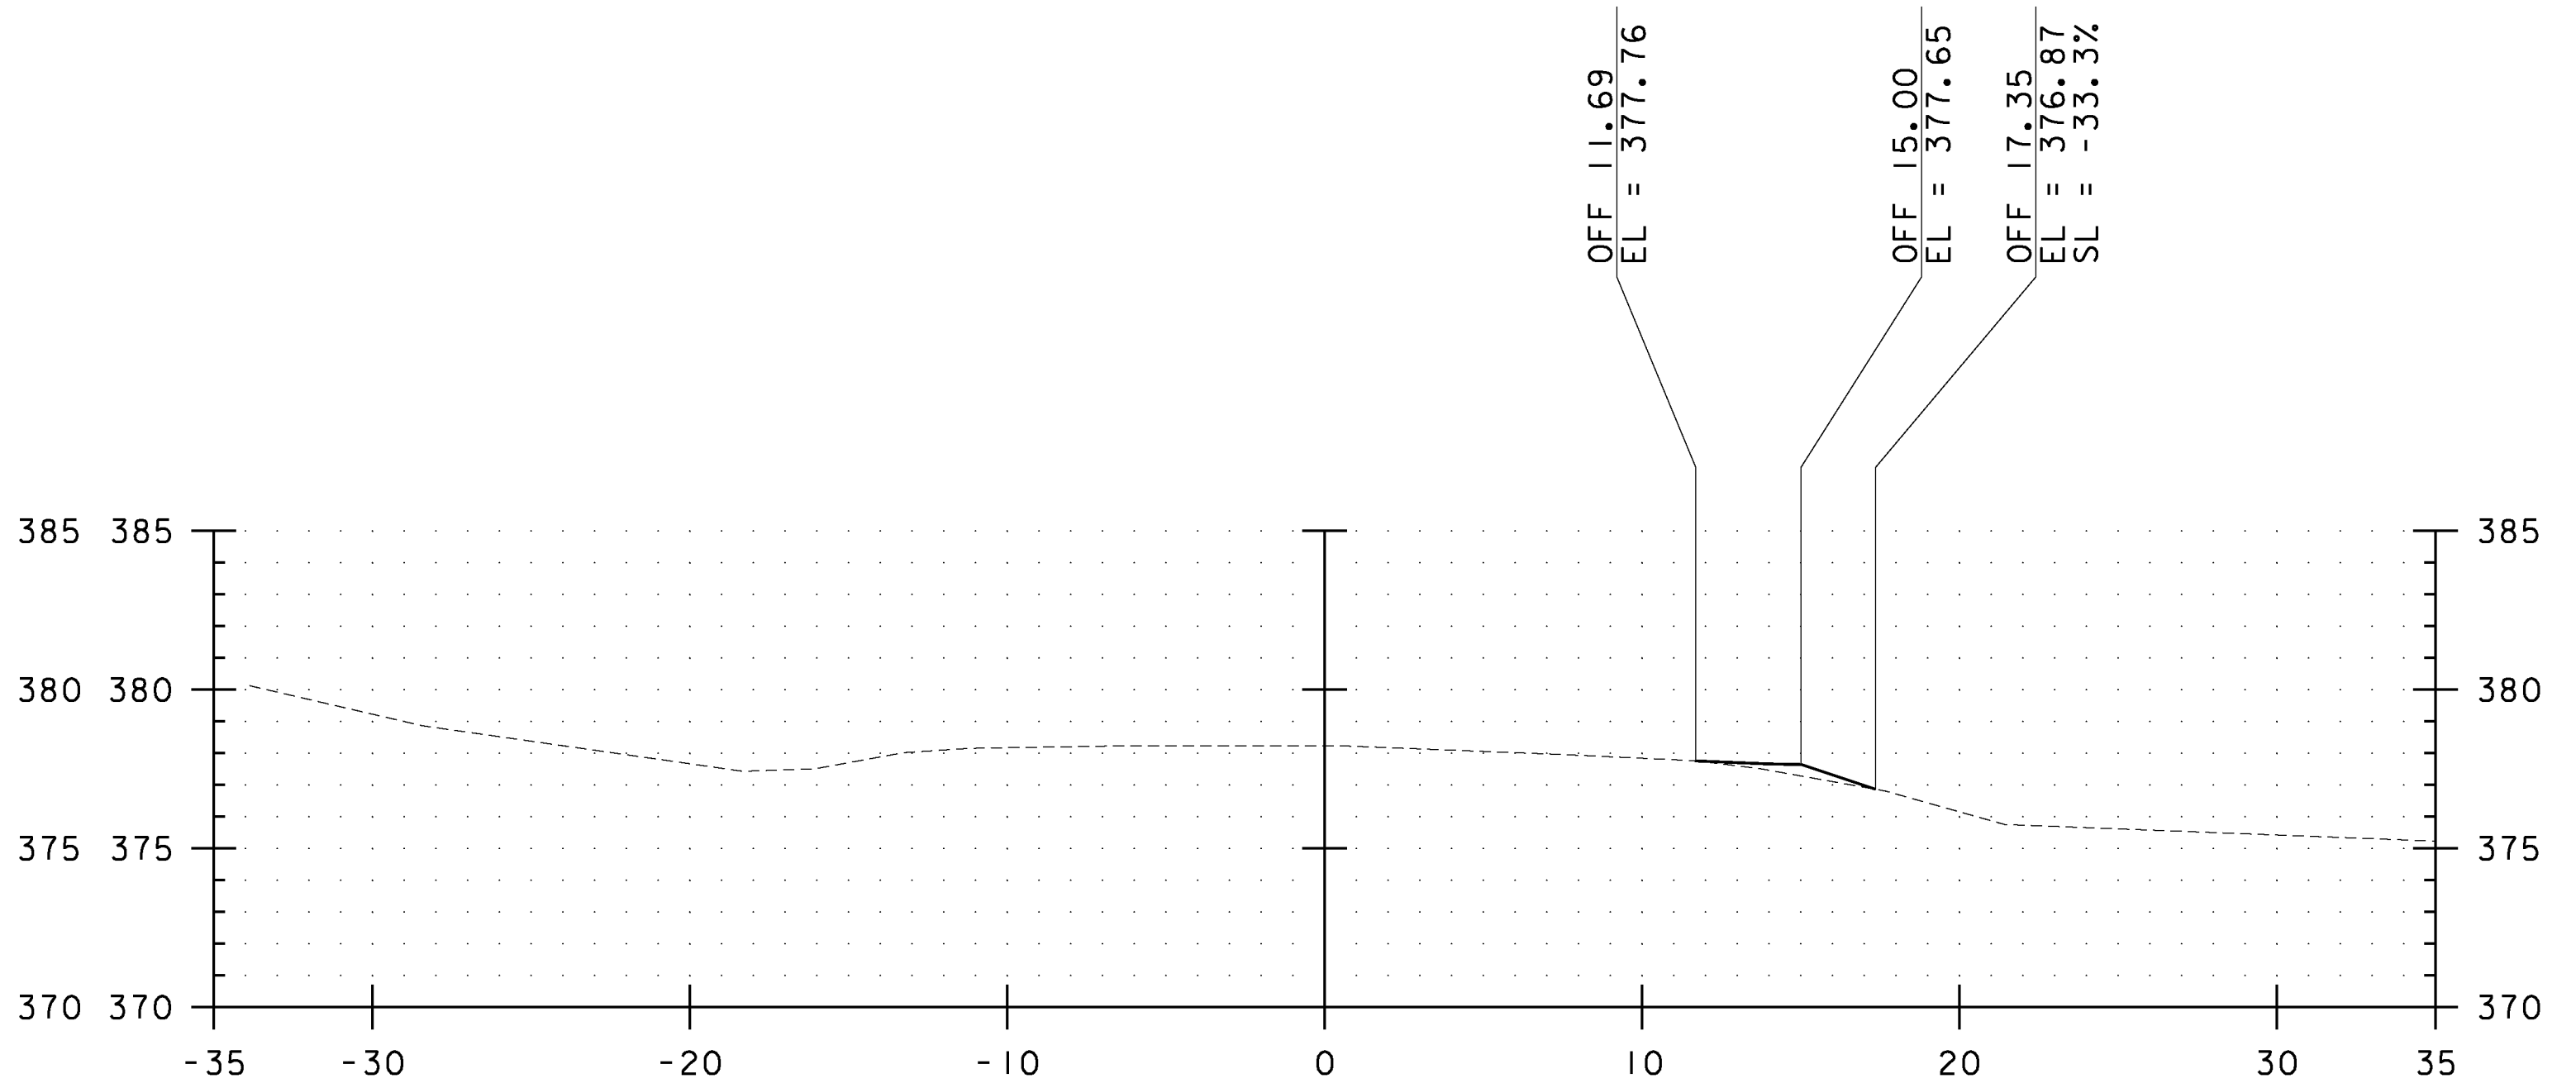

E.G. = 378.24
3+50

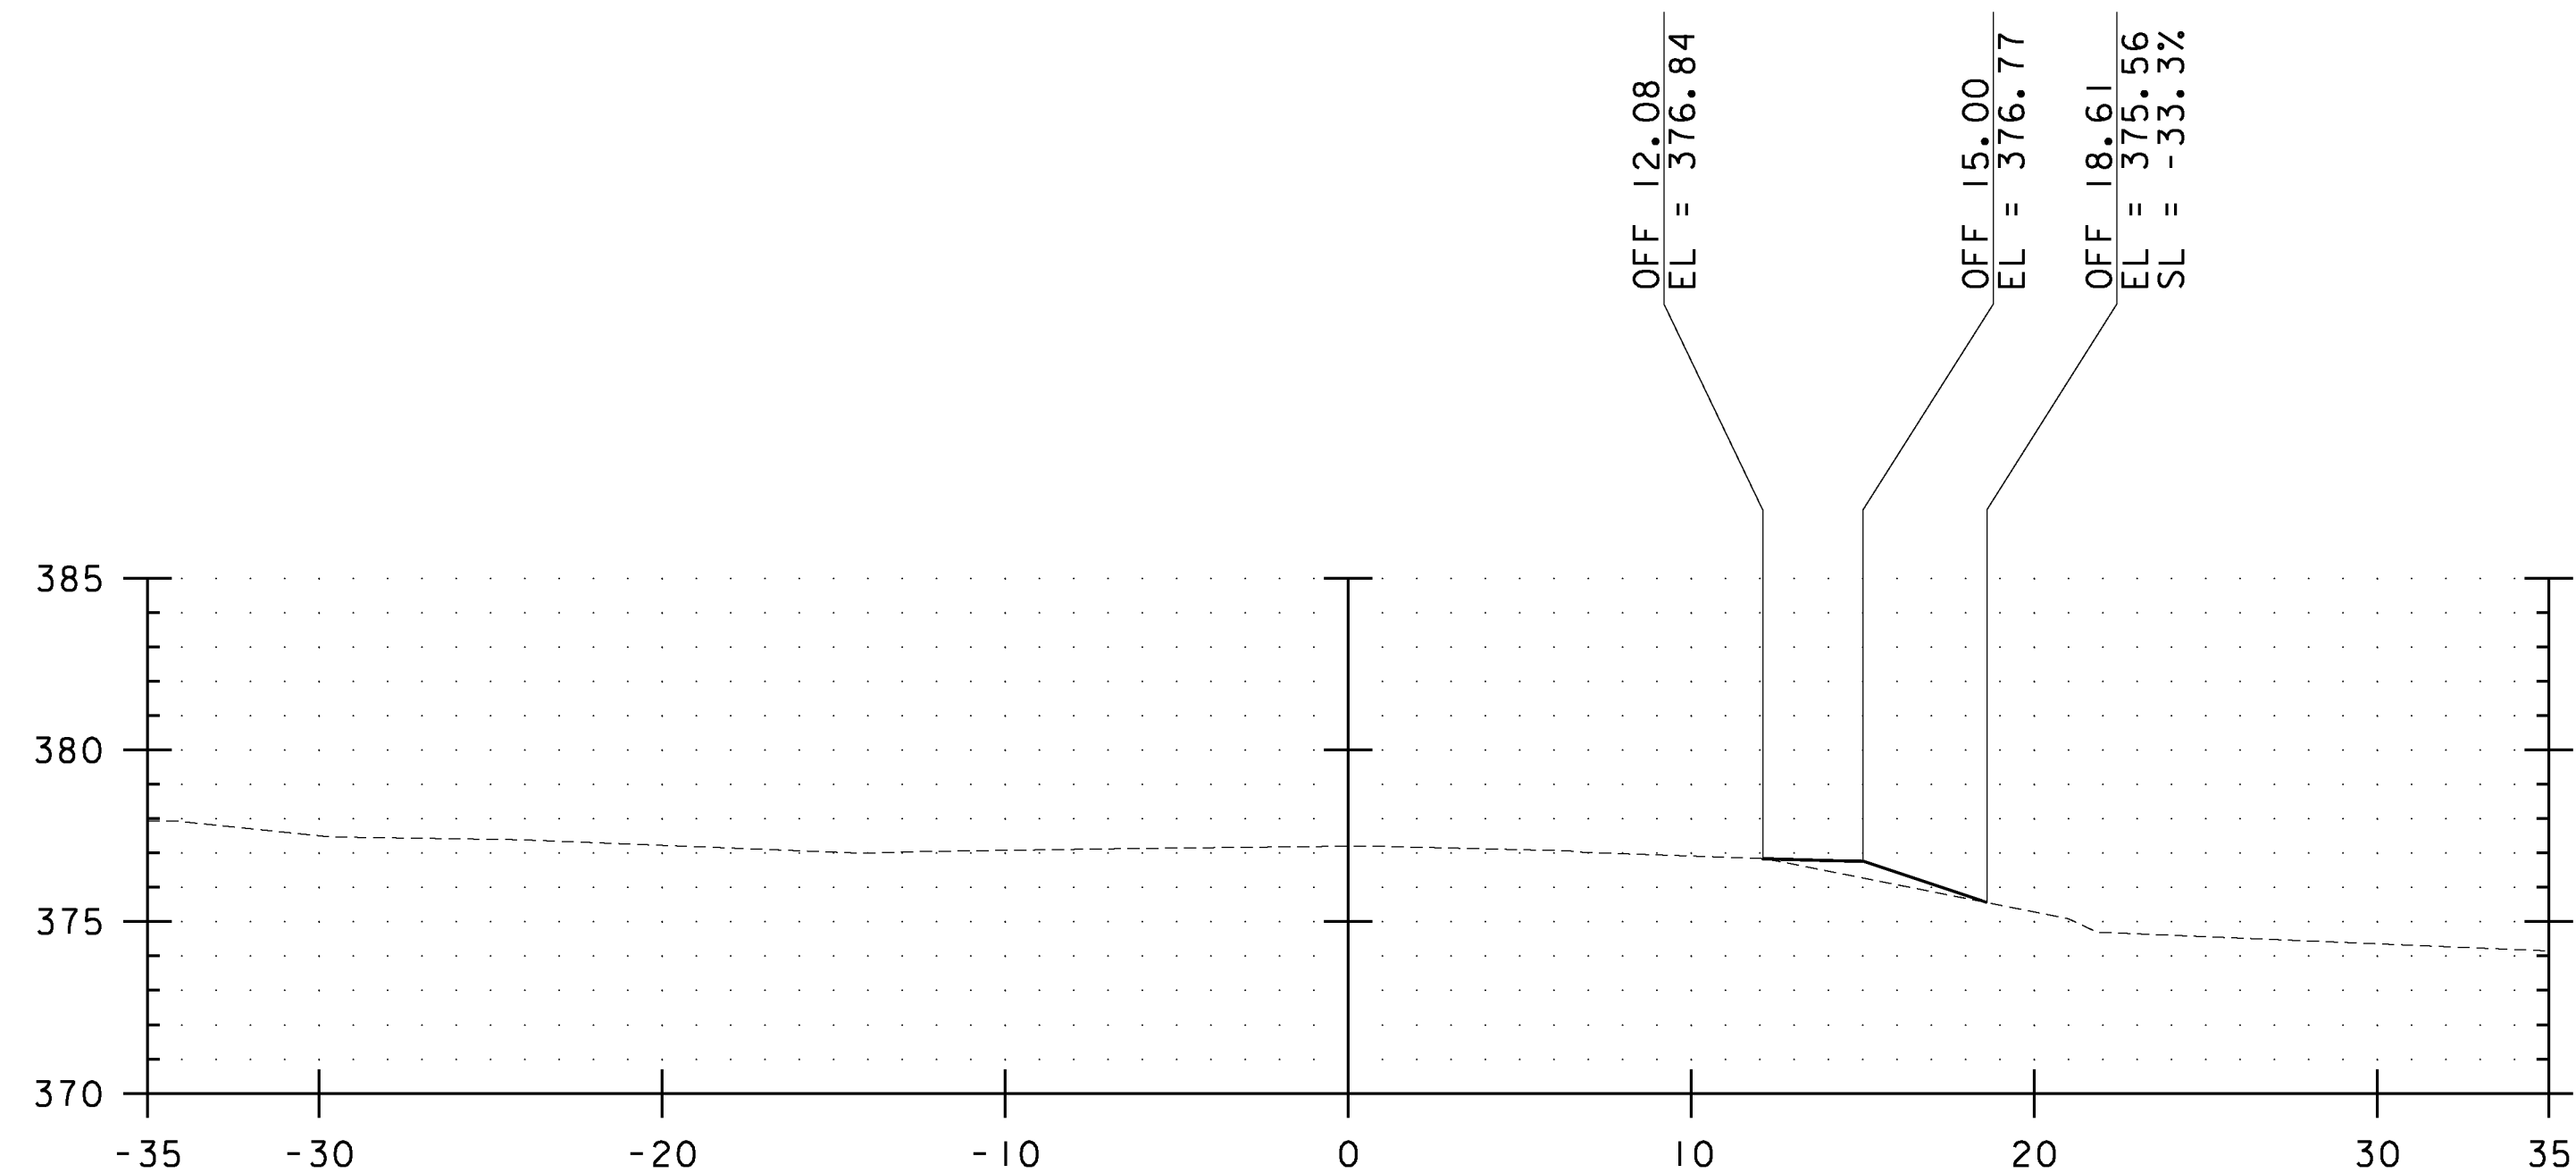

E.G. = 377.20
2+00

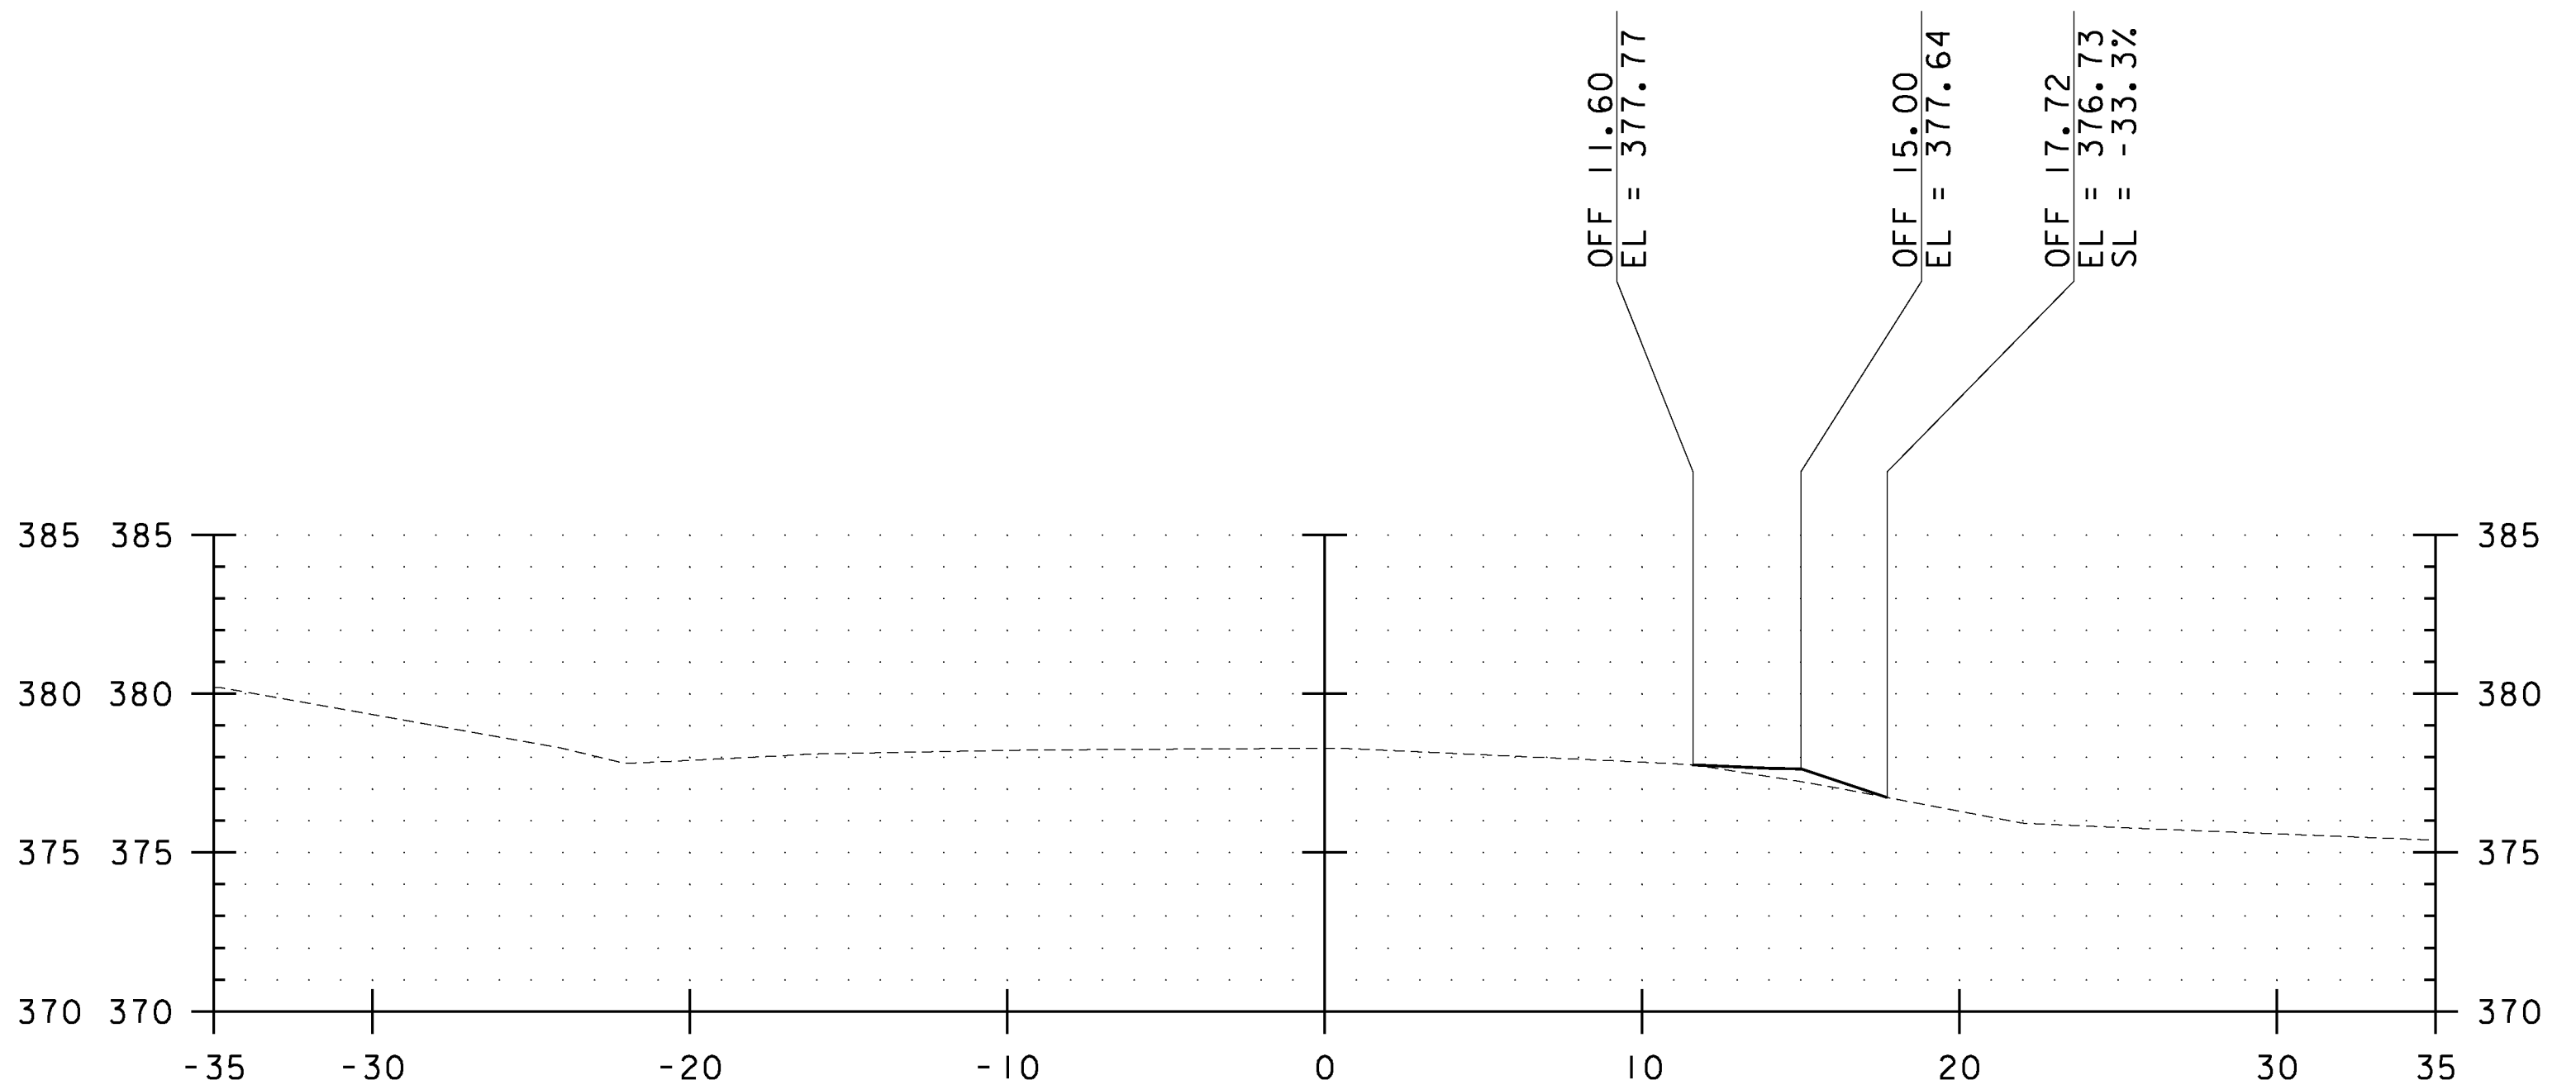

E.G. = 378.29
3+00


SCALE:
1" = 10' HORIZONTAL
1" = 10' VERTICAL

CROSS SLOPES SHALL MATCH EXISTING

ALL SIDESLOPES SHALL BE
CONSTRUCTED TO A 1:3 MAXIMUM GRADE
UNLESS SPECIFICALLY NOTED OTHERWISE


DATUM
VERTICAL NAVD 88
HORIZONTAL NAD 83

NO.	DATE	REVISIONS	BY	CK'D

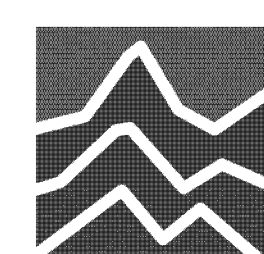

RS|G INC.
RESOURCE SYSTEMS GROUP, INC.

60 Lake Street, Unit 1E • Burlington, Vermont 05401
TEL 802.383.0118 • FAX 802.383.0122 • www.rsginc.com

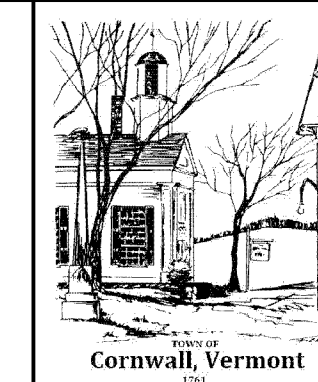

PROJECT NAME: CORNWALL - MIDDLEBURY

PROJECT NUMBER: STP EH08(13)

FILE NAME: Z08F122BDR XS.DGN

PROJECT LEADER: MS

DESIGNED BY: CM

CROSS SECTION SHEET 42

PLOT DATE: 06/09/2010

DRAWN BY: CM

CHECKED BY: MS

SHEET 125 OF 133