

SCALE:
 1" = 10' HORIZONTAL
 1" = 10' VERTICAL


CROSS SLOPE SHALL MATCH EXISTING

ALL SIDESLOPES SHALL BE
 CONSTRUCTED TO A 1:3 MAXIMUM GRADE
 UNLESS SPECIFICALLY NOTED OTHERWISE

DATUM
 VERTICAL NAVD 88
 HORIZONTAL NAD 83

NO.	DATE	REVISIONS	BY	CK'D

R | S | G INC.
 RESOURCE SYSTEMS GROUP, INC.
 60 Lake Street, Unit 1E • Burlington, Vermont 05401
 TEL 802.383.0118 • FAX 802.383.0122 • www.rsginc.com

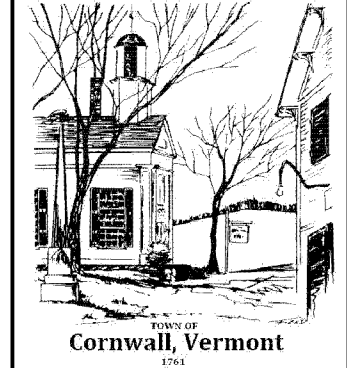

PROJECT NAME: CORNWALL - MIDDLEBURY
 PROJECT NUMBER: STP EH08(13)
 FILE NAME: Z08F122BDR XS.DGN
 PROJECT LEADER: MS
 DESIGNED BY: CM
 CROSS SECTION SHEET 44

PLOT DATE: 06/09/2010
 DRAWN BY: CM
 CHECKED BY: MS
 SHEET 127 OF 133