

SCALE:  
 1" = 10' HORIZONTAL  
 1" = 10' VERTICAL


CROSS SLOPE SHALL MATCH EXISTING

ALL SIDESLOPES SHALL BE  
 CONSTRUCTED TO A 1:3 MAXIMUM GRADE  
 UNLESS SPECIFICALLY NOTED OTHERWISE

DATUM  
 VERTICAL NAVD 88  
 HORIZONTAL NAD 83

NO.	DATE	REVISIONS	BY	CK'D

**RS&G INC.**  
 RESOURCE SYSTEMS GROUP, INC.  
 60 Lake Street, Unit 1E • Burlington, Vermont 05401  
 TEL 802.383.0118 • FAX 802.383.0122 • www.rs&ginc.com

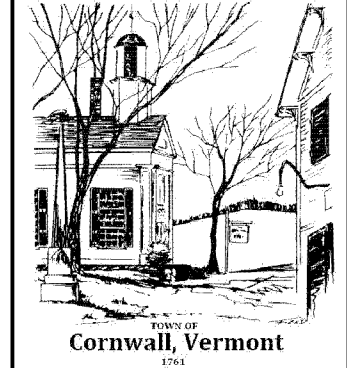

PROJECT NAME: CORNWALL - MIDDLEBURY  
 PROJECT NUMBER: STP EH08(13)  
 FILE NAME: Z08F122BDR XS.DGN  
 PROJECT LEADER: MS  
 DESIGNED BY: CM  
 CROSS SECTION SHEET 47  
 PLOT DATE: 06/09/2010  
 DRAWN BY: CM  
 CHECKED BY: MS  
 SHEET 130 OF 133