


SCALE:  
 1" = 10' HORIZONTAL  
 1" = 10' VERTICAL

CROSS SLOPE SHALL MATCH EXISTING

ALL SIDESLOPES SHALL BE  
 CONSTRUCTED TO A 1:3 MAXIMUM GRADE  
 UNLESS SPECIFICALLY NOTED OTHERWISE


DATUM  
 VERTICAL NAVD 88  
 HORIZONTAL NAD 83

NO.	DATE	REVISIONS	BY	CK'D

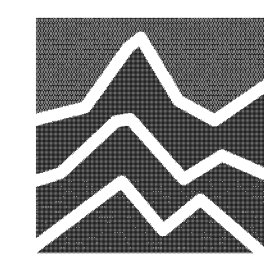

**R | S | G** INC.  
 RESOURCE SYSTEMS GROUP, INC.

60 Lake Street, Unit 1E • Burlington, Vermont 05401  
 TEL 802.393.0118 • FAX 802.393.0122 • www.rsginc.com

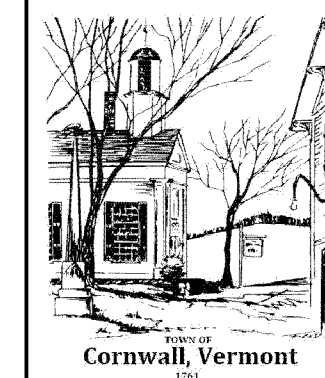

PROJECT NAME: CORNWALL - MIDDLEBURY

PROJECT NUMBER: STP EH08(13)

FILE NAME: Z08F122BDR XS.DGN

PROJECT LEADER: MS

DESIGNED BY: CM

CROSS SECTION SHEET 50

PLOT DATE: 06/09/2010

DRAWN BY: CM

CHECKED BY: MS

SHEET 133 OF 133