


COLD PLANE TYPICAL SECTION

U.S. ROUTE 7 RUTLAND CITY STA 21+40.00 TO RUTLAND CITY STA 31+00.00
 U.S. ROUTE 7 RUTLAND CITY STA 68+25.00 TO RUTLAND CITY STA 75+00.00

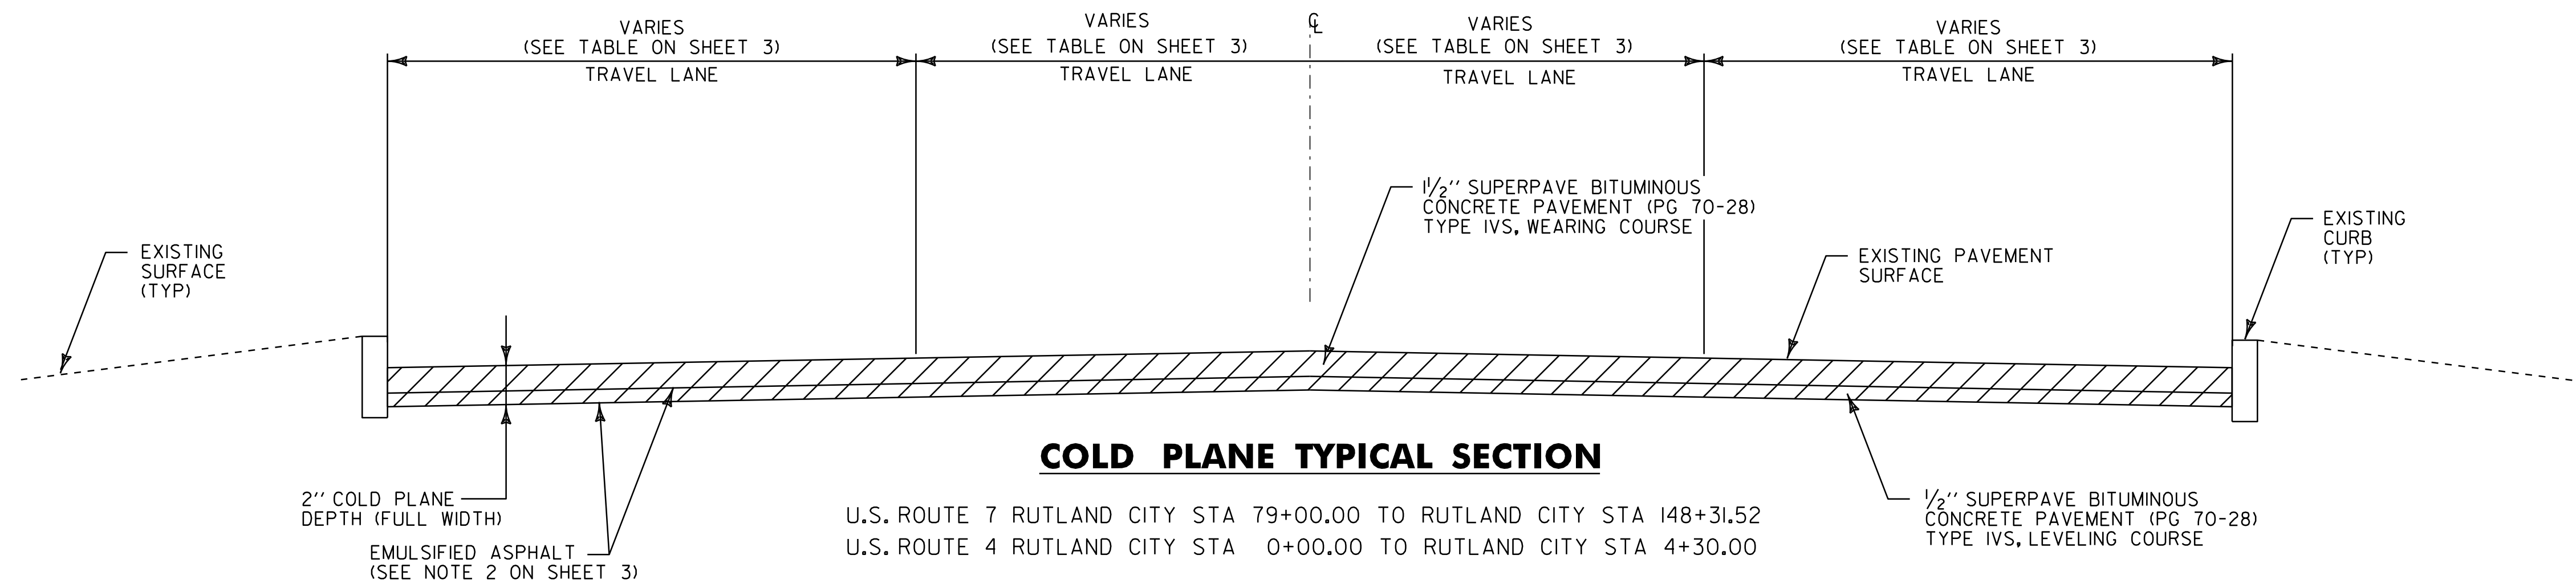

COLD PLANE TYPICAL SECTION

U.S. ROUTE 7 RUTLAND CITY STA 79+00.00 TO RUTLAND CITY STA 148+31.52
 U.S. ROUTE 4 RUTLAND CITY STA 0+00.00 TO RUTLAND CITY STA 4+30.00

NOT TO SCALE

**PROJECT
TYPICAL
SHEET #2**

PROJECT NAME: RUTLAND CITY	PLOT DATE: 03-AUG-2012 12:2
PROJECT NUMBER: NH 2605(I)S	DRAWN BY: CAK
FILE NAME: p06d050.dgn	DESIGNED BY: MJL
PROJECT LEADER: DEG	CHECKED BY: DWE
IPARM FILE: p06d050+yp2.i	SHEET 4 OF 76