


**BEGIN PROJECT
LOCATION TIES
U.S. ROUTE 7**

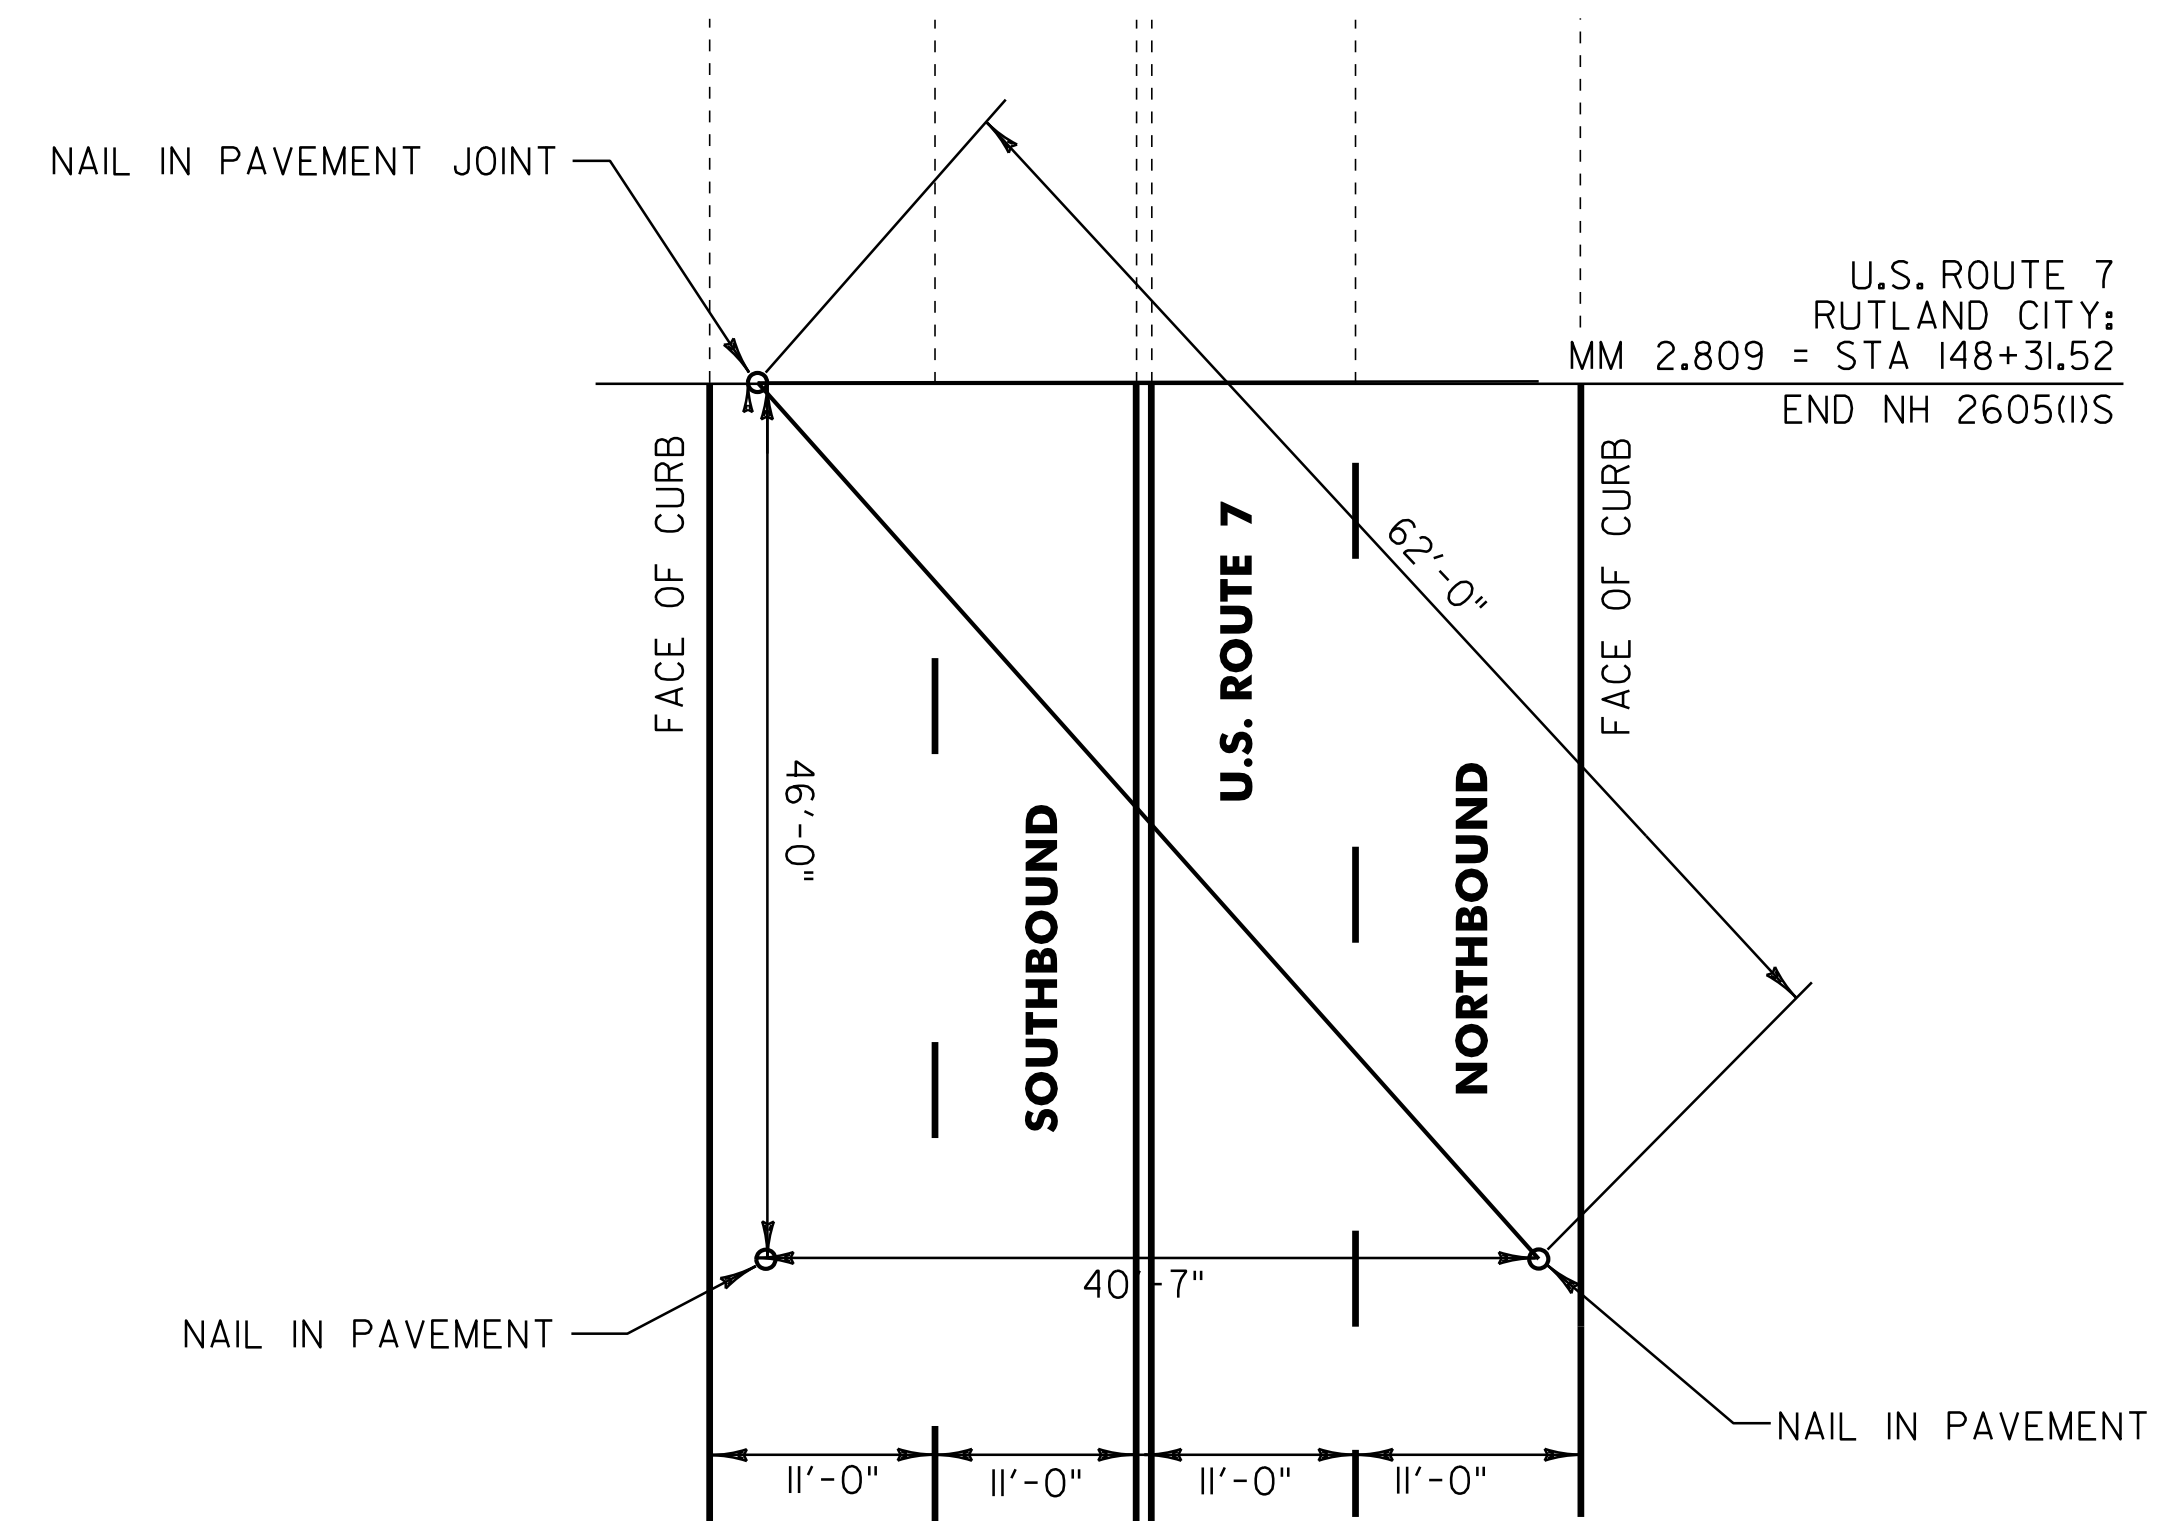

**END PROJECT
LOCATION TIES
U.S. ROUTE 7**

NOT TO SCALE

**PROJECT
TIE
SHEET**

PROJECT NAME: RUTLAND CITY	PLOT DATE: 03-AUG-2012 12:2
PROJECT NUMBER: NH 2605(I)S	DRAWN BY: CAK
FILE NAME: p06d050.dgn	CHECKED BY: DWE
PROJECT LEADER: DEG	SHEET 5 OF 76
DESIGNED BY: MJL	
IPARM FILE: p06d050pt.i	