

646.402 DURABLE 4 INCH WHITE LINE, THERMOPLASTIC  
 (ALL LINES WILL INCLUDE EDGE LINE BREAKS AND RADIUS FOR TOWN HIGHWAYS)  
 U.S. ROUTE 7:  
 STA 5+80.00 - STA 12+00.00 EDGE LINE LT/RT  
 STA 5+80.00 - STA 12+00.00 DASHED LANE LINE RT  
 STA 6+00.00 - STA 6+76.00 SOLID LANE LINE LT  
 STA 6+01.00 - STA 12+00.00 DASHED LANE LINE LT

646.412 DURABLE 4 INCH YELLOW LINE, THERMOPLASTIC  
 (ALL LINES WILL INCLUDE C/L BREAKS FOR TOWN HIGHWAYS)  
 U.S. ROUTE 7:  
 STA 6+00.00 - STA 6+92.00 DOUBLE SOLID RT  
 STA 7+18.08 DOUBLE SOLID LT, MARBLE AVENUE  
 STA 7+30.00 - STA 8+10.00 DOUBLE SOLID LT/RT  
 STA 8+10.00 - STA 12+00.00 SOLID/DASH TURN LANE LINES LT/RT

646.491 DURABLE LETTER OR SYMBOL, TYPE I TAPE  
 U.S. ROUTE 7:  
 STA 6+09.25 C/L, ARROW (1EA)  
 STA 6+71.84 C/L, "O,N,L,Y" (4 EA)  
 STA 7+18.08 LT, MARBLE AVENUE, "S,T,O,P" (4 EA)  
 STA 8+37.00 C/L, ARROW (1EA)  
 STA 8+48.00 C/L, ARROW (1EA)  
 STA 9+75.00 C/L, ARROW (1EA)  
 STA 9+86.00 C/L, ARROW (1EA)  
 STA 11+01.00 C/L, ARROW (1EA)  
 STA 11+12.00 C/L, ARROW (1EA)

646.692 TEMPORARY LETTER OR SYMBOL, PAINT  
 U.S. ROUTE 7:  
 STA 6+09.25 C/L, ARROW (2 EA)  
 STA 7+18.08 LT, MARBLE AVENUE, "S,T,O,P" (8 EA)  
 STA 8+37.00 C/L, ARROW (2 EA)  
 STA 8+48.00 C/L, ARROW (2 EA)  
 STA 9+75.00 C/L, ARROW (2 EA)  
 STA 9+86.00 C/L, ARROW (2 EA)  
 STA 11+01.00 C/L, ARROW (2 EA)  
 STA 11+12.00 C/L, ARROW (2 EA)

646.702 TEMPORARY CROSSWALK MARKING, PAINT  
 U.S. ROUTE 7:  
 STA 7+18.08 LT, MARBLE AVENUE  
 STA 10+56.00 LT, DANA AVENUE

646.502 DURABLE CROSSWALK MARKING, THERMOPLASTIC  
 U.S. ROUTE 7:  
 STA 7+18.08 LT, MARBLE AVENUE  
 STA 10+56.00 LT, DANA AVENUE

646.602 TEMPORARY 4 INCH WHITE LINE, PAINT  
 (ALL LINES WILL INCLUDE EDGE LINE BREAKS AND RADIUS FOR TOWN HIGHWAYS)  
 U.S. ROUTE 7:  
 STA 5+80.00 - STA 12+00.00 EDGE LINE LT/RT  
 STA 5+80.00 - STA 12+00.00 DASHED LANE LINE RT  
 STA 6+00.00 - STA 6+76.00 SOLID LANE LINE LT  
 STA 6+01.00 - STA 12+00.00 DASHED LANE LINE LT


646.612 TEMPORARY 4 INCH YELLOW LINE, PAINT  
 (ALL LINES WILL INCLUDE C/L BREAKS FOR TOWN HIGHWAYS)  
 U.S. ROUTE 7:  
 STA 6+00.00 - STA 6+92.00 DOUBLE SOLID RT  
 STA 7+18.08 DOUBLE SOLID LT, MARBLE AVENUE  
 STA 7+30.00 - STA 8+10.00 DOUBLE SOLID LT/RT  
 STA 8+10.00 - STA 12+00.00 SOLID/DASH TURN LANE LINES LT/RT

646.452 DURABLE 8 INCH YELLOW LINE, THERMOPLASTIC  
 U.S. ROUTE 7:  
 STA 7+30.00 - STA 8+10.00 HATCHED MEDIAN LT/RT

646.682 TEMPORARY 24 INCH STOP BAR, PAINT  
 U.S. ROUTE 7:  
 STA 6+00.00 LT  
 STA 7+18.08 LT, MARBLE AVENUE  
 STA 8+05.00 LT

675.50 REMOVING SIGNS  
 AS SHOWN - 14

675.60 ERECTING SALVAGED SIGNS  
 AS SHOWN - 4

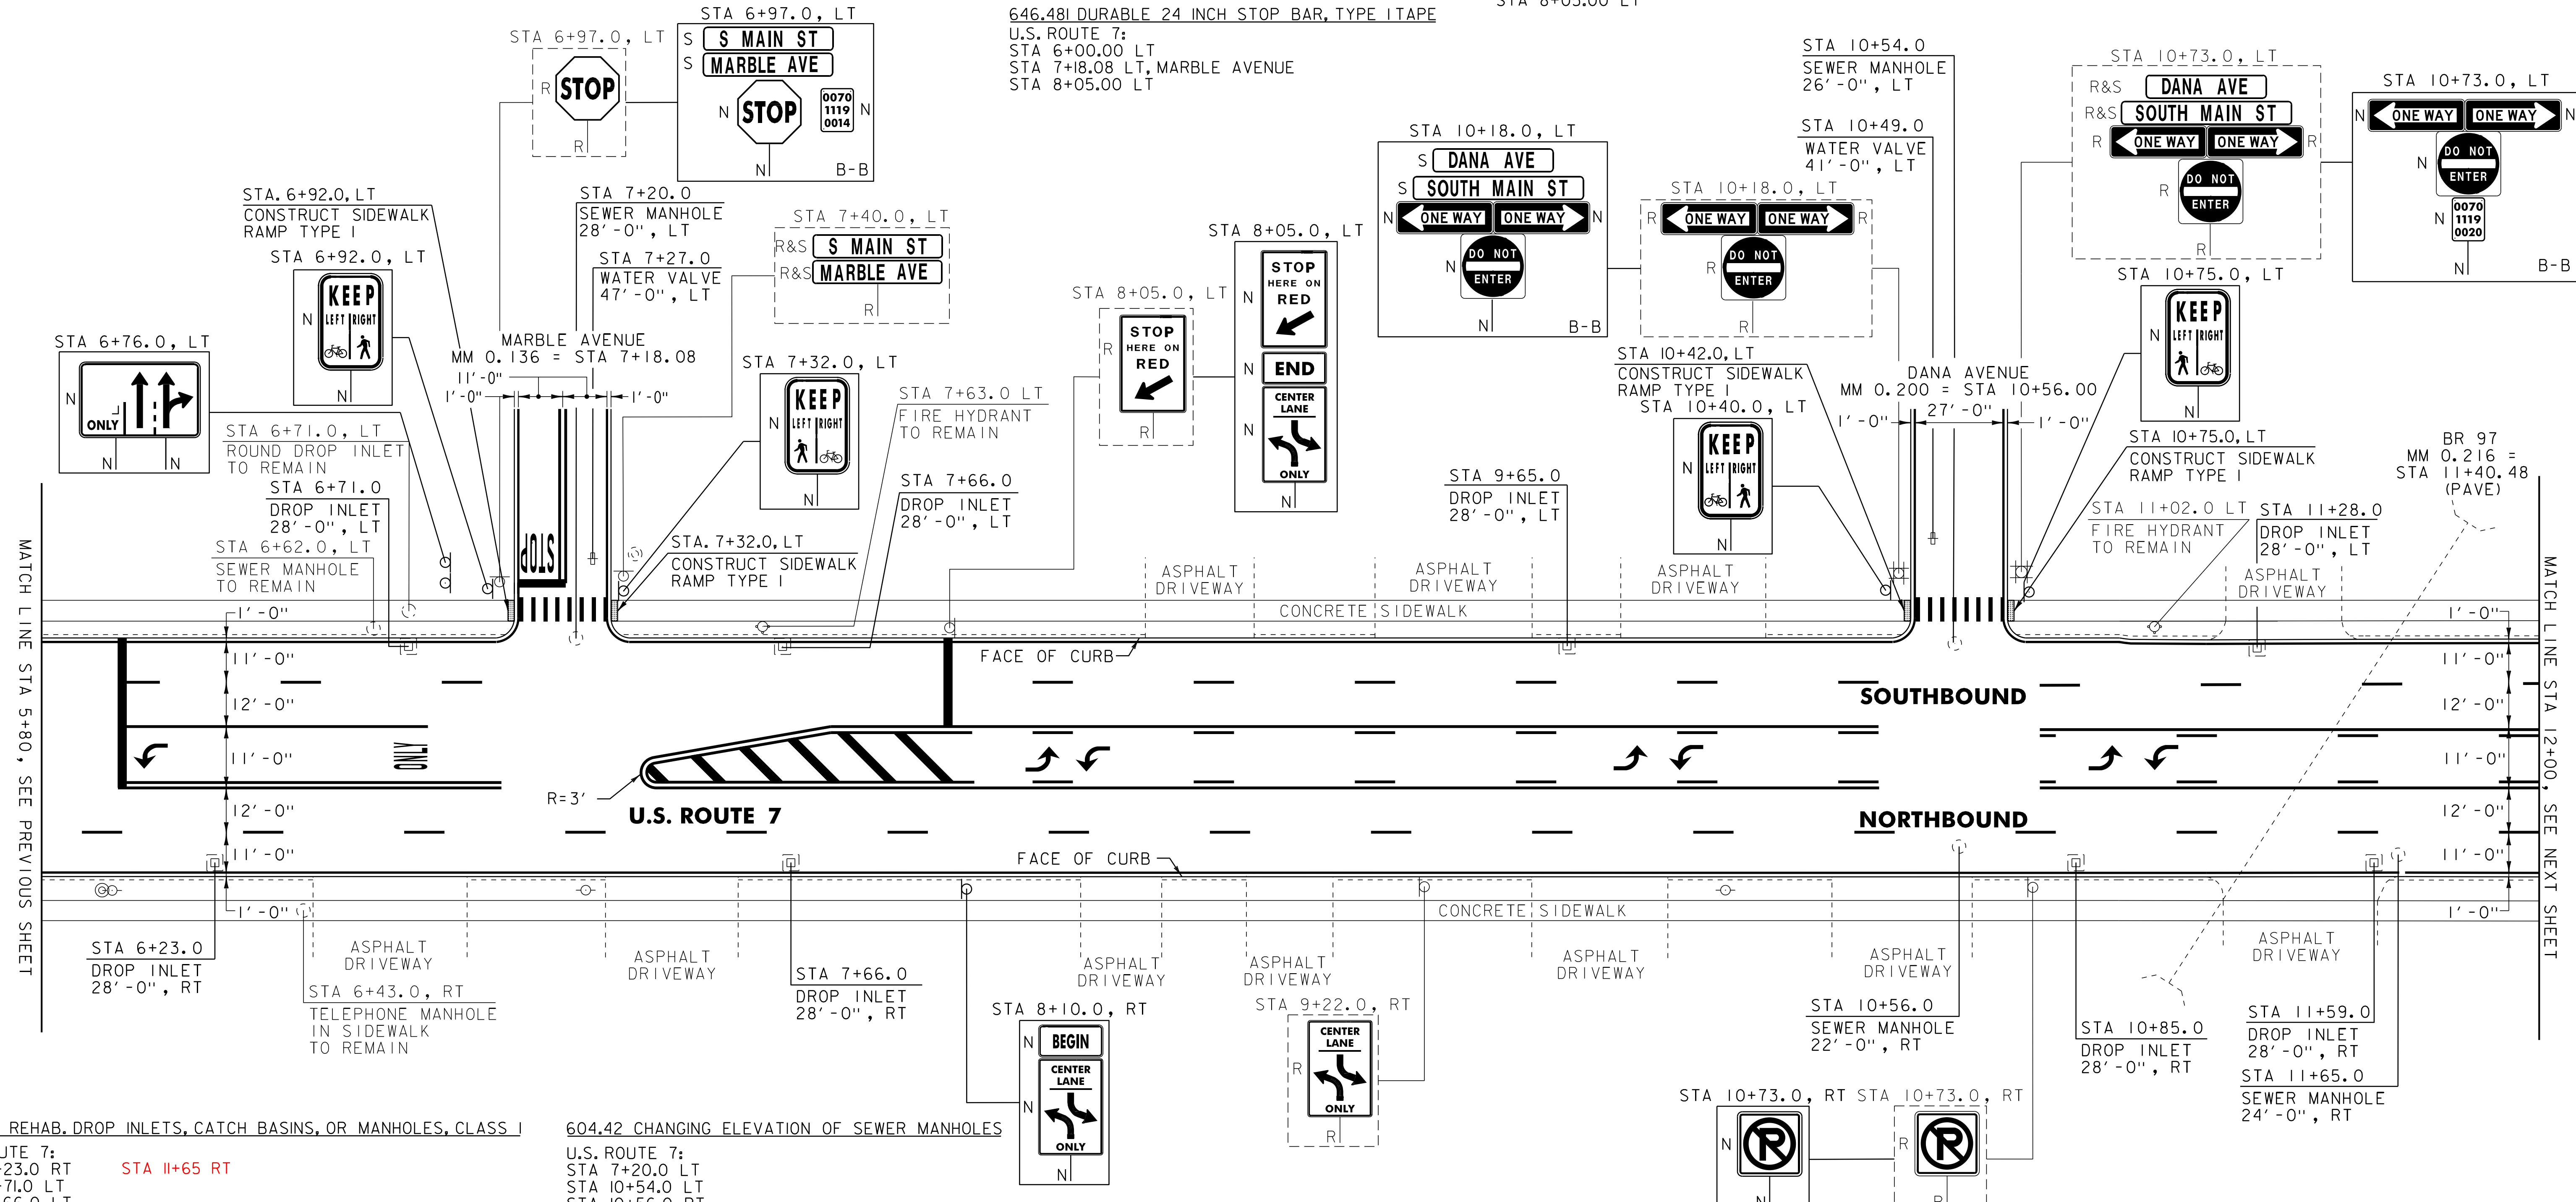

604.412 REHAB. DROP INLETS, CATCH BASINS, OR MANHOLES, CLASS I  
 U.S. ROUTE 7:  
 STA 6+23.0 RT STA 11+65.0 RT  
 STA 6+71.0 LT  
 STA 7+66.0 LT  
 STA 7+66.0 RT  
 STA 9+65.0 LT  
 STA 10+85.0 RT  
 STA 11+28.0 LT  
 STA 11+59.0 RT

604.42 CHANGING ELEVATION OF SEWER MANHOLES  
 U.S. ROUTE 7:  
 STA 7+20.0 LT  
 STA 10+54.0 LT  
 STA 10+56.0 RT

629.20 ADJUST ELEVATION OF VALVE BOX  
 U.S. ROUTE 7:  
 STA 7+27.0 LT  
 STA 10+49.0 LT

604.415 REHAB. DROP INLETS, CATCH BASINS, OR MANHOLES, CLASS II  
 U.S. ROUTE 7:  
 STA 11+65.0 RT

NOTES:  
 1. PAVING LIMIT ON ALL TOWN HIGHWAYS SHALL BE MEASURED 25 FT BACK FROM U.S. ROUTE 7 EDGE OF SHOULDER UNLESS DENOTED OTHERWISE ON THE PLANS OR AS DIRECTED BY THE RESIDENT ENGINEER.  
 2. SEE SHEET 38 FOR VIDEO DETECTION SYSTEM SHEET.

SIGN LEGEND  
 R = REMOVE  
 S = SALVAGE  
 N = NEW  
 RET = RETAIN  
 B-B = BACK TO BACK  
 EXISTING = \_\_\_\_\_  
 NEW = \_\_\_\_\_

<h2>PROJECT LAYOUT SHEET #2</h2>	PROJECT NAME: RUILAND CITY	FILE NAME: p06d050.dgn	PLOT DATE: 03-AUG-2012 12:2
	PROJECT NUMBER: NH 2605(I)S	PROJECT LEADER: DEG	DRAWN BY: C&K
	DESIGNED BY: MJL	CHECKED BY: DWE	
	IPARM FILE: p06d050I02.i		SHEET 14 OF 76