

646.402 DURABLE 4 INCH WHITE LINE, THERMOPLASTIC  
U.S. ROUTE 7:  
STA 68+51.00 - STA 69+00.00 DASHED LANE LINE RT  
STA 68+52.00 - STA 69+00.00 SOLID LANE LINE LT  
STA 68+52.00 - STA 69+00.00 DASHED LANE LINE LT  
STA 68+52.00 - STA 69+00.00 SOLID LANE LINE C/L

646.602 TEMPORARY 4 INCH WHITE LINE, PAINT  
U.S. ROUTE 7:  
STA 68+51.00 - STA 69+00.00 DASHED LANE LINE RT  
STA 68+52.00 - STA 69+00.00 SOLID LANE LINE LT  
STA 68+52.00 - STA 69+00.00 DASHED LANE LINE LT  
STA 68+52.00 - STA 69+00.00 SOLID LANE LINE C/L

646.412 DURABLE 4 INCH YELLOW LINE, THERMOPLASTIC  
(ALL LINES WILL INCLUDE C/L BREAKS FOR TOWN HIGHWAYS)  
U.S. ROUTE 7:  
STA 68+78.00 - STA 69+00.00 DOUBLE SOLID RT


646.612 TEMPORARY 4 INCH YELLOW LINE, PAINT  
(ALL LINES WILL INCLUDE C/L BREAKS FOR TOWN HIGHWAYS)  
U.S. ROUTE 7:  
STA 68+78.00 - STA 69+00.00 DOUBLE SOLID RT

646.481 DURABLE 24 INCH STOP BAR, TYPE 1 TAPE  
U.S. ROUTE 7:  
STA 68+51.00 LT  
STA 68+78.00 RT

646.491 DURABLE LETTER OF SYMBOL, TYPE 1 TAPE  
U.S. ROUTE 7:  
STA 68+60.25 LT, ARROW (1EA)  
STA 68+87.25 RT, ARROW (1EA)

646.682 TEMPORARY 24 INCH STOP BAR, PAINT  
U.S. ROUTE 7:  
STA 68+51.00 LT  
STA 68+78.00 RT

646.692 TEMPORARY LETTER OR SYMBOL, PAINT  
U.S. ROUTE 7:  
STA 68+60.25 LT, ARROW (2 EA)  
STA 68+87.25 RT, ARROW (2 EA)

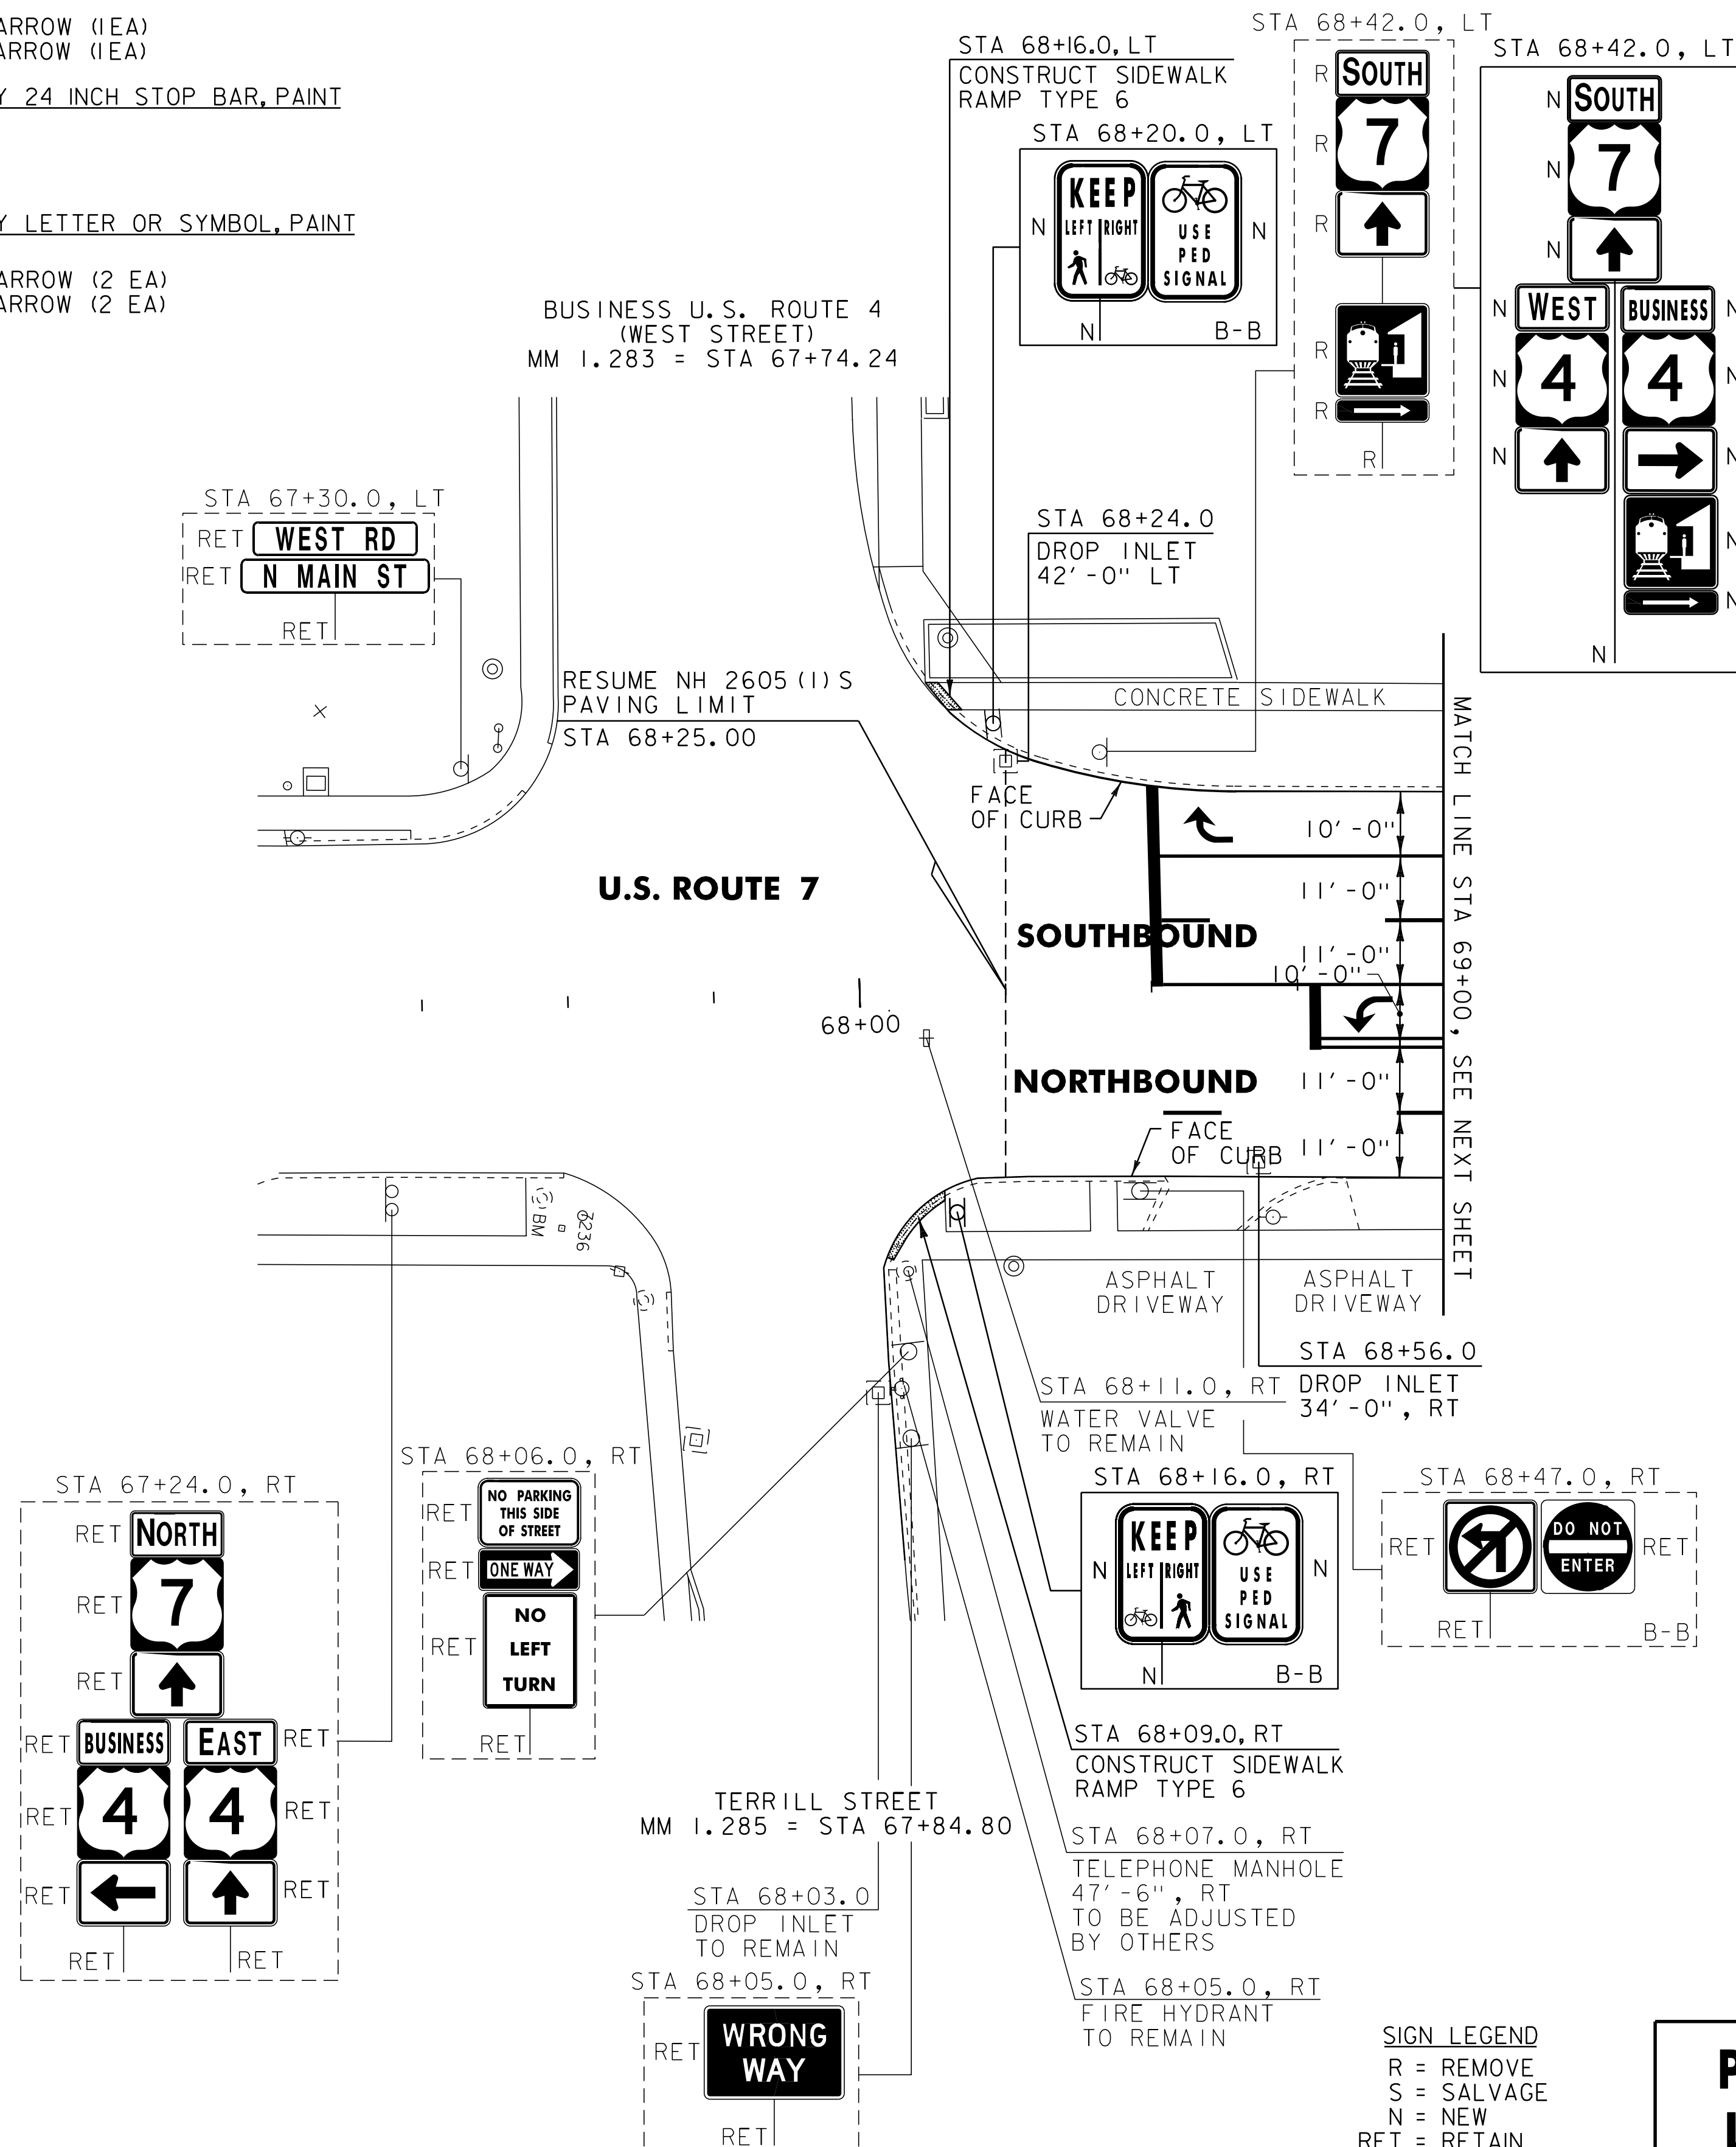

604.42 CHANGING ELEVATION OF D.I.  
STA 68+24 LT

604.412 REHAB. DROP INLETS, CATCH BASINS, OR MANHOLES, CLASS I  
U.S. ROUTE 7:  
~~STA 68+24.0 LT~~  
STA 68+56.0 RT

**SIGN LEGEND**  
R = REMOVE  
S = SALVAGE  
N = NEW  
RET = RETAIN  
B-B = BACK TO BACK  
EXISTING = \_\_\_\_\_  
NEW = \_\_\_\_\_

**PROJECT LAYOUT SHEET #7**

NOTE:  
1. SEE SHEET 42 FOR VIDEO DETECTION SYSTEM SHEET.

PROJECT NAME: RUILAND CITY	PLOT DATE: 03-AUG-2012 12:2
PROJECT NUMBER: NH 2605(1)S	DRAWN BY: C&K
FILE NAME: p06d050.dgn	CHECKED BY: DWE
PROJECT LEADER: DEG	SHEET 19 OF 76
DESIGNED BY: MJL	
IPARM FILE: p06d050107.i	