

646.402 DURABLE 4 INCH WHITE LINE, THERMOPLASTIC
 U.S. ROUTE 7:
 STA 73+00.00 - STA 73+10.00 DOTTED LANE LINE C/L
 STA 73+00.00 - STA 73+10.00 DOTTED LANE LINE RT
 STA 73+00.00 - STA 77+00.00 DASHED LANE LINE LT
 STA 73+00.00 - STA 77+00.00 DASHED LANE LINE RT
 STA 73+10.00 - STA 74+54.00 SOLID LANE LINE C/L
 STA 73+10.00 - STA 74+54.00 SOLID LANE LINE RT
 STA 74+56.00 - STA 1+00.00 U.S. ROUTE 4 DOTTED LANE LINE LT
 STA 75+71.00 - STA 77+00.00 SOLID LANE LINE LT
 STA 76+95.00 - STA 77+00.00 DOTTED LANE LINE LT

U.S. ROUTE 4:
 STA 1+00.00 - STA 1+70.00 SOLID LANE LINE C/L
 STA 1+00.00 - STA 1+70.00 SOLID LANE LINE LT

646.602 TEMPORARY 4 INCH WHITE LINE, PAINT
 U.S. ROUTE 7:
 STA 73+00.00 - STA 73+10.00 DOTTED LANE LINE C/L
 STA 73+00.00 - STA 73+10.00 DOTTED LANE LINE RT
 STA 73+00.00 - STA 77+00.00 DASHED LANE LINE LT
 STA 73+00.00 - STA 77+00.00 DASHED LANE LINE RT
 STA 73+10.00 - STA 74+54.00 SOLID LANE LINE C/L
 STA 73+10.00 - STA 74+54.00 SOLID LANE LINE RT
 STA 74+56.00 - STA 1+00.00 U.S. ROUTE 4 DOTTED LANE LINE LT
 STA 75+71.00 - STA 77+00.00 SOLID LANE LINE LT
 STA 76+95.00 - STA 77+00.00 DOTTED LANE LINE LT

U.S. ROUTE 4:
 STA 1+00.00 - STA 1+70.00 SOLID LANE LINE C/L
 STA 1+00.00 - STA 1+70.00 SOLID LANE LINE LT

646.412 DURABLE 4 INCH YELLOW LINE, THERMOPLASTIC
 (ALL LINES WILL INCLUDE C/L BREAKS FOR TOWN HIGHWAYS)
 U.S. ROUTE 7:
 STA 73+00.00 - STA 73+10.00 DOUBLE SOLID MEDIAN LT
 STA 73+10.00 - STA 77+00.00 DOUBLE SOLID LT/RT
 STA 74+18.00 - STA 1+10.00 U.S. ROUTE 4 DOTTED LANE LINE

U.S. ROUTE 4:
 STA 1+10.00 - STA 1+70.00 DOUBLE SOLID RT

646.612 TEMPORARY 4 INCH YELLOW LINE, PAINT
 (ALL LINES WILL INCLUDE C/L BREAKS FOR TOWN HIGHWAYS)
 U.S. ROUTE 7:
 STA 73+00.00 - STA 73+10.00 DOUBLE SOLID MEDIAN LT
 STA 73+10.00 - STA 77+00.00 DOUBLE SOLID LT/RT
 STA 74+18.00 - STA 1+10.00 U.S. ROUTE 4 DOTTED LANE LINE

U.S. ROUTE 4:
 STA 1+10.00 - STA 1+70.00 DOUBLE SOLID RT

646.491 DURABLE LETTER OR SYMBOL, TYPE ITAPE
 U.S. ROUTE 7:
 STA 73+14.25 RT, ARROW (1EA)
 STA 73+14.25 LT, "O,N,L,Y" (4 EA)
 STA 73+80.00 RT, "O,N,L,Y" (4 EA)
 STA 74+11.75 LT, ARROW (1EA)
 STA 74+55.75 RT, ARROW (1EA)
 STA 75+78.25 LT, ARROW (1EA)
 STA 76+35.00 LT, "O,N,L,Y" (4 EA)
 STA 76+90.75 LT, ARROW (1EA)


U.S. ROUTE 4:
 STA 1+12.50 LT, ARROW (2 EA)
 STA 1+14.75 LT, ARROW (1EA)
 STA 1+20.25 RT, ARROW (1EA)

629.20 ADJUST ELEVATION OF VALVE BOX
 U.S. ROUTE 7:
 STA 74+85.0 RT

U.S. ROUTE 4:
 STA 1+60.0 RT

604.42 CHANGING ELEVATION OF SEWER MANHOLES
 U.S. ROUTE 7:
 STA 75+23.0 RT

604.412 REHAB. DROP INLETS, CATCH BASINS, OR MANHOLES, CLASS I
 U.S. ROUTE 7:
 STA 73+37.0 LT
 STA 74+57.0 RT
 STA 75+55.0 LT
 STA 75+67.0 RT

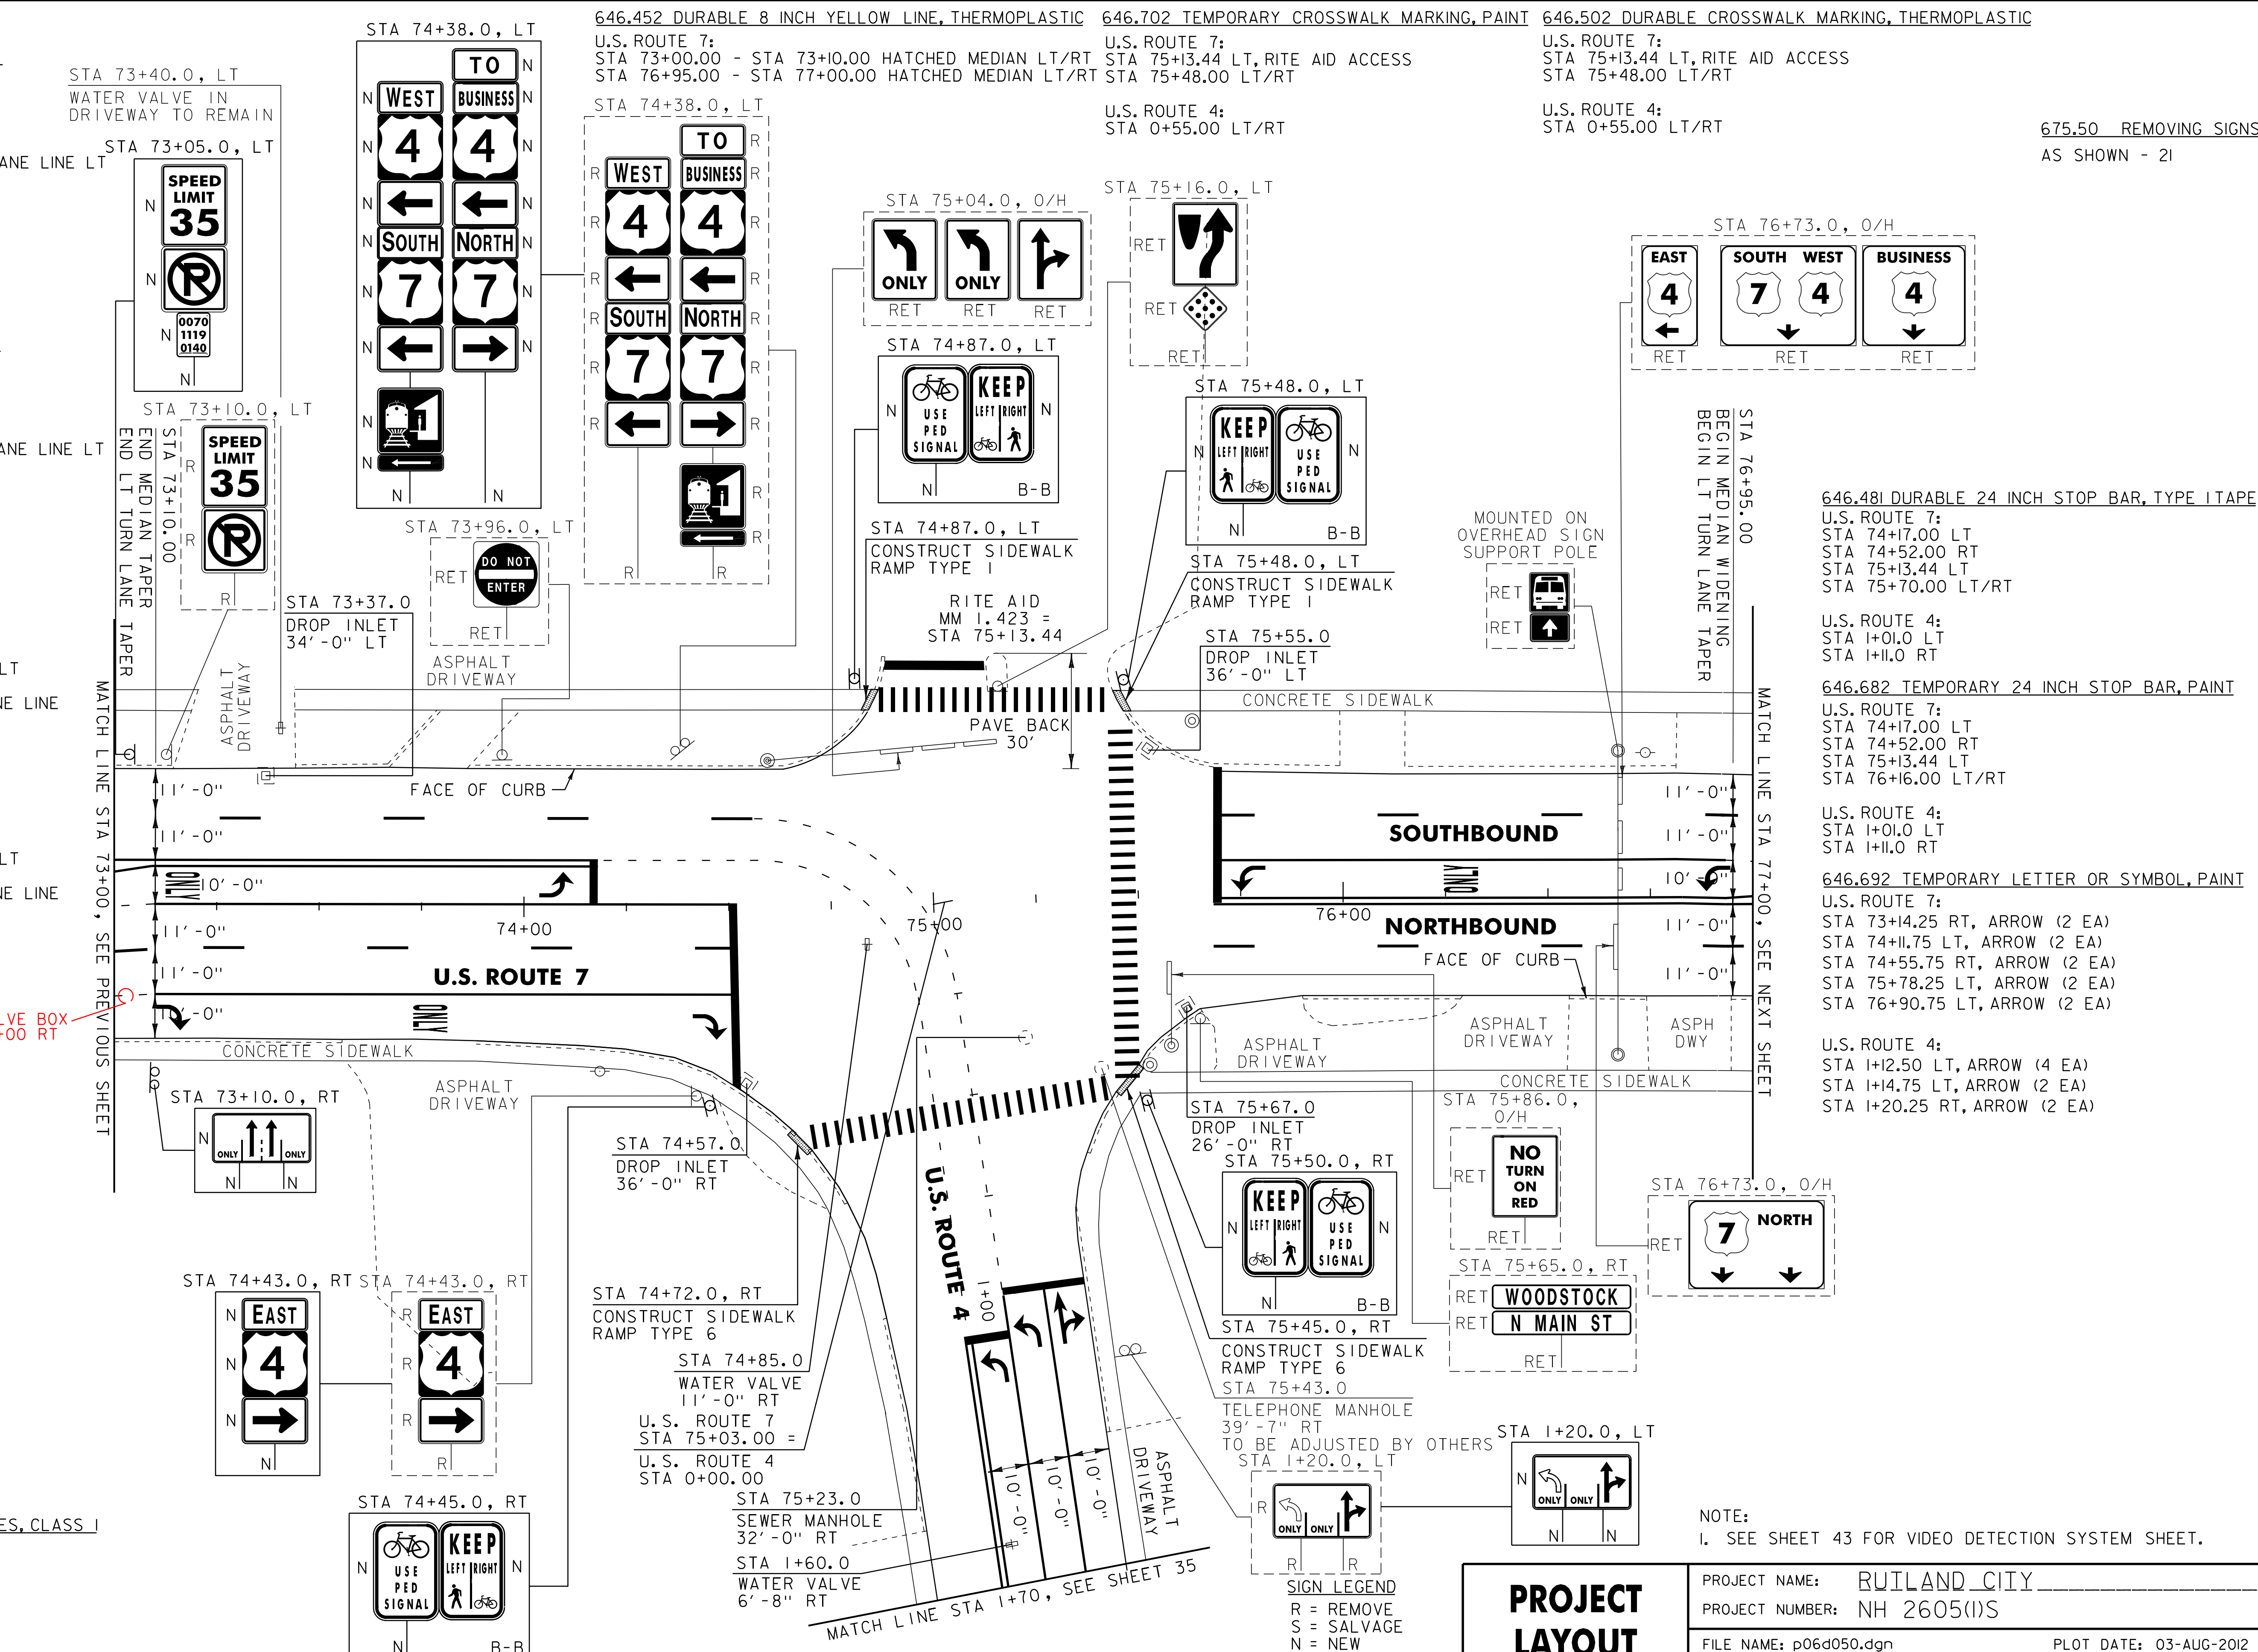

VALVE BOX
 73+00 RT

NOTE:
 1. SEE SHEET 43 FOR VIDEO DETECTION SYSTEM SHEET.

SIGN LEGEND
 R = REMOVE
 S = SALVAGE
 N = NEW
 RET = RETAIN
 B-B = BACK TO BACK
 EXISTING = _____
 NEW = _____

PROJECT LAYOUT SHEET #9

PROJECT NAME: RUILAND CITY
 PROJECT NUMBER: NH 2605(1)S
 FILE NAME: p06d050.dgn
 PROJECT LEADER: DEJ
 DESIGNED BY: MJL
 IPARM FILE: p06d050109.1
 PLOT DATE: 03-AUG-2012 12:2
 DRAWN BY: C&K
 CHECKED BY: DWE
 SHEET 21 OF 76

675.50 REMOVING SIGNS
 AS SHOWN - 21

646.481 DURABLE 24 INCH STOP BAR, TYPE ITAPE
 U.S. ROUTE 7:
 STA 74+17.00 LT
 STA 74+52.00 RT
 STA 75+13.44 LT
 STA 75+70.00 LT/RT

U.S. ROUTE 4:
 STA 1+01.0 LT
 STA 1+11.0 RT

646.682 TEMPORARY 24 INCH STOP BAR, PAINT
 U.S. ROUTE 7:
 STA 74+17.00 LT
 STA 74+52.00 RT
 STA 75+13.44 LT
 STA 76+16.00 LT/RT

U.S. ROUTE 4:
 STA 1+01.0 LT
 STA 1+11.0 RT

646.692 TEMPORARY LETTER OR SYMBOL, PAINT
 U.S. ROUTE 7:
 STA 73+14.25 RT, ARROW (2 EA)
 STA 74+11.75 LT, ARROW (2 EA)
 STA 74+55.75 RT, ARROW (2 EA)
 STA 75+78.25 LT, ARROW (2 EA)
 STA 76+90.75 LT, ARROW (2 EA)

U.S. ROUTE 4:
 STA 1+12.50 LT, ARROW (4 EA)
 STA 1+14.75 LT, ARROW (2 EA)
 STA 1+20.25 RT, ARROW (2 EA)