

646.402 DURABLE 4 INCH WHITE LINE, THERMOPLASTIC
 U.S. ROUTE 7:
 STA 81+00.00 - STA 87+00.00 DASHED LANE LINE LT
 STA 81+00.00 - STA 87+00.00 DASHED LANE LINE RT

675.50 REMOVING SIGNS
 AS SHOWN - 13
 675.60 ERECTING SALVAGED SIGNS
 AS SHOWN - 4

646.412 DURABLE 4 INCH YELLOW LINE, THERMOPLASTIC
 (ALL LINES WILL INCLUDE C/L BREAKS FOR TOWN HIGHWAYS)
 U.S. ROUTE 7:
 STA 81+00.00 - STA 87+00.00 DOUBLE SOLID C/L
 STA 81+84.00 DOUBLE SOLID LT, BURNHAM AVENUE
 STA 85+06.08 DOUBLE SOLID LT, KENDALL AVENUE
 STA 85+64.16 DOUBLE SOLID RT, TEMPLE STREET

646.481 DURABLE 24 INCH STOP BAR, TYPE ITAPE
 U.S. ROUTE 7:
 STA 81+84.00 LT, BURNHAM AVENUE
 STA 85+06.08 LT, KENDALL AVENUE
 STA 85+64.16 RT, TEMPLE STREET


646.682 TEMPORARY 24 INCH STOP BAR, PAINT
 U.S. ROUTE 7:
 STA 81+84.00 LT, BURNHAM AVENUE
 STA 85+06.08 LT, KENDALL AVENUE
 STA 85+64.16 RT, TEMPLE STREET

646.491 DURABLE LETTER OR SYMBOL, TYPE ITAPE
 U.S. ROUTE 7:
 STA 81+84.00 LT, BURNHAM AVENUE, "S,T,O,P" (4 EA)
 STA 85+06.08 LT, KENDALL AVENUE, "S,T,O,P" (4 EA)
 STA 85+64.16 RT, TEMPLE STREET, "S,T,O,P" (4 EA)

646.692 TEMPORARY LETTER OR SYMBOL, PAINT
 U.S. ROUTE 7:
 STA 81+84.00 LT, BURNHAM AVENUE, "S,T,O,P" (8 EA)
 STA 85+06.08 LT, KENDALL AVENUE, "S,T,O,P" (8 EA)
 STA 85+64.16 RT, TEMPLE STREET, "S,T,O,P" (8 EA)

646.702 TEMPORARY CROSSWALK MARKING, PAINT
 U.S. ROUTE 7:
 STA 81+84.00 LT, BURNHAM AVENUE
 STA 85+06.08 LT, KENDALL AVENUE
 STA 85+64.16 RT, TEMPLE STREET

646.502 DURABLE CROSSWALK MARKING, THERMOPLASTIC
 U.S. ROUTE 7:
 STA 81+84.00 LT, BURNHAM AVENUE
 STA 85+06.08 LT, KENDALL AVENUE
 STA 85+64.16 RT, TEMPLE STREET

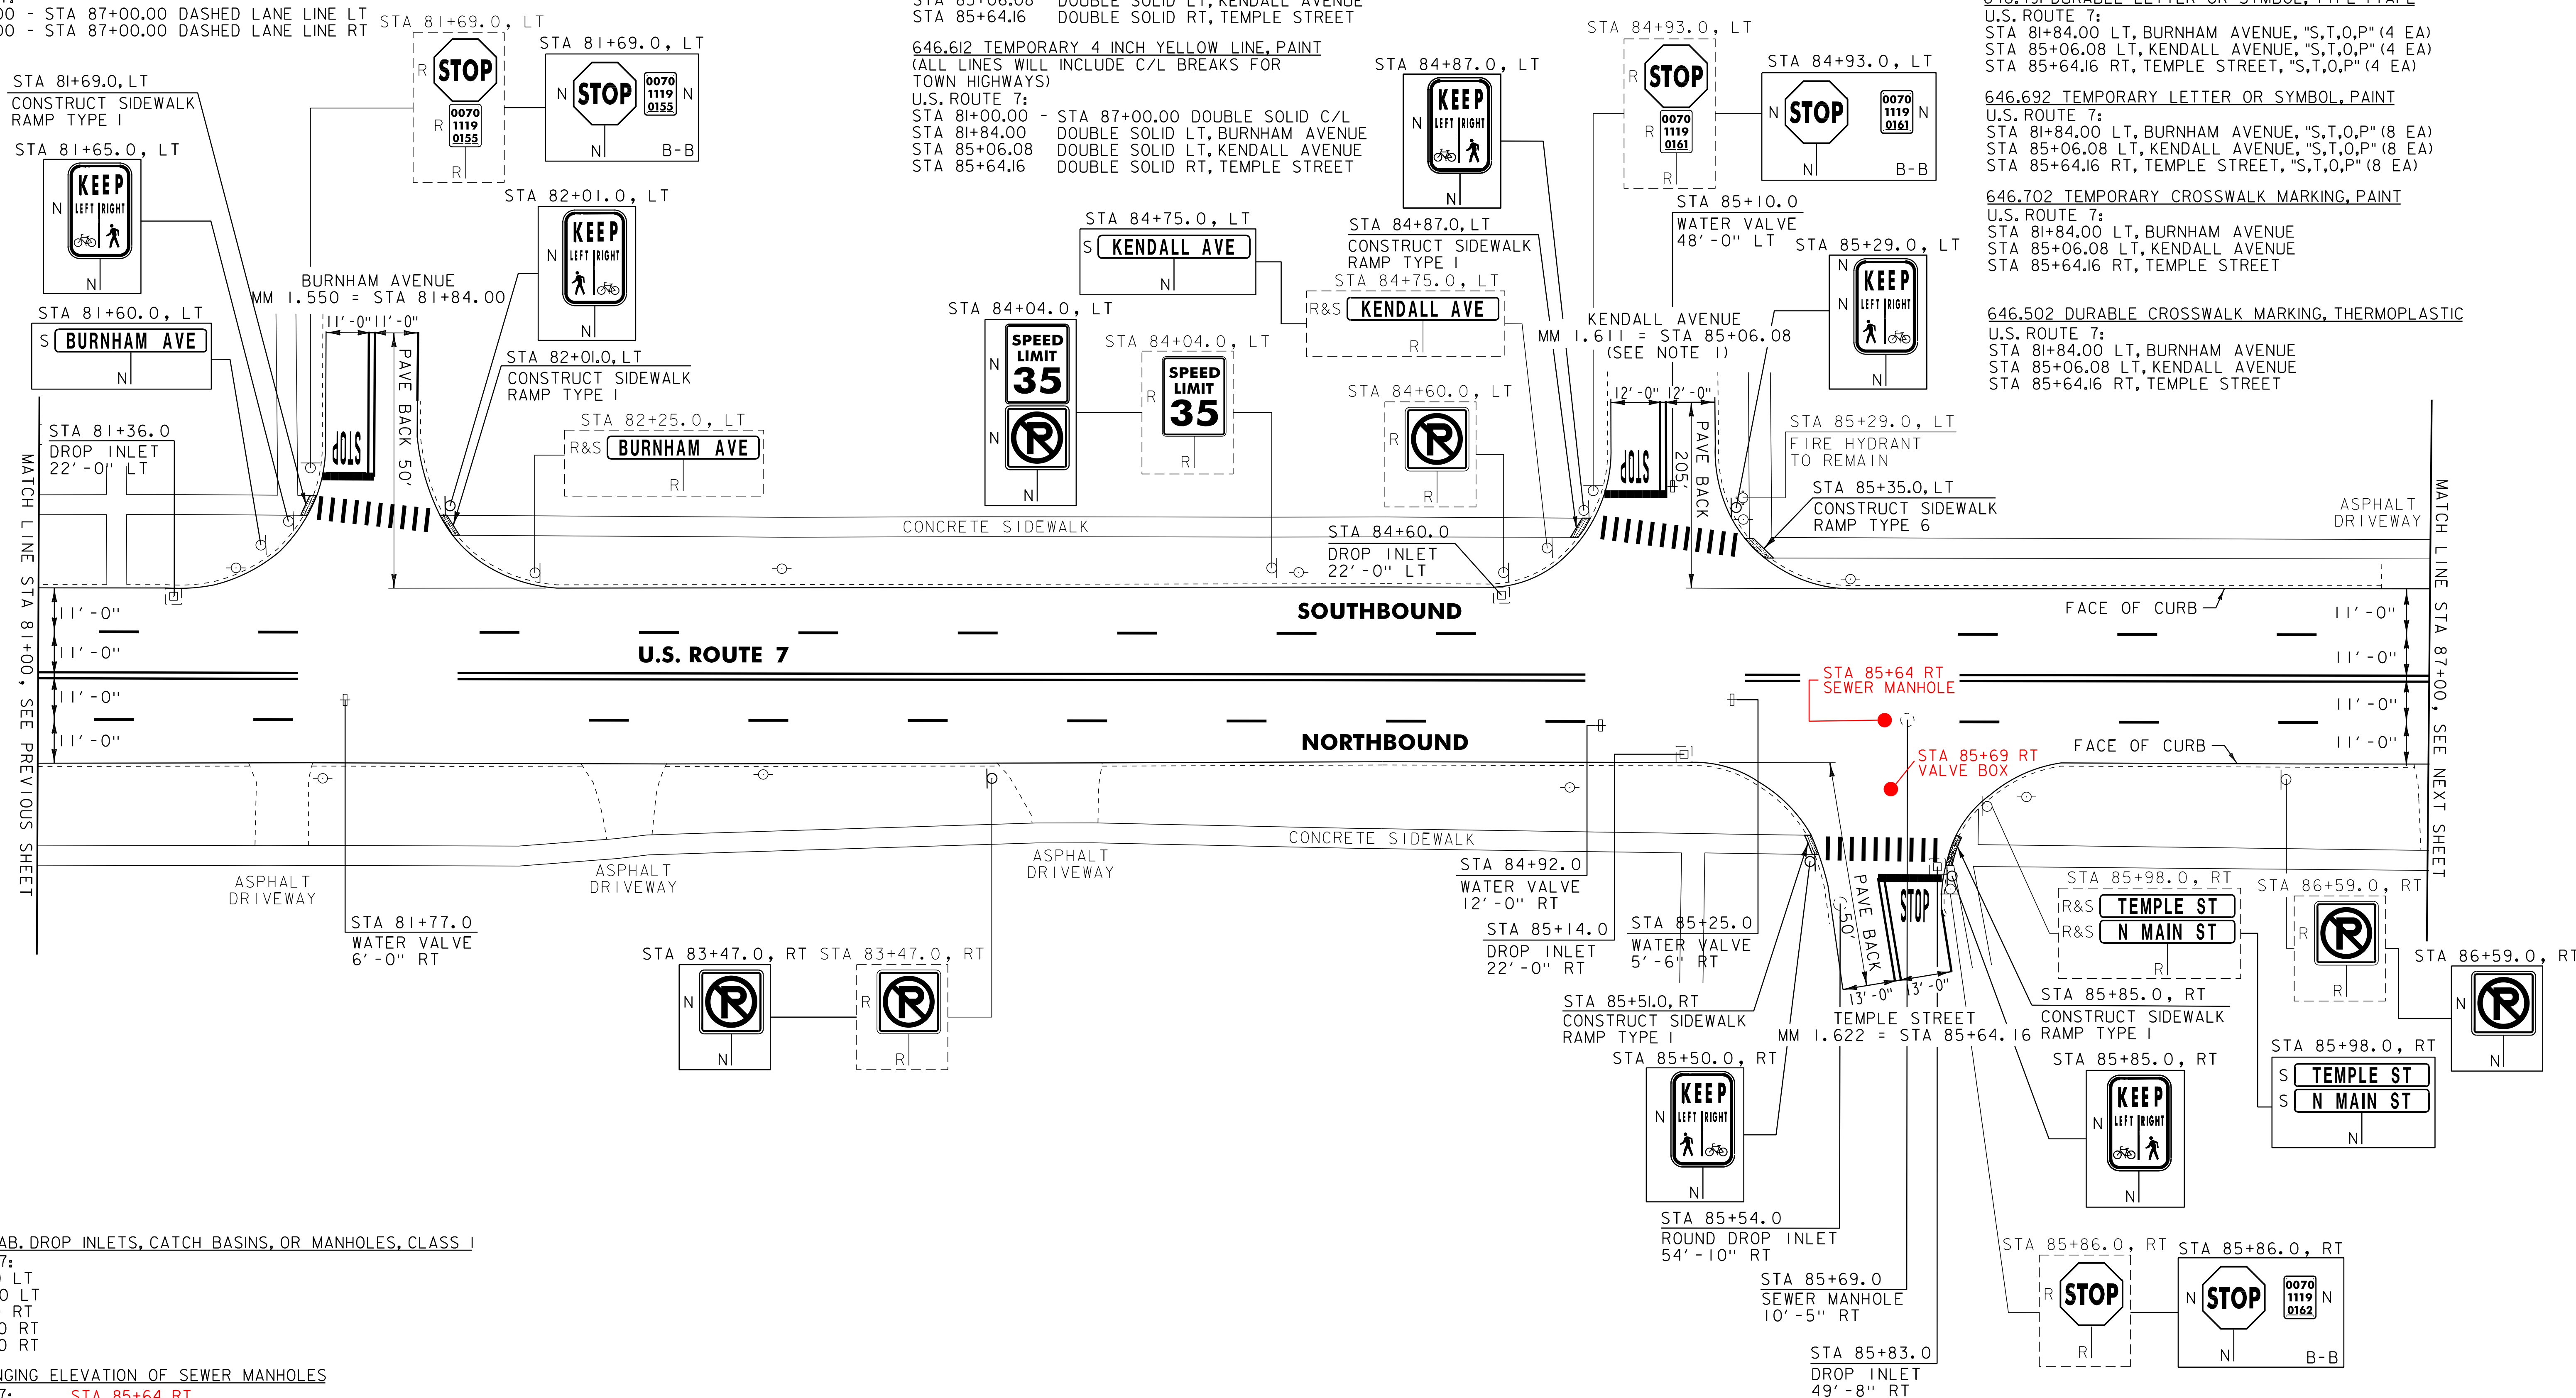

604.412 REHAB. DROP INLETS, CATCH BASINS, OR MANHOLES, CLASS I
 U.S. ROUTE 7:
 STA 81+36.0 LT
 STA 84+60.0 LT
 STA 85+14.0 RT
 STA 85+54.0 RT
 STA 85+83.0 RT

604.42 CHANGING ELEVATION OF SEWER MANHOLES
 U.S. ROUTE 7: STA 85+64 RT
 STA 85+69.0 RT

629.20 ADJUST ELEVATION OF VALVE BOX
 U.S. ROUTE 7:
 STA 81+77.0 RT STA 85+69 RT
 STA 84+92.0 RT
 STA 85+10.0 LT
 STA 85+25.0 RT

NOTE:
 I. CONTRACTOR SHALL COLD PLANE KENDALL AVENUE 4" THEN LEVEL 1/2" TYPE IVS AND PAVE 1 1/2" TYPE IVS TO MAXIMIZE CURB REVEAL AS DIRECTED BY THE RESIDENT ENGINEER.

SIGN LEGEND
 R = REMOVE
 S = SALVAGE
 N = NEW
 RET = RETAIN
 B-B = BACK TO BACK
 EXISTING =
 NEW =

PROJECT LAYOUT SHEET #11	PROJECT NAME: RUILAND CITY	PLOT DATE: 03-AUG-2012 12:22
	PROJECT NUMBER: NH 2605(I)S	DRAWN BY: C&K
	FILE NAME: p06d050.dgn	DESIGNED BY: MJL
	IPARM FILE: p06d050111.i	SHEET 23 OF 76