

646.402 DURABLE 4 INCH WHITE LINE, THERMOPLASTIC
 U.S. ROUTE 7:
 STA 92+00.00 - STA 97+00.00 DASHED LANE LINE LT
 STA 92+00.00 - STA 97+00.00 DASHED LANE LINE RT
 STA 95+99.04 SOLID LANE LINE LT, CRESCENT STREET

646.481 DURABLE 24 INCH STOP BAR, TYPE ITAPE
 U.S. ROUTE 7:
 STA 93+72.00 RT, CLINTON AVENUE
 STA 95+64.00 RT
 STA 95+99.04 LT, CRESCENT STREET
 STA 96+40.00 LT

646.702 DURABLE CROSSWALK MARKING, PAINT
 U.S. ROUTE 7:
 STA 93+72.00 RT, CLINTON AVENUE
 STA 95+70.00 LT/RT
 STA 95+99.04 LT, CRESCENT STREET

646.602 TEMPORARY 4 INCH WHITE LINE, PAINT
 U.S. ROUTE 7:
 STA 92+00.00 - STA 97+00.00 DASHED LANE LINE LT
 STA 92+00.00 - STA 97+00.00 DASHED LANE LINE RT
 STA 95+99.04 SOLID LANE LINE LT, CRESCENT STREET

646.682 TEMPORARY 24 INCH STOP BAR, PAINT
 U.S. ROUTE 7:
 STA 93+72.00 RT, CLINTON AVENUE
 STA 96+00.00 RT
 STA 95+99.04 LT, CRESCENT STREET
 STA 96+40.00 LT

646.502 DURABLE CROSSWALK MARKING, THERMOPLASTIC
 U.S. ROUTE 7:
 STA 93+72.00 RT, CLINTON AVENUE
 STA 95+70.00 LT/RT
 STA 95+99.04 LT, CRESCENT STREET

646.412 DURABLE 4 INCH YELLOW LINE, THERMOPLASTIC
 (ALL LINES WILL INCLUDE C/L BREAKS FOR TOWN HIGHWAYS)


646.491 DURABLE LETTER OR SYMBOL, TYPE ITAPE
 U.S. ROUTE 7:
 STA 93+72.00 RT, CLINTON AVENUE, "S,T,O,P" (4 EA)
 STA 95+99.04 LT, CRESCENT STREET, ARROW (1EA)
 STA 95+99.04 LT, CRESCENT STREET, ARROW (1EA)

U.S. ROUTE 7:
 STA 92+00.00 - STA 97+00.00 DOUBLE SOLID C/L
 STA 93+72.00 DOUBLE SOLID RT, CLINTON AVENUE
 STA 95+99.04 DOUBLE SOLID LT, CRESCENT STREET

646.692 TEMPORARY LETTER OR SYMBOL, PAINT
 U.S. ROUTE 7:
 STA 93+74.24 RT, CLINTON AVENUE, "S,T,O,P" (8 EA)
 STA 96+01.28 LT, CRESCENT STREET, ARROW (2 EA)
 STA 96+01.28 LT, CRESCENT STREET, ARROW (2 EA)

646.612 TEMPORARY 4 INCH YELLOW LINE, PAINT
 (ALL LINES WILL INCLUDE C/L BREAKS FOR TOWN HIGHWAYS)

U.S. ROUTE 7:
 STA 92+00.00 - STA 97+00.00 DOUBLE SOLID C/L
 STA 93+72.00 DOUBLE SOLID RT, CLINTON AVENUE
 STA 95+99.04 DOUBLE SOLID LT, CRESCENT STREET

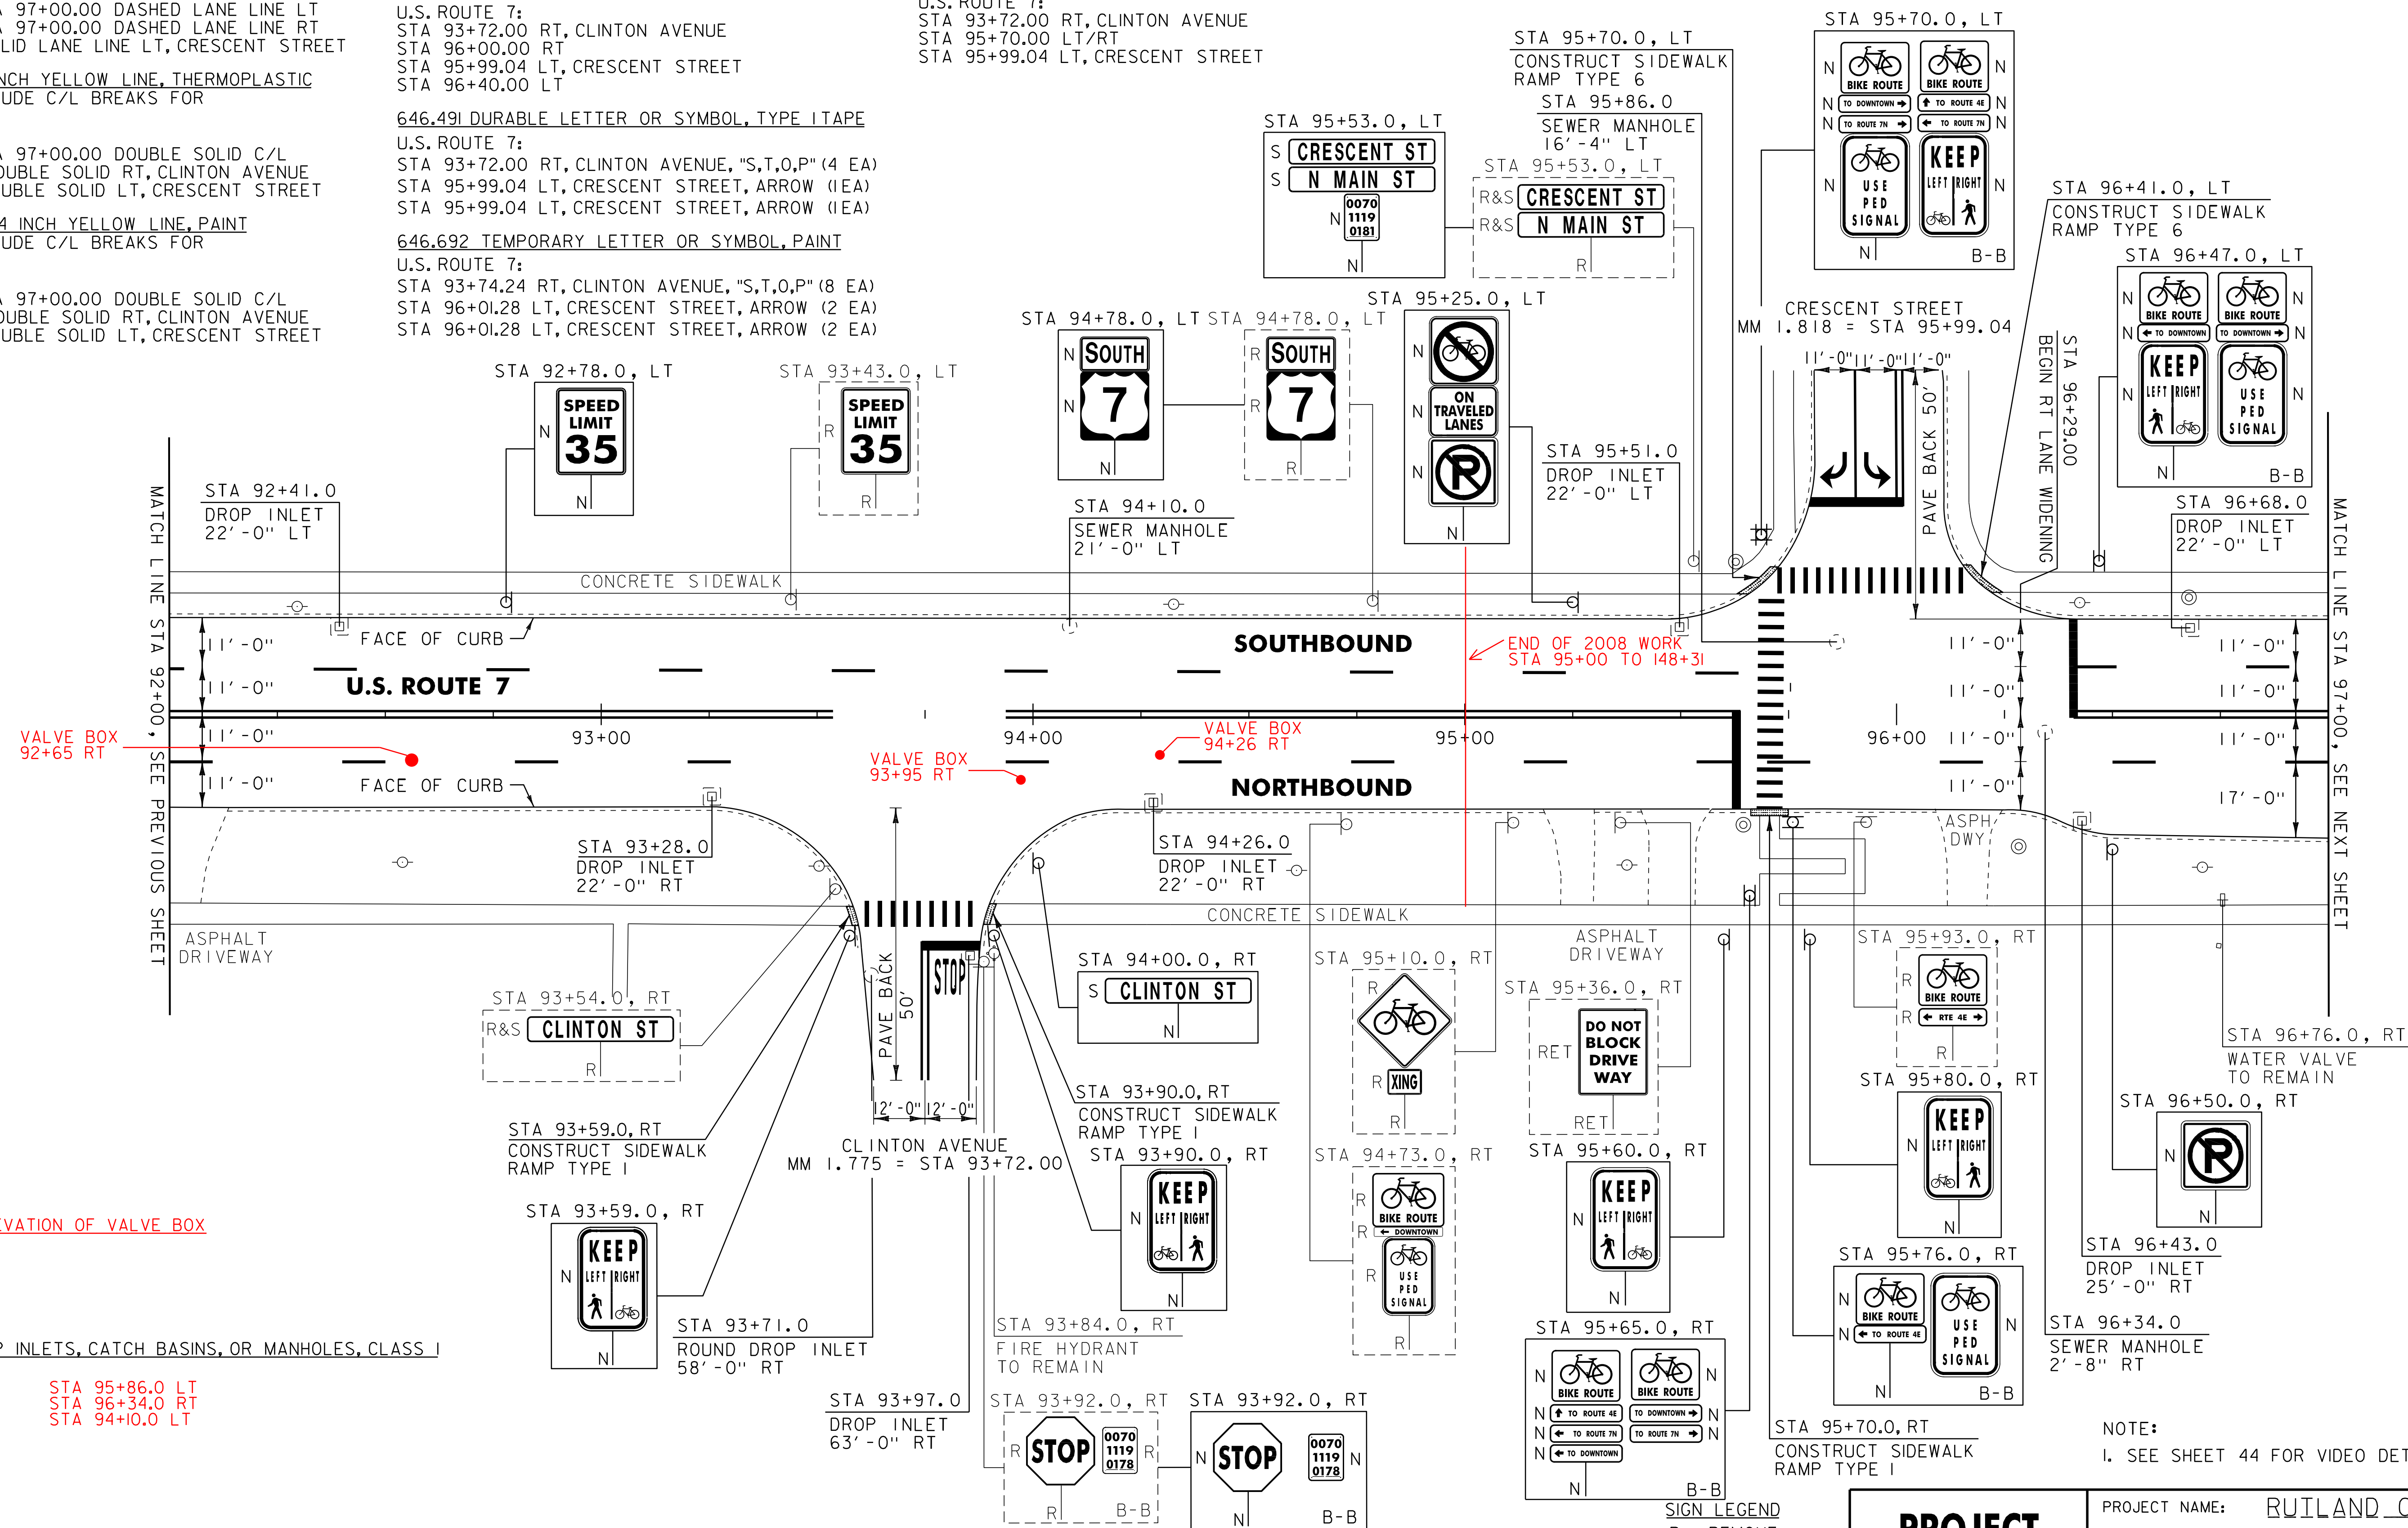

629.20 ADJUST ELEVATION OF VALVE BOX

STA 92+65 RT
 STA 93+95 RT
 STA 94+26 RT

604.412 REHAB. DROP INLETS, CATCH BASINS, OR MANHOLES, CLASS I

U.S. ROUTE 7:
 STA 92+41.0 LT
 STA 93+28.0 RT
 STA 93+71.0 RT
 STA 93+97.0 RT
 STA 94+26.0 RT
 STA 95+51.0 LT
 STA 96+43.0 RT
 STA 96+68.0 LT

STA 95+86.0 LT
 STA 96+34.0 RT
 STA 94+10.0 LT

604.415 REHAB. DROP INLETS, CATCH BASINS, OR MANHOLES, CLASS II

U.S. ROUTE 7:
~~STA 94+10.0 LT~~
~~STA 95+86.0 LT~~
~~STA 96+34.0 RT~~

SIGN LEGEND
 R = REMOVE
 S = SALVAGE
 N = NEW
 RET = RETAIN
 B-B = BACK TO BACK
 EXISTING = _____
 NEW = _____

PROJECT LAYOUT SHEET #13

PROJECT NAME: RUILAND CITY
 PROJECT NUMBER: NH 2605(I)S
 FILE NAME: p06d050.dgn
 PROJECT LEADER: DEG
 DESIGNED BY: MJL
 IPARM FILE: p06d050i13.i
 PLOT DATE: 03-AUG-2012 12:2
 DRAWN BY: CAK
 CHECKED BY: DWE
 SHEET 25 OF 76

NOTE:
 1. SEE SHEET 44 FOR VIDEO DETECTION SYSTEM SHEET.