

646.402 DURABLE 4 INCH WHITE LINE, THERMOPLASTIC
 U.S. ROUTE 7:
 STA 120+00.00 - STA 126+00.00 DASHED LANE LINE LT
 STA 120+00.00 - STA 126+00.00 DASHED LANE LINE RT

646.602 TEMPORARY 4 INCH WHITE LINE, PAINT
 U.S. ROUTE 7:
 STA 120+00.00 - STA 126+00.00 DASHED LANE LINE LT
 STA 120+00.00 - STA 126+00.00 DASHED LANE LINE RT

646.412 DURABLE 4 INCH YELLOW LINE, THERMOPLASTIC
 (ALL LINES WILL INCLUDE C/L BREAKS FOR TOWN HIGHWAYS)
 U.S. ROUTE 7:
 STA 120+00.00 - STA 126+00.00 DOUBLE SOLID C/L
 STA 122+02.08 DOUBLE SOLID LT, VERNON STREET

646.612 TEMPORARY 4 INCH YELLOW LINE, PAINT
 (ALL LINES WILL INCLUDE C/L BREAKS FOR TOWN HIGHWAYS)
 U.S. ROUTE 7:
 STA 120+00.00 - STA 126+00.00 DOUBLE SOLID C/L
 STA 122+02.08 DOUBLE SOLID LT, VERNON STREET

646.481 DURABLE 24 INCH STOP BAR, TYPE I TAPE
 U.S. ROUTE 7:
 STA 122+02.08 LT, VERNON STREET

646.682 TEMPORARY 24 INCH STOP BAR, PAINT
 U.S. ROUTE 7:
 STA 122+02.08 LT, VERNON STREET

646.491 DURABLE LETTER OR SYMBOL, TYPE I TAPE
 U.S. ROUTE 7:
 STA 122+02.08 LT, VERNON STREET, "S,T,O,P" (4 EA)


646.692 TEMPORARY LETTER OR SYMBOL, PAINT
 U.S. ROUTE 7:
 STA 122+02.08 LT, VERNON STREET, "S,T,O,P" (8 EA)

646.702 TEMPORARY CROSSWALK MARKING, PAINT
 U.S. ROUTE 7:
 STA 122+02.08 LT, VERNON STREET

646.502 DURABLE CROSSWALK MARKING, THERMOPLASTIC
 U.S. ROUTE 7:
 STA 122+02.08 LT, VERNON STREET

675.50 REMOVING SIGNS
 AS SHOWN - II

675.60 ERECTING SALVAGED SIGNS
 AS SHOWN - I

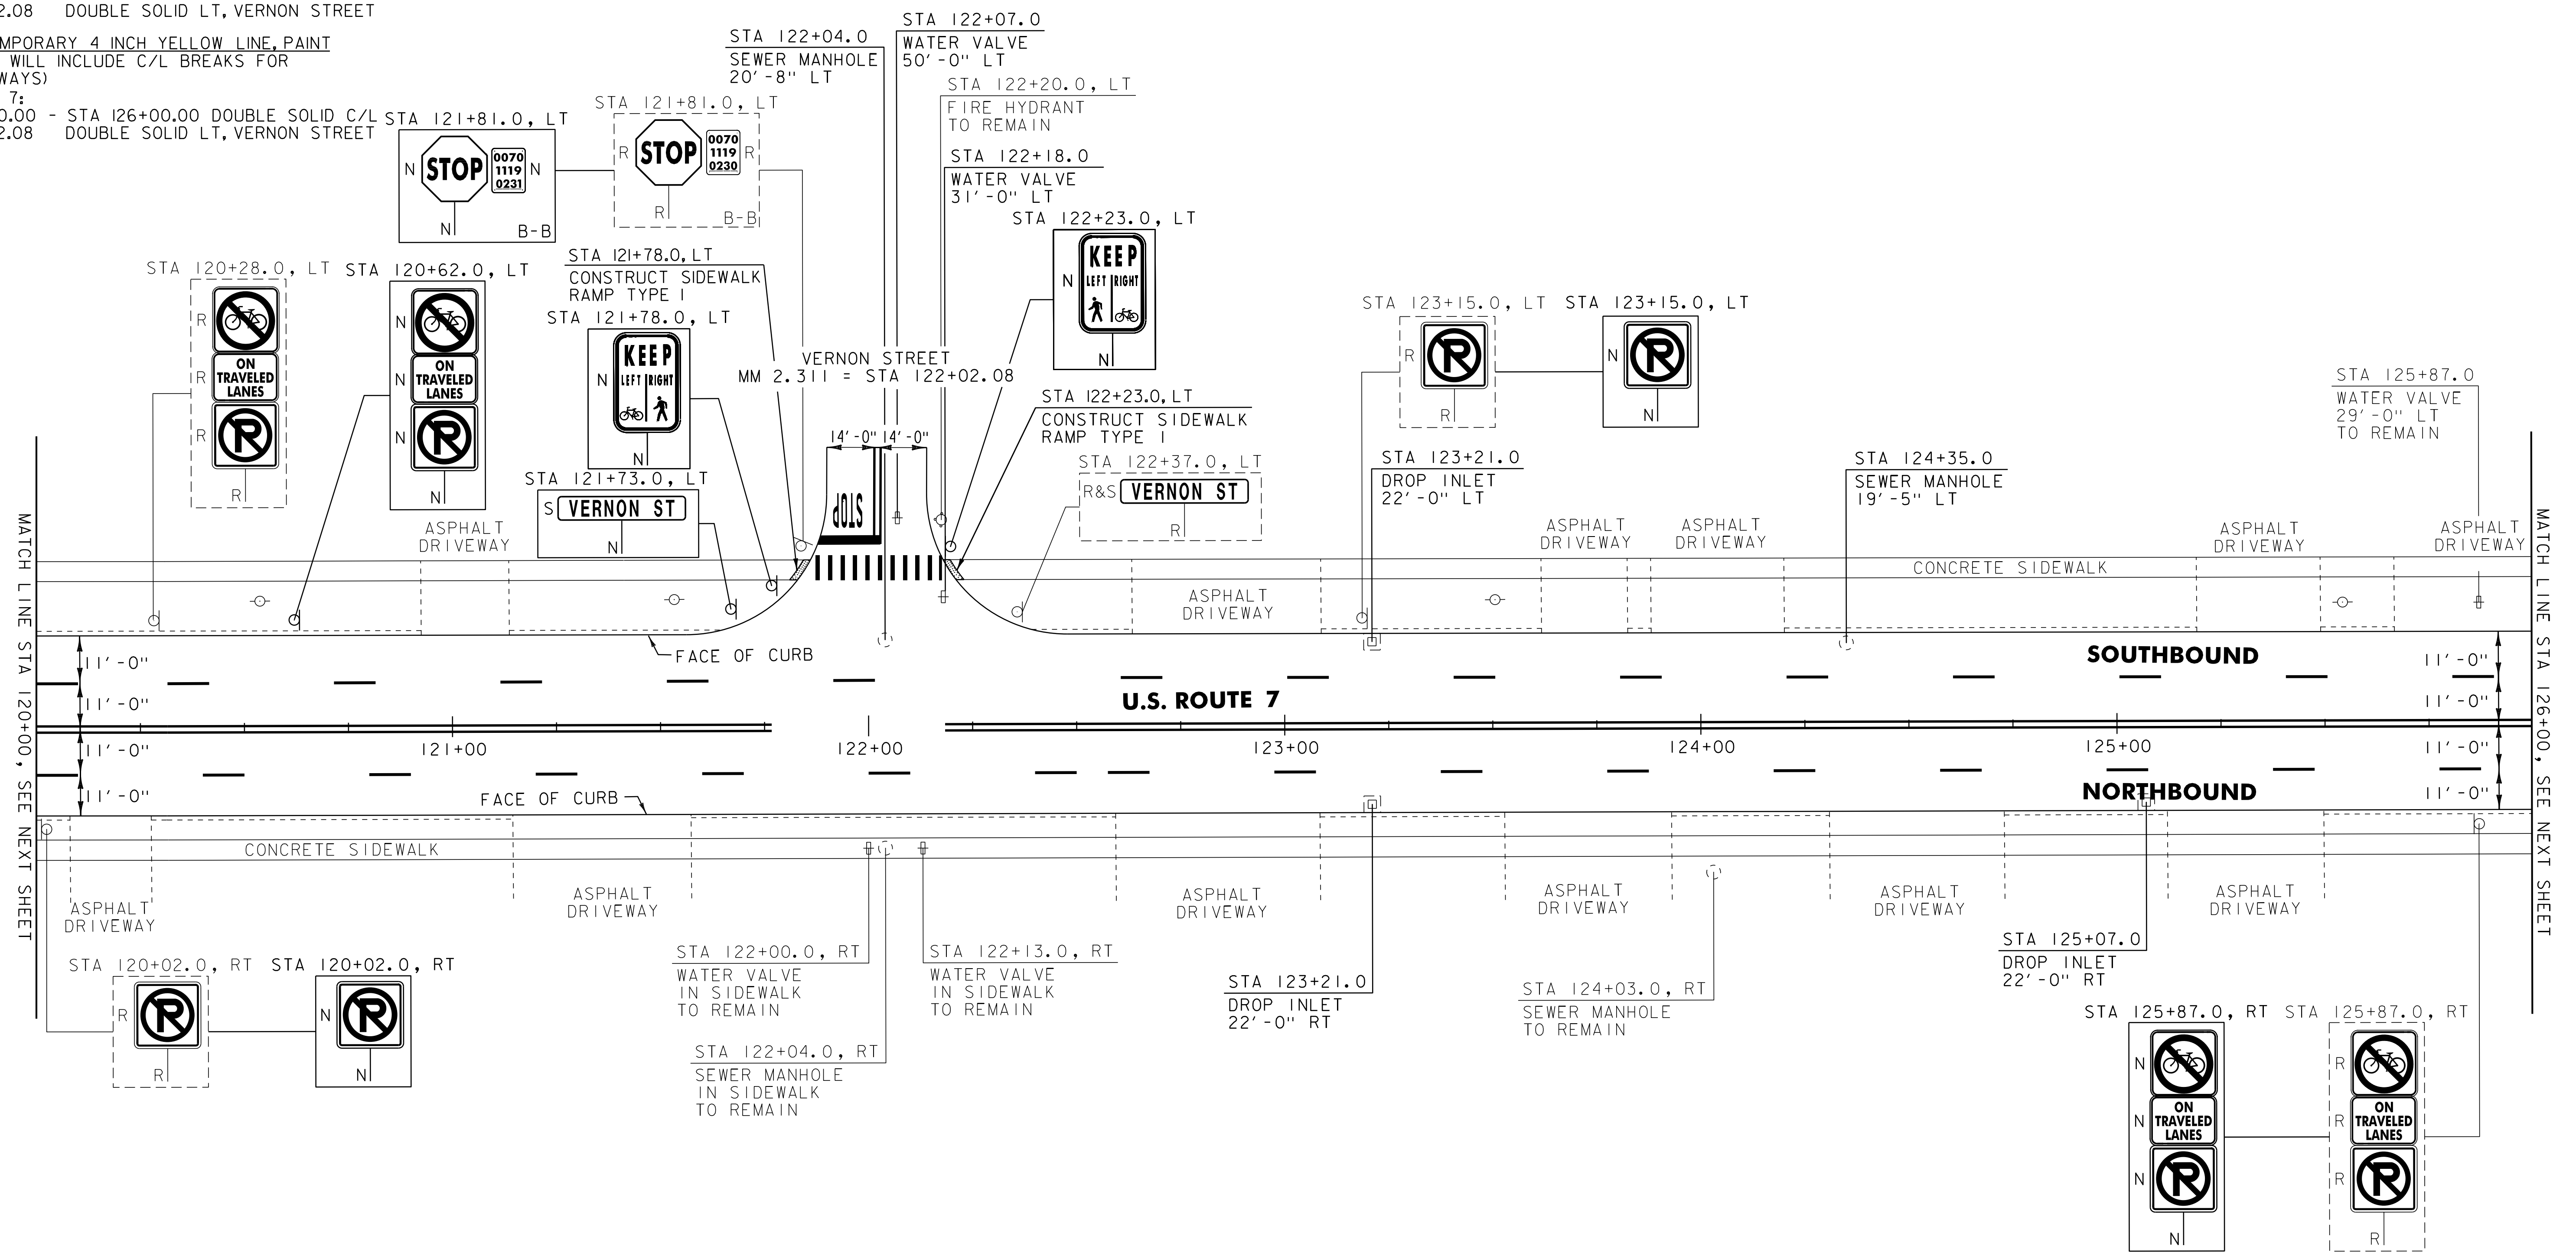

604.412 REHAB. DROP INLETS, CATCH BASINS, OR MANHOLES, CLASS I
 U.S. ROUTE 7:
 STA 123+21.0 RT
 STA 123+21.0 LT
 STA 125+07.0 RT

604.415 REHAB. DROP INLETS, CATCH BASINS, OR MANHOLES, CLASS II
 U.S. ROUTE 7:
~~STA 122+04.0 LT~~
 STA 124+35.0 LT

629.20 ADJUST ELEVATION OF VALVE BOX
 U.S. ROUTE 7:
~~STA 122+07.0 LT NOT FOUND~~
 STA 122+18.0 LT

NOTE:
 I. PAVING LIMIT ON ALL TOWN HIGHWAYS SHALL BE MEASURED 25 FT BACK FROM U.S. ROUTE 7 EDGE OF SHOULDER UNLESS DENOTED OTHERWISE ON THE PLANS OR AS DIRECTED BY THE RESIDENT ENGINEER.

SIGN LEGEND
 R = REMOVE
 S = SALVAGE
 N = NEW
 RET = RETAIN
 B-B = BACK TO BACK
 EXISTING = - - - - -
 NEW = _____

PROJECT LAYOUT SHEET #18	PROJECT NAME: RUILAND CITY	PLOT DATE: 03-AUG-2012 12:2
	PROJECT NUMBER: NH 2605(I)S	DRAWN BY: CAK
	FILE NAME: p06d050.dgn	CHECKED BY: DWE
	DESIGNED BY: MJL	SHEET 30 OF 76