


646.402 DURABLE 4 INCH WHITE LINE, THERMOPLASTIC
 U.S. ROUTE 7:
 STA 126+00.00 - STA 132+00.00 DASHED LANE LINE LT
 STA 126+00.00 - STA 132+00.00 DASHED LANE LINE RT
 646.602 TEMPORARY 4 INCH WHITE LINE, PAINT
 U.S. ROUTE 7:
 STA 126+00.00 - STA 132+00.00 DASHED LANE LINE LT
 STA 126+00.00 - STA 132+00.00 DASHED LANE LINE RT

646.412 DURABLE 4 INCH YELLOW LINE, THERMOPLASTIC
 (ALL LINES WILL INCLUDE C/L BREAKS FOR TOWN HIGHWAYS)
 U.S. ROUTE 7:
 STA 126+00.00 - STA 132+00.00 DOUBLE SOLID C/L
 646.612 TEMPORARY 4 INCH YELLOW LINE, PAINT
 (ALL LINES WILL INCLUDE C/L BREAKS FOR TOWN HIGHWAYS)
 U.S. ROUTE 7:
 STA 126+00.00 - STA 132+00.00 DOUBLE SOLID C/L

675.50 REMOVING SIGNS
 AS SHOWN - 3

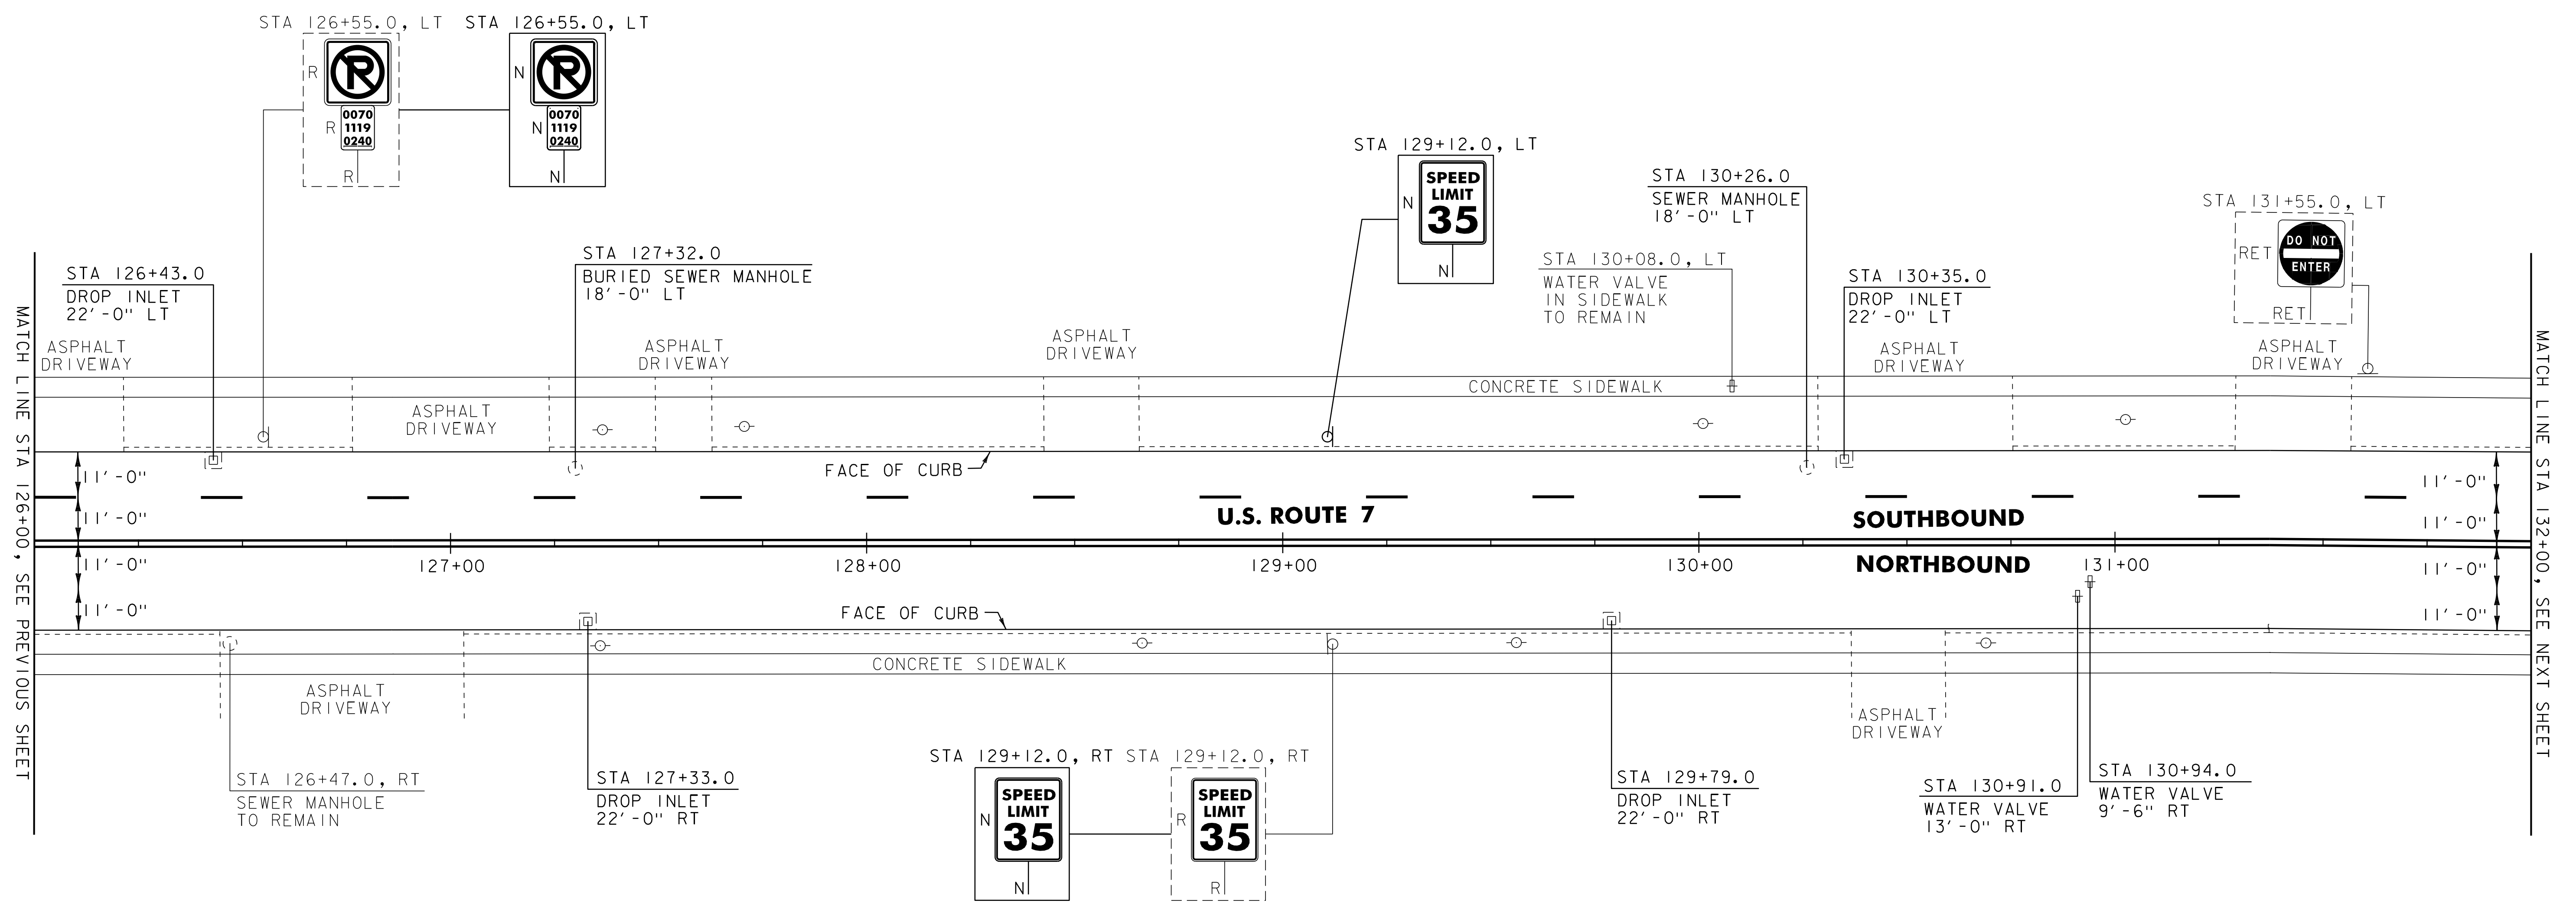

MATCH LINE STA 126+00, SEE PREVIOUS SHEET

MATCH LINE STA 132+00, SEE NEXT SHEET

604.412 REHAB. DROP INLETS, CATCH BASINS, OR MANHOLES, CLASS I
 U.S. ROUTE 7:
 STA 126+43.0 LT
~~STA 127+33.0 RT~~
 STA 129+79.0 RT
 STA 130+35.0 LT
 604.415 REHAB. DROP INLETS, CATCH BASINS, OR MANHOLES, CLASS II
 U.S. ROUTE 7:
 STA 127+32.0 LT
 STA 130+26.0 LT

629.20 ADJUST ELEVATION OF VALVE BOX
 U.S. ROUTE 7:
 STA 130+91.0 RT
 STA 130+94.0 RT

604.42 CHANGING ELEVATION OF SEWER, OR MANHOLES
 STA 127+33.0 RT

SIGN LEGEND
 R = REMOVE
 S = SALVAGE
 N = NEW
 RET = RETAIN
 B-B = BACK TO BACK
 EXISTING =
 NEW =

PROJECT LAYOUT SHEET #19	PROJECT NAME: <u>RUILAND CITY</u>	PLOT DATE: <u>03-AUG-2012 12:2</u>
	PROJECT NUMBER: <u>NH 2605(I)S</u>	DRAWN BY: <u>CAK</u>
	FILE NAME: <u>p06d050.dgn</u>	CHECKED BY: <u>DWE</u>
	DESIGNED BY: <u>MJL</u>	SHEET <u>31</u> OF <u>76</u>