

675.50 REMOVING SIGNS

AS SHOWN - 9

675.60 ERECTING SALVAGED SIGNS

AS SHOWN - 2

646.402 DURABLE 4 INCH WHITE LINE, THERMOPLASTIC

U.S. ROUTE 7:
STA 132+00.00 - STA 138+00.00 DASHED LANE LINE LT
STA 132+00.00 - STA 138+00.00 DASHED LANE LINE RT

646.602 TEMPORARY 4 INCH WHITE LINE, PAINT

U.S. ROUTE 7:
STA 132+00.00 - STA 138+00.00 DASHED LANE LINE LT
STA 132+00.00 - STA 138+00.00 DASHED LANE LINE RT

646.412 DURABLE 4 INCH YELLOW LINE, THERMOPLASTIC

(ALL LINES WILL INCLUDE C/L BREAKS FOR TOWN HIGHWAYS)

U.S. ROUTE 7:
STA 132+00.00 - STA 138+00.00 DOUBLE SOLID C/L
STA 133+21.44 DOUBLE SOLID LT, FIELD AVENUE

646.612 TEMPORARY 4 INCH YELLOW LINE, PAINT

(ALL LINES WILL INCLUDE C/L BREAKS FOR TOWN HIGHWAYS)
U.S. ROUTE 7:
STA 132+00.00 - STA 138+00.00 DOUBLE SOLID C/L
STA 133+21.44 DOUBLE SOLID LT, FIELD AVENUE

646.481 DURABLE 24 INCH STOP BAR, TYPE I TAPE

U.S. ROUTE 7:
STA 133+21.44 LT, FIELD AVENUE

646.682 TEMPORARY 24 INCH STOP BAR, PAINT

U.S. ROUTE 7:
STA 133+21.44 LT, FIELD AVENUE

646.491 DURABLE LETTER OR SYMBOL, TYPE I TAPE

U.S. ROUTE 7:
STA 133+21.44 LT, FIELD AVENUE, "S,T,O,P" (4 EA)

646.692 TEMPORARY LETTER OR SYMBOL, PAINT


U.S. ROUTE 7:
STA 133+21.44 LT, FIELD AVENUE, "S,T,O,P" (8 EA)

646.702 TEMPORARY CROSSWALK MARKING, PAINT

U.S. ROUTE 7:
STA 133+21.44 LT, FIELD AVENUE

646.502 DURABLE CROSSWALK MARKING, THERMOPLASTIC

U.S. ROUTE 7:
STA 133+21.44 LT, FIELD AVENUE

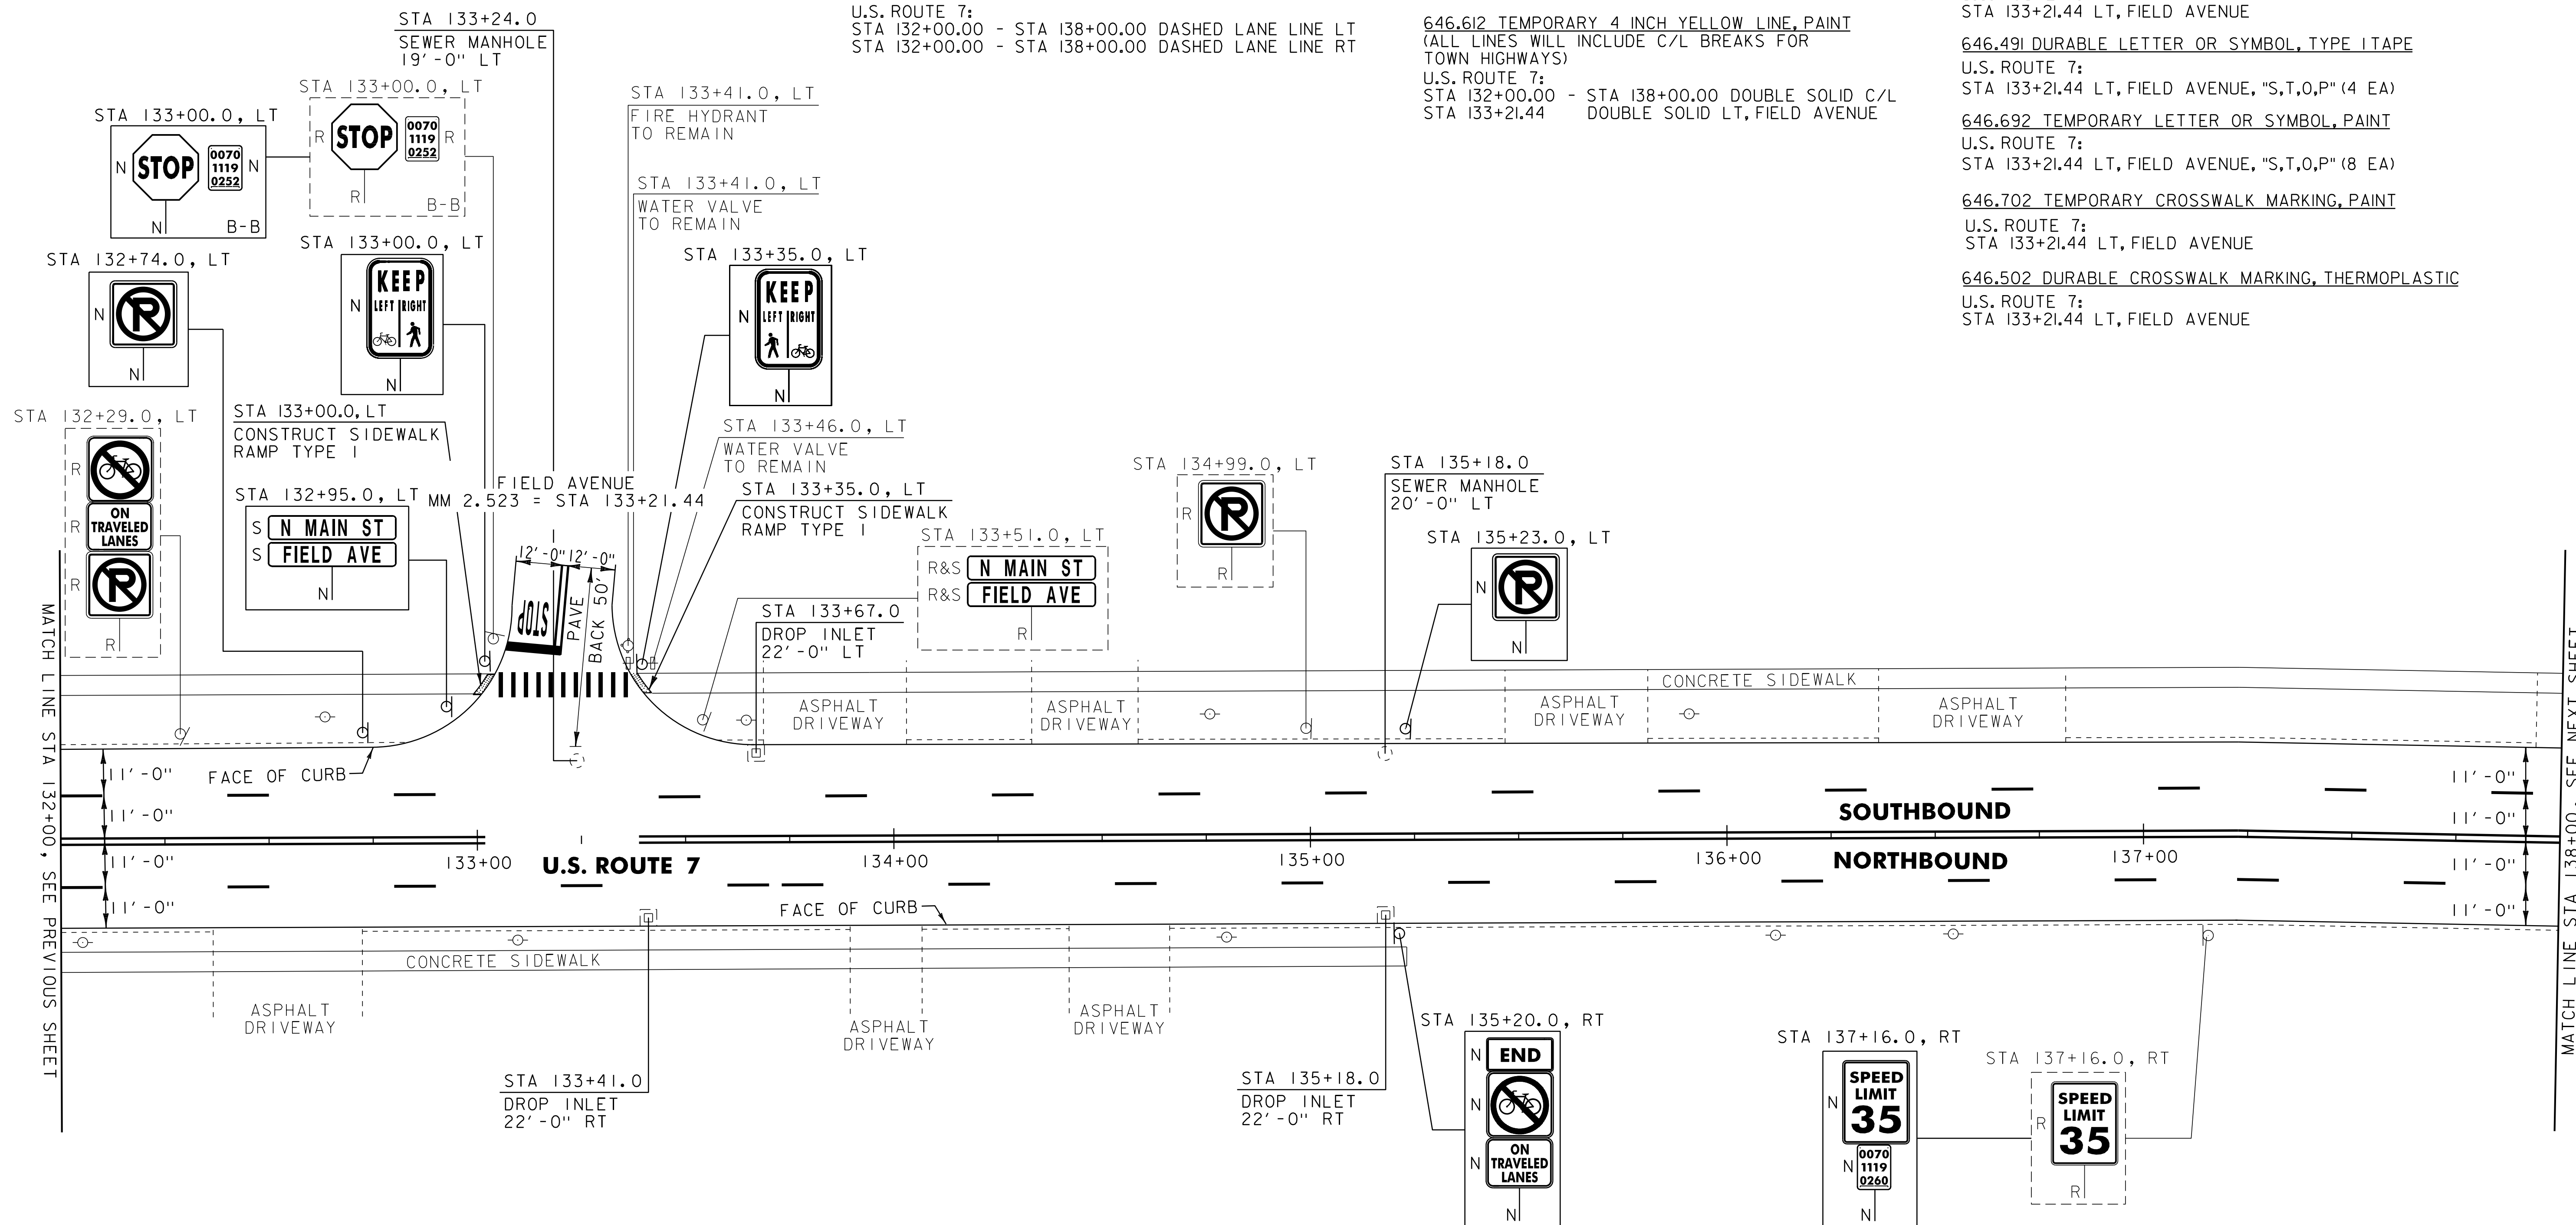

604.412 REHAB. DROP INLETS, CATCH BASINS, OR MANHOLES, CLASS I
U.S. ROUTE 7:
STA 133+41.0 RT STA 135+18.0 LT
STA 133+67.0 LT STA 133+24.0 LT
STA 135+18.0 RT

604.415 REHAB. DROP INLETS, CATCH BASINS, OR MANHOLES, CLASS II
U.S. ROUTE 7:
~~STA 133+24.0 LT~~
~~STA 135+18.0 LT~~

SIGN LEGEND
R = REMOVE
S = SALVAGE
N = NEW
RET = RETAIN
B-B = BACK TO BACK
EXISTING = _____
NEW = _____

PROJECT LAYOUT SHEET #20	PROJECT NAME: RUILAND CITY	PLOT DATE: 03-AUG-2012 12:2
	PROJECT NUMBER: NH 2605(1)S	DRAWN BY: C&K
	DESIGNED BY: MJL	CHECKED BY: DWE
	IPARM FILE: p06d050i20.i	SHEET 32 OF 76